




8+50

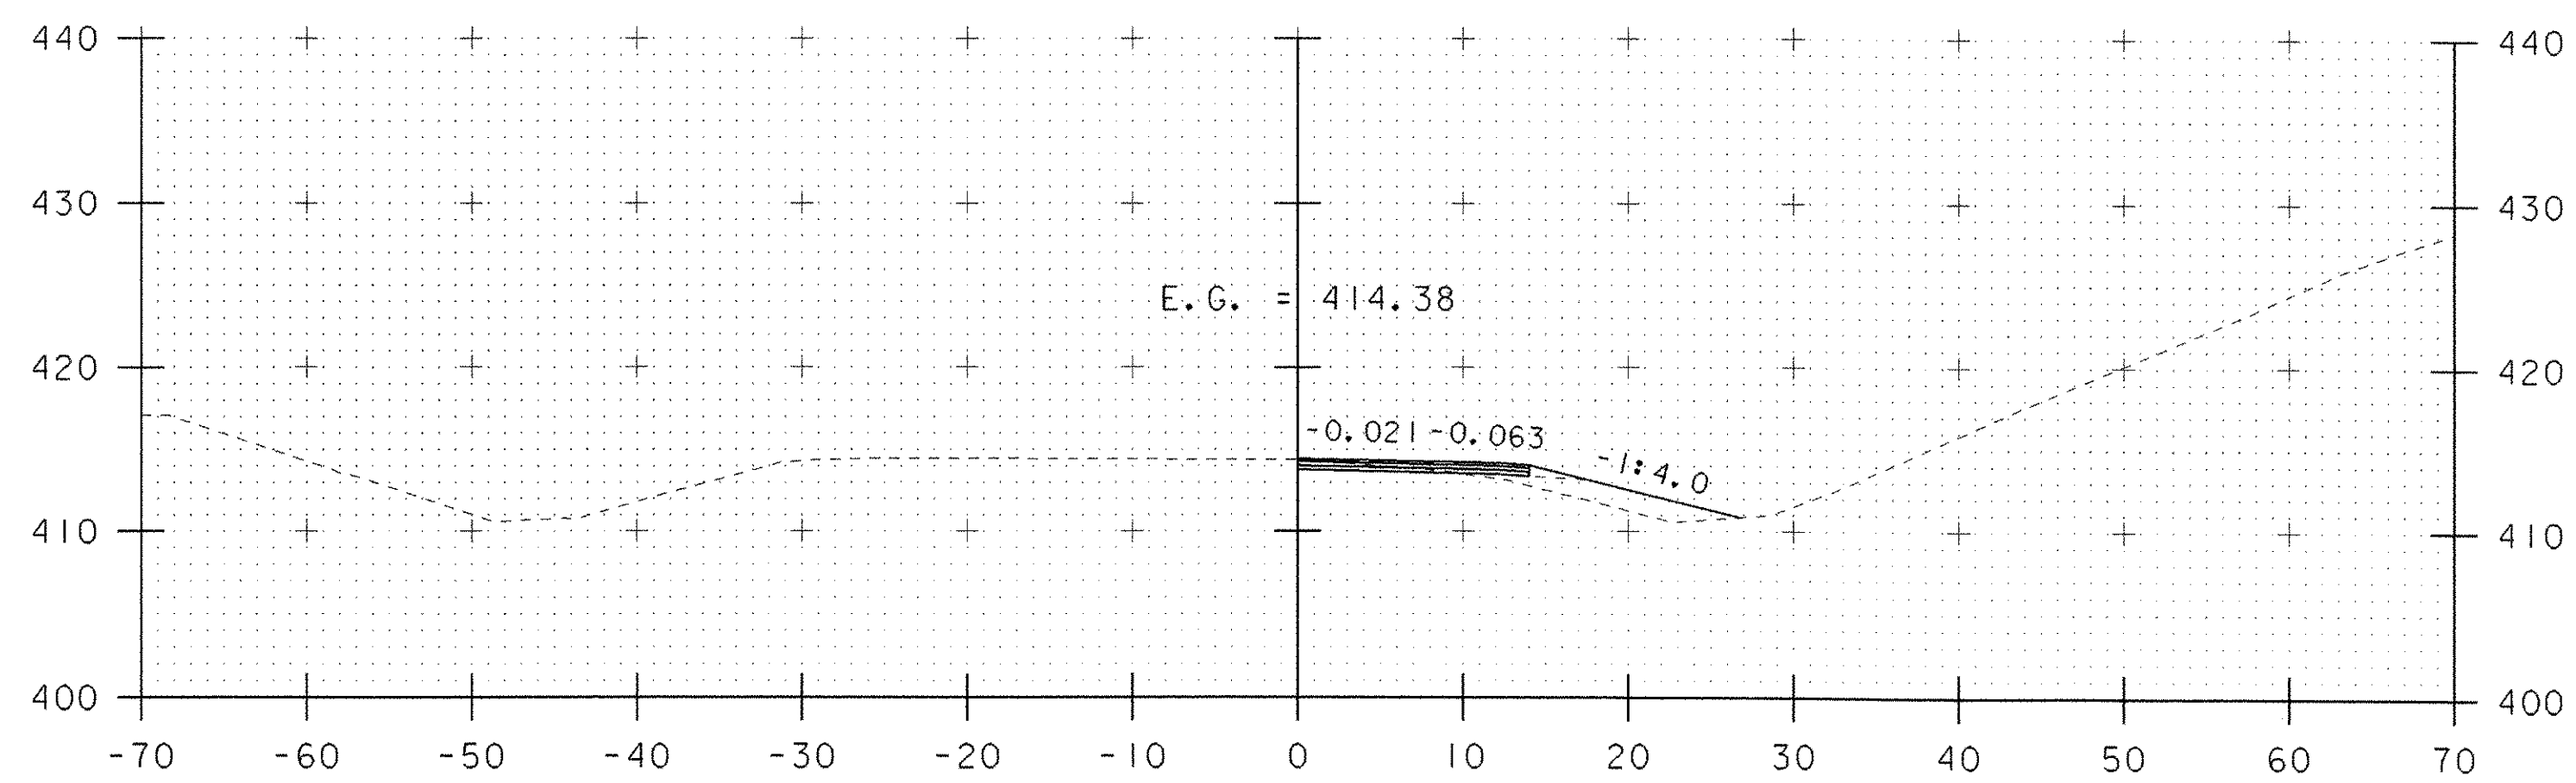


8+00

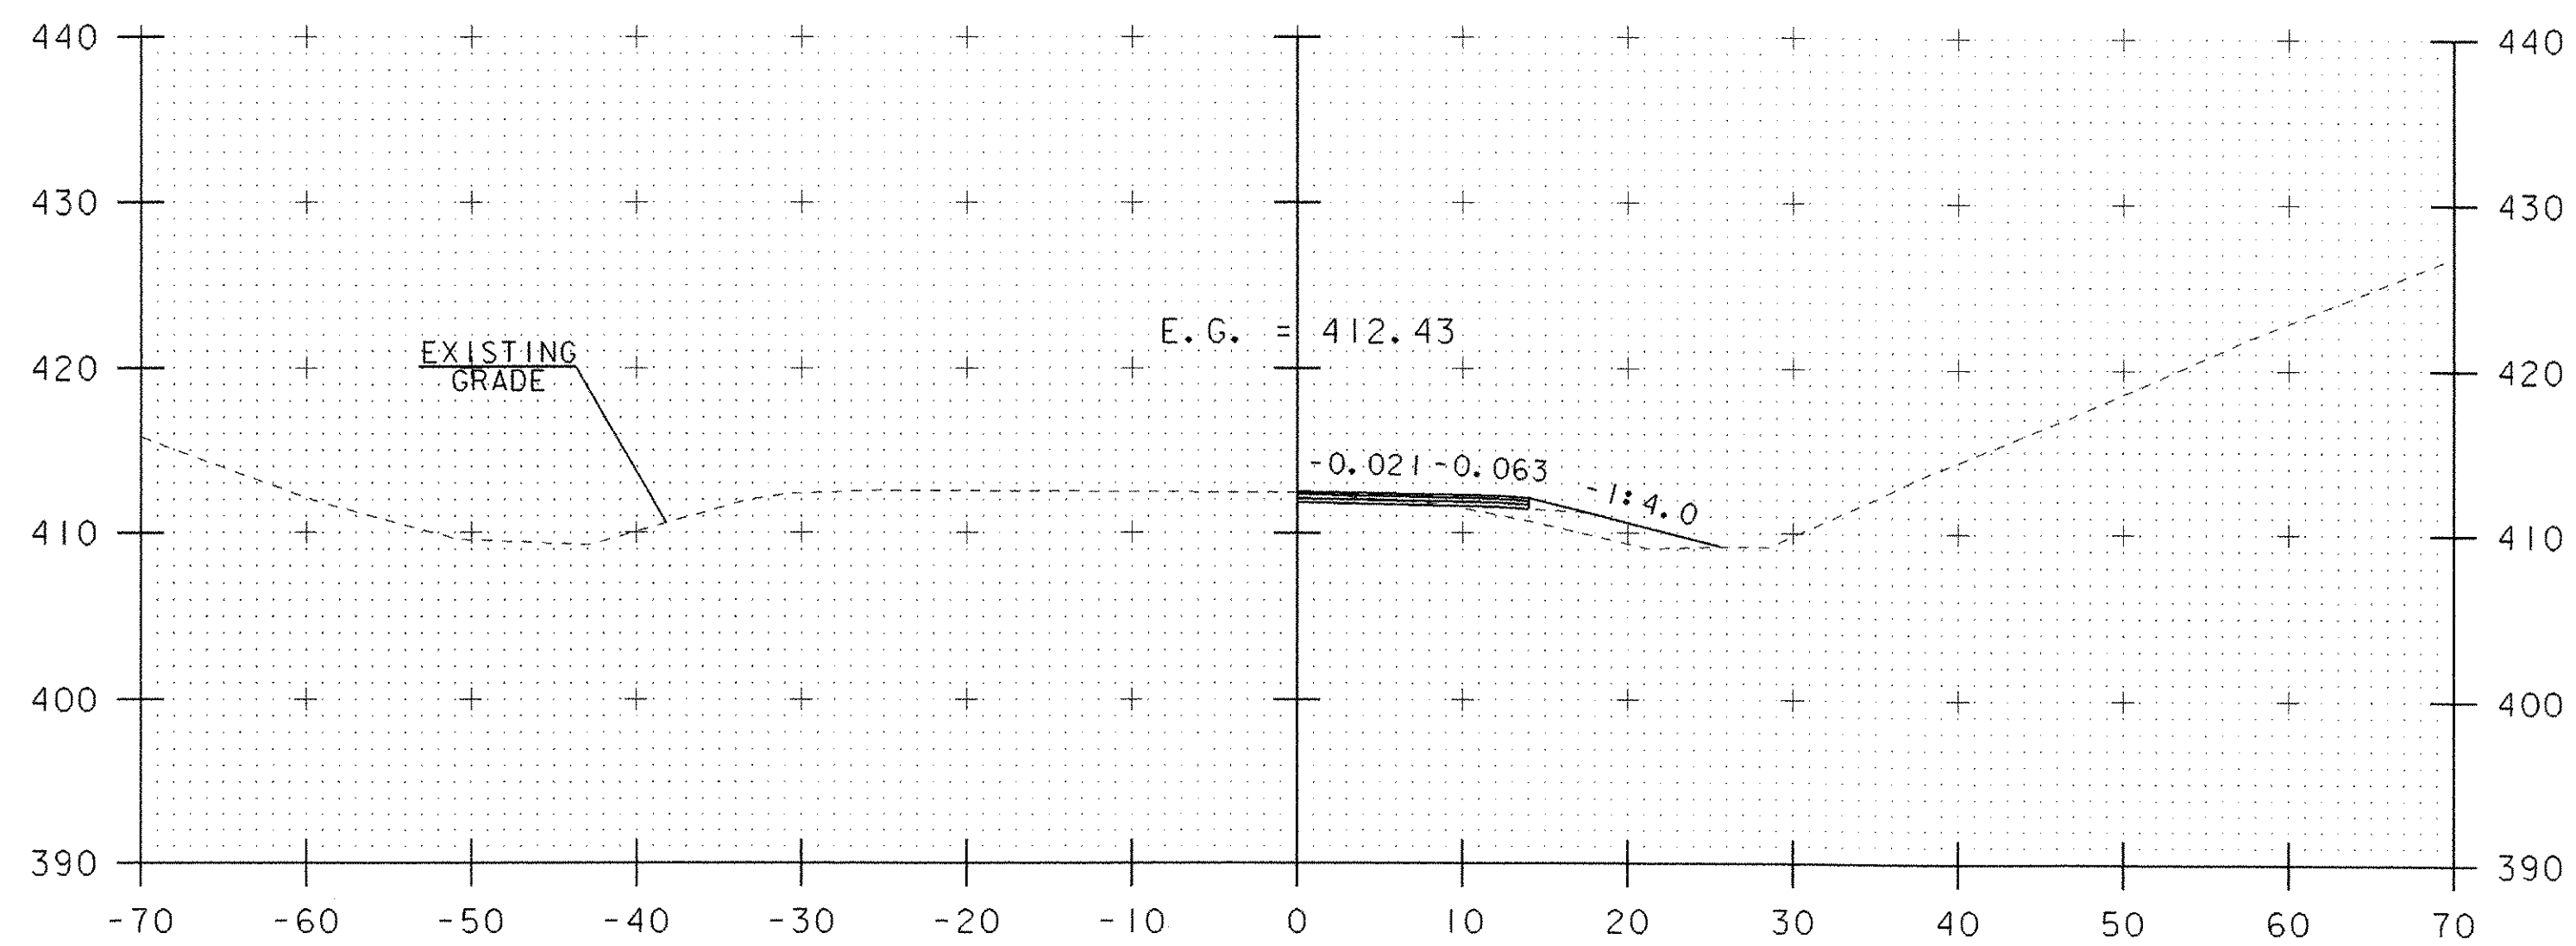

7+50

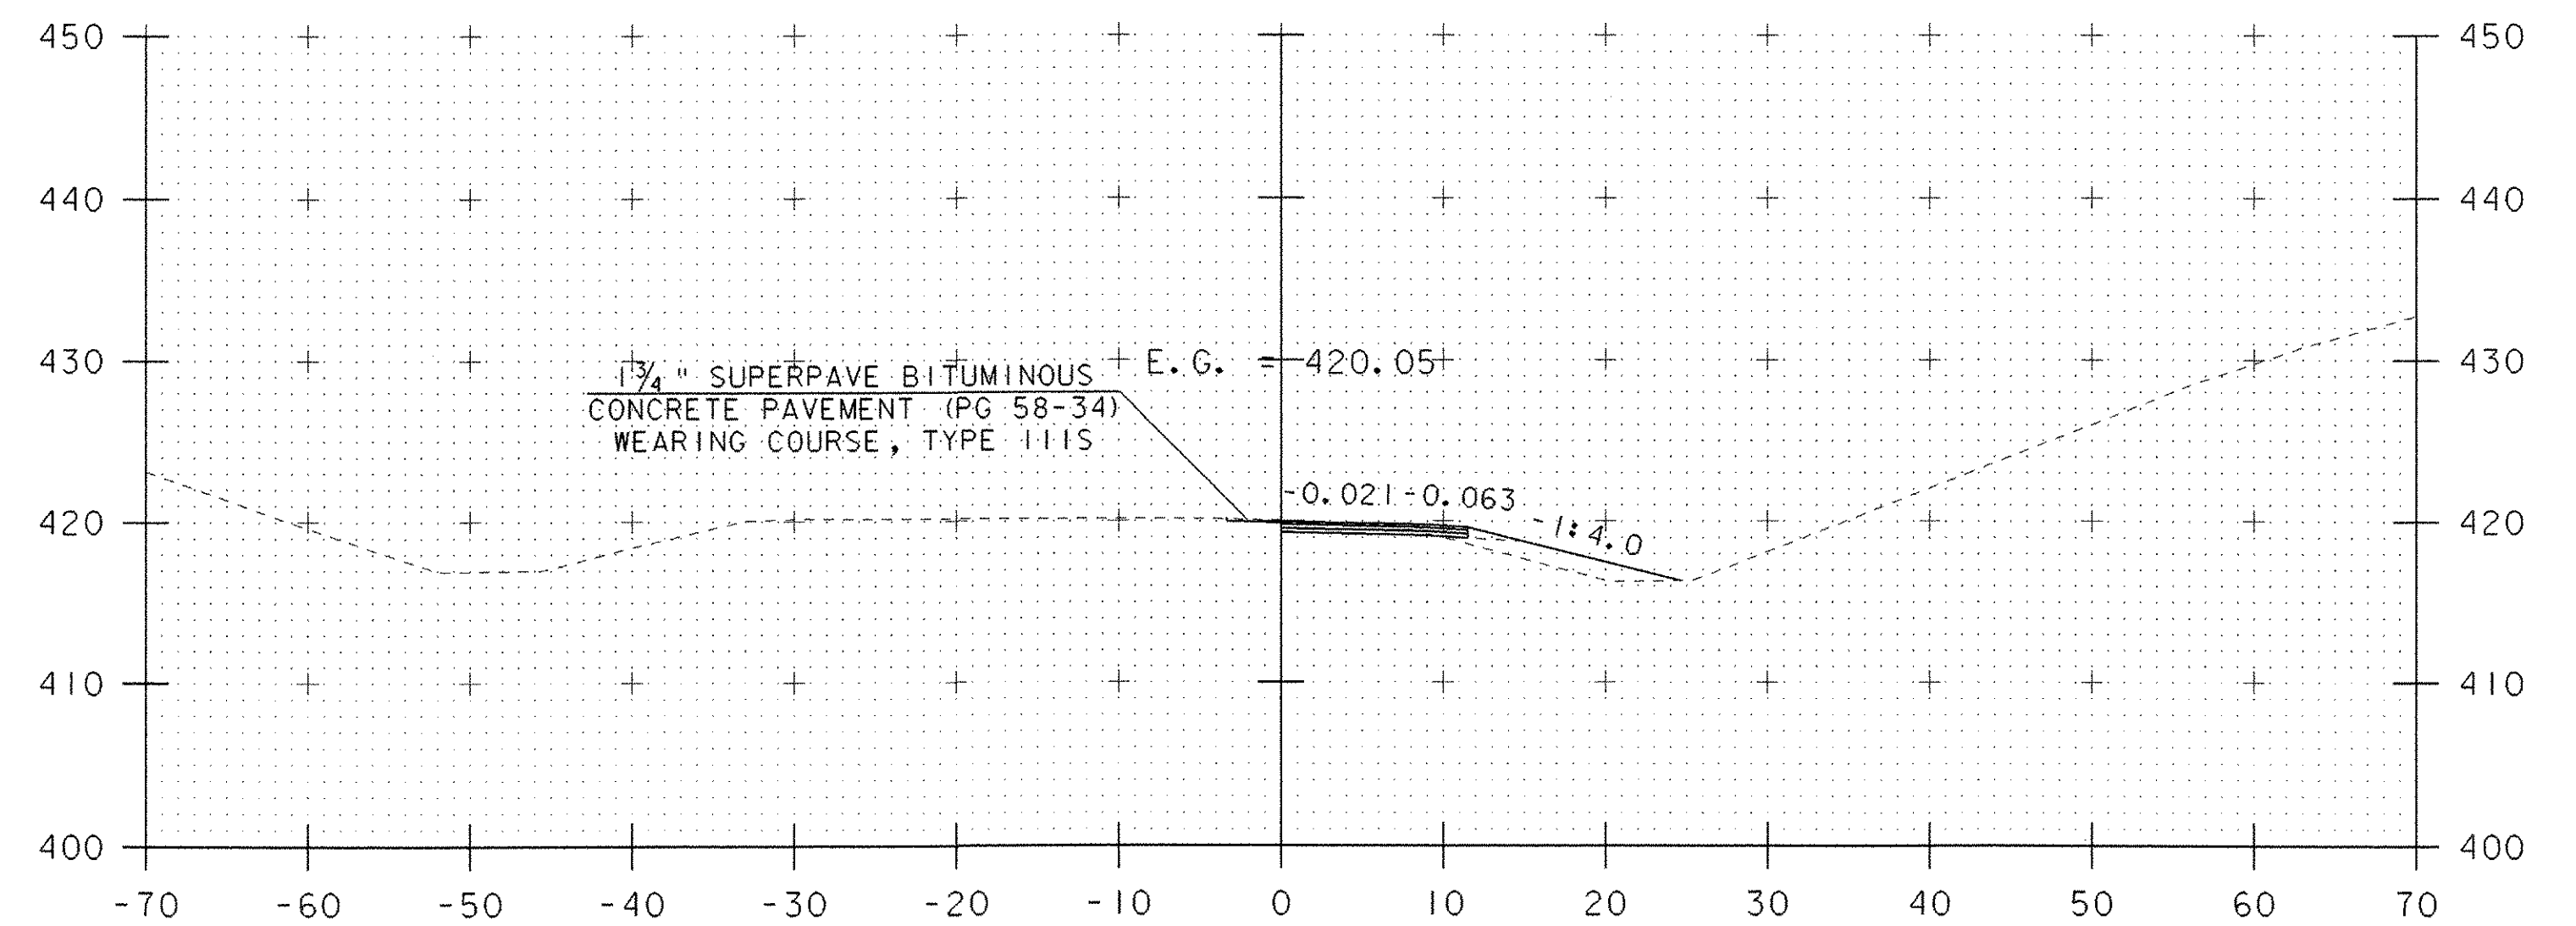

9+50

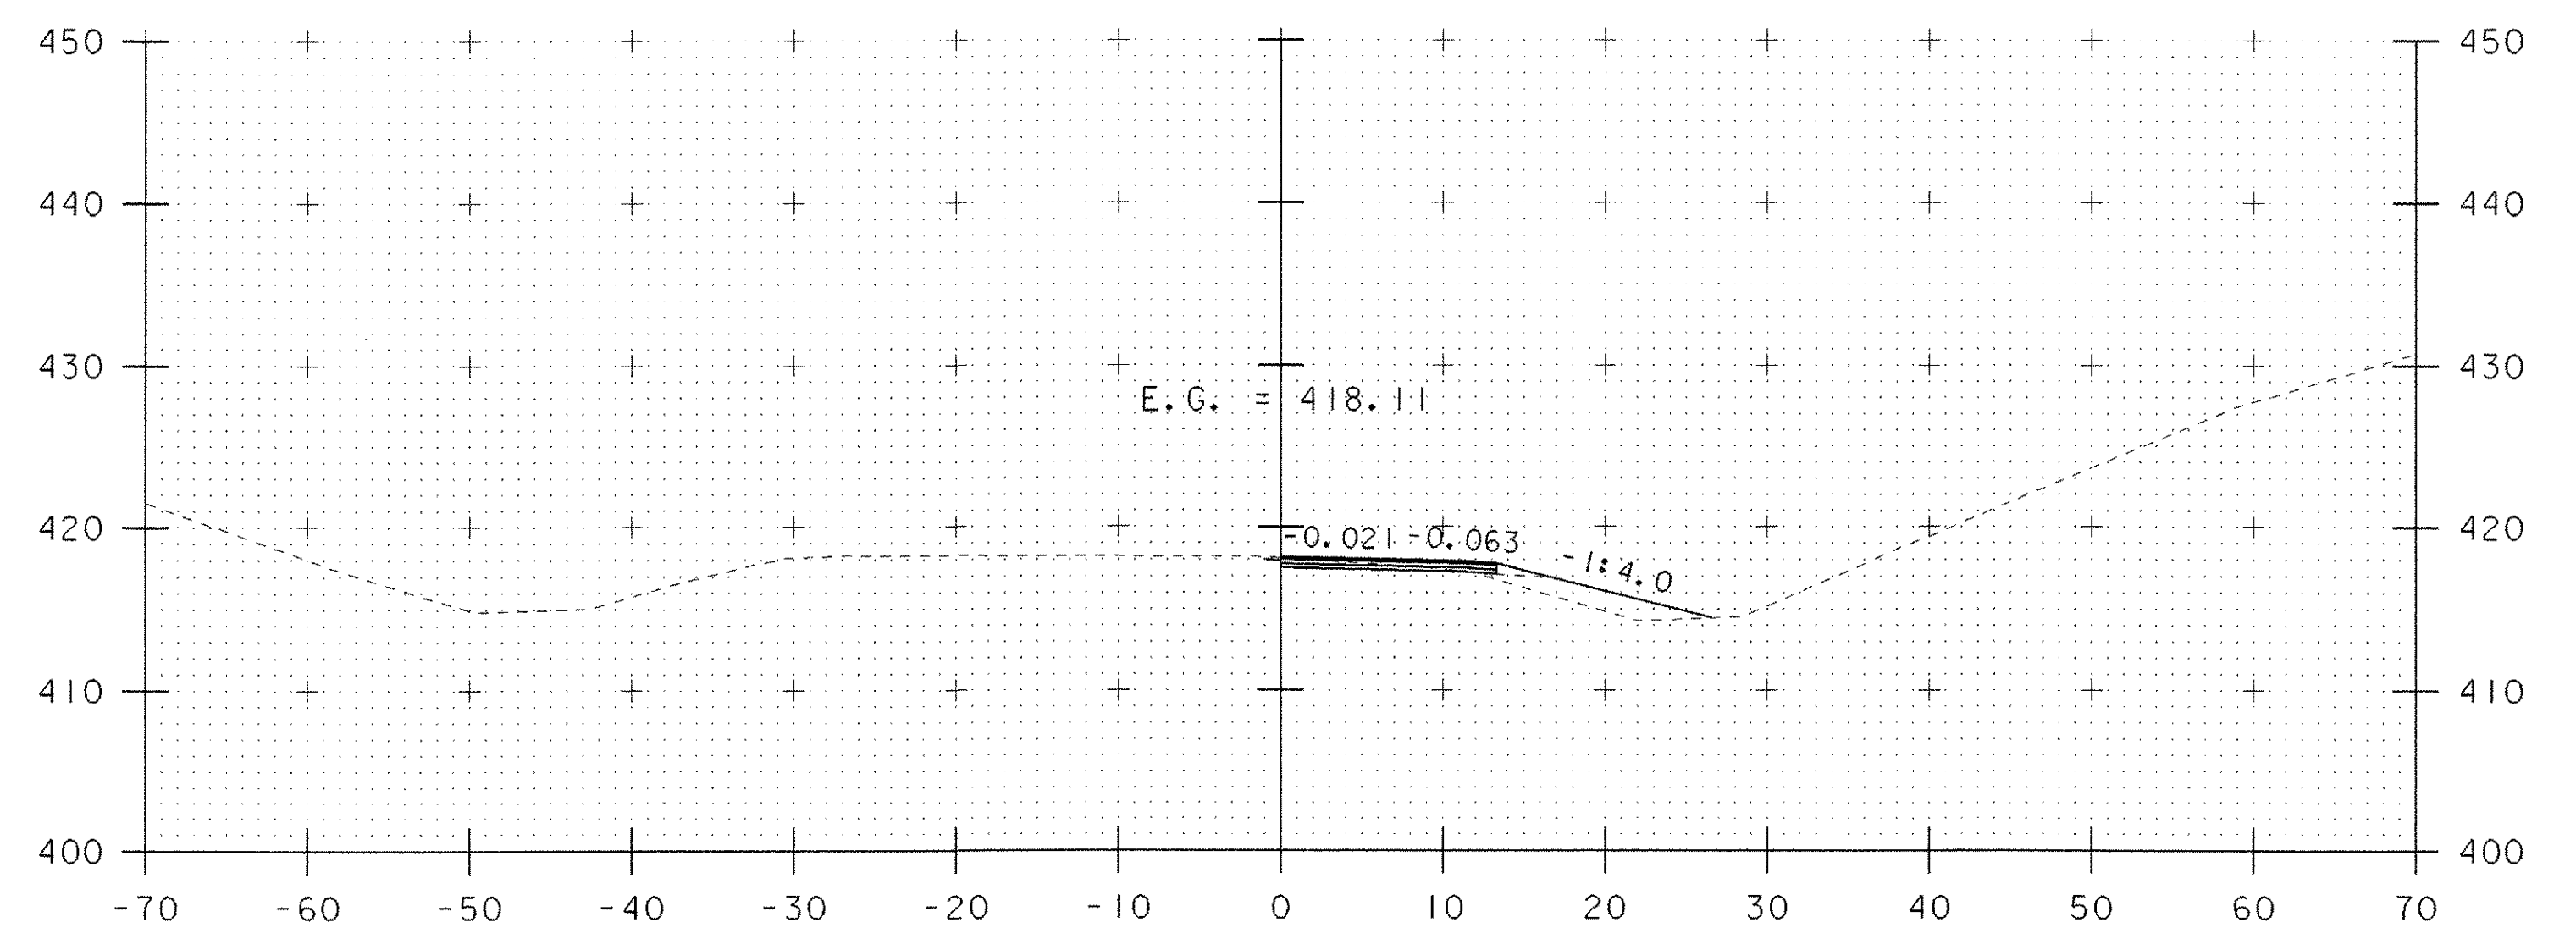

9+00

DATUM
 VERTICAL N/A
 HORIZONTAL N/A

SCALE 1" = 10' - 0"

PROJECT NAME: I-89 EXIT 12 SB OFF RAMP
 PROJECT NUMBER: IM 089-2(35)

FILE NAME: 618800F4XS01.dgn
 PROJECT LEADER: EPD
 DESIGNED BY: JDA
 STA. 7+50 TO STA. 9+50

PLOT DATE: 17-MAY-2005
 DRAWN BY: JDA / PGJ
 CHECKED BY: EPD
 SHEET 72 OF 76