




11+08

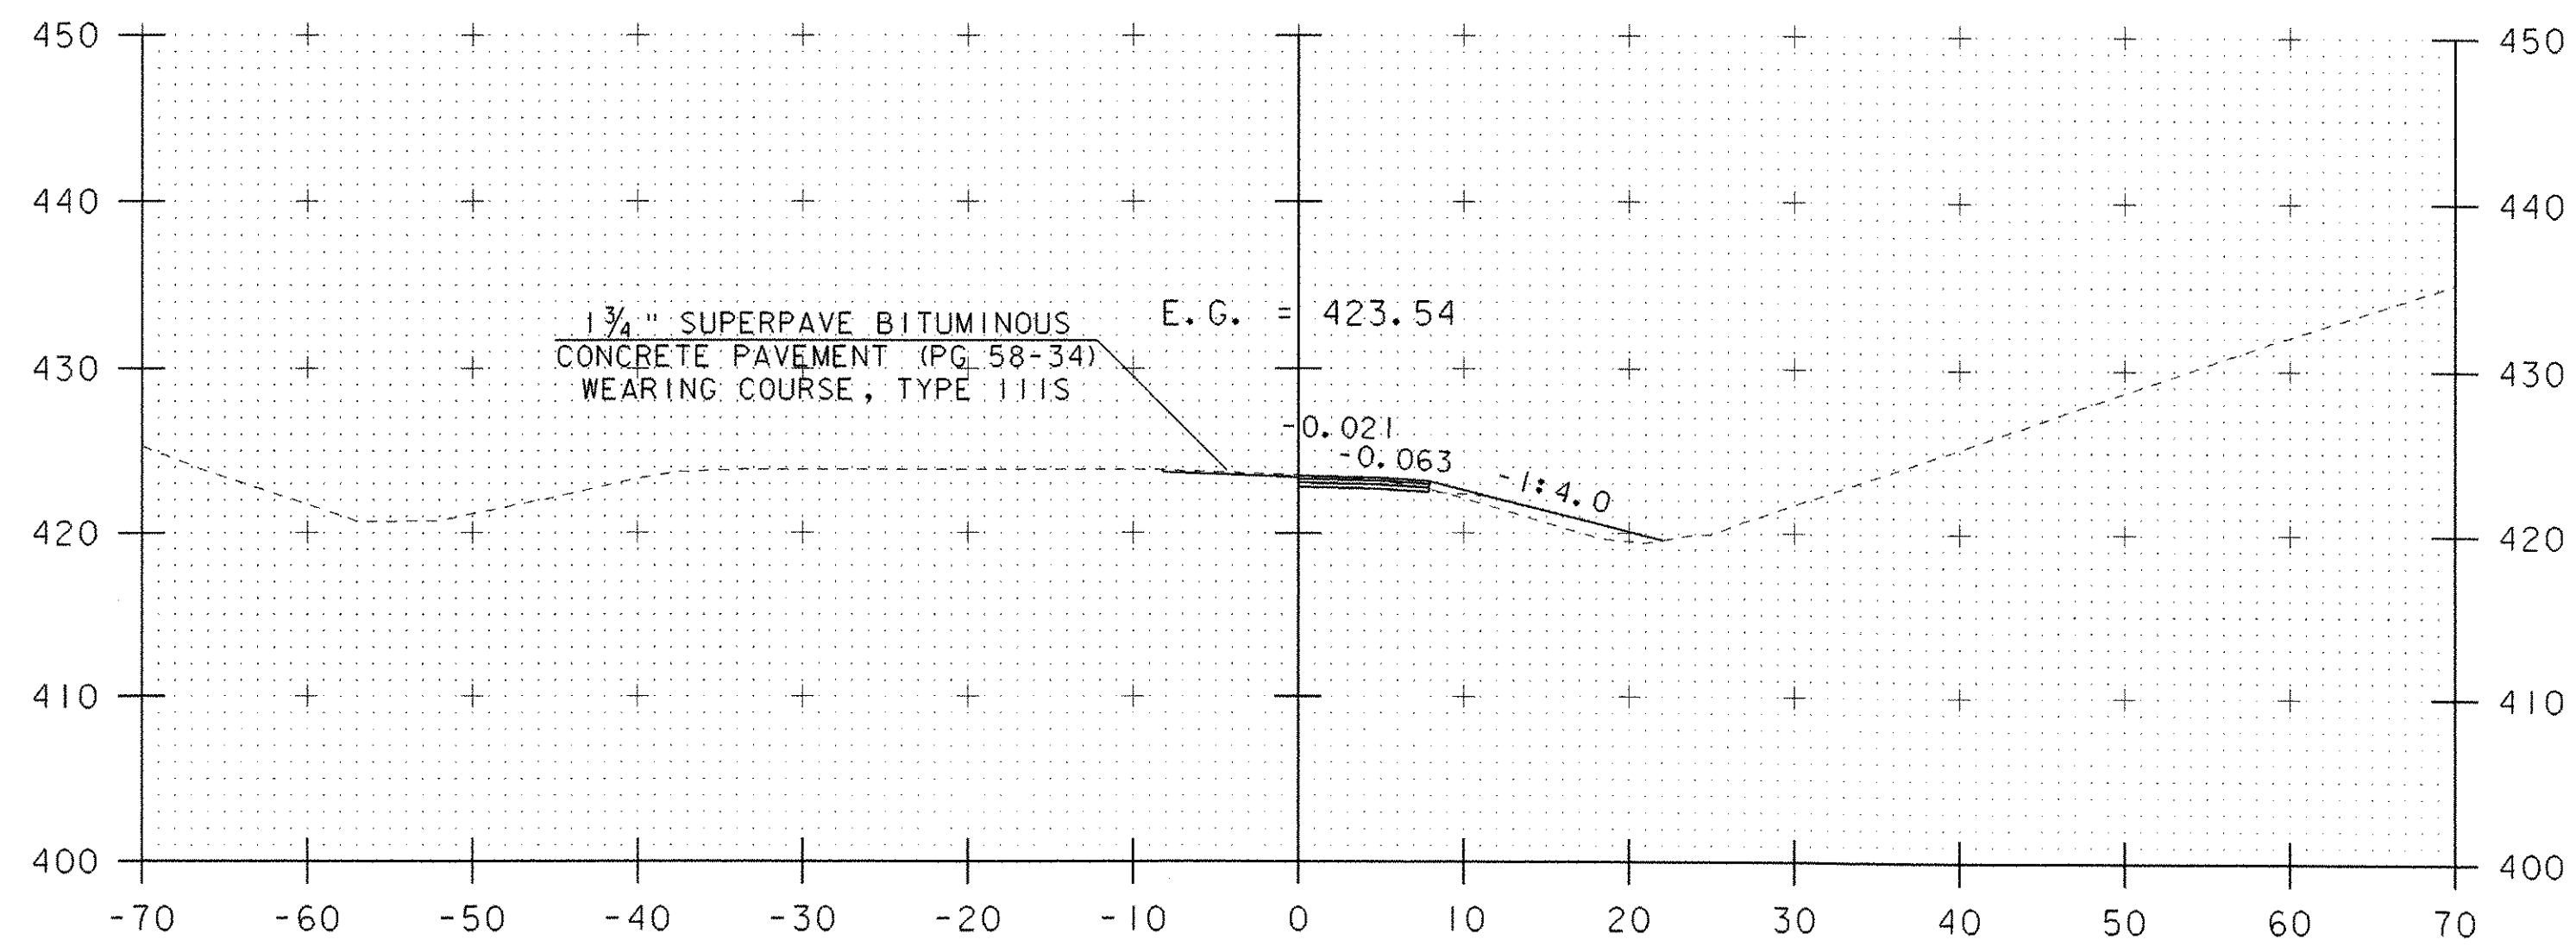


10+50

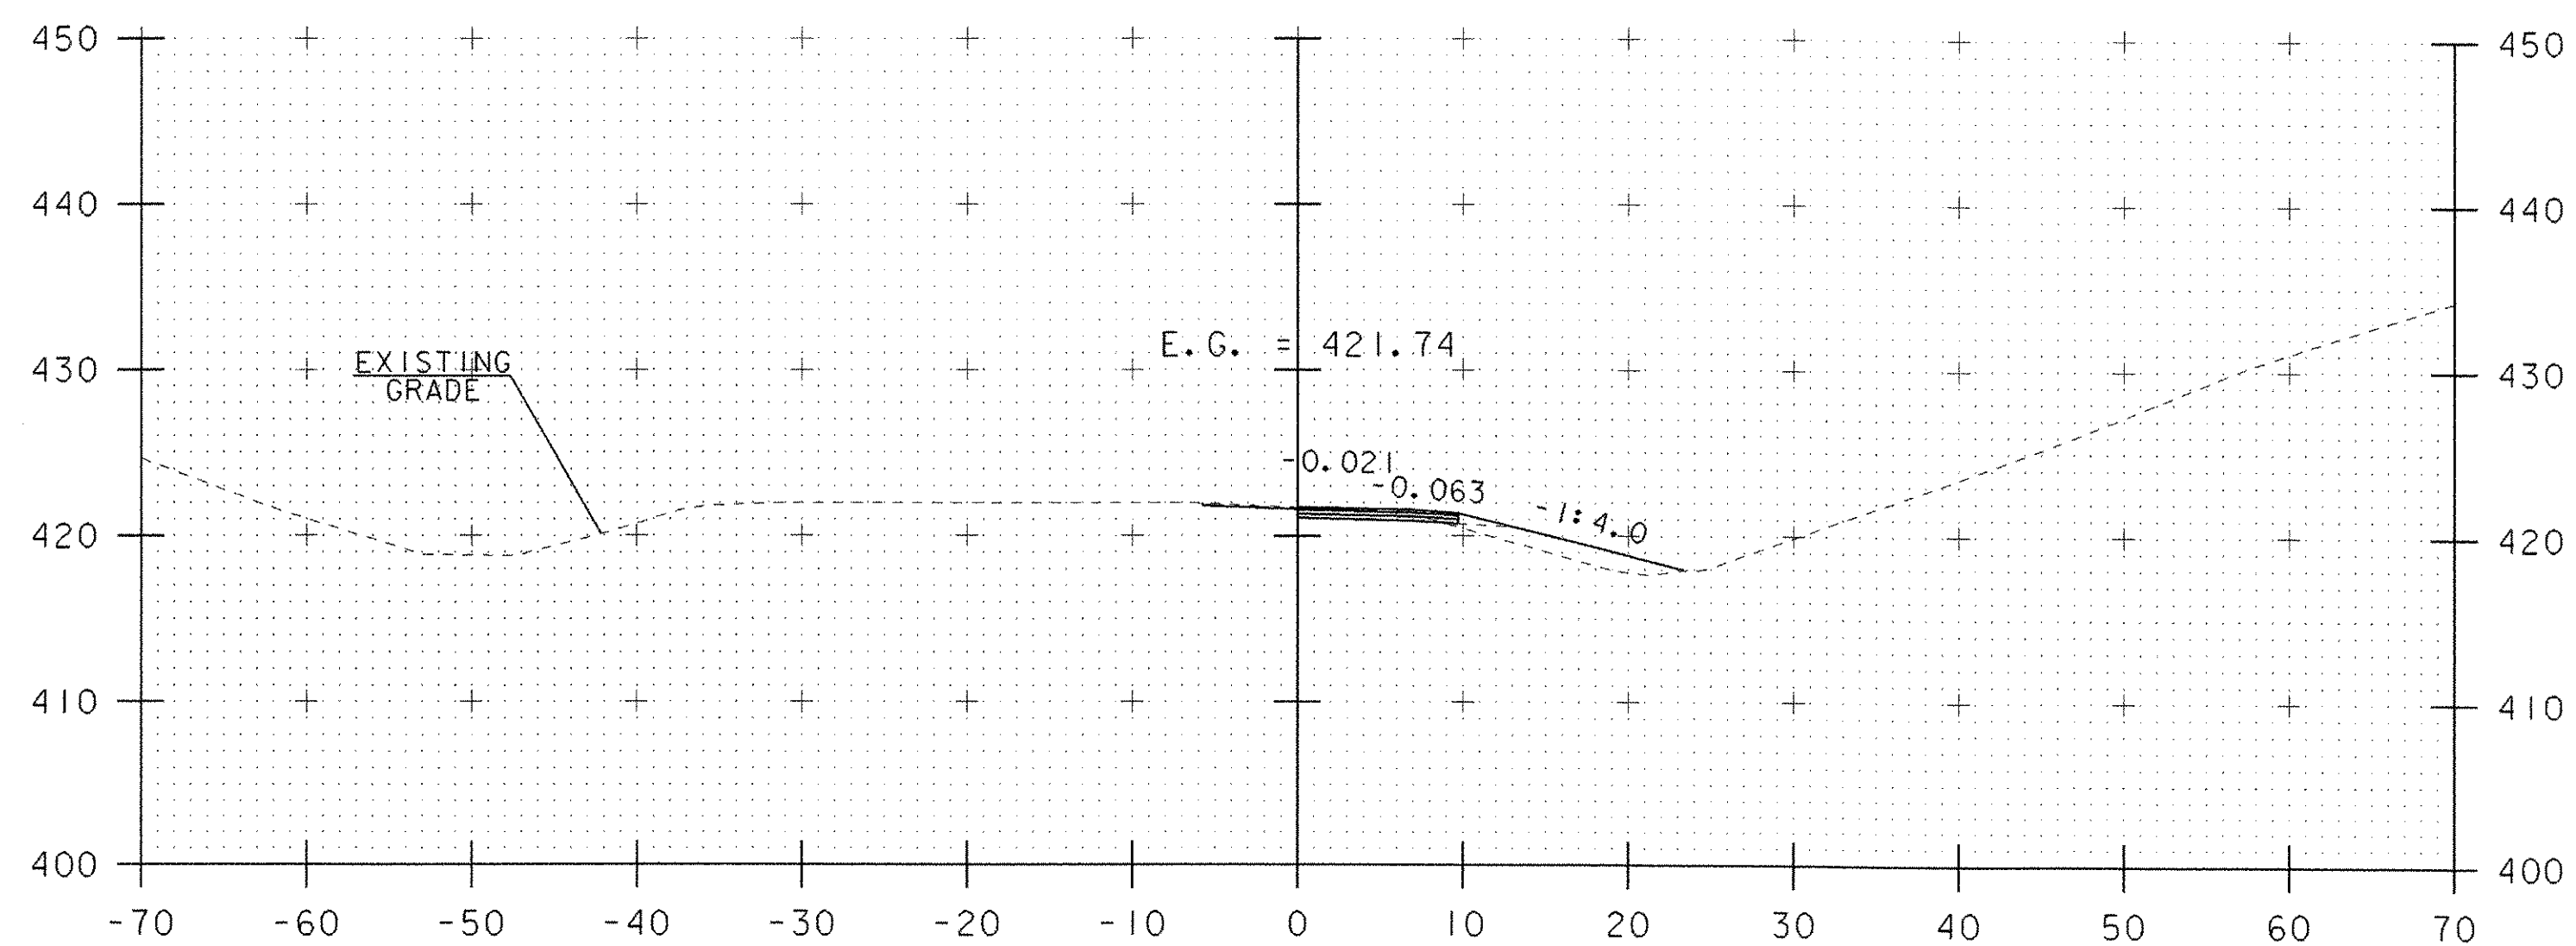


10+00

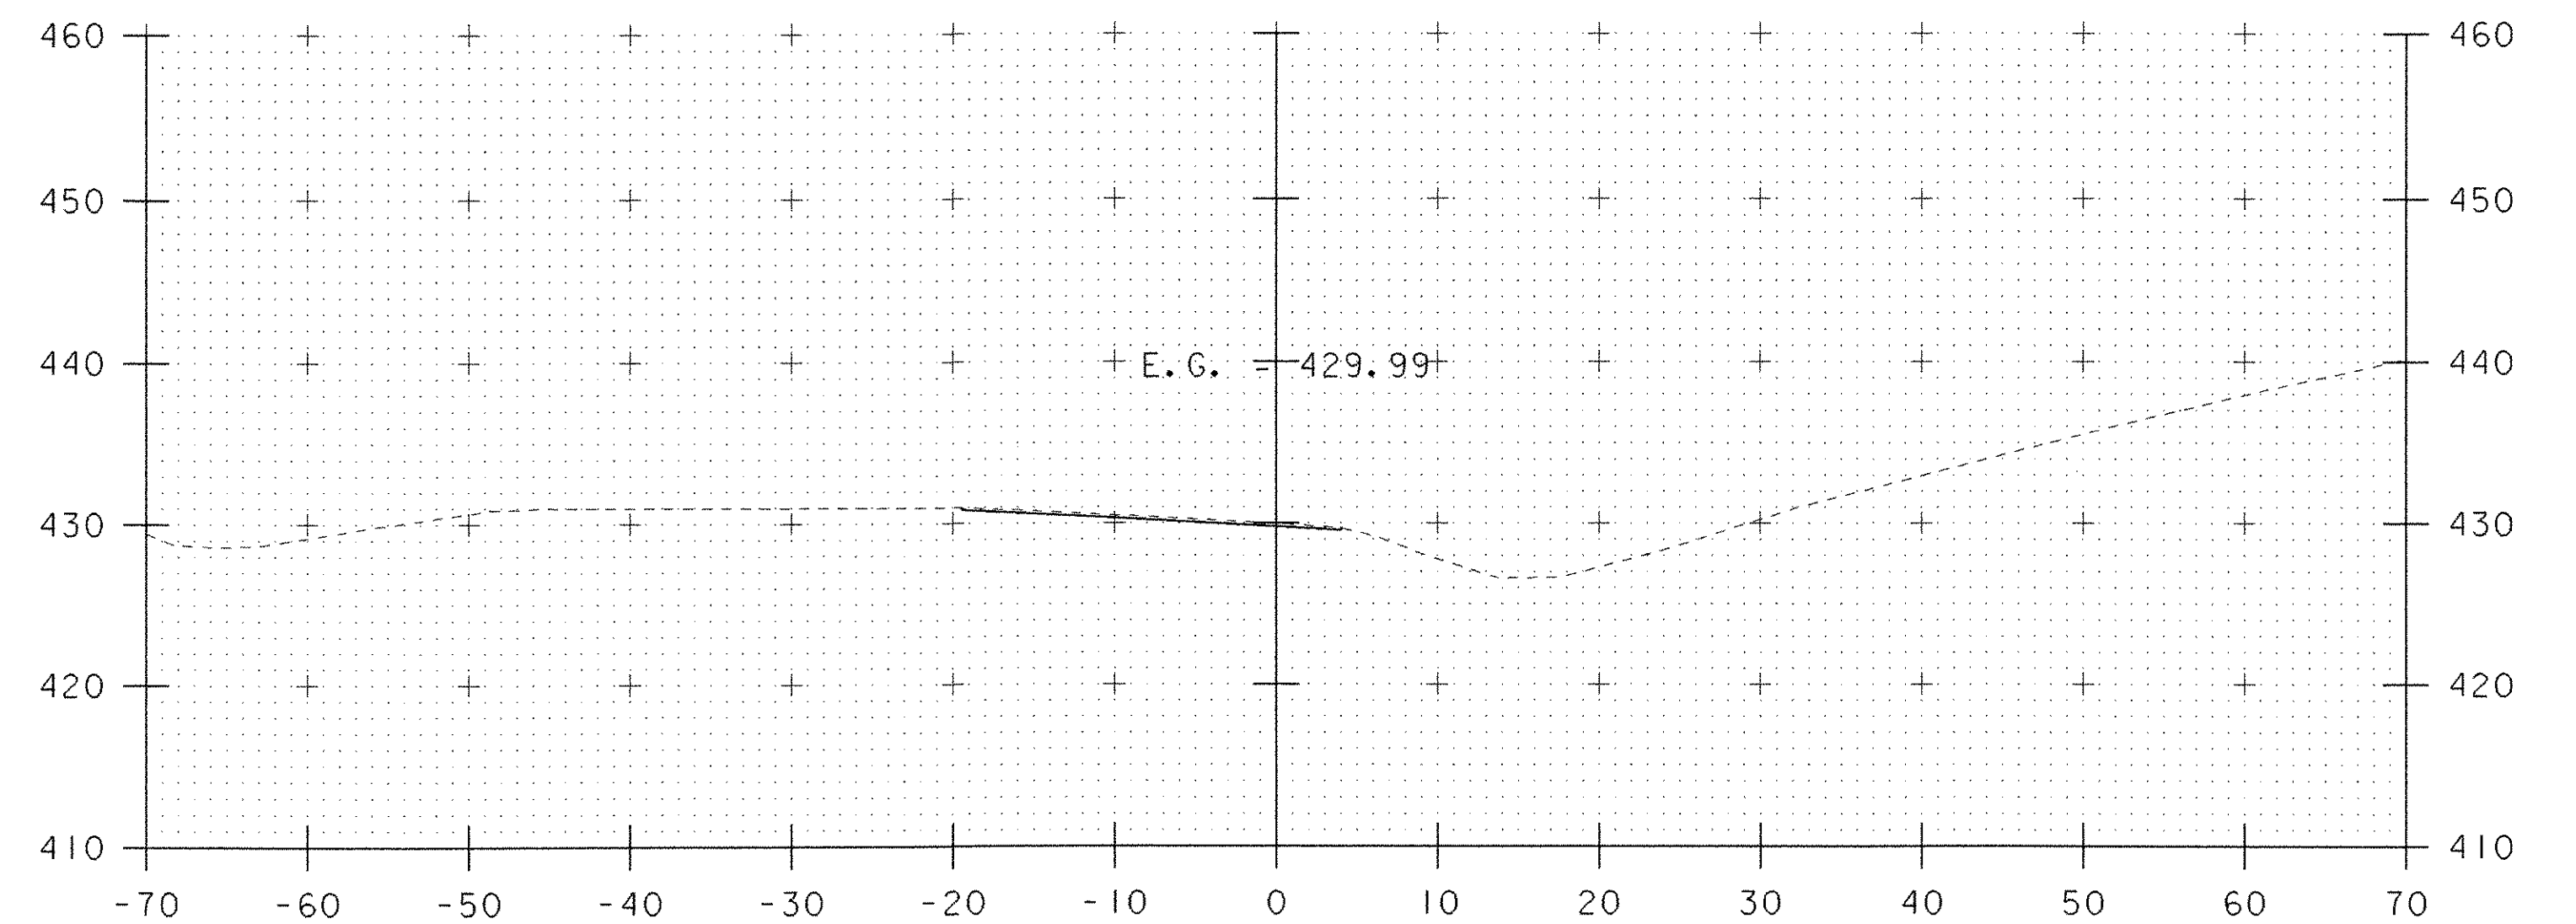

12+50

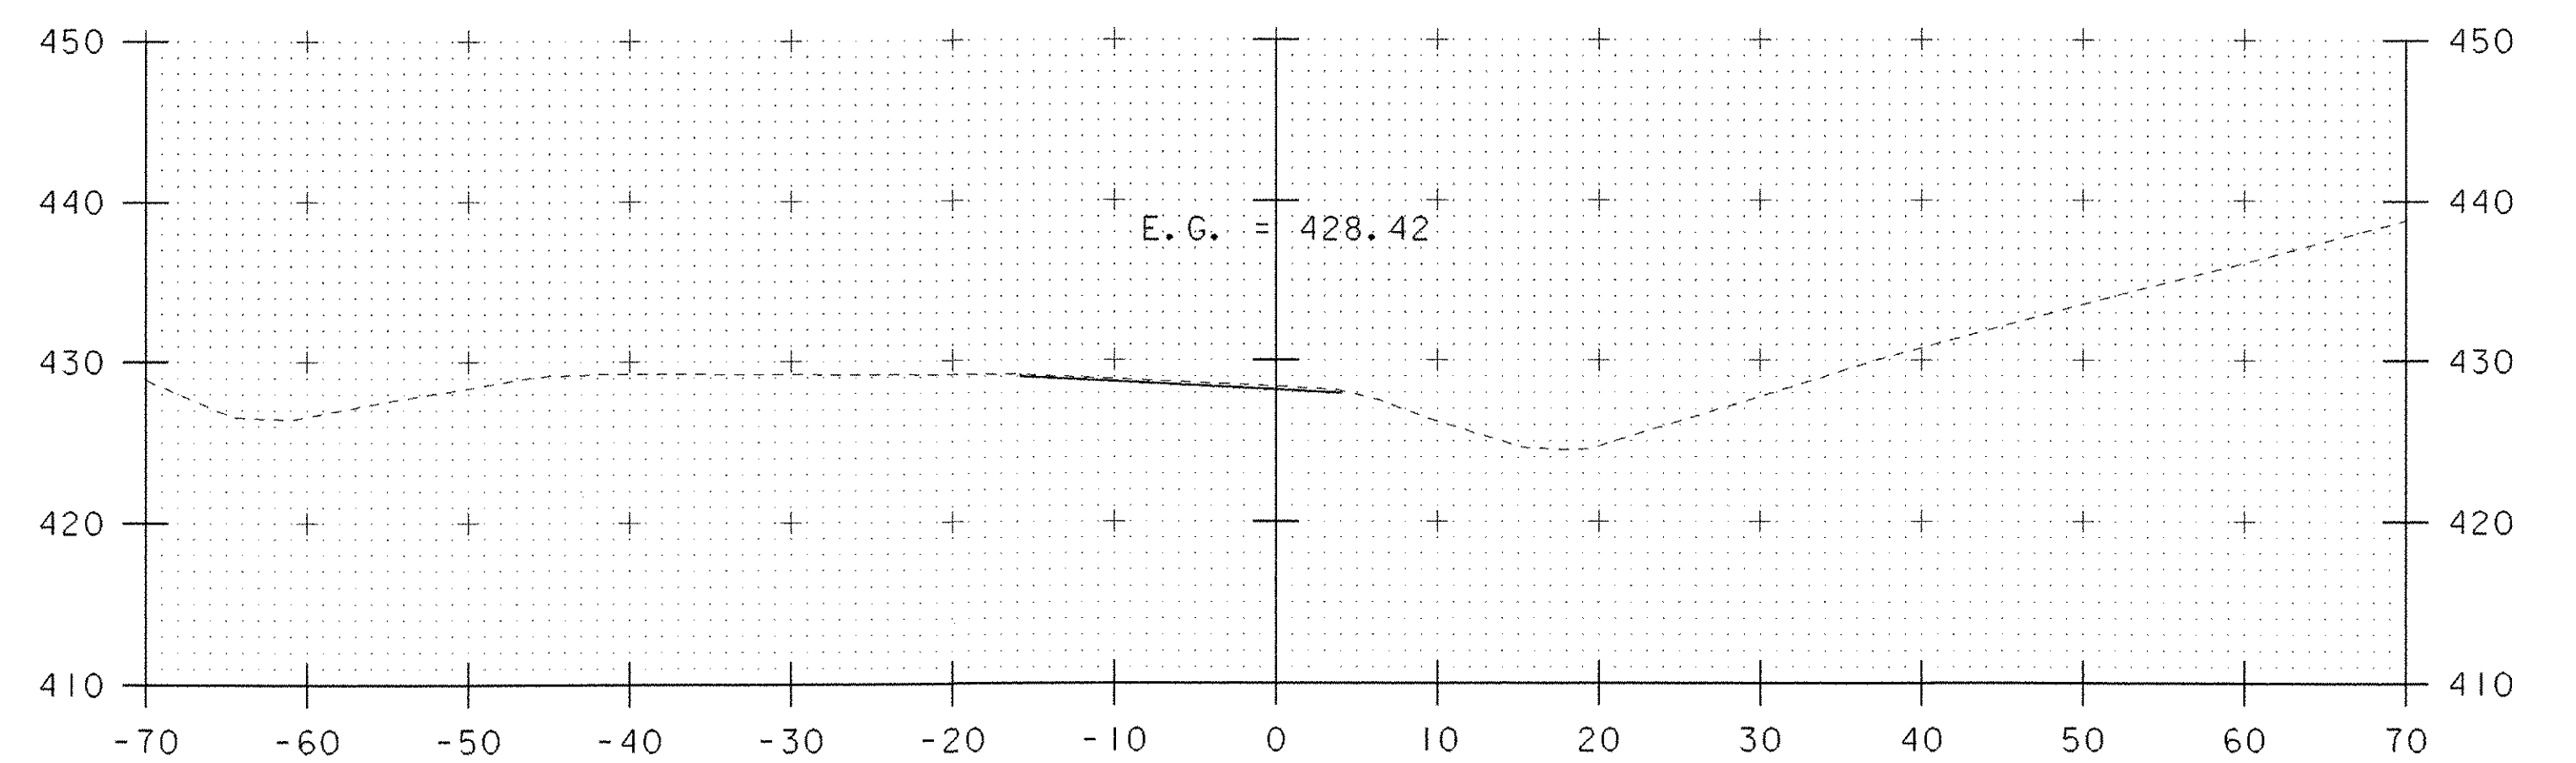

12+00

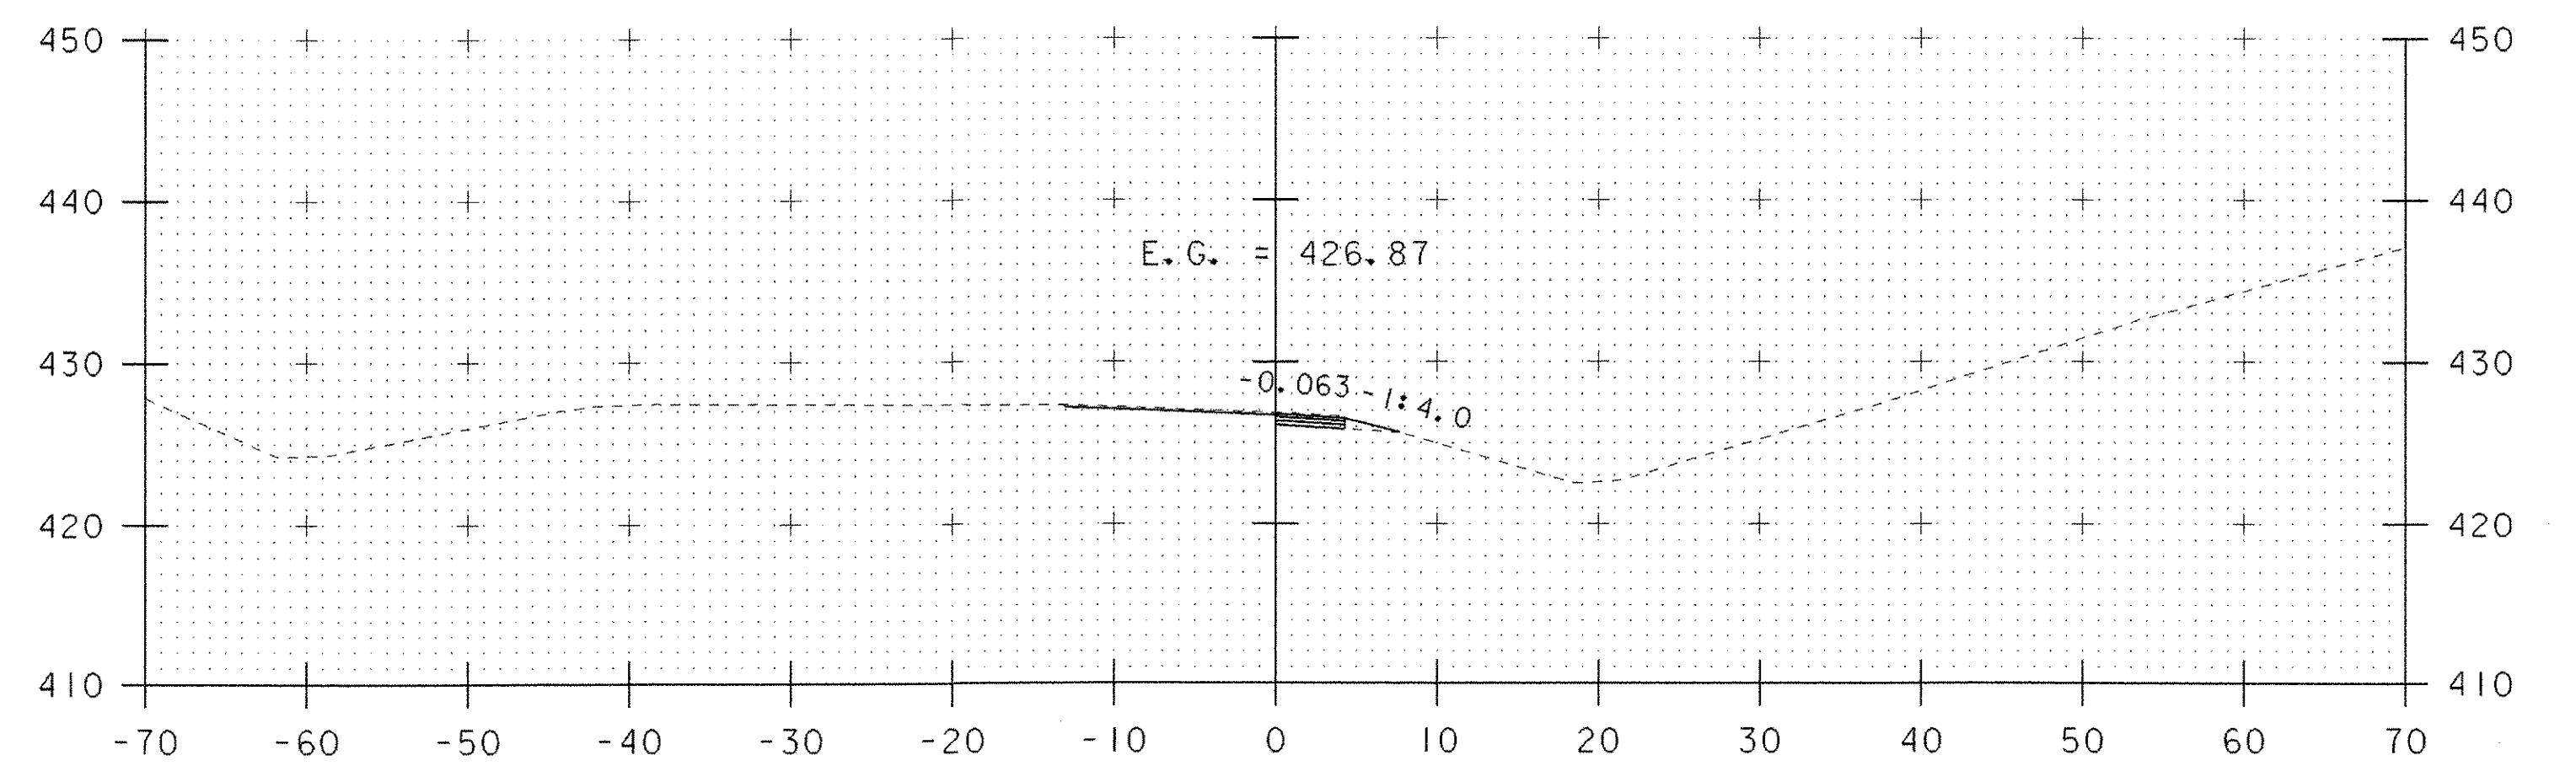

11+50

DATUM	
VERTICAL	N/A
HORIZONTAL	N/A



PROJECT NAME: I-89 EXIT 12 SB OFF RAMP  
PROJECT NUMBER: IM 089-2(35)

FILE NAME: 618800F4XS01.dgn  
PROJECT LEADER: EPD  
DESIGNED BY: JDA  
STA. 10+00 TO STA. 12+50

PLOT DATE: 17-MAY-2005  
DRAWN BY: JDA / PGJ  
CHECKED BY: EPD  
SHEET 73 OF 76