




14+00

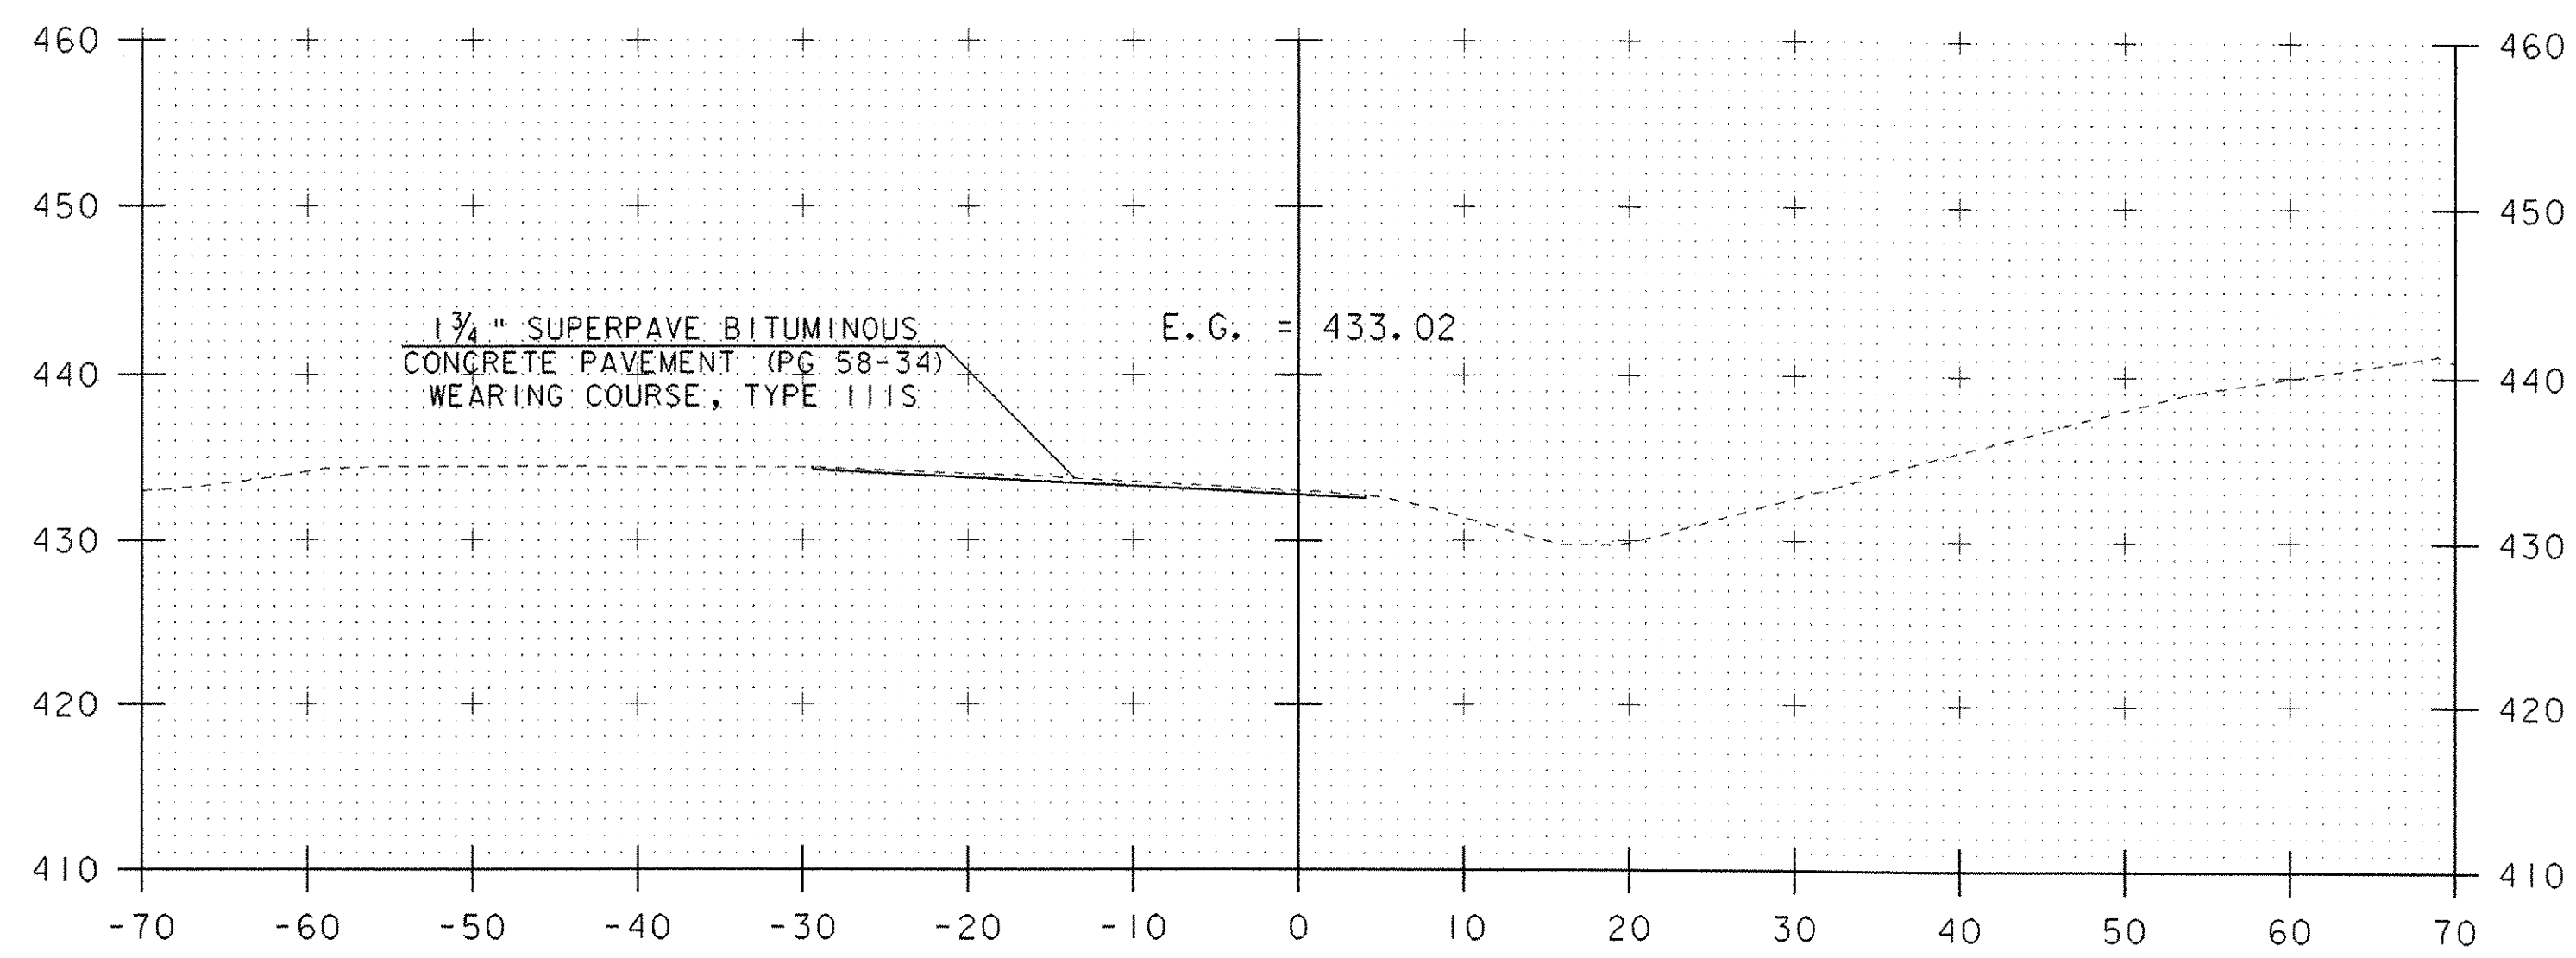


13+50

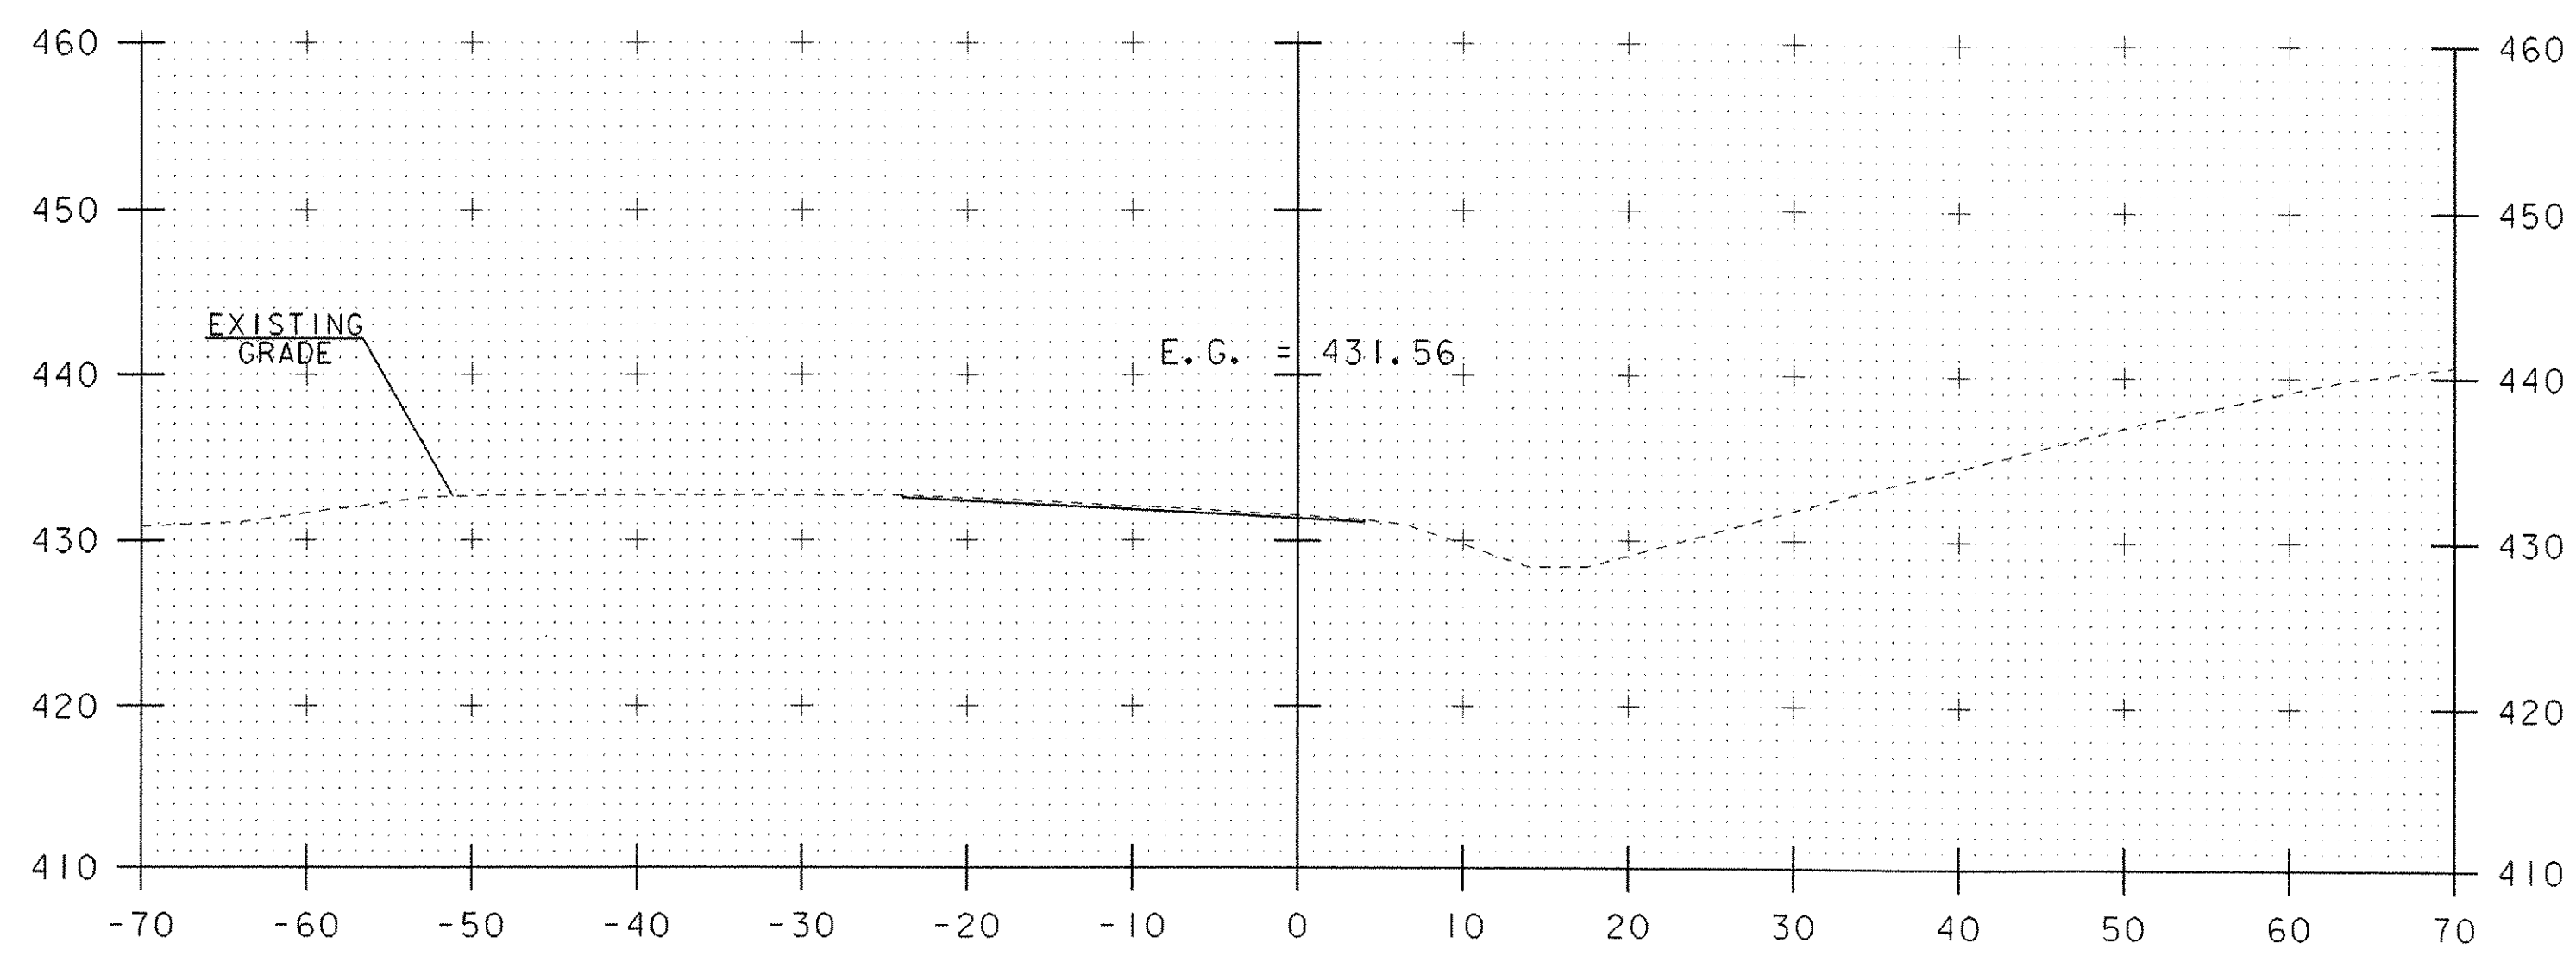


13+00

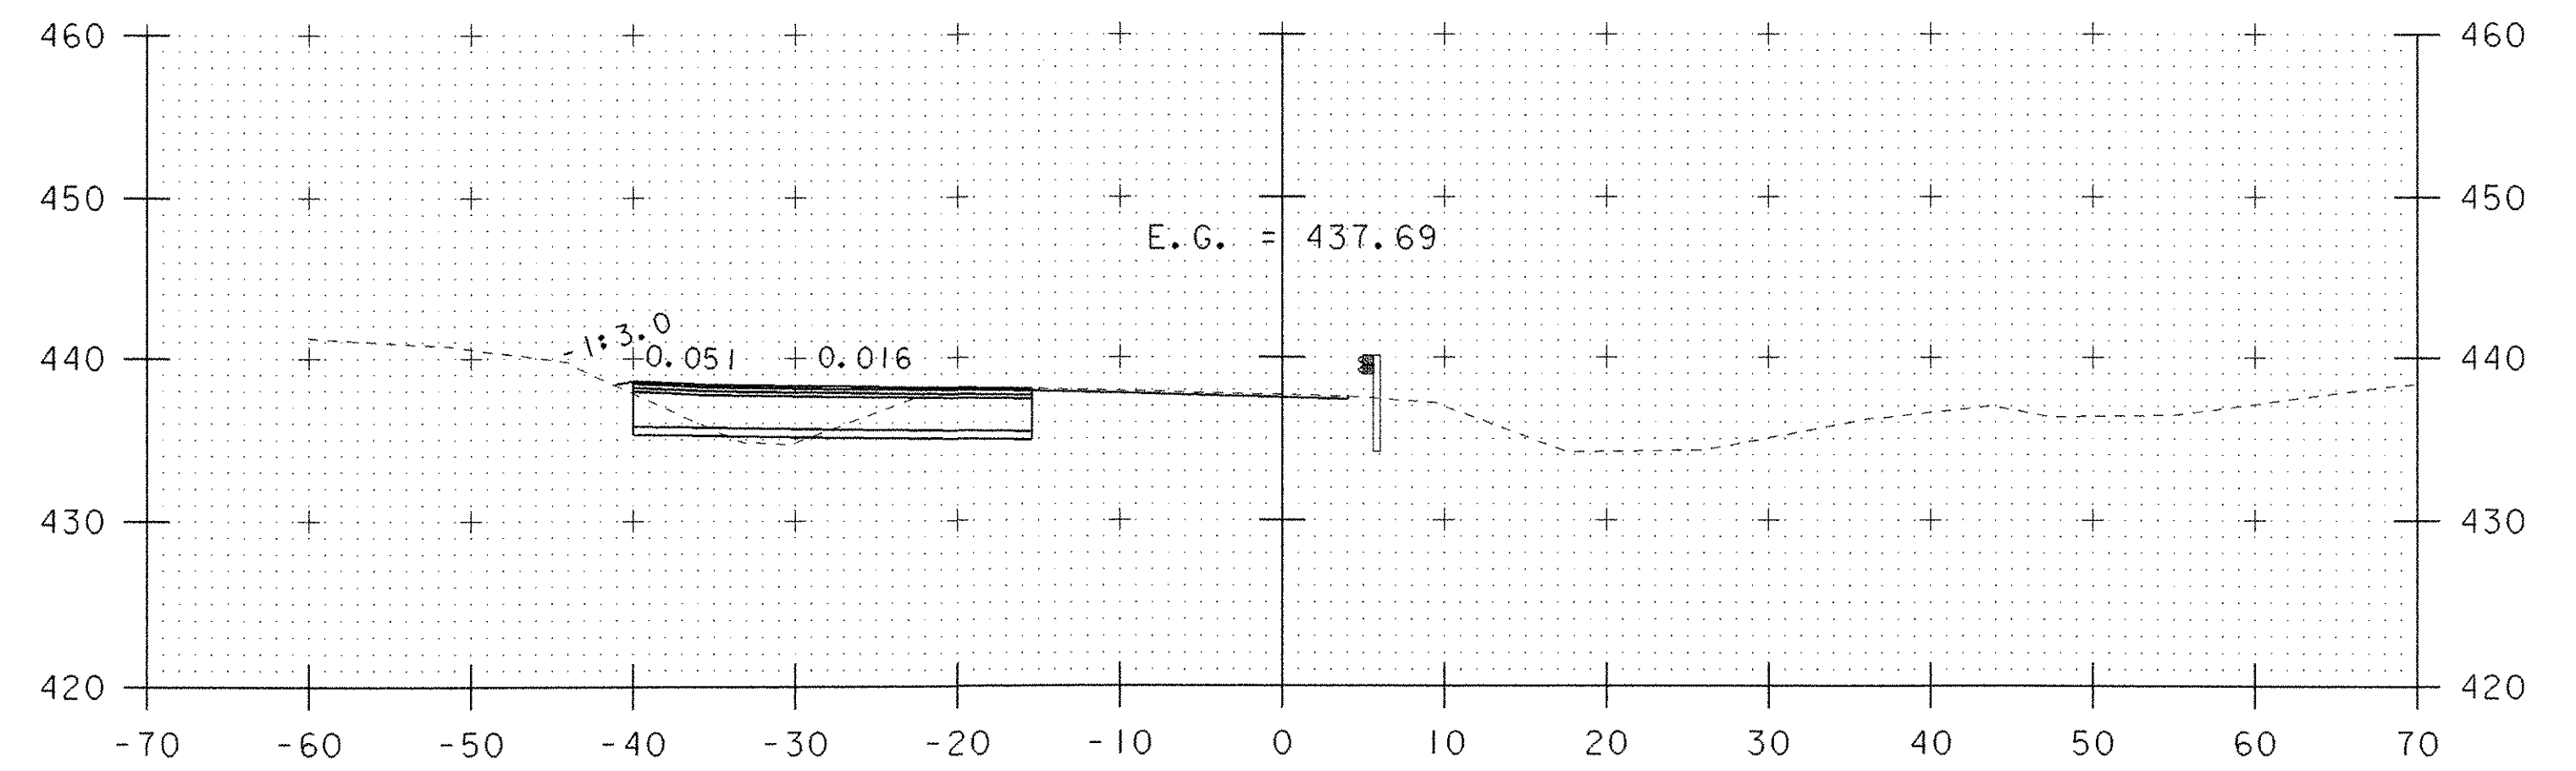

15+50

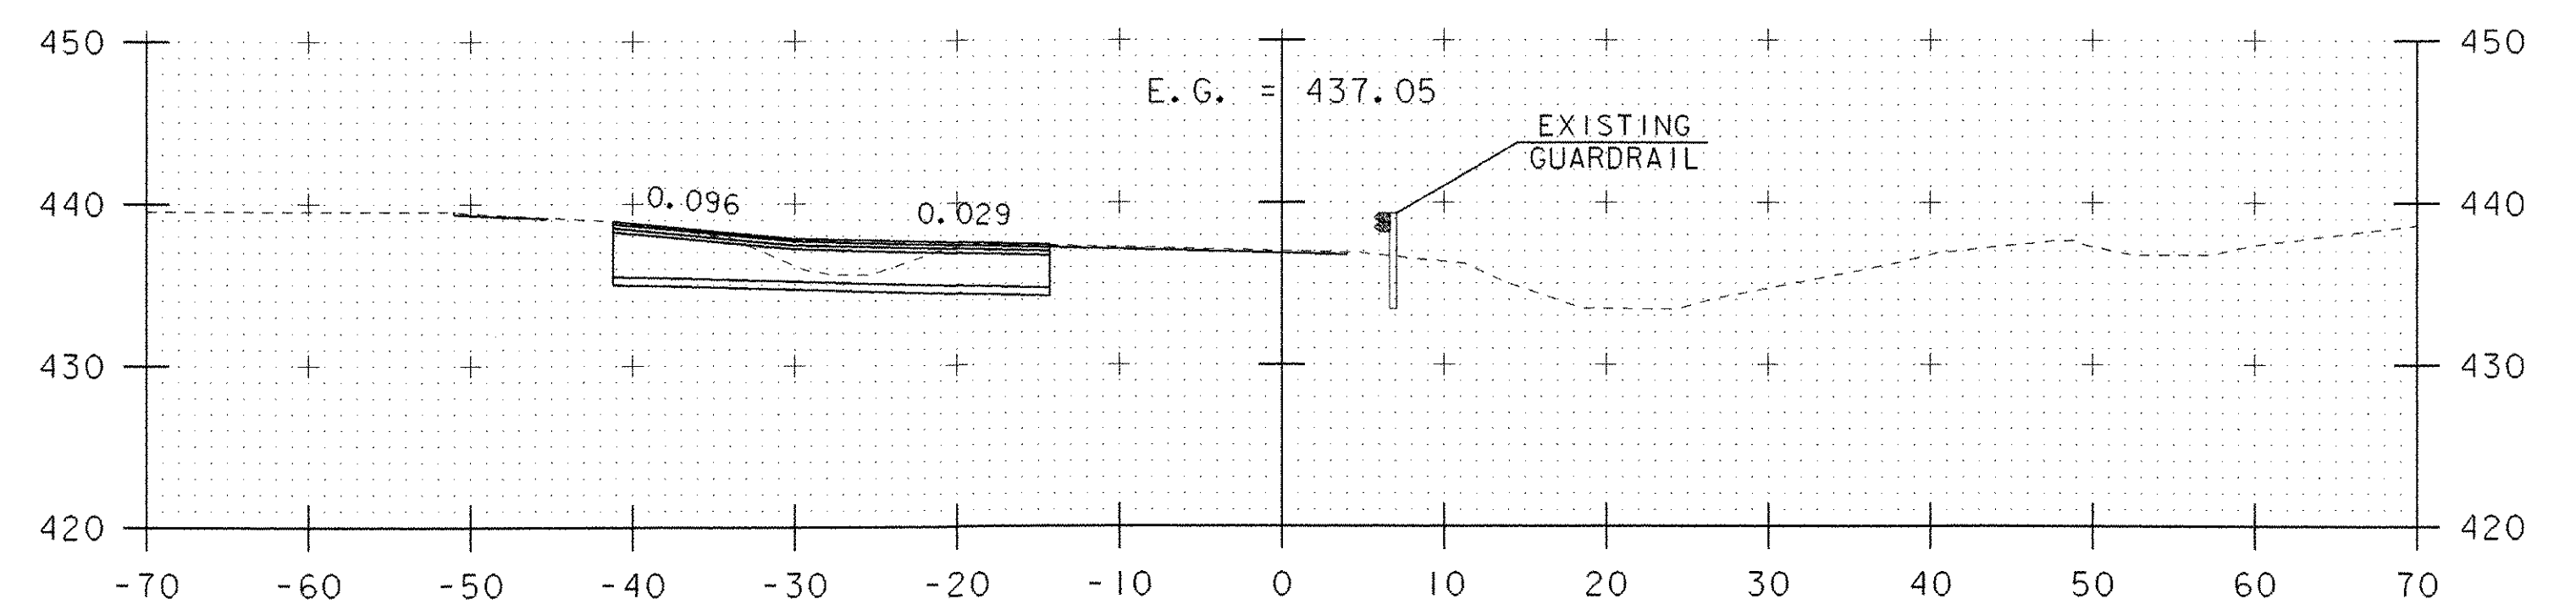


15+00

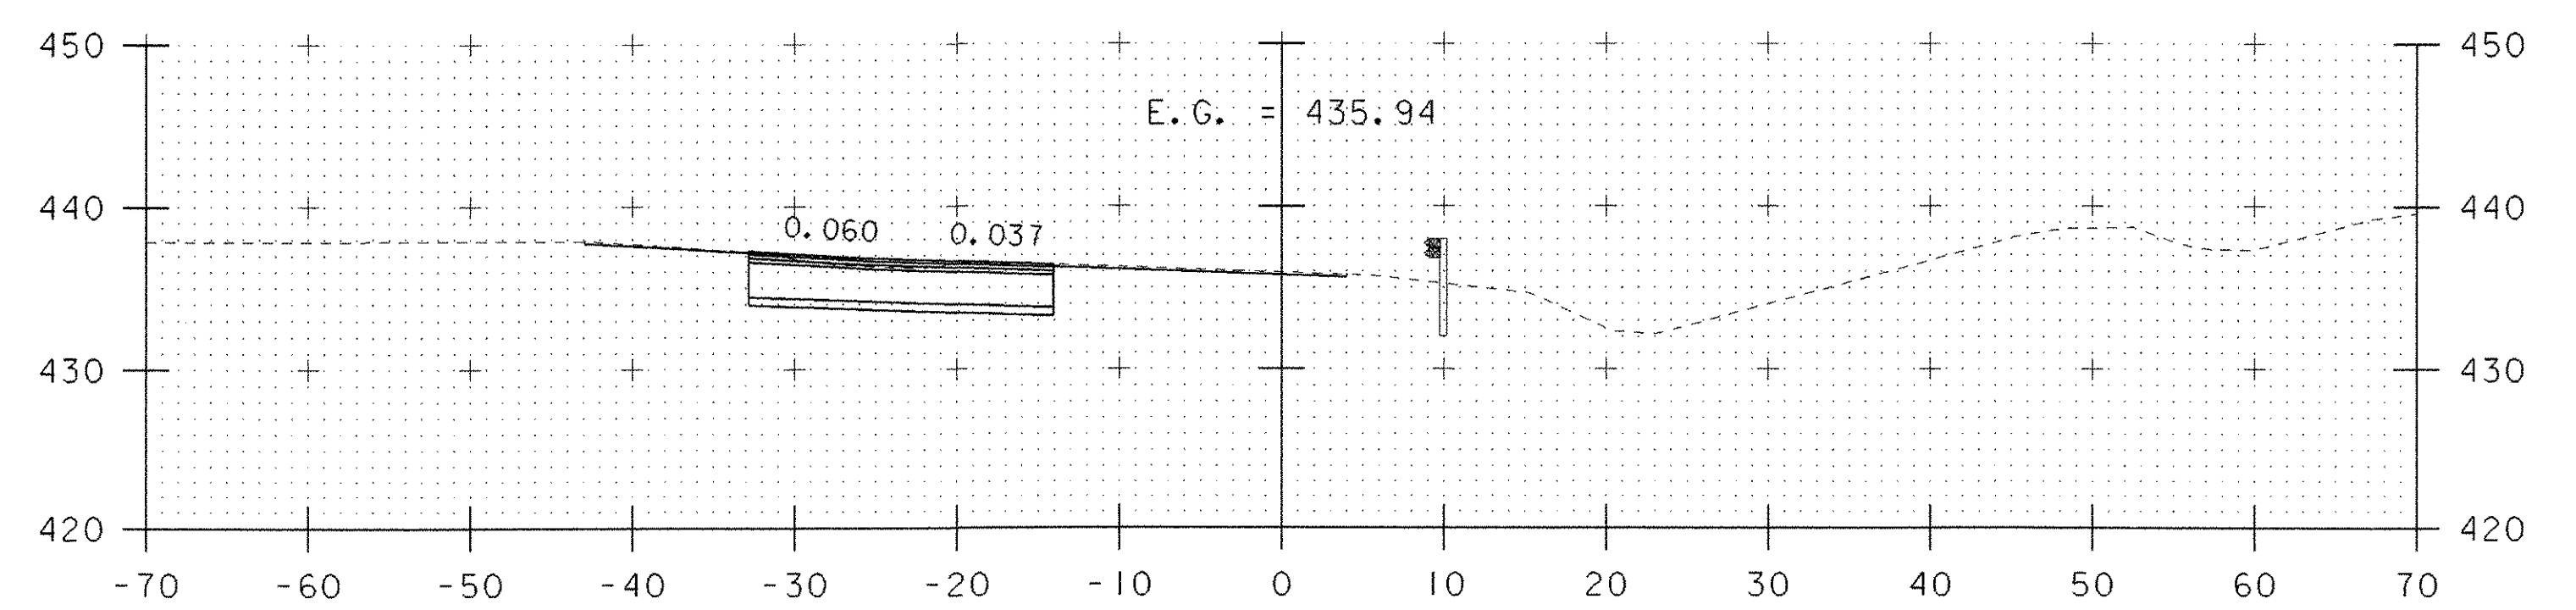

14+50

DATUM  
 VERTICAL N/A  
 HORIZONTAL N/A

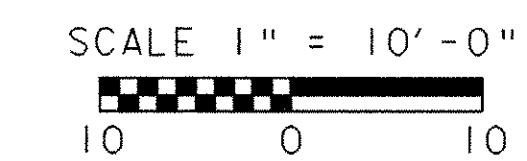

PROJECT NAME: I-89 EXIT 12 SB OFF RAMP  
 PROJECT NUMBER: IM 089-2(35)

FILE NAME: 618800F4XS01.dgn  
 PROJECT LEADER: EPD  
 DESIGNED BY: JDA  
 STA. 13+00 TO STA. 15+50

PLOT DATE: 17-MAY-2005  
 DRAWN BY: JDA / PGJ  
 CHECKED BY: EPD  
 SHEET 74 OF 76