


DATUM	
VERTICAL	N/A
HORIZONTAL	N/A

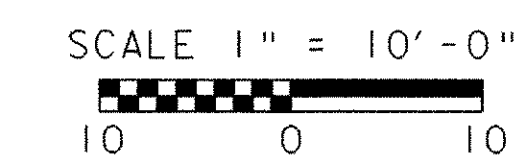

PROJECT NAME:	I-89 EXIT 12 SB OFF RAMP	PLOT DATE:	17-MAY-2005
PROJECT NUMBER:	IM 089-2(35)	DRAWN BY:	JDA / PGJ
FILE NAME:	618800F4XS01.dgn	CHECKED BY:	EPD
PROJECT LEADER:	EPD	DESIGNED BY:	JDA
STA. 16+00 TO STA. 18+50		SHEET	75 OF 76