


| | |
|------------|-----|
| DATUM | |
| VERTICAL | N/A |
| HORIZONTAL | N/A |

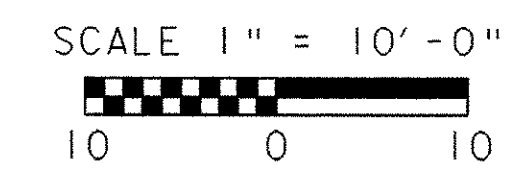

PROJECT NAME: I-89 EXIT 12 SB OFF RAMP
PROJECT NUMBER: IM 089-2(35)

| | |
|-----------------------------|------------------------|
| FILE NAME: 618800F4XS01.dgn | PLOT DATE: 17-MAY-2005 |
| PROJECT LEADER: EPD | DRAWN BY: JDA / PGJ |
| DESIGNED BY: JDA | CHECKED BY: EPD |
| STA. 19+00 TO STA. 21+43 | SHEET 76 OF 76 |