


604.412 REHABING DROP INLETS, CATCH BASINS, OR MANHOLES, CLASS I
 STA. 7+50 RAMP A LT
 STA. 4+00 RAMP B RT
 STA. 6+50 RAMP B RT

646.426 DURABLE 6 INCH WHITE LINE, RECESSED
 STA. 4843+61 - STA. 4844+71 SOUTHBOUND LT (DASHED)
 STA. 4844+71 - STA. 4847+61 SOUTHBOUND LT (DOTTED)
 STA. 0+00 - STA. 10+31 RAMP A RT (SOLID)
 STA. 4842+22 - STA. 4845+22 NORTHBOUND RT (DASHED)
 STA. 0+81 - STA. 10+54 RAMP B RT (SOLID)
 STA. 4818+56 - STA. 4820+96 SOUTHBOUND LT (DASHED)
 STA. 0+80 - STA. 6+87 RAMP C RT (SOLID)
 STA. 4818+11 - STA. 4820+86 NORTHBOUND RT (DOTTED)
 STA. 4820+86 - STA. 4821+81 NORTHBOUND RT (DASHED)
 STA. 0+00 - STA. 4+60 RAMP D RT (SOLID)

646.436 DURABLE 6 INCH YELLOW LINE, RECESSED
 STA. 1+95 - STA. 10+31 RAMP A LT (SOLID)
 STA. 0+81 - STA. 9+29 RAMP B LT (SOLID)
 STA. 0+80 - STA. 5+63 RAMP C LT (SOLID)
 STA. 0+92 - STA. 4+60 RAMP D LT (SOLID)

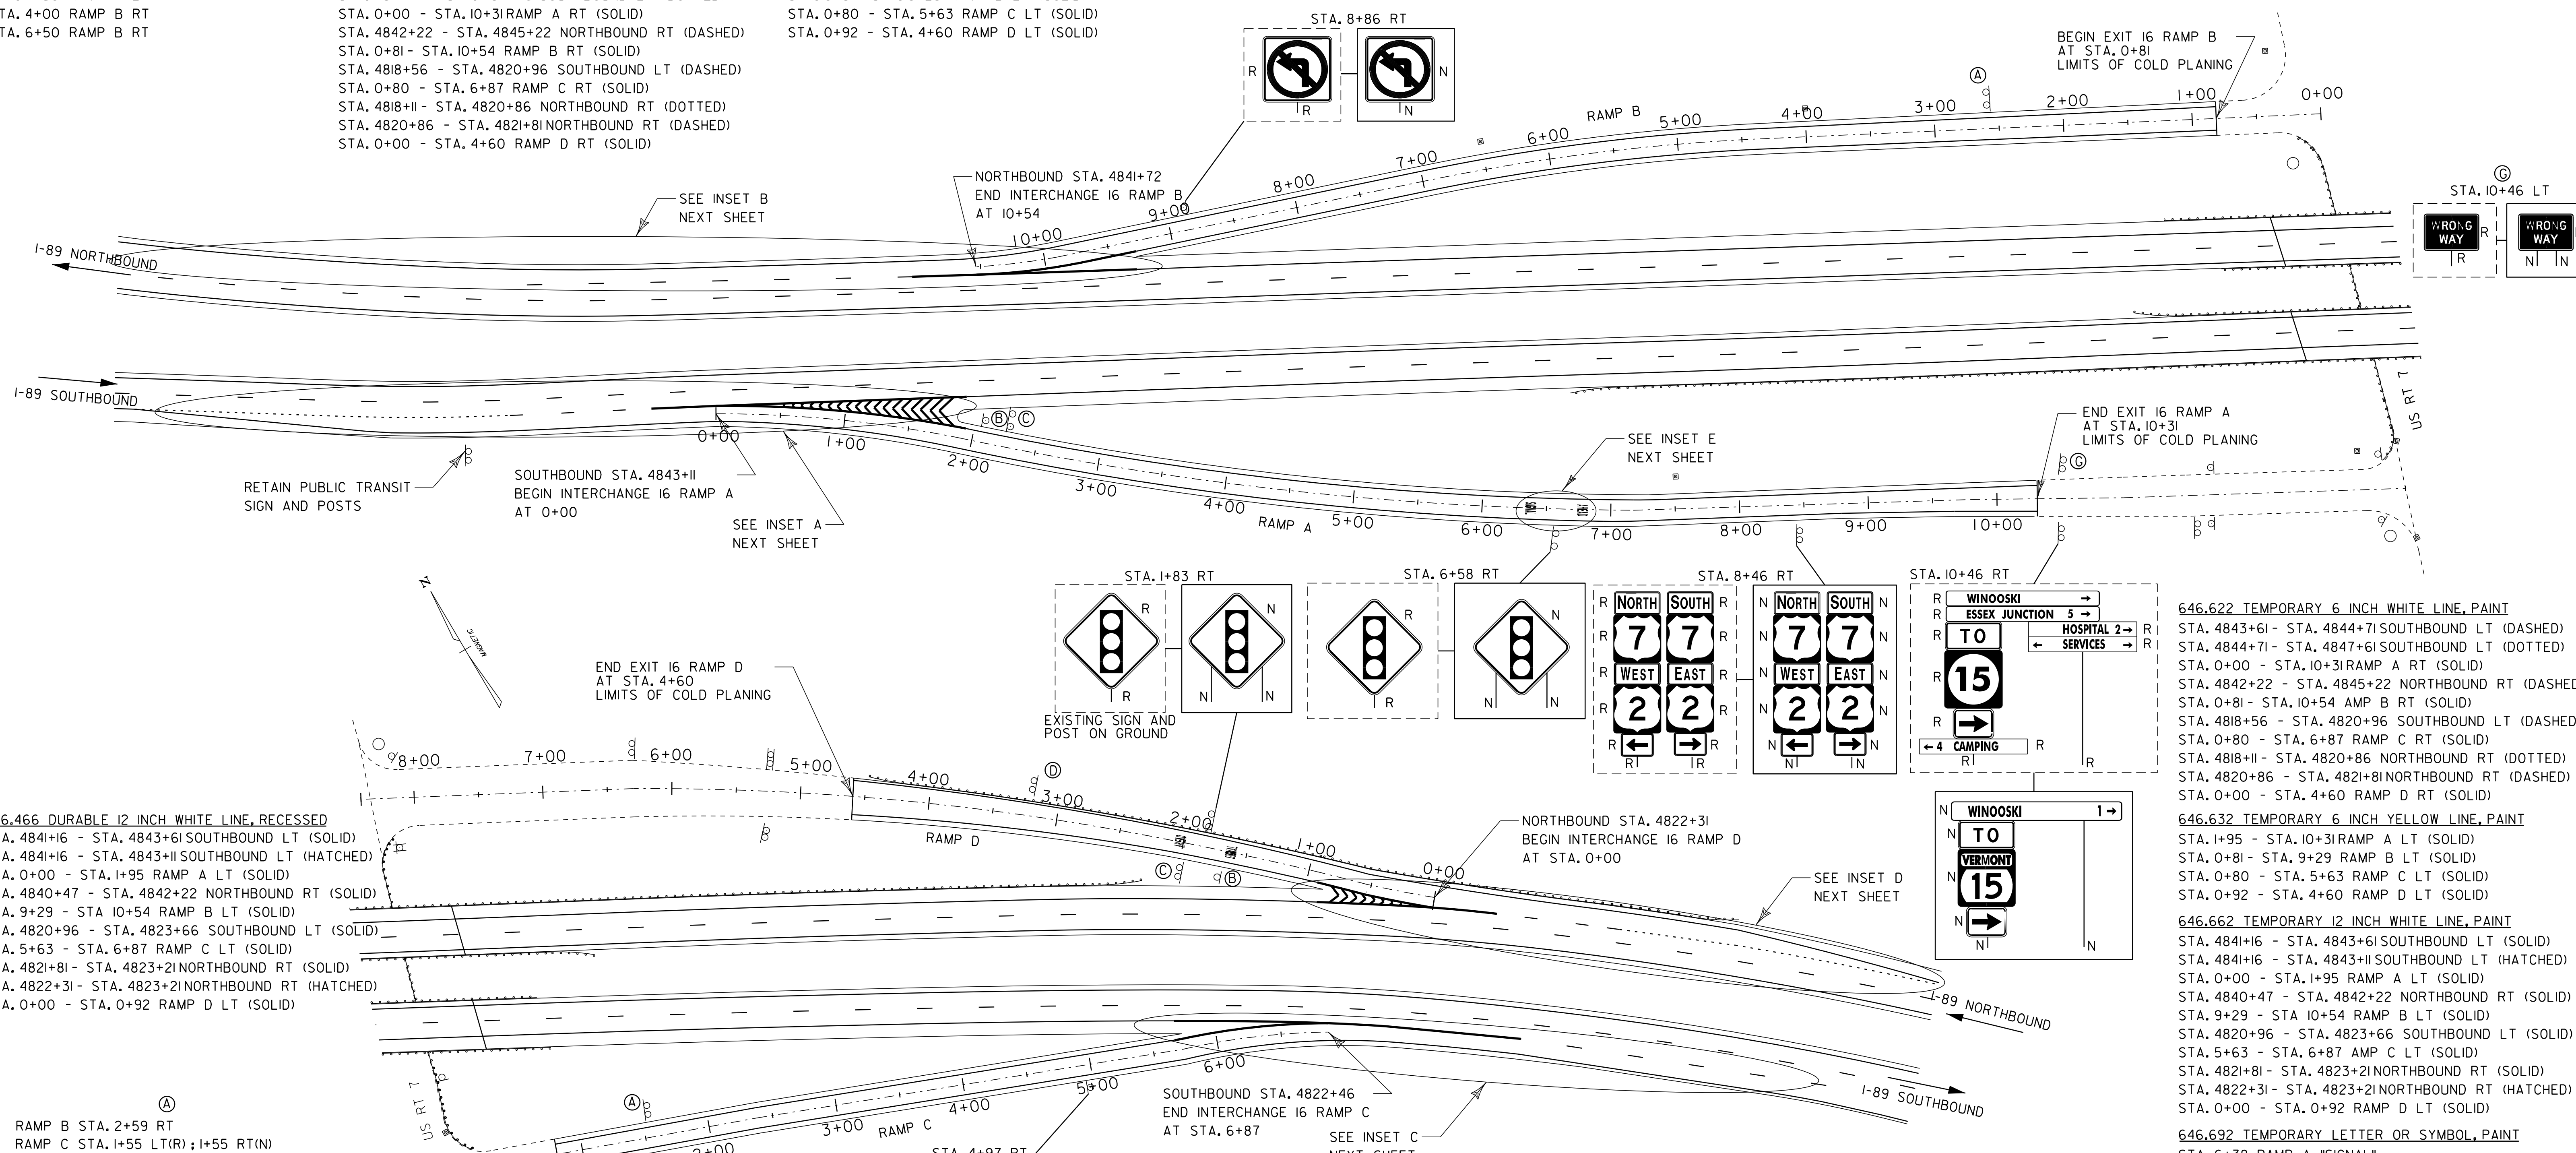

646.466 DURABLE 12 INCH WHITE LINE, RECESSED
 STA. 4841+16 - STA. 4843+61 SOUTHBOUND LT (SOLID)
 STA. 4841+16 - STA. 4843+11 SOUTHBOUND LT (HATCHED)
 STA. 0+00 - STA. 1+95 RAMP A LT (SOLID)
 STA. 4840+47 - STA. 4842+22 NORTHBOUND RT (SOLID)
 STA. 9+29 - STA. 10+54 RAMP B LT (SOLID)
 STA. 4820+96 - STA. 4823+66 SOUTHBOUND LT (SOLID)
 STA. 5+63 - STA. 6+87 RAMP C LT (SOLID)
 STA. 4821+81 - STA. 4823+21 NORTHBOUND RT (SOLID)
 STA. 4822+31 - STA. 4823+21 NORTHBOUND RT (HATCHED)
 STA. 0+00 - STA. 0+92 RAMP D LT (SOLID)

646.622 TEMPORARY 6 INCH WHITE LINE, PAINT
 STA. 4843+61 - STA. 4844+71 SOUTHBOUND LT (DASHED)
 STA. 4844+71 - STA. 4847+61 SOUTHBOUND LT (DOTTED)
 STA. 0+00 - STA. 10+31 RAMP A RT (SOLID)
 STA. 4842+22 - STA. 4845+22 NORTHBOUND RT (DASHED)
 STA. 0+81 - STA. 10+54 AMP B RT (SOLID)
 STA. 4818+56 - STA. 4820+96 SOUTHBOUND LT (DASHED)
 STA. 0+80 - STA. 6+87 RAMP C RT (SOLID)
 STA. 4818+11 - STA. 4820+86 NORTHBOUND RT (DOTTED)
 STA. 4820+86 - STA. 4821+81 NORTHBOUND RT (DASHED)
 STA. 0+00 - STA. 4+60 RAMP D RT (SOLID)


646.632 TEMPORARY 6 INCH YELLOW LINE, PAINT
 STA. 1+95 - STA. 10+31 RAMP A LT (SOLID)
 STA. 0+81 - STA. 9+29 RAMP B LT (SOLID)
 STA. 0+80 - STA. 5+63 RAMP C LT (SOLID)
 STA. 0+92 - STA. 4+60 RAMP D LT (SOLID)

646.662 TEMPORARY 12 INCH WHITE LINE, PAINT
 STA. 4841+16 - STA. 4843+61 SOUTHBOUND LT (SOLID)
 STA. 4841+16 - STA. 4843+11 SOUTHBOUND LT (HATCHED)
 STA. 0+00 - STA. 1+95 RAMP A LT (SOLID)
 STA. 4840+47 - STA. 4842+22 NORTHBOUND RT (SOLID)
 STA. 9+29 - STA. 10+54 RAMP B LT (SOLID)
 STA. 4820+96 - STA. 4823+66 SOUTHBOUND LT (SOLID)
 STA. 5+63 - STA. 6+87 AMP C LT (SOLID)
 STA. 4821+81 - STA. 4823+21 NORTHBOUND RT (SOLID)
 STA. 4822+31 - STA. 4823+21 NORTHBOUND RT (HATCHED)
 STA. 0+00 - STA. 0+92 RAMP D LT (SOLID)

646.692 TEMPORARY LETTER OR SYMBOL, PAINT
 STA. 6+38 RAMP A "SIGNAL"
 STA. 6+78 RAMP A "AHEAD"
 STA. 1+63 RAMP D "SIGNAL"
 STA. 2+03 RAMP D "AHEAD"




646.492 DURABLE LETTER OR SYMBOL, THERMOPLASTIC
 STA. 6+38 RAMP A "SIGNAL"
 STA. 6+78 RAMP A "AHEAD"
 STA. 1+63 RAMP D "SIGNAL"
 STA. 2+03 RAMP D "AHEAD"

RAMP B STA. 2+59 RT
 RAMP C STA. 1+55 LT(R); 1+55 RT(N)

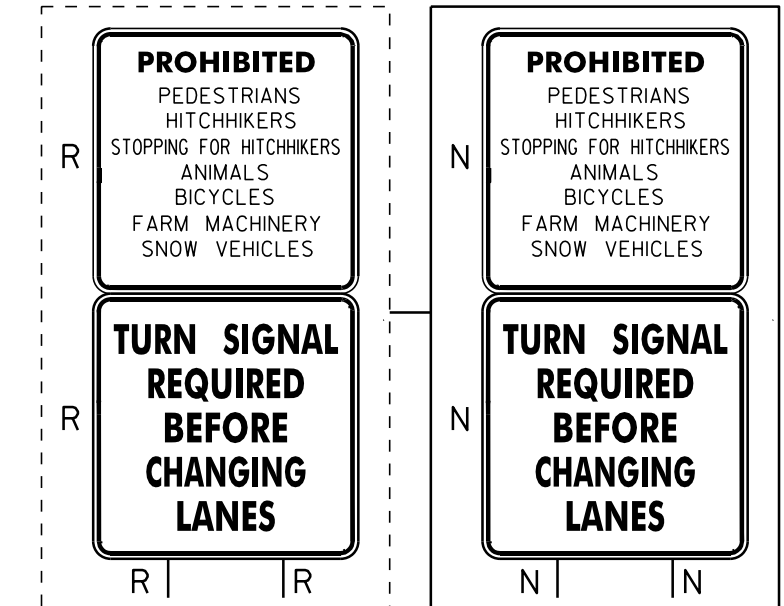

RAMP RADII INFORMATION

RAMP	RADII, FT	DESCRIPTION
A	1432	ONLY ONE CURVE ALONG RAMP
B	1432	ONLY ONE CURVE ALONG RAMP
C	819	ONLY ONE CURVE ALONG RAMP
D	2100	ONLY ONE CURVE ALONG RAMP

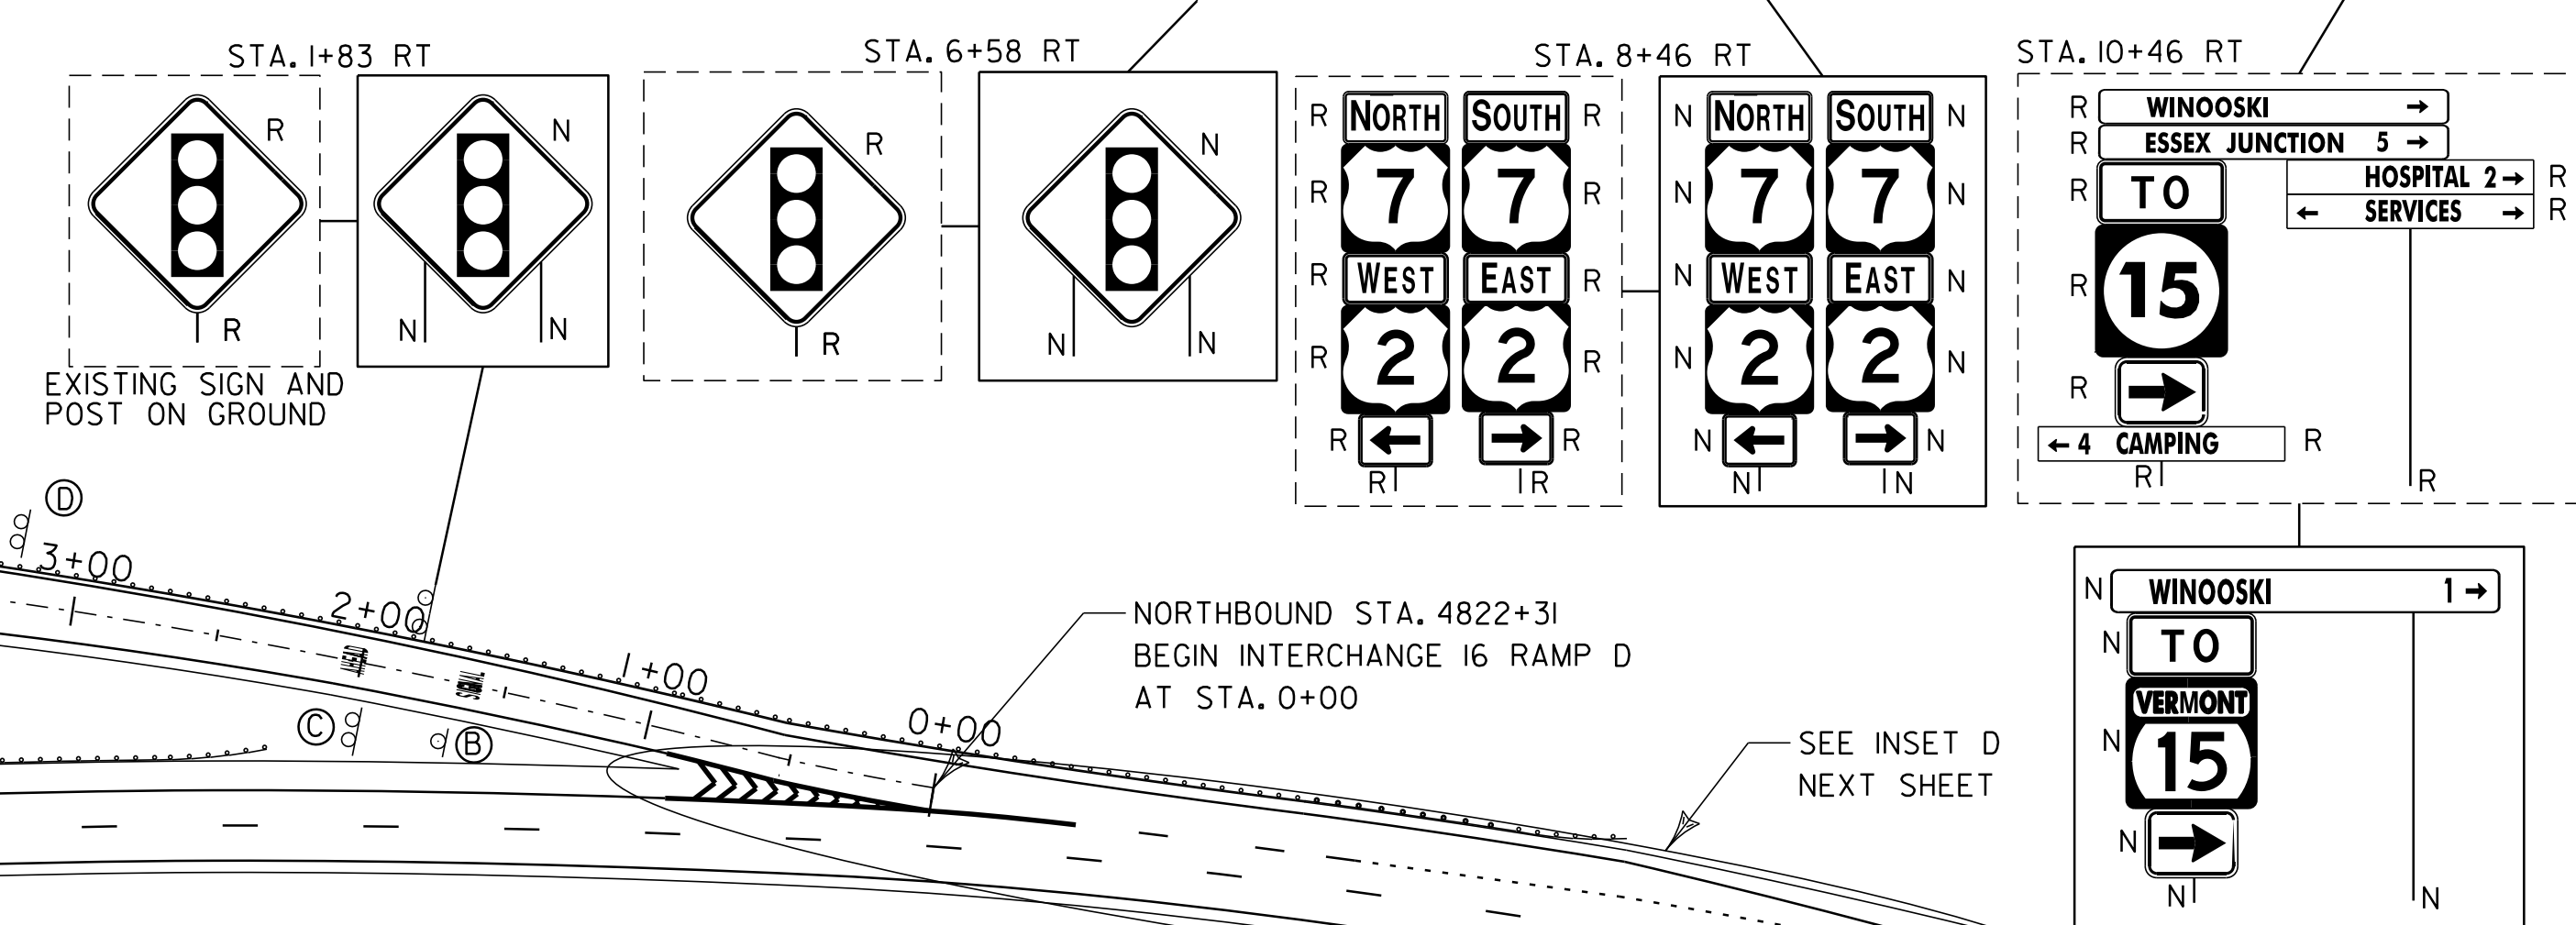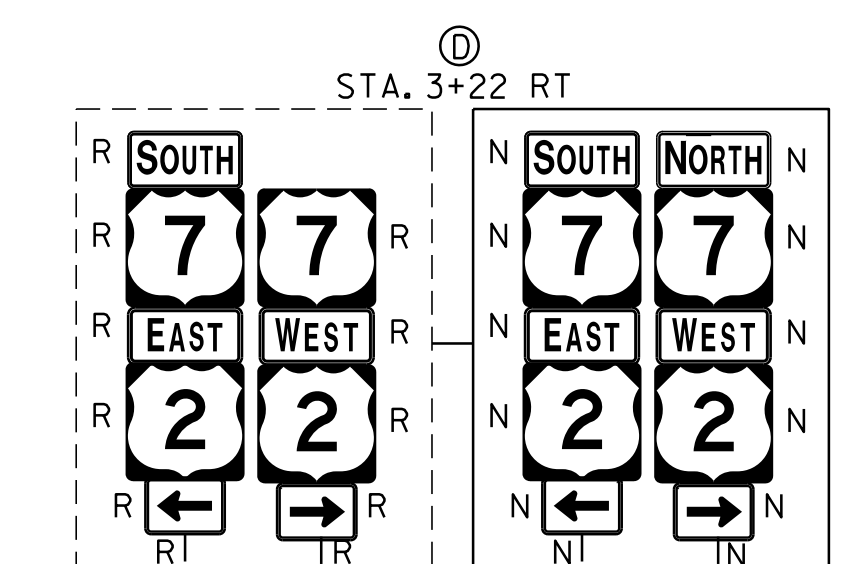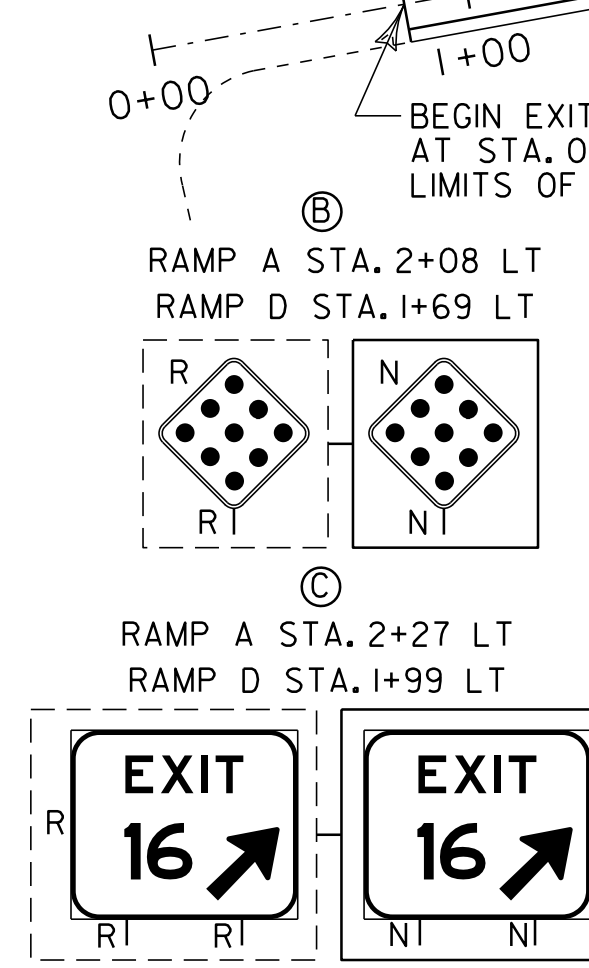

LEGEND
 N = NEW
 R = REMOVE
 B-B = BACK TO BACK
 RET = RETAIN
 S = SALVAGE

REFER TO STANDARDS E-191 & E-192 FOR ADDITIONAL DETAILS.

675.50 REMOVING SIGNS AS SHOWN - 40

RAMP DETAIL SHEET 1 INTERCHANGE #16

PROJECT NAME: SO. BURLINGTON - COLCHESTER
 PROJECT NUMBER: IM 089-3(60)

FILE NAME: p05a012.dgn
 PROJECT LEADER: EPD
 DESIGNED BY: JDA
 PLOT FILE: p05a012rds17.dgn

PLOT DATE: \$\$\$\$\$\$DATE\$\$\$\$
 DRAWN BY: SJB
 CHECKED BY: EPD
 SHEET 41 OF 91