

TEMPORARY (PAINT) AND
DURABLE (RECESSED) 6in WHITE LINE

MAINLINE
STA 4323+00 TO 4328+50
STA 4328+50 TO 4330+90
STA 4343+25 TO 4346+35

DOTTED RT
DASHED RT
DASHED RT


TEMPORARY (PAINT) AND
DURABLE (RECESSED) 12in WHITE LINE

MAINLINE
STA 4330+90 TO 4332+80
STA 4340+35 TO 4343+25

GORE MARKINGS
GORE MARKINGS

REMOVAL AND DISPOSAL OF GUARD RAIL
STA 4343+04 TO 4343+41RT

MANUFACTURED TERMINAL SECTION, FLARED
STA 4343+04 TO 4343+41RT

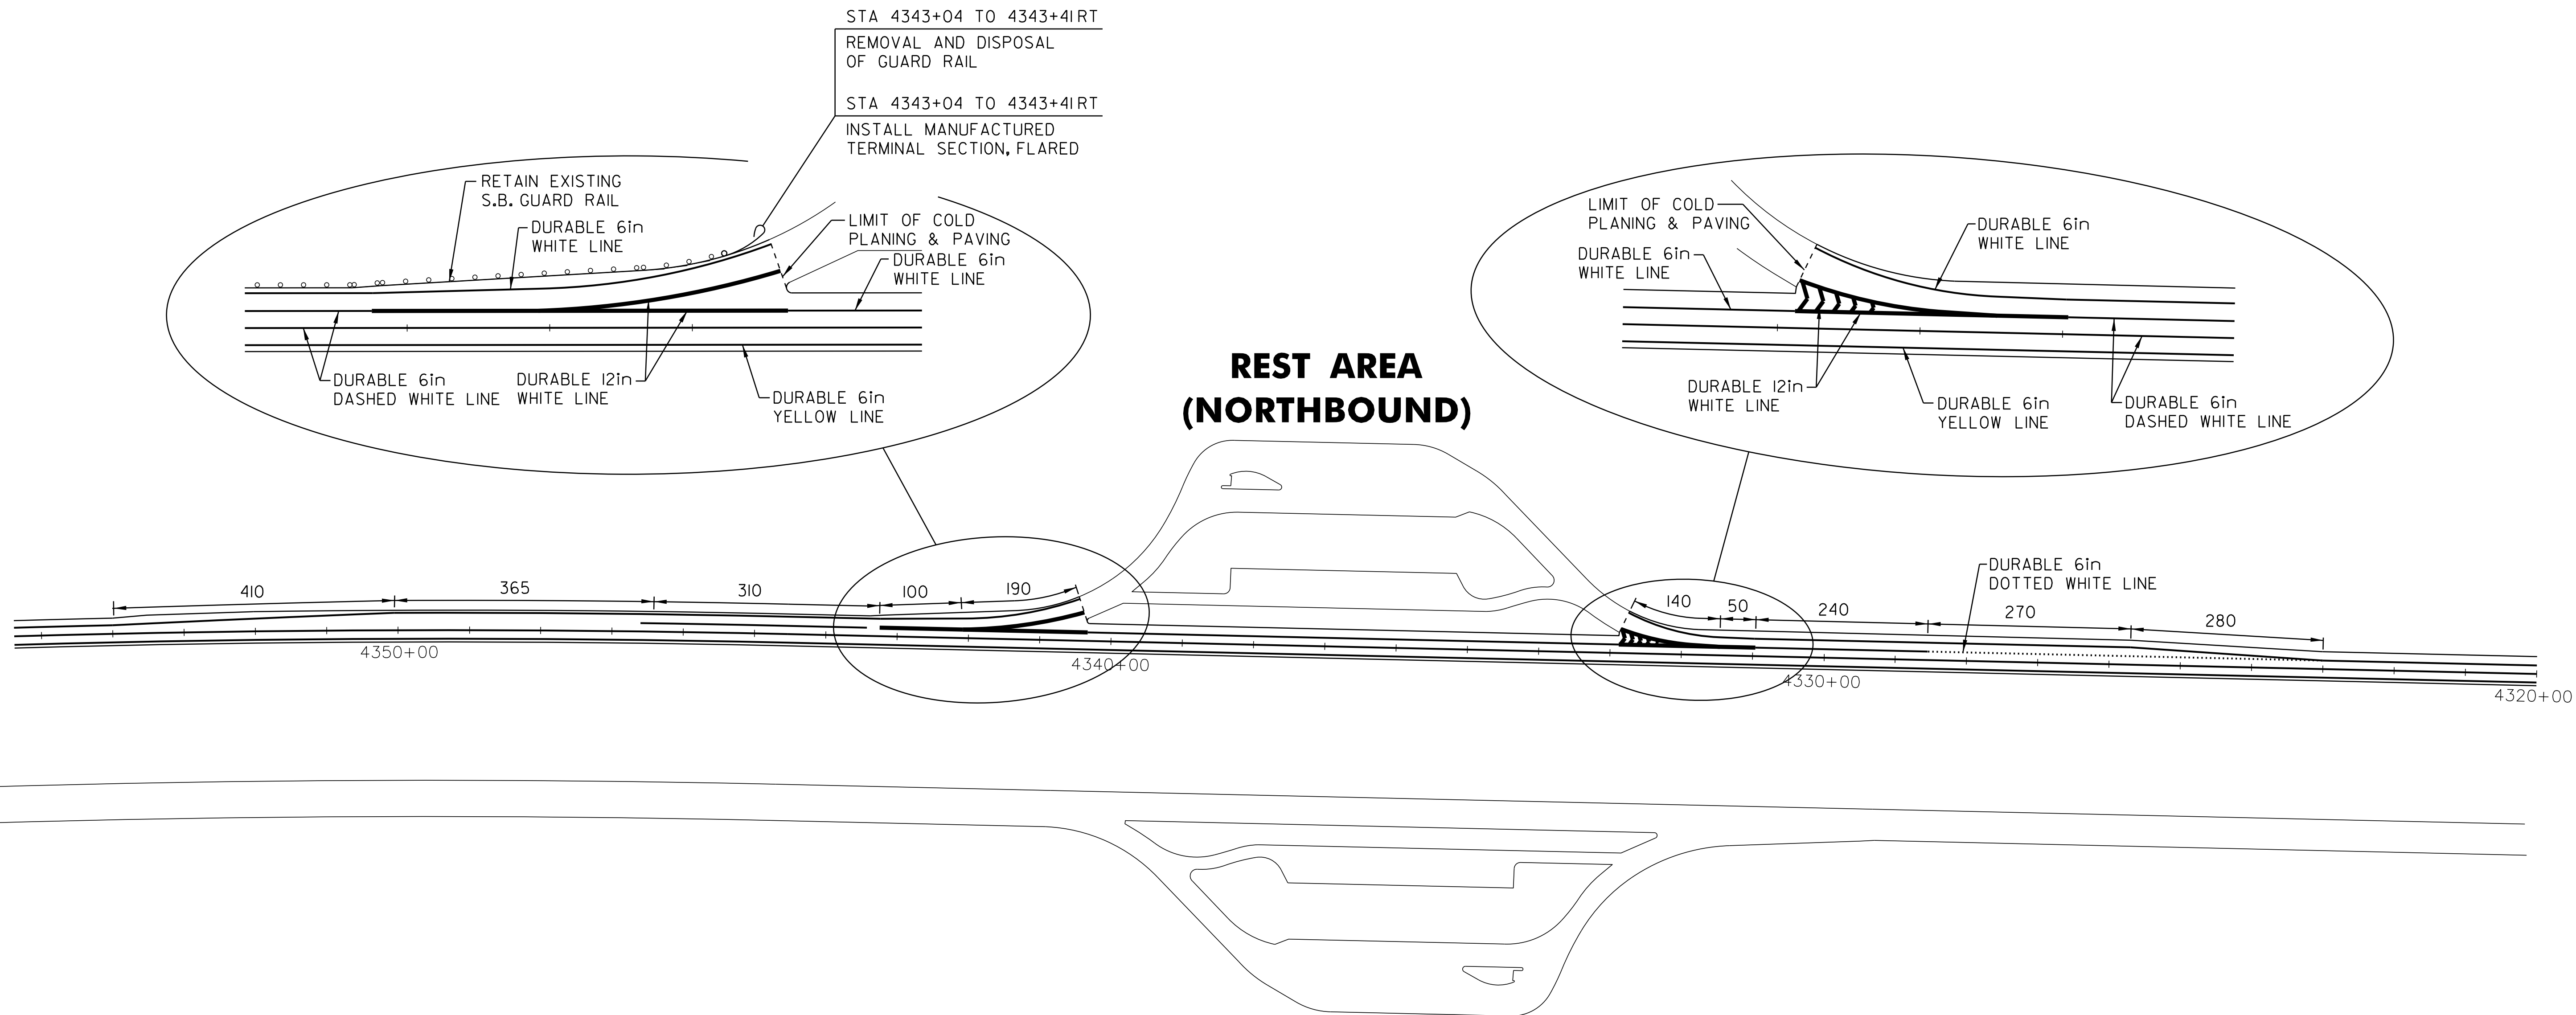

NOTE: ALL DIMENSIONS IN FEET UNLESS OTHERWISE NOTED.
REFER TO STANDARDS E-191, E-192, & E-193
FOR ADDITIONAL DETAILS.

**REST AREA
DETAIL
SHEET**

DESIGNED BY BCE/PJM DATE 6-07
DRAWN BY C.E.A., INC. DATE 6-07
DESIGN FILE NO. p01a030.dgn
PRF FILE p01a030rad.i DATE PLOTTED #####DATE
PROJ. NAME **RICHMOND-SO. BURLINGTON**
PROJ. NO. **IM089-2(39)**
SHEET **61** OF **91** SHEETS