
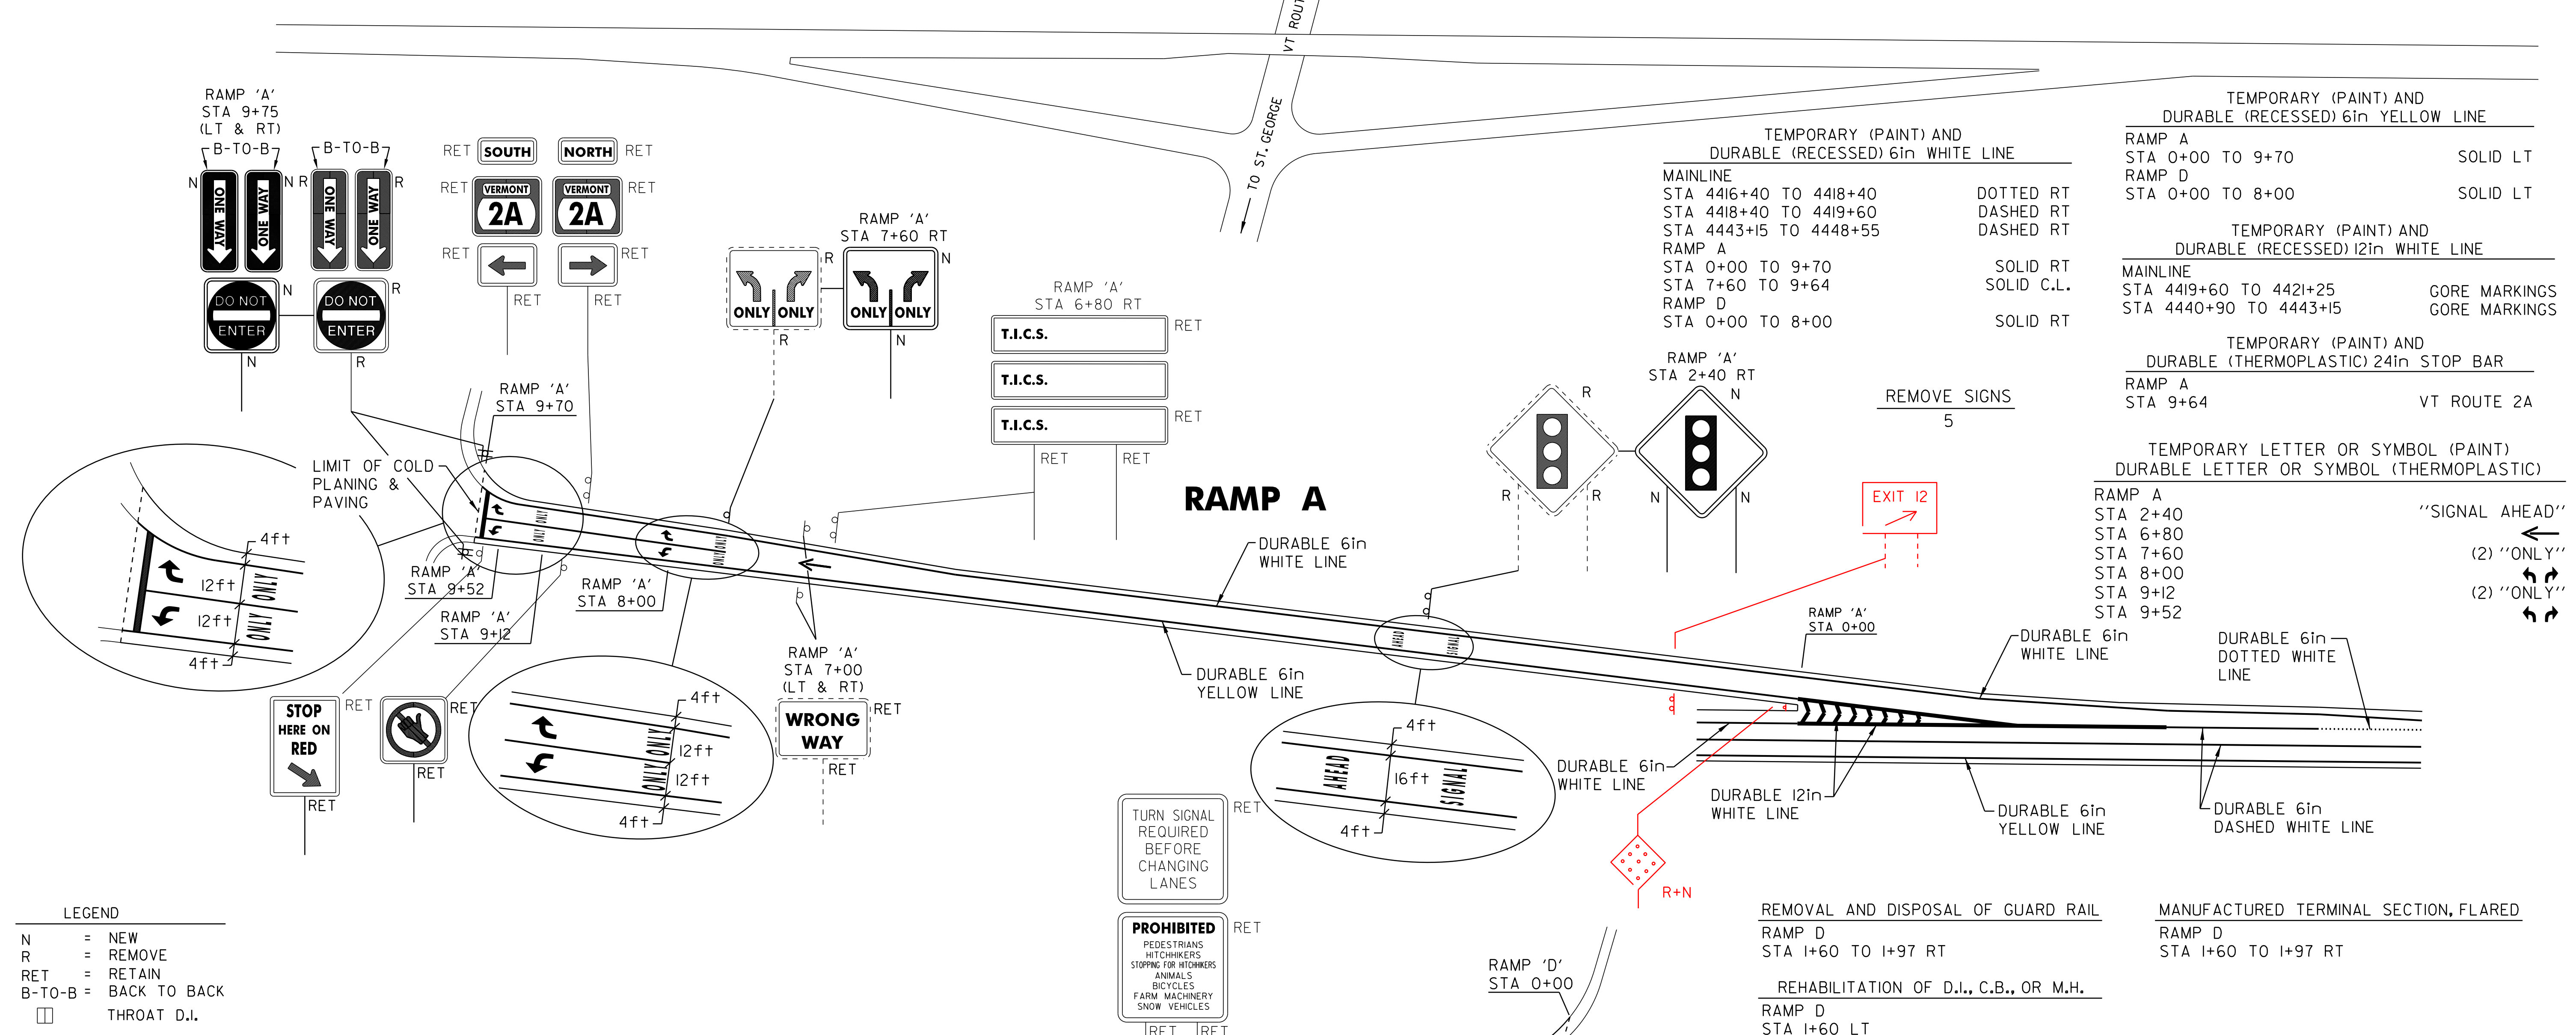


# INTERCHANGE #12 (NORTHBOUND)

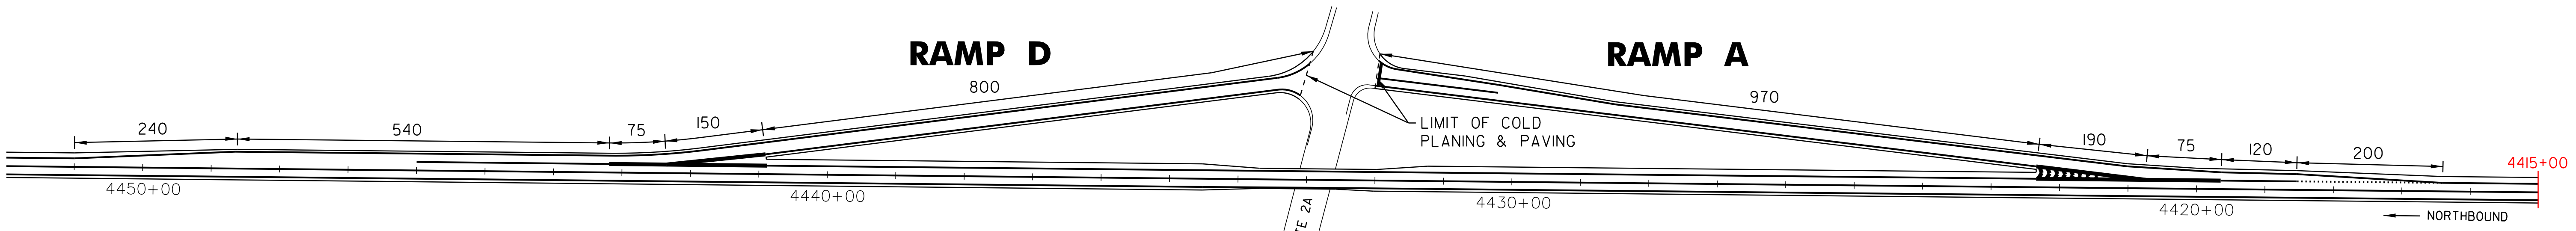

TEMPORARY (PAINT) AND DURABLE (RECESSED) 6in YELLOW LINE	
RAMP A STA 0+00 TO 9+70	SOLID LT
RAMP D STA 0+00 TO 8+00	SOLID LT
TEMPORARY (PAINT) AND DURABLE (RECESSED) 12in WHITE LINE	
MAINLINE STA 4416+40 TO 4418+40	DOTTED RT
STA 4418+40 TO 4419+60	DASHED RT
STA 4443+15 TO 4448+55	DASHED RT
RAMP A STA 0+00 TO 9+70	SOLID RT
STA 7+60 TO 9+64	SOLID C.L.
RAMP D STA 0+00 TO 8+00	SOLID RT
TEMPORARY (PAINT) AND DURABLE (THERMOPLASTIC) 24in STOP BAR	
RAMP A STA 9+64	VT ROUTE 2A

TEMPORARY LETTER OR SYMBOL (PAINT) DURABLE LETTER OR SYMBOL (THERMOPLASTIC)	
RAMP A STA 2+40	"SIGNAL AHEAD"
STA 6+80	(2) "ONLY"
STA 7+60	(2) "ONLY"
STA 8+00	(2) "ONLY"
STA 9+12	(2) "ONLY"
STA 9+52	(2) "ONLY"

**LEGEND**

- N = NEW
- R = REMOVE
- RET = RETAIN
- B-TO-B = BACK TO BACK
- = THROAT D.I.

REMOVAL AND DISPOSAL OF GUARD RAIL	MANUFACTURED TERMINAL SECTION, FLARED
RAMP D STA 1+60 TO 1+97 RT	RAMP D STA 1+60 TO 1+97 RT
REHABILITATION OF D.I., C.B., OR M.H.	
RAMP D STA 1+60 LT	

NOTE: ALL DIMENSIONS IN FEET UNLESS OTHERWISE NOTED.  
REFER TO STANDARDS E-191, E-192, & E-193 FOR ADDITIONAL DETAILS.

## INTERCHANGE #12 DETAIL SHEET

DESIGNED BY	BCE/PJM	DATE	6-07
DRAWN BY	C.E.A., INC.	DATE	6-07
DESIGN FILE NO.	p01a030.dgn		
PRF FILE	p01a030int.i	DATE PLOTTED	#####DATE#
PROJ. NAME	RICHMOND-SO. BURLINGTON		
PROJ. NO.	IM089-2(39)		
SHEET	62	OF	91 SHEETS

