


**PAVEMENT MARKING LINE DETAILS**




**STOP BAR DETAIL**

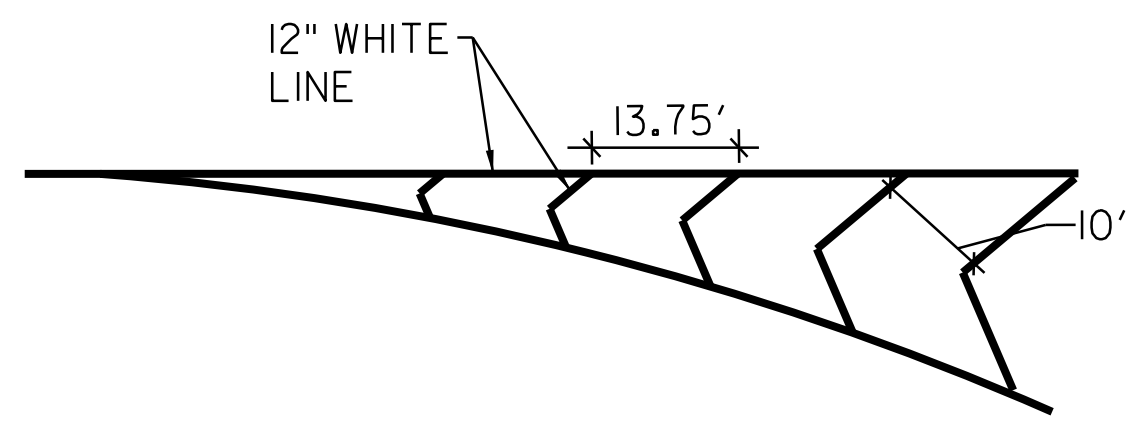

**GORE MARKING DETAIL**

**NOT TO SCALE**

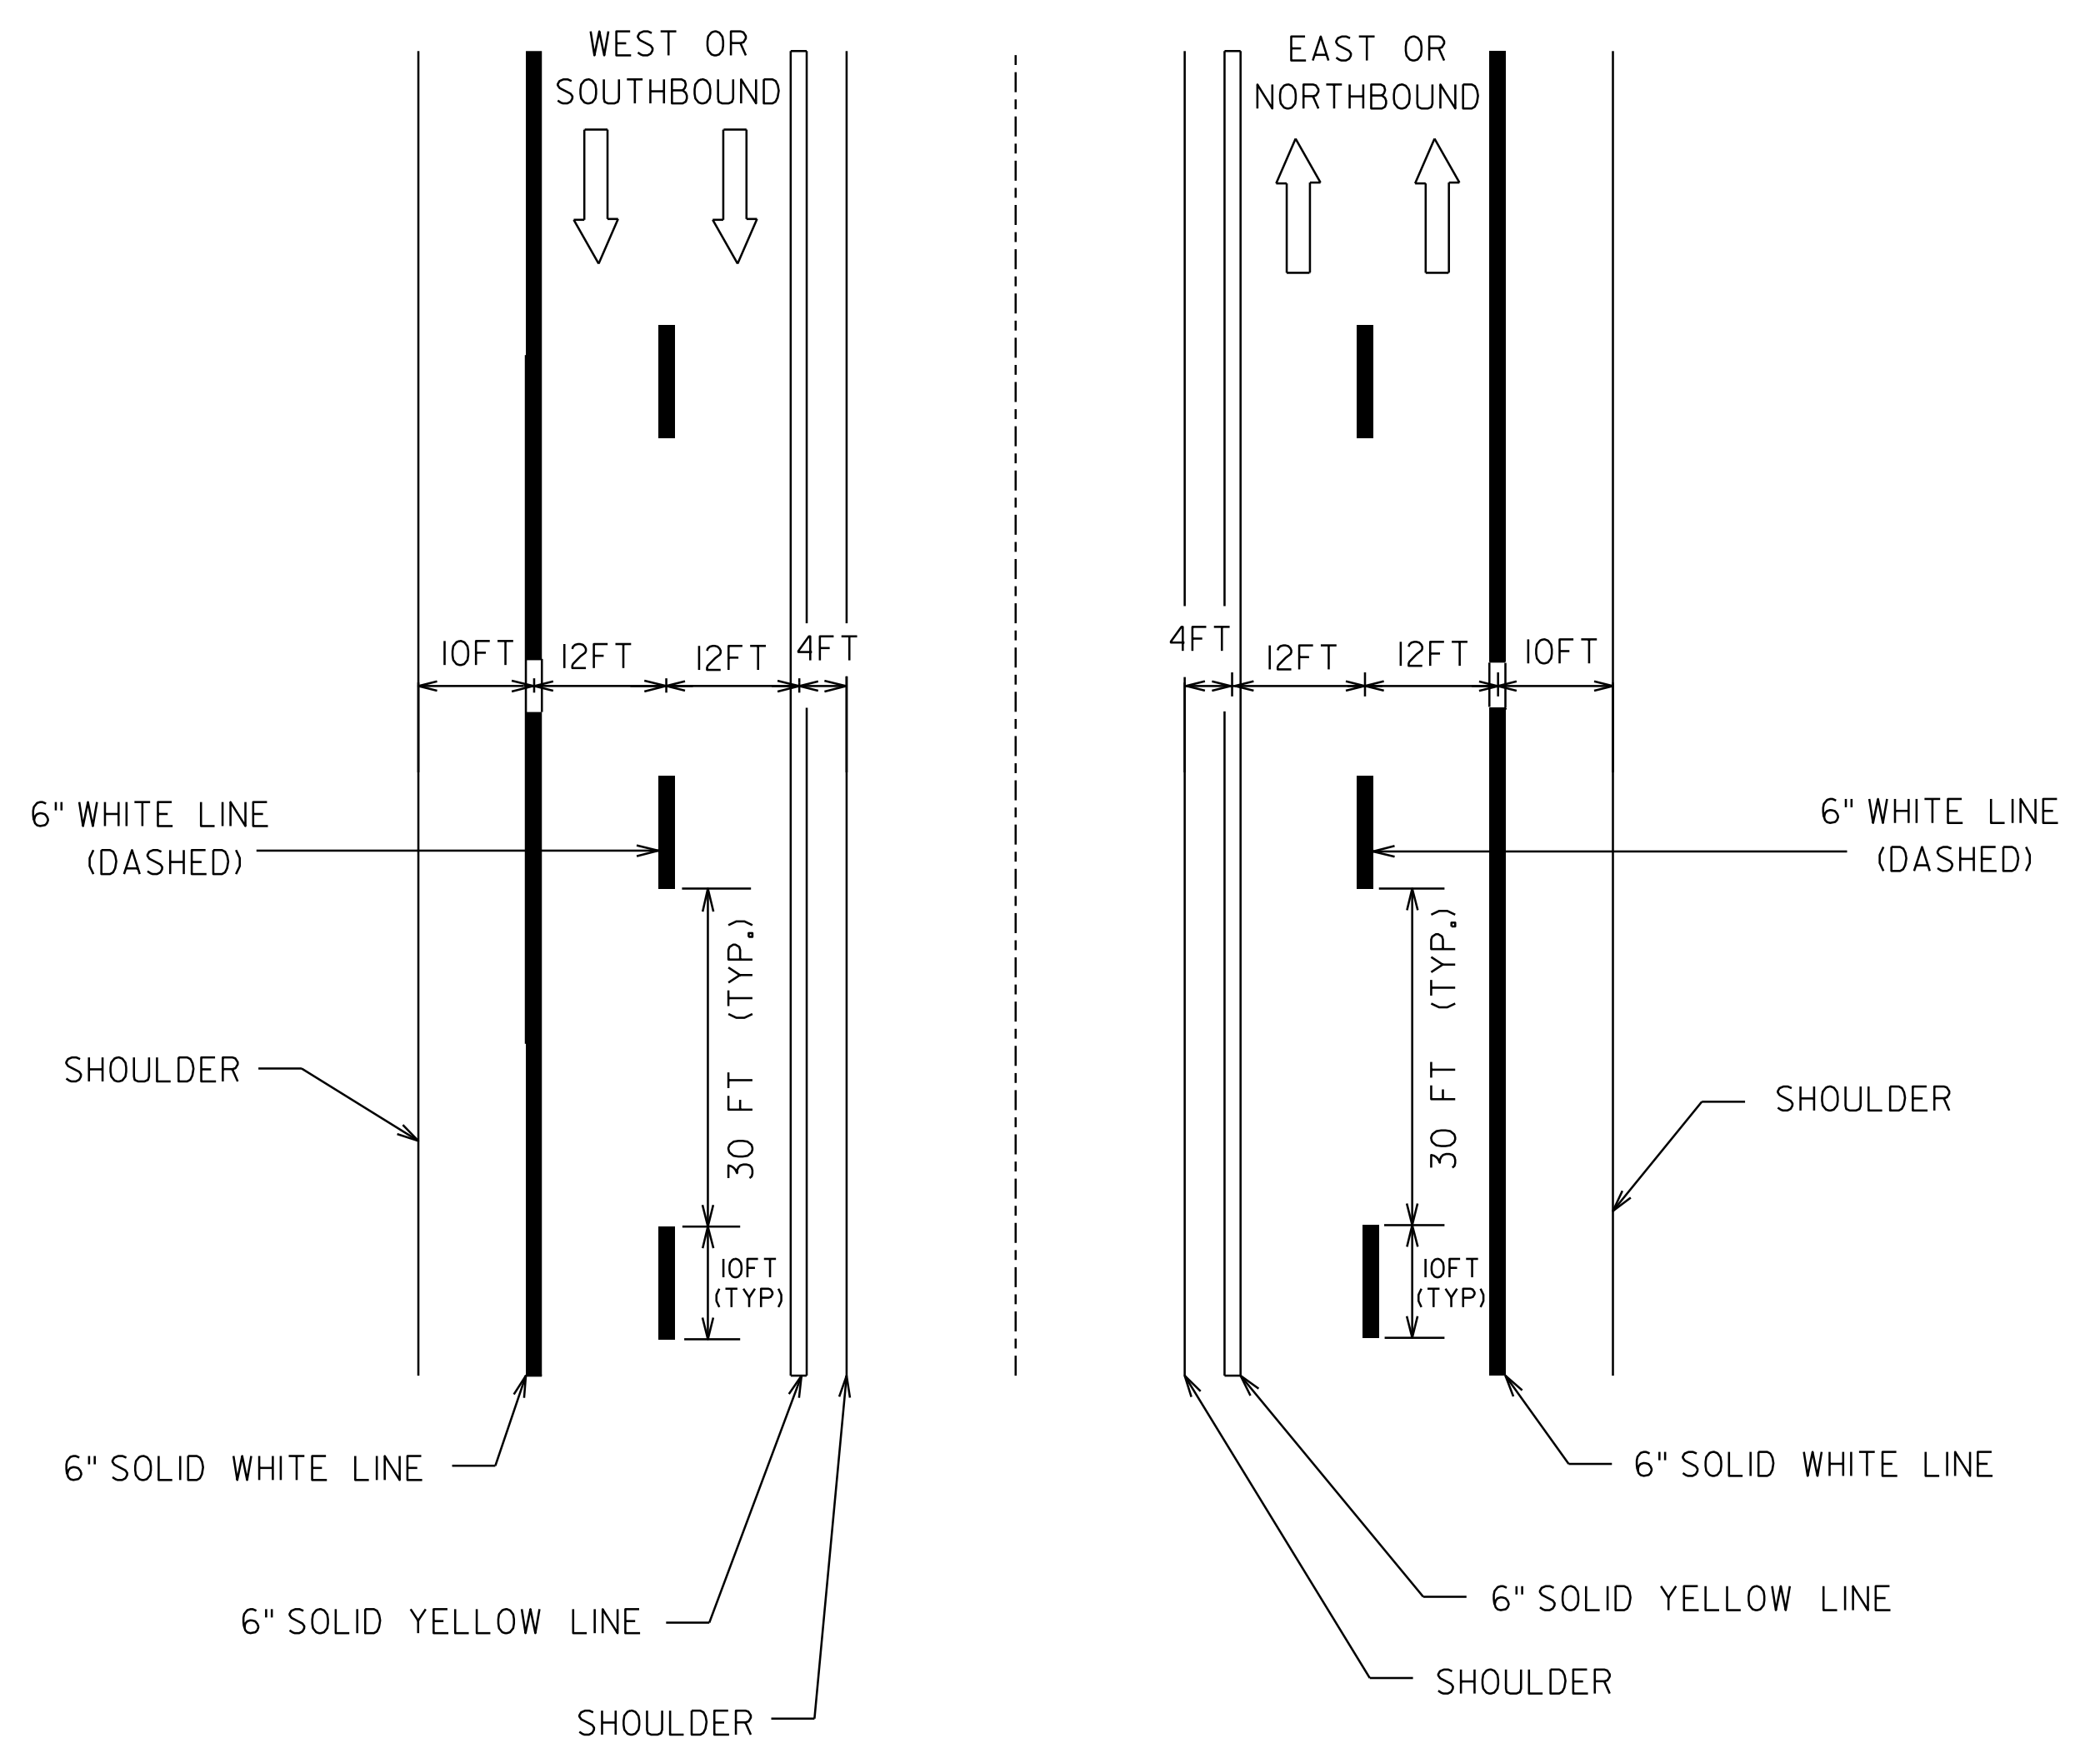

**TYPICAL MAINLINE MARKING PLAN**

**LEGEND**

- 6" WHITE LINES
- 6" YELLOW LINES
- DIRECTION OF TRAFFIC FLOW

**PAVEMENT MARKING DETAIL SHEET**

DESIGNED BY _____	DATE 6-07
DRAWN BY _____	DATE 6-07
DESIGN FILE NO. p01a030.dgn	
PRF FILE p01a030pmd.i	DATE PLOTTED \$\$\$\$\$\$DATE\$\$\$
PROJ. NAME RICHMOND-SO. BURLINGTON	
PROJ. NO. IM089-2(39)	
SHEET 63 OF 91 SHEETS	