


**INTERSTATE ROUTE 89
NORTHBOUND
STA 4170+67
(MM 78.990)
BEGIN PROJECT IM089-2(39)**

REMOVE SIGNS
9

NB STA 4435+20
MM 84.00

**INTERSTATE ROUTE 89
NORTHBOUND
STA 4614+56
(MM 87.397)
END PROJECT IM089-2(39)**

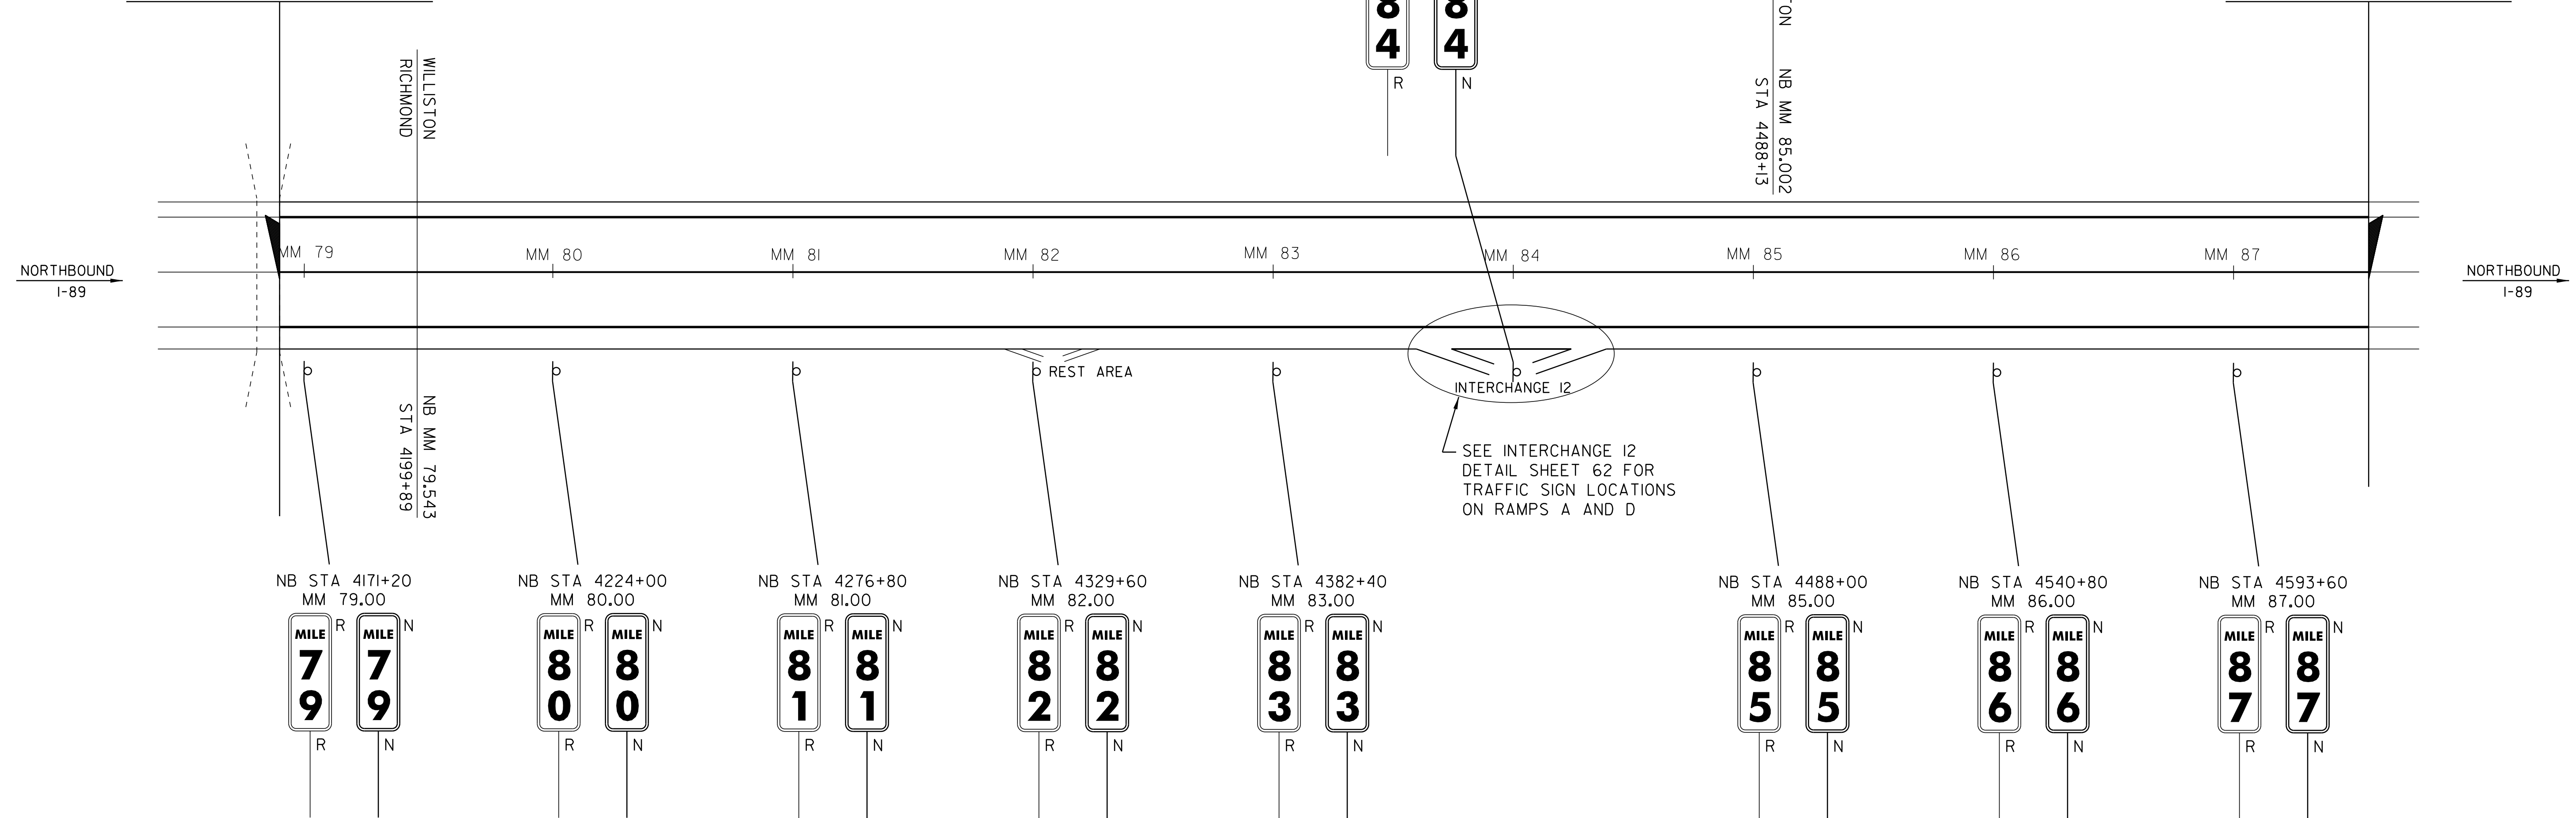

**TRAFFIC
SIGN
LAYOUT
SHEET**

DESIGNED BY BCE/PJM DATE 6-07
 DRAWN BY C.E.A., INC. DATE 6-07
 DESIGN FILE NO. p01a030.dgn
 PRF FILE p01a030+sl.i DATE PLOTTED #####DATE
 PROJ. NAME **RICHMOND-SO. BURLINGTON**
 PROJ. NO. **IM089-2(39)**
 SHEET **66** OF **91** SHEETS