


4224+50



4224+42

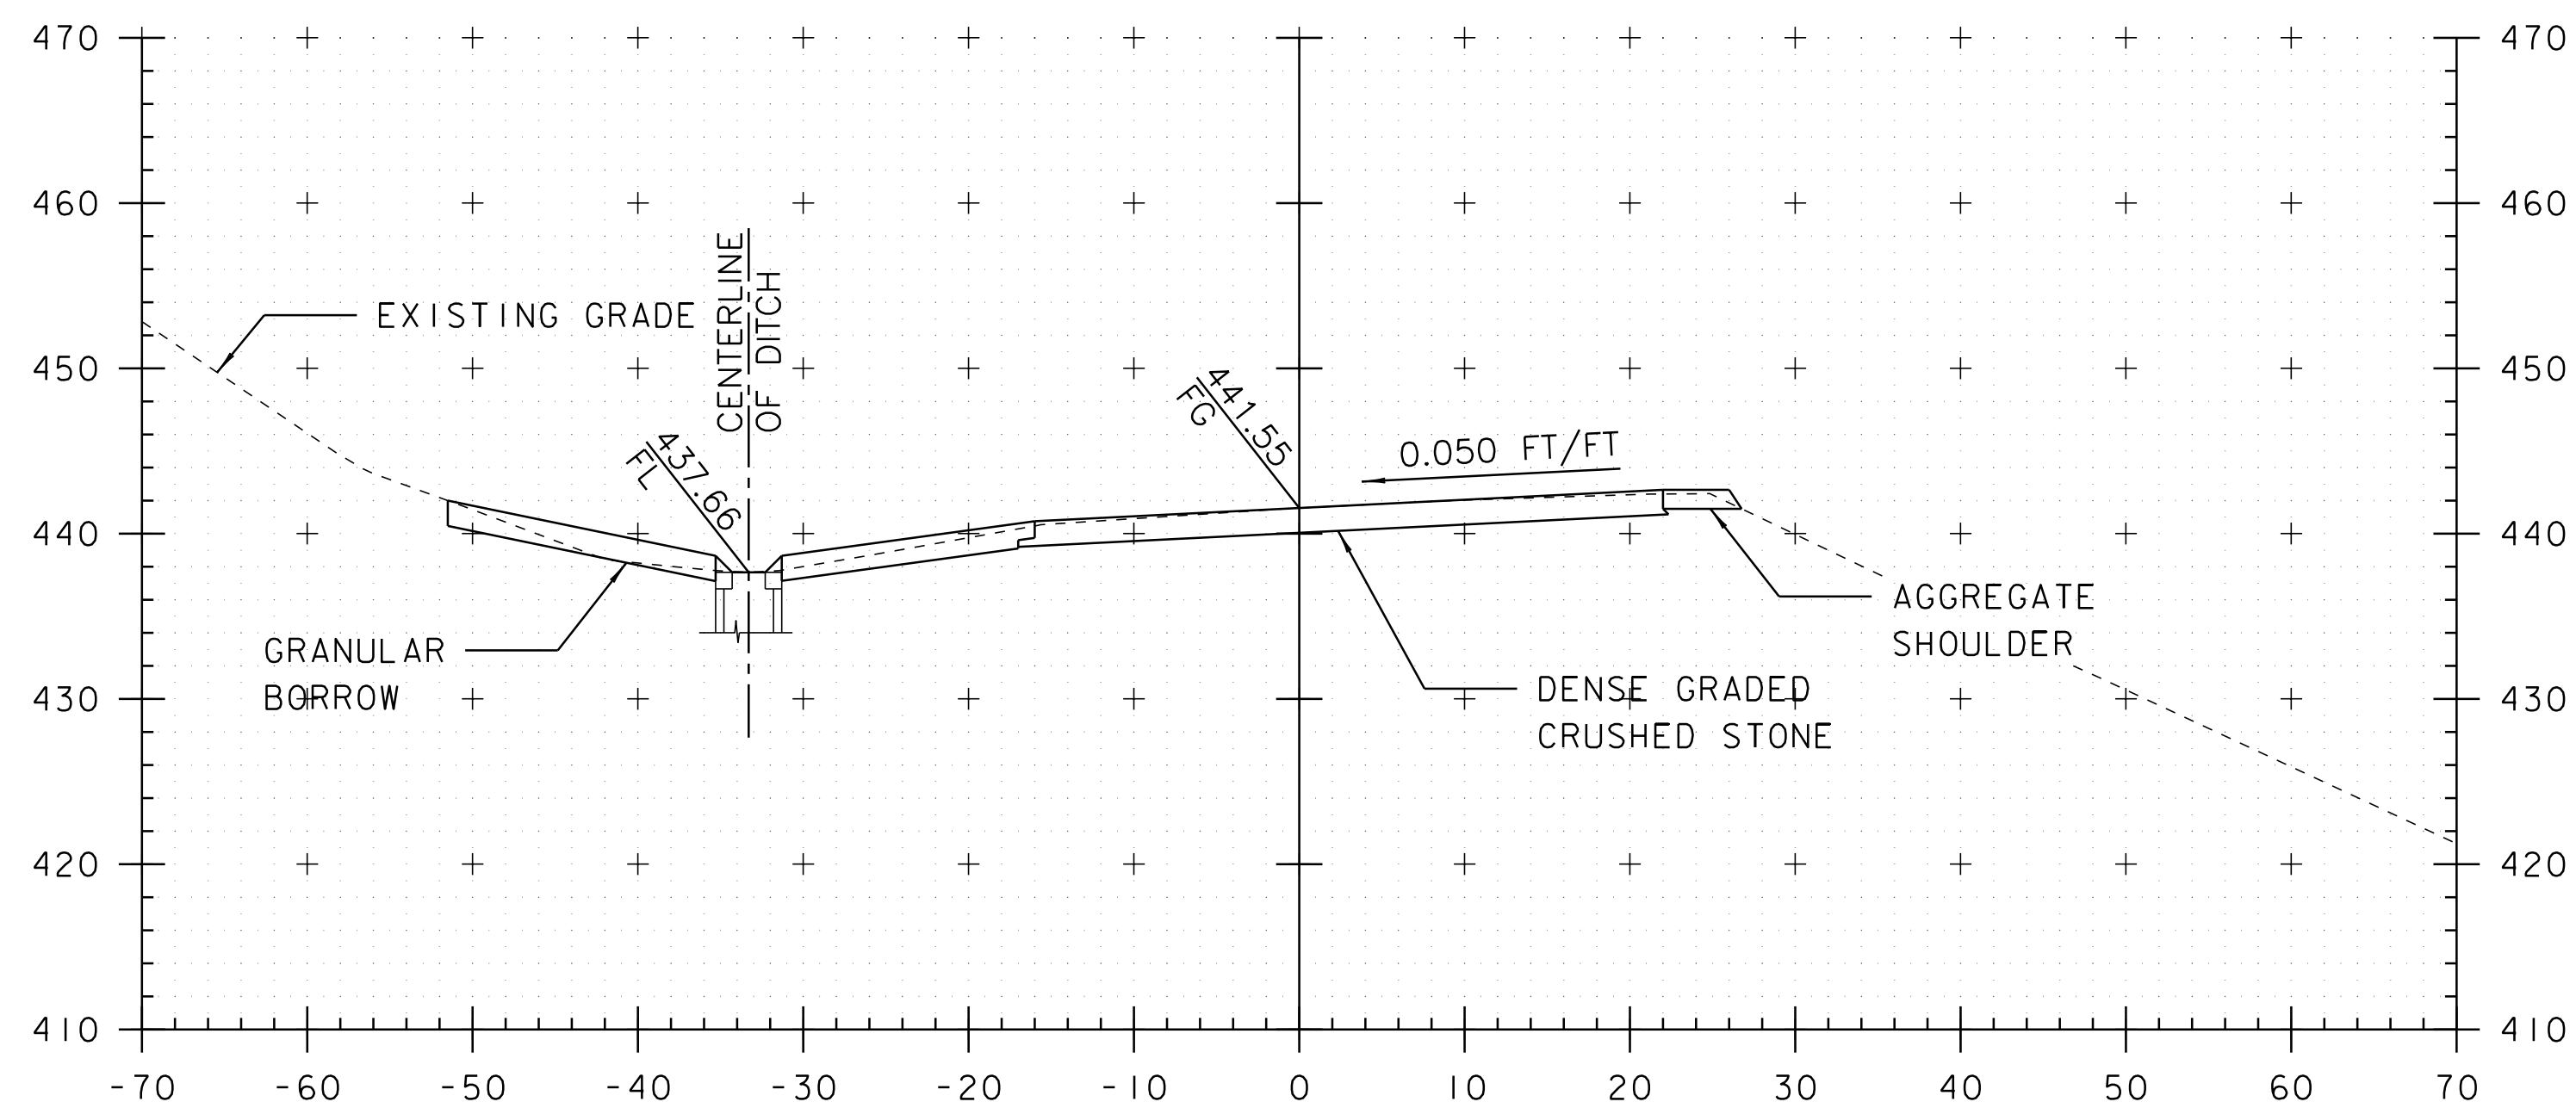

STA. 4224+42 TO STA. 4224+50

RECONSTRUCTION CROSS SECTIONS

PROJECT NAME: RICHMOND-SOUTH BURLINGTON
PROJECT NUMBER: IM 089-2(39)

FILE NAME: p05a012.dgn
PROJECT LEADER: PCI
DESIGNED BY: MMC
GOLDER ASSOCIATES INC.

PLOT DATE: 02-OCT-2012 16:5
DRAWN BY: MPB
CHECKED BY: RAW
SHEET 75 OF 91