
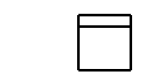
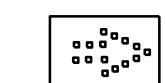
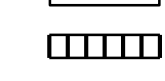



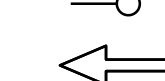

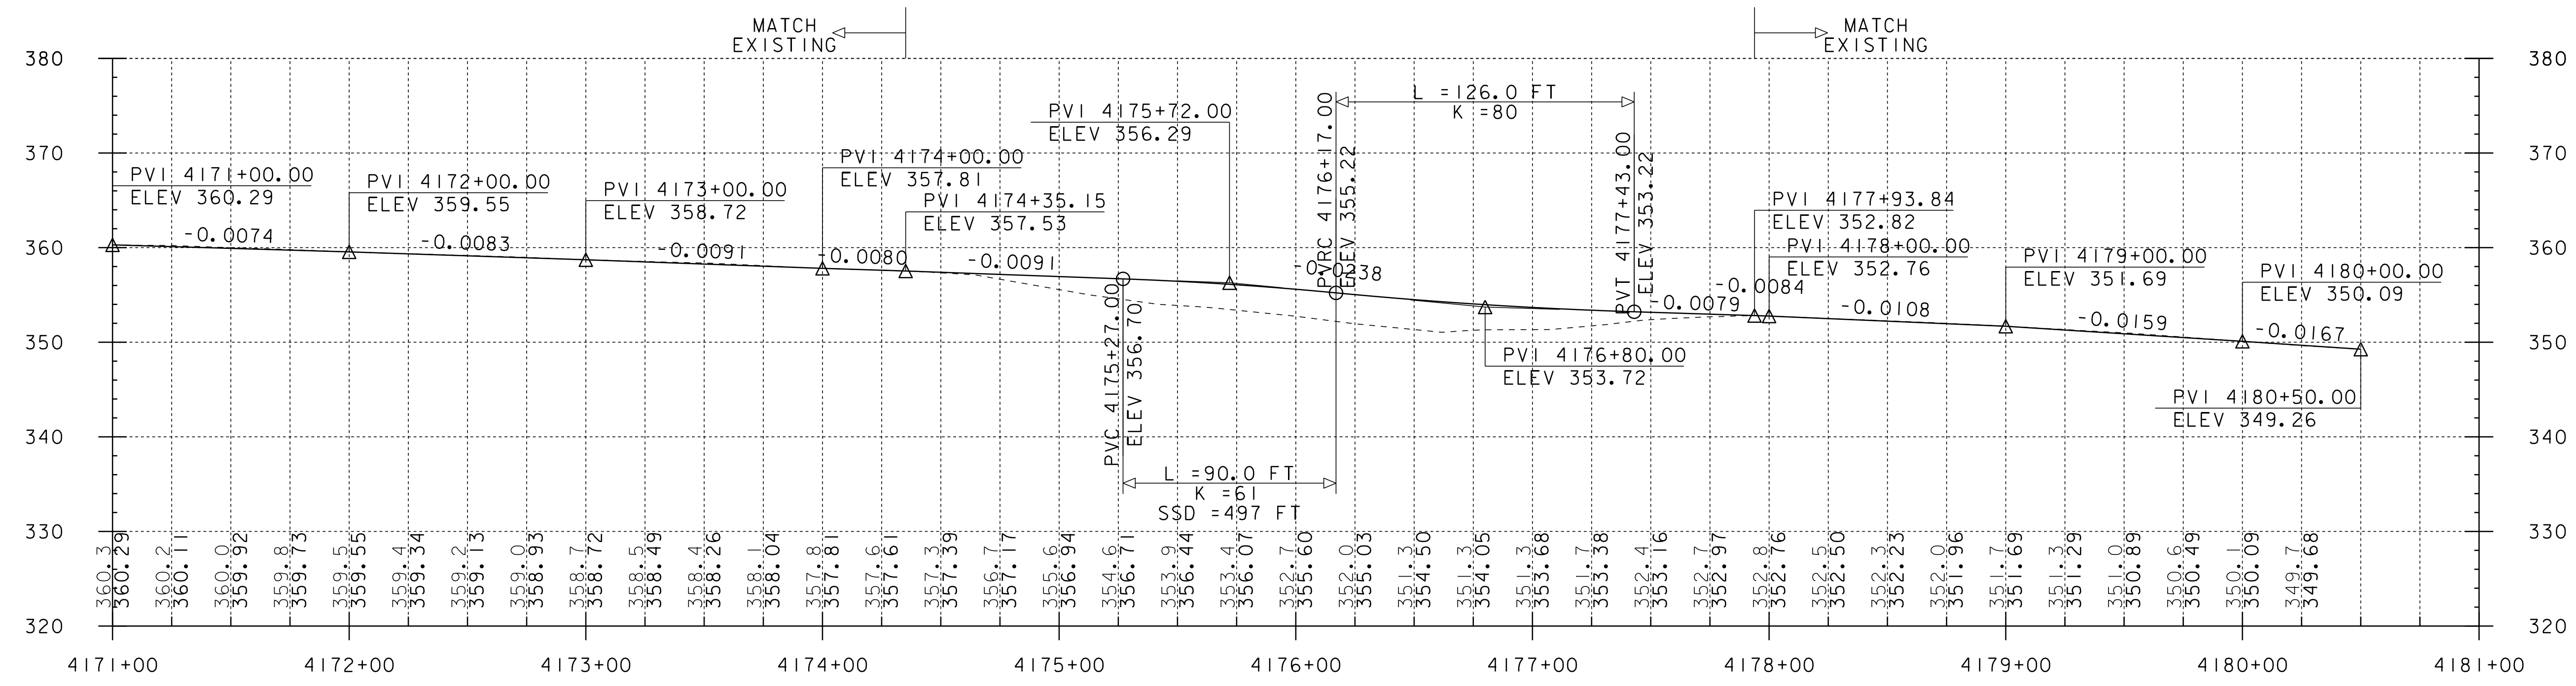
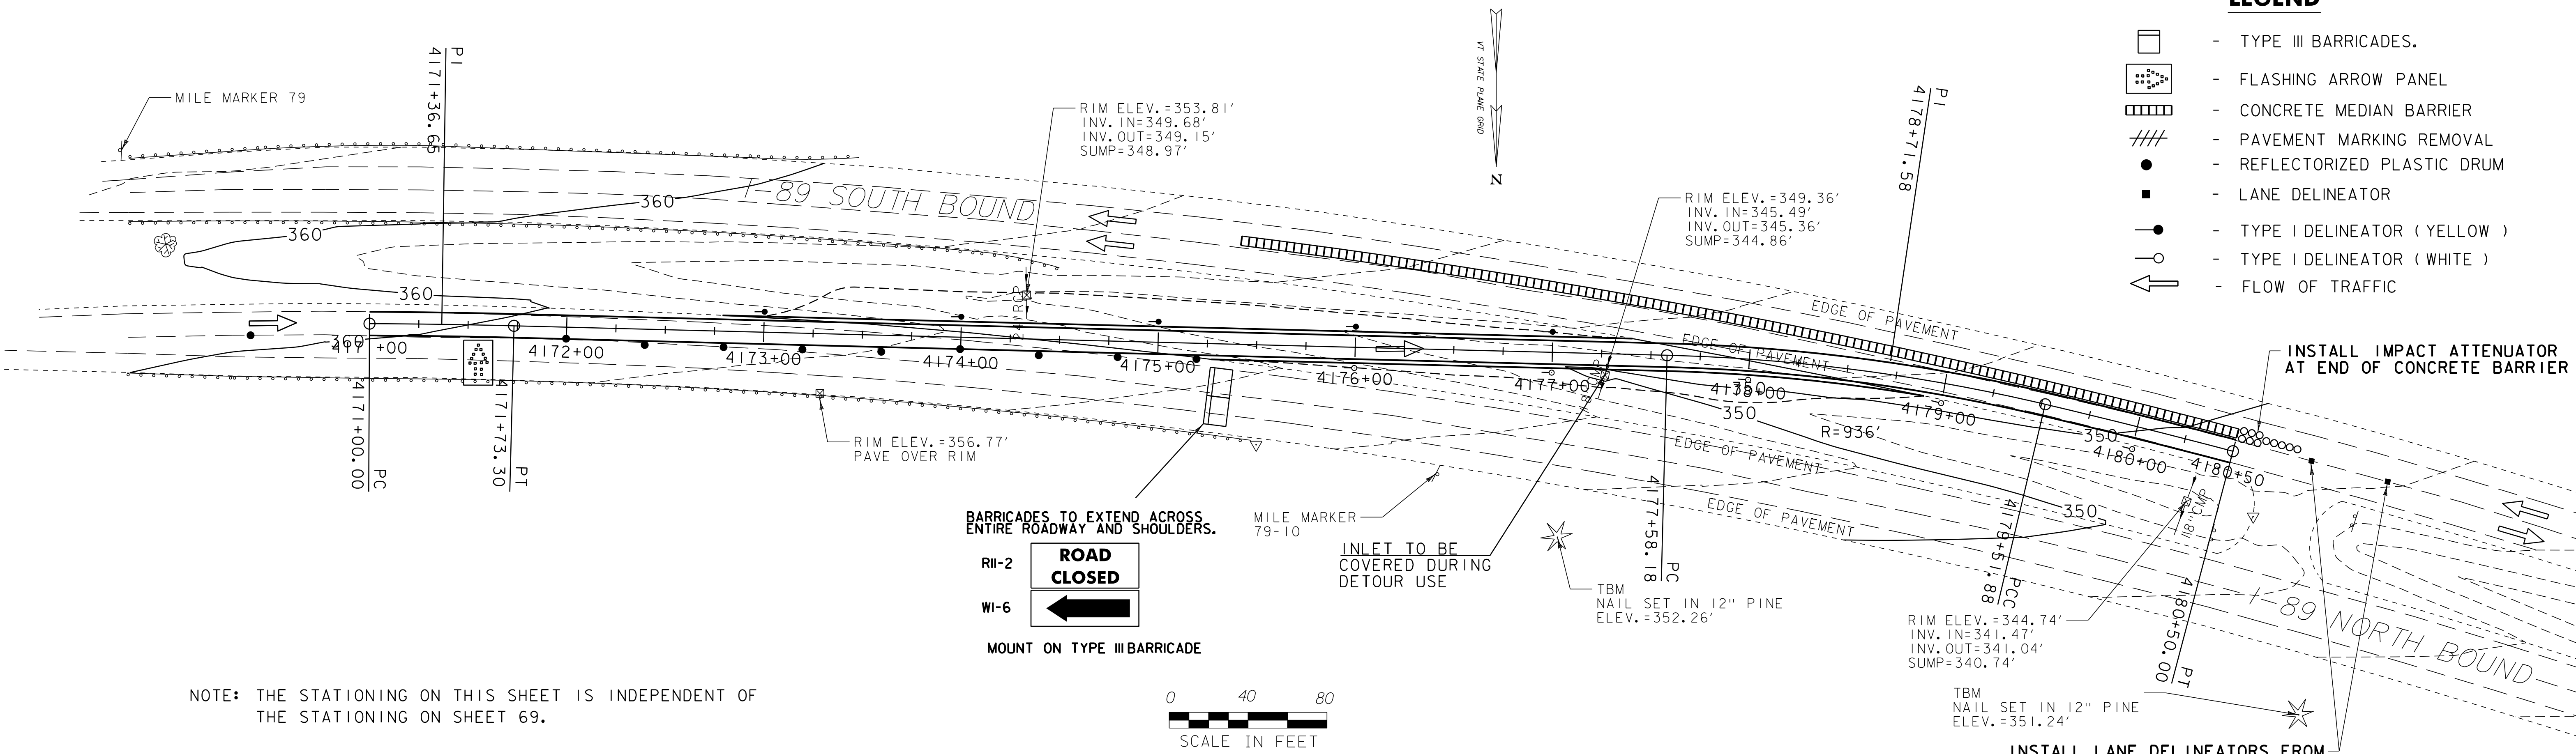


LEGEND

-  - TYPE III BARRICADES.
-  - FLASHING ARROW PANEL
-  - CONCRETE MEDIAN BARRIER
-  - PAVEMENT MARKING REMOVAL
-  - REFLECTORIZED PLASTIC DRUM
-  - LANE DELINEATOR
-  - TYPE I DELINEATOR (YELLOW)
-  - TYPE I DELINEATOR (WHITE)
-  - FLOW OF TRAFFIC

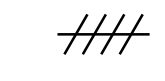

CROSSOVER AT MM 79.00

PROJECT NAME: RICHMOND-SOUTH BURLINGTON
 PROJECT NUMBER: IM 089-2(39)

FILE NAME: p05a012.dgn
 PROJECT LEADER: CRB
 DESIGNED BY: JJB
 CLD 07-0313

PLOT DATE: 02-OCT-2012 16:5
 DRAWN BY: JJB/MRS
 CHECKED BY: DH
 SHEET 82 OF 91

