




4172+00

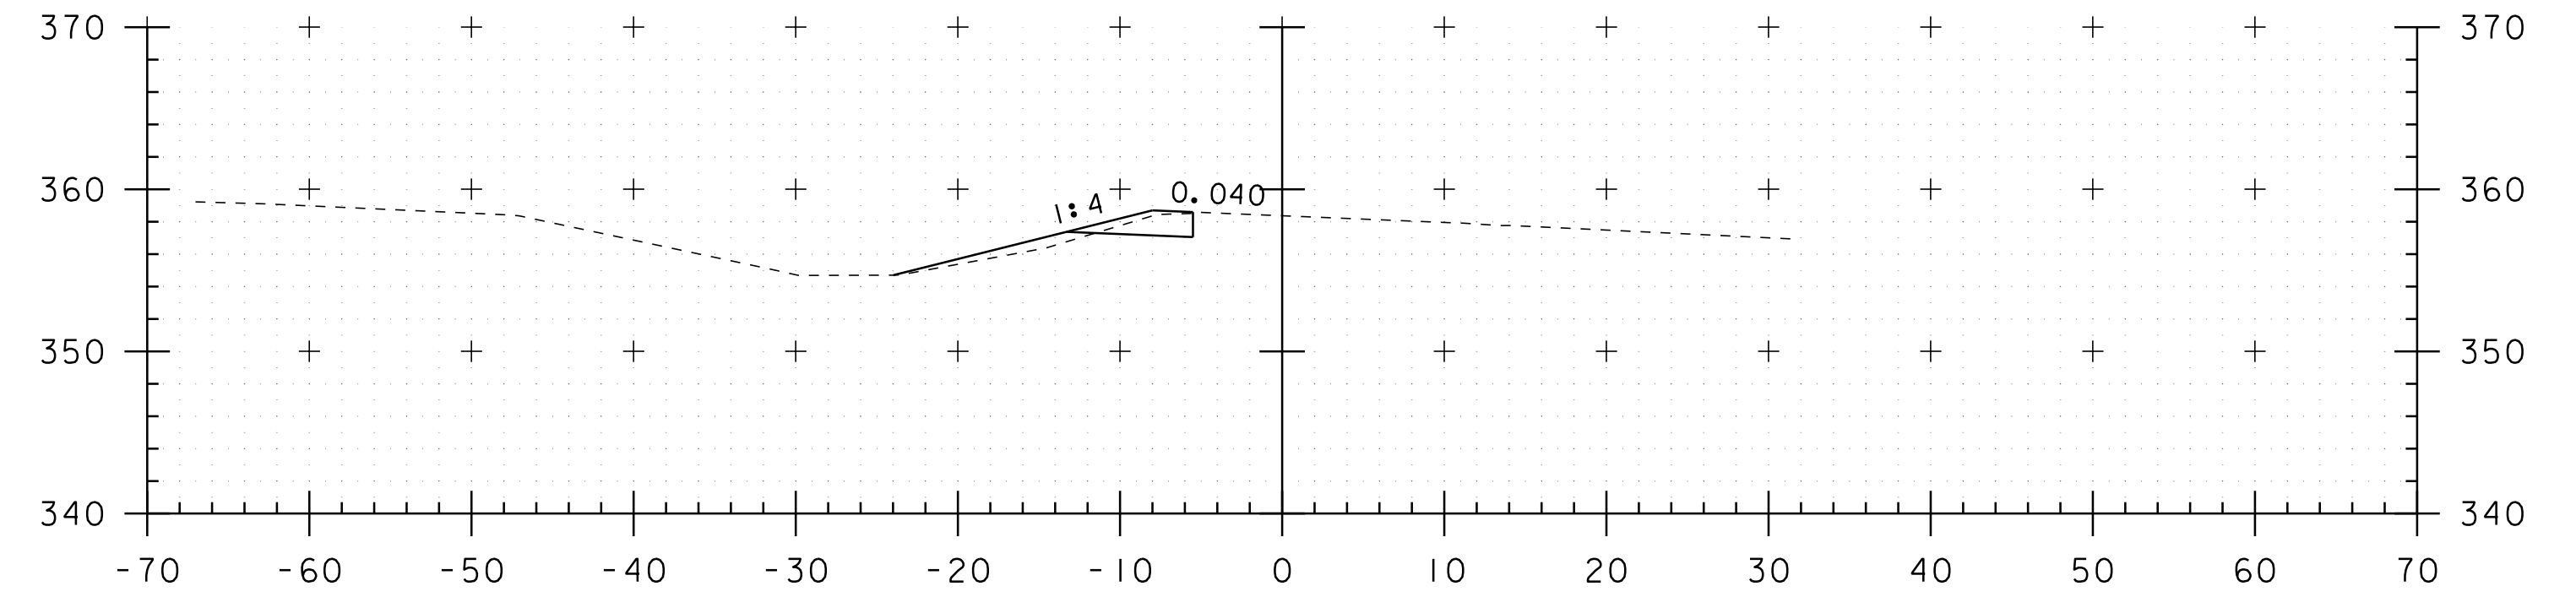


4173+50

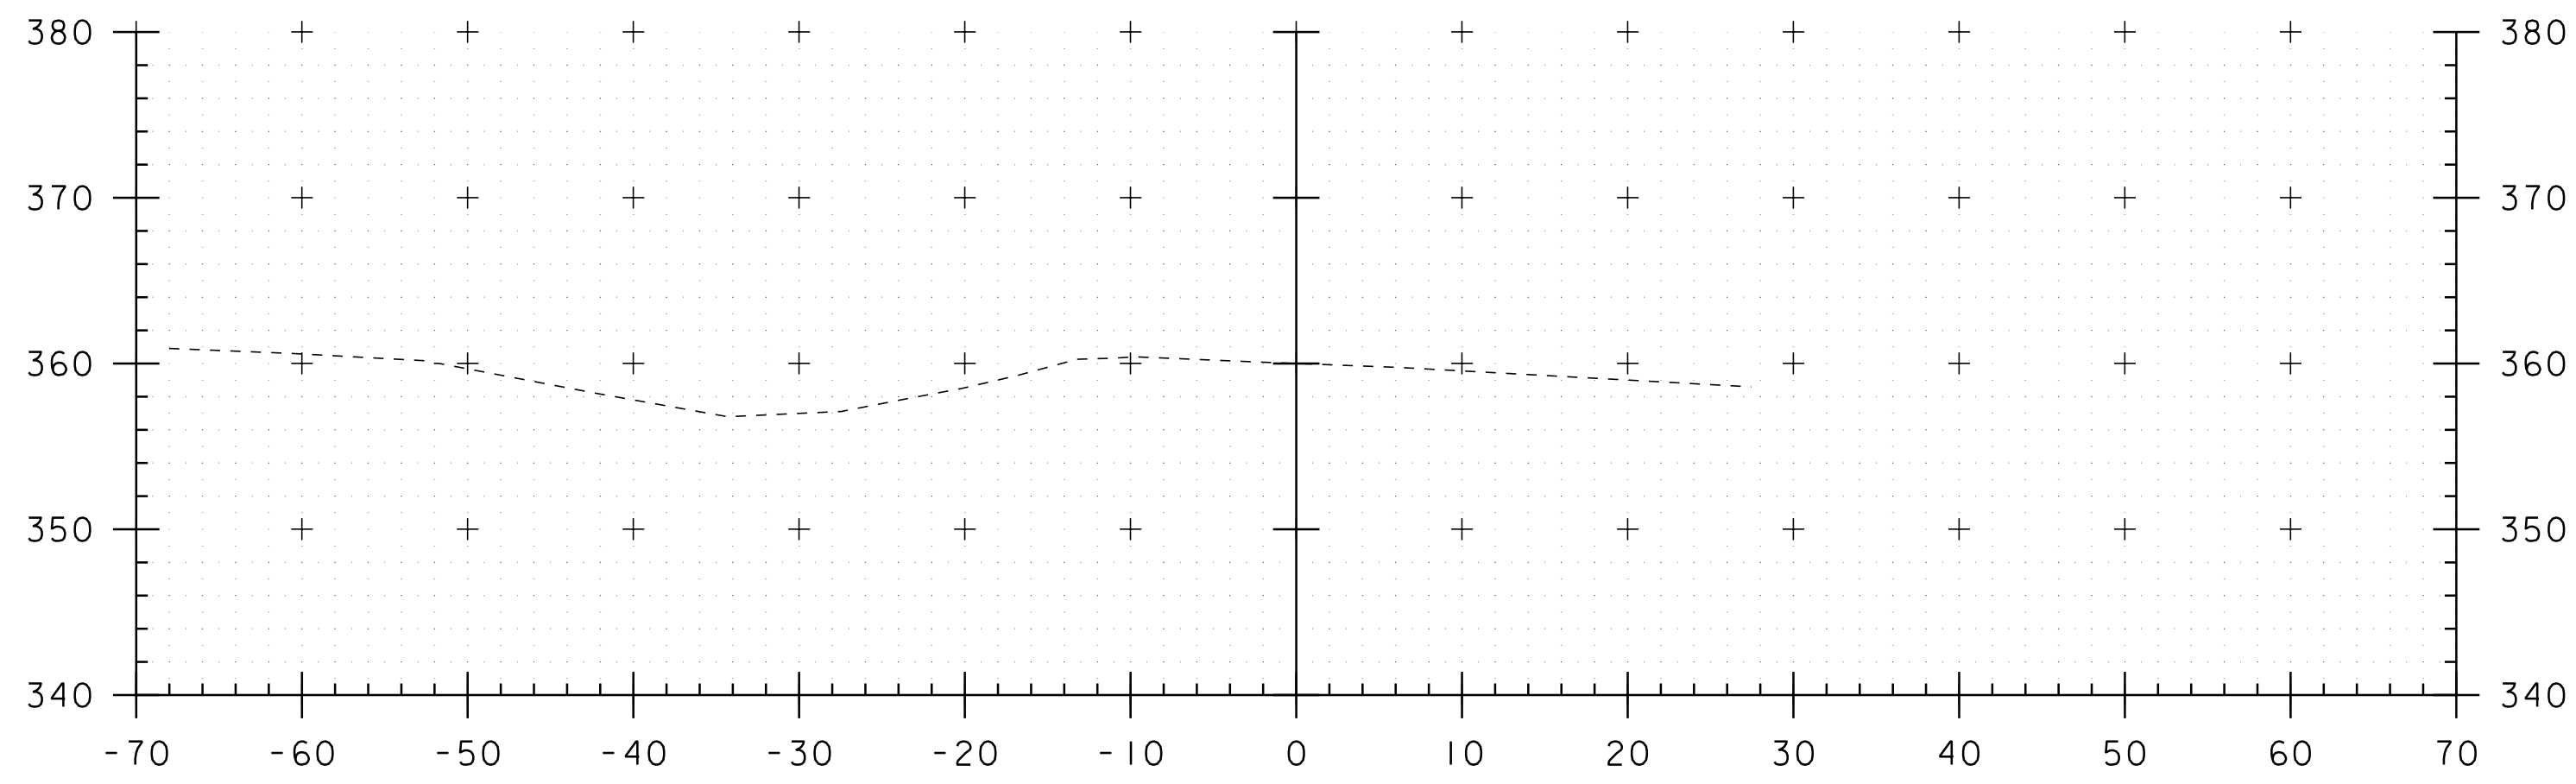


4171+50

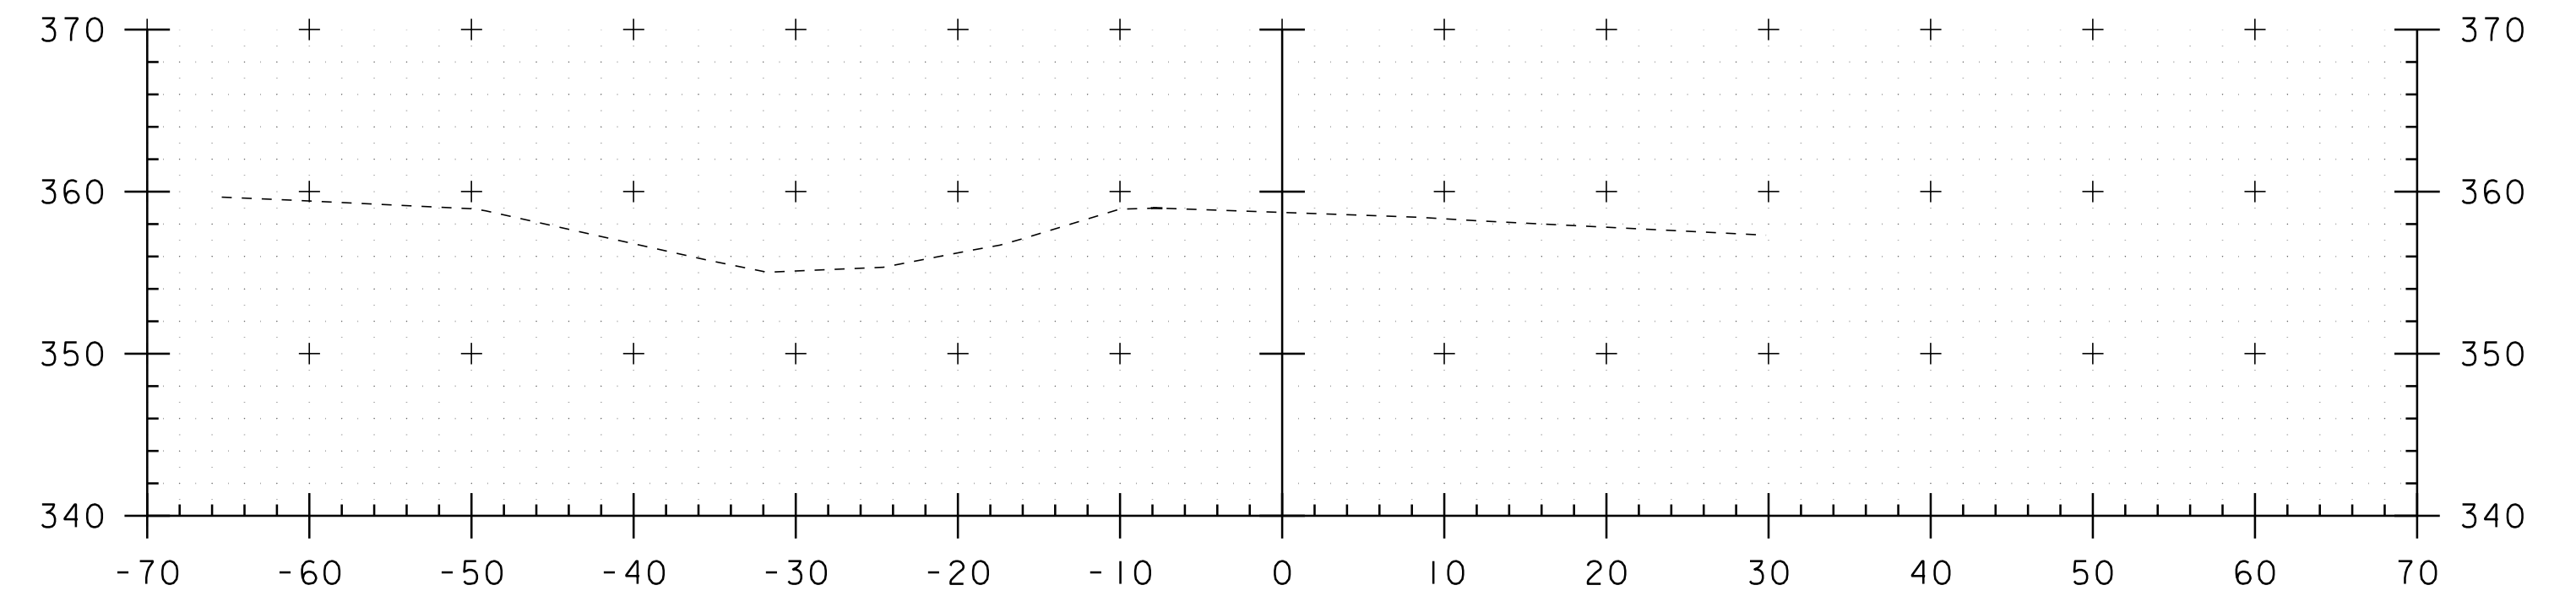

4173+00

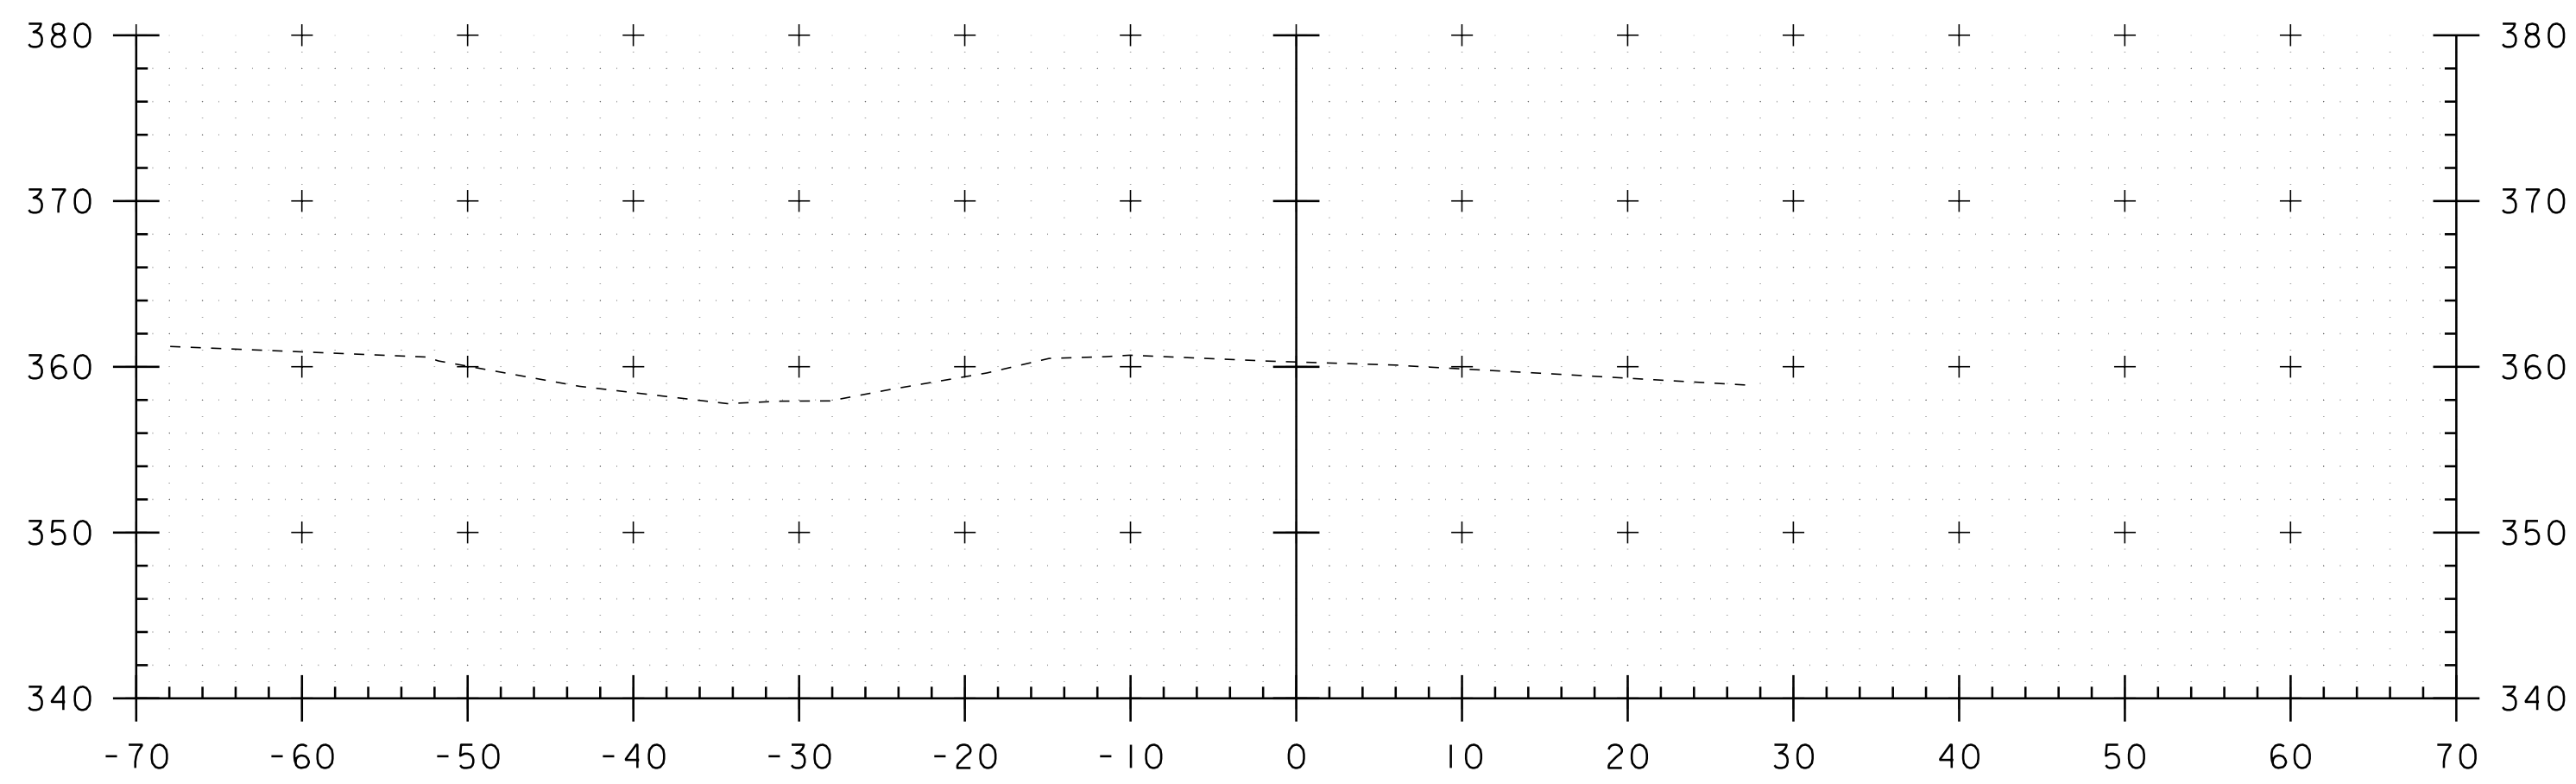

4171+00

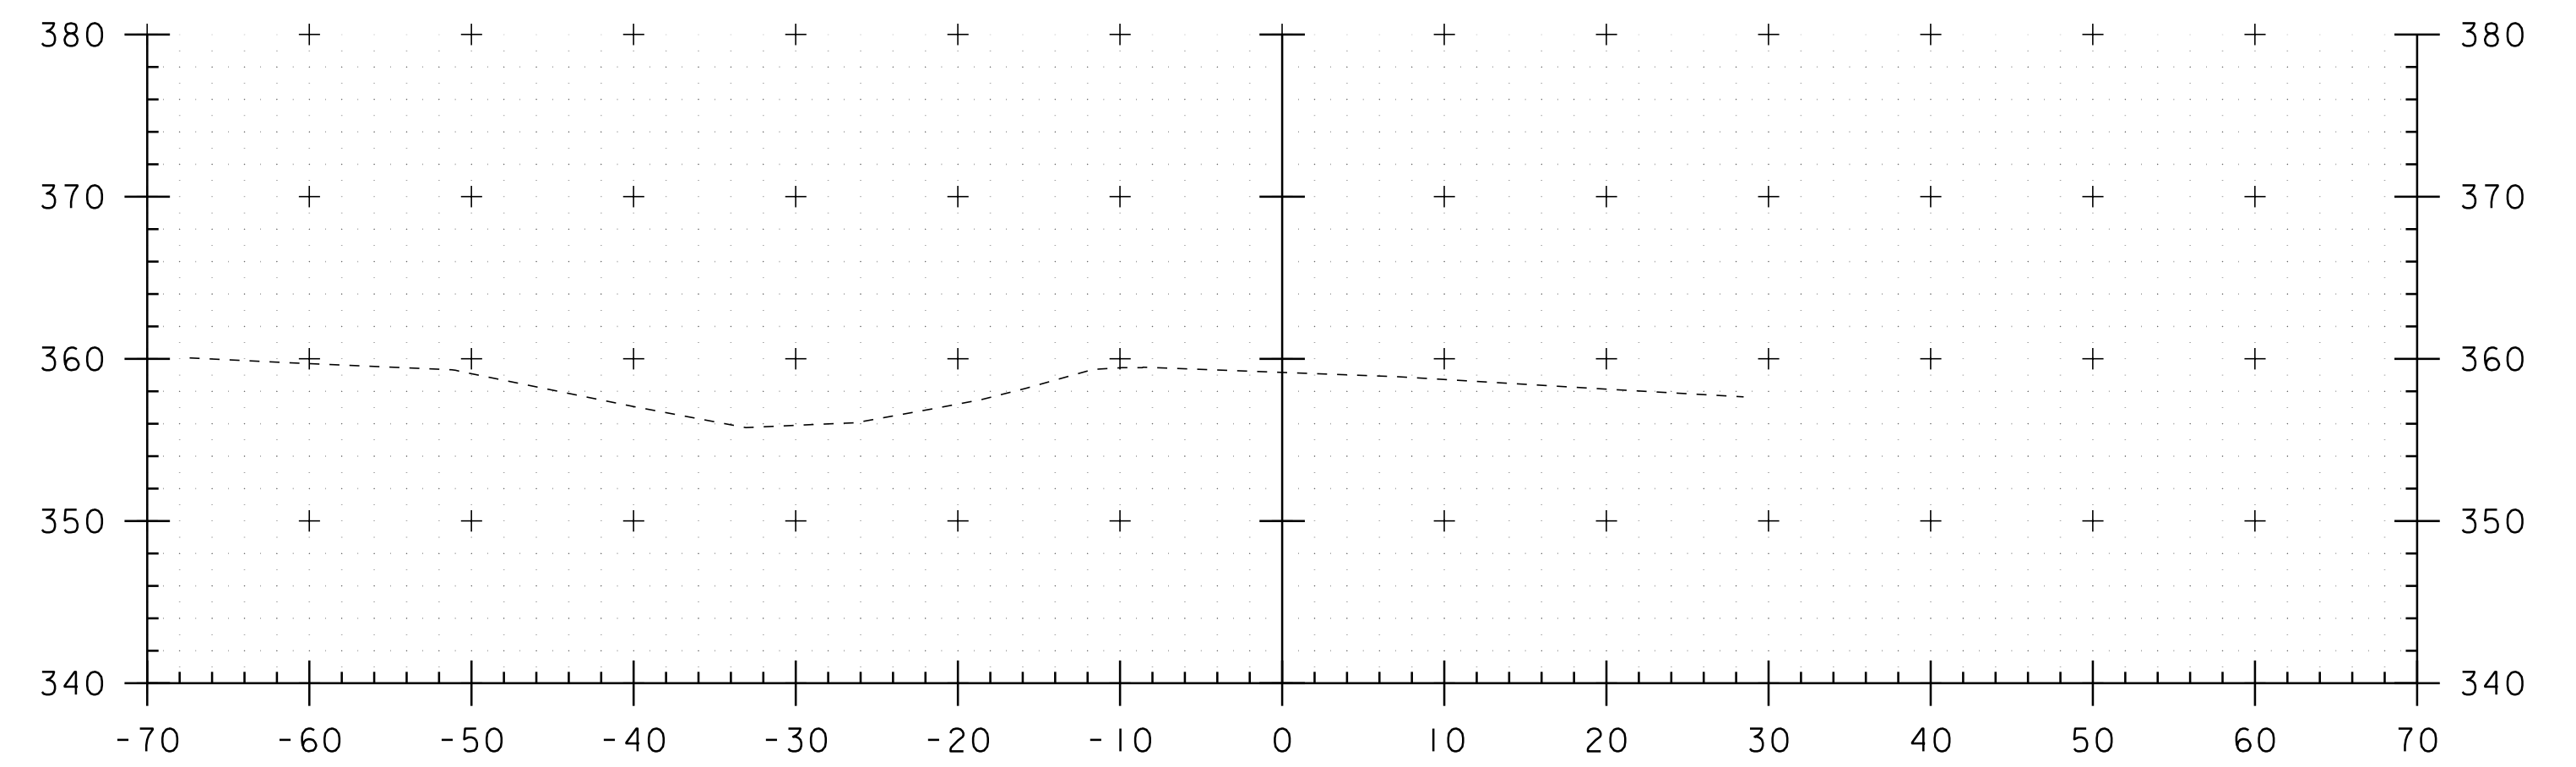

4172+50

CROSSOVER AT MM 79.00

PROJECT NAME: RICHMOND-SOUTH BURLINGTON
PROJECT NUMBER: IM 089-2(39)

FILE NAME: p05a012.dgn
PROJECT LEADER: CRB
DESIGNED BY: JJB
CLD 07-0313

PLOT DATE: 02-OCT-2012 16:5
DRAWN BY: JJB/MRS
CHECKED BY: DH
SHEET 84 OF 91



STA. 4171+00 TO STA. 4173+50