




4175+00

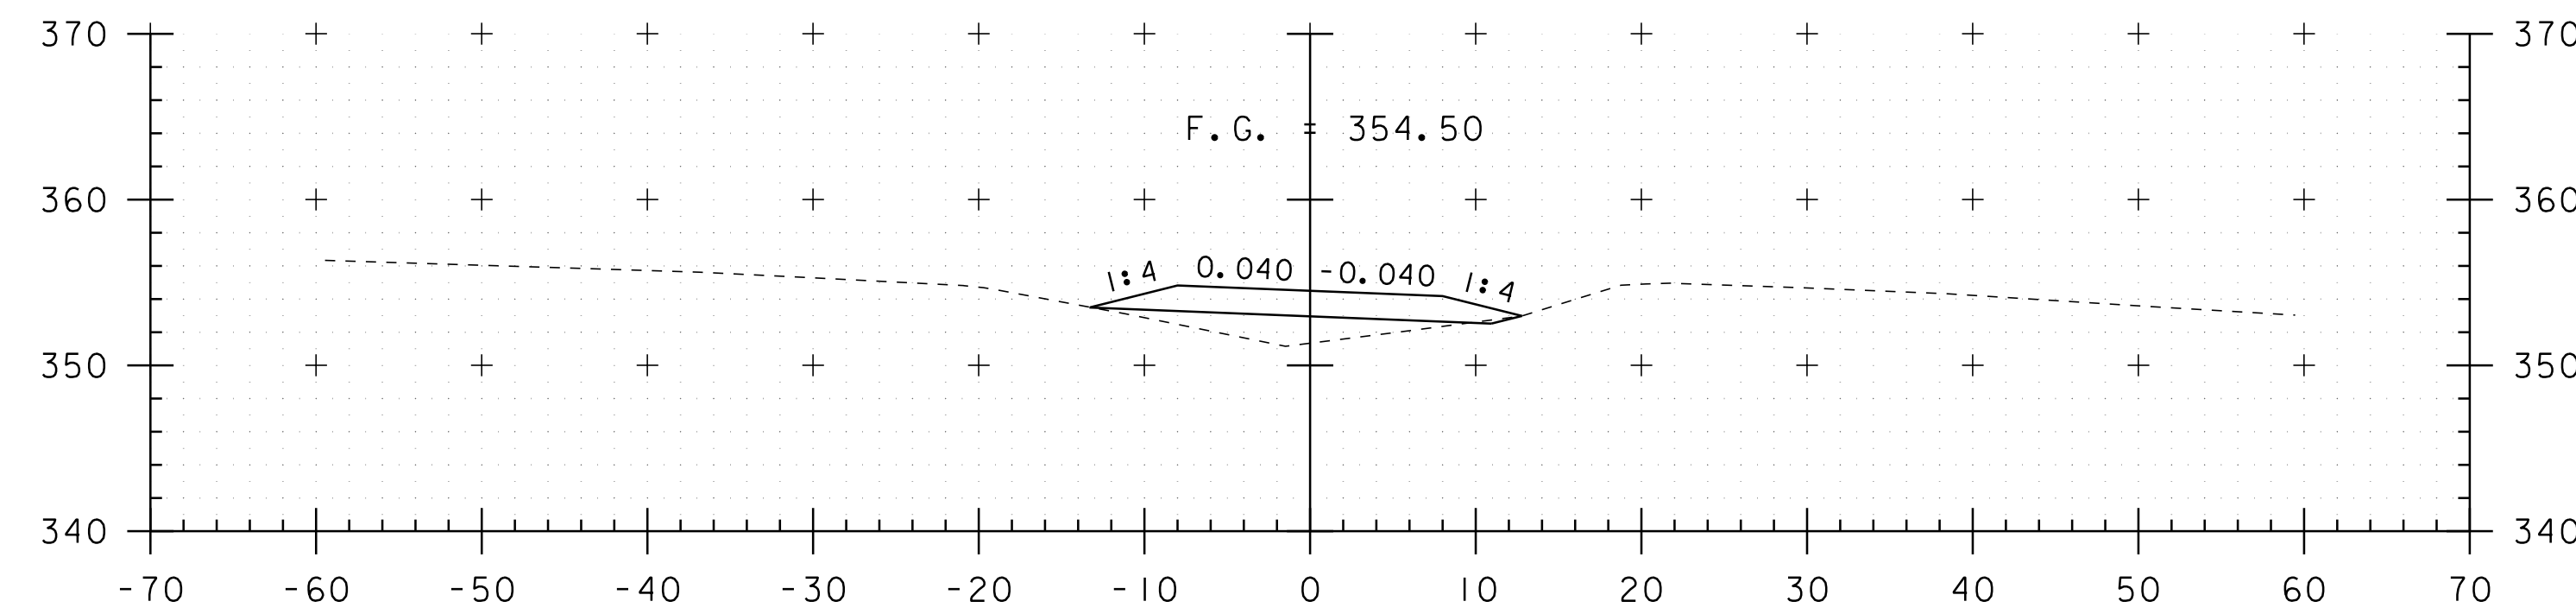


4176+50

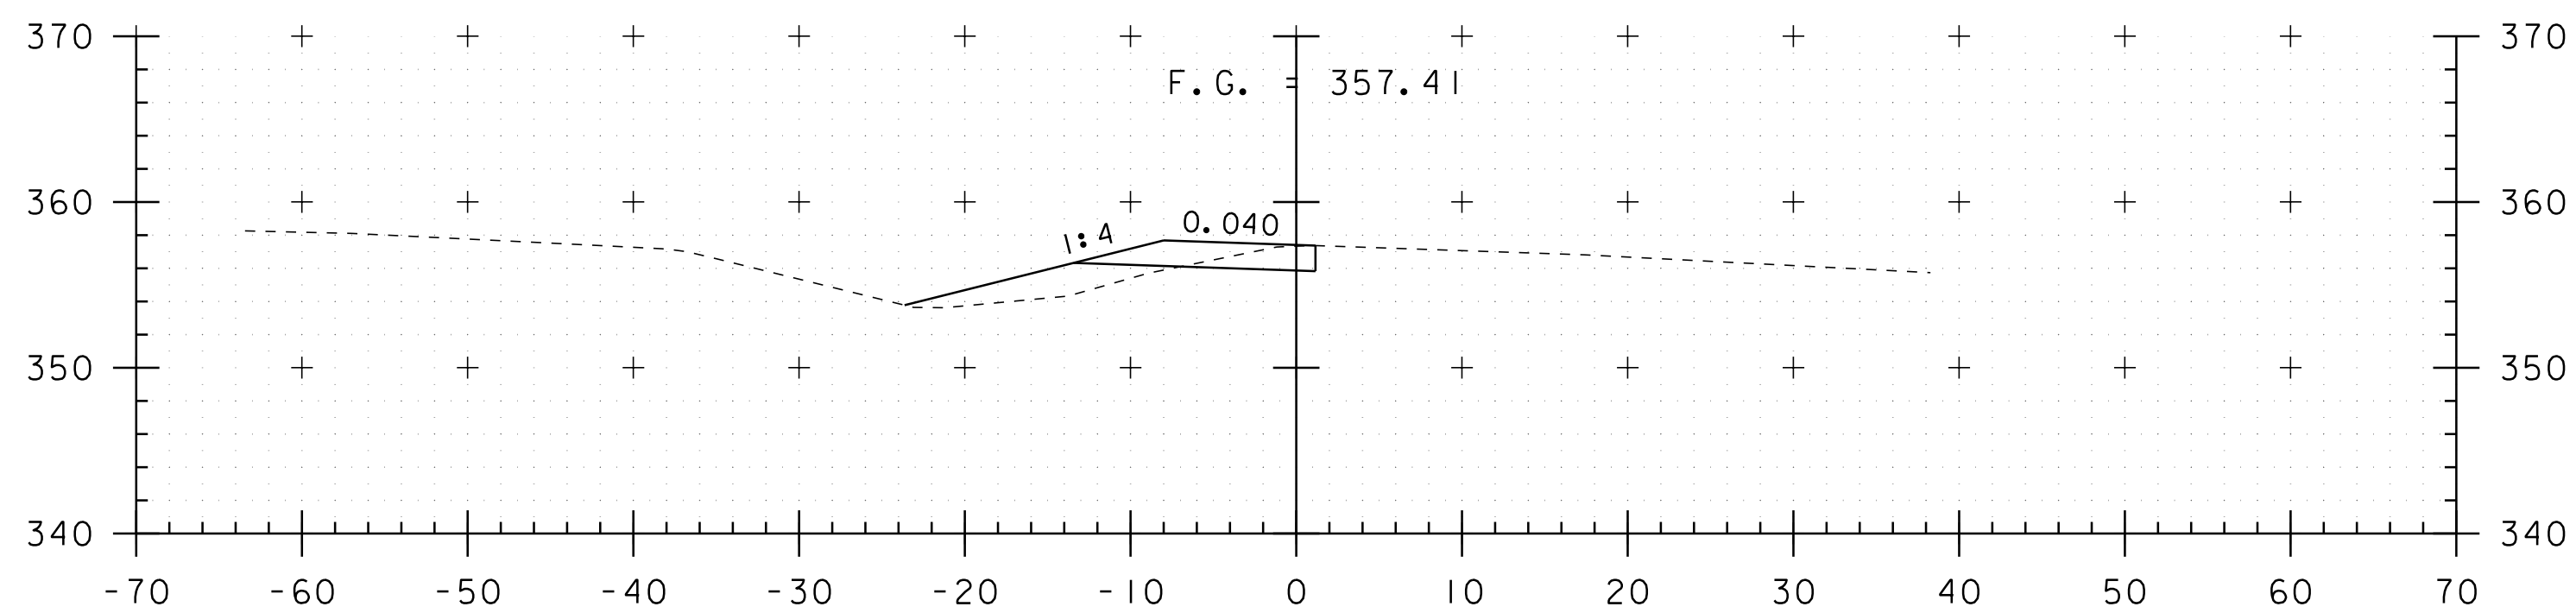


4174+50

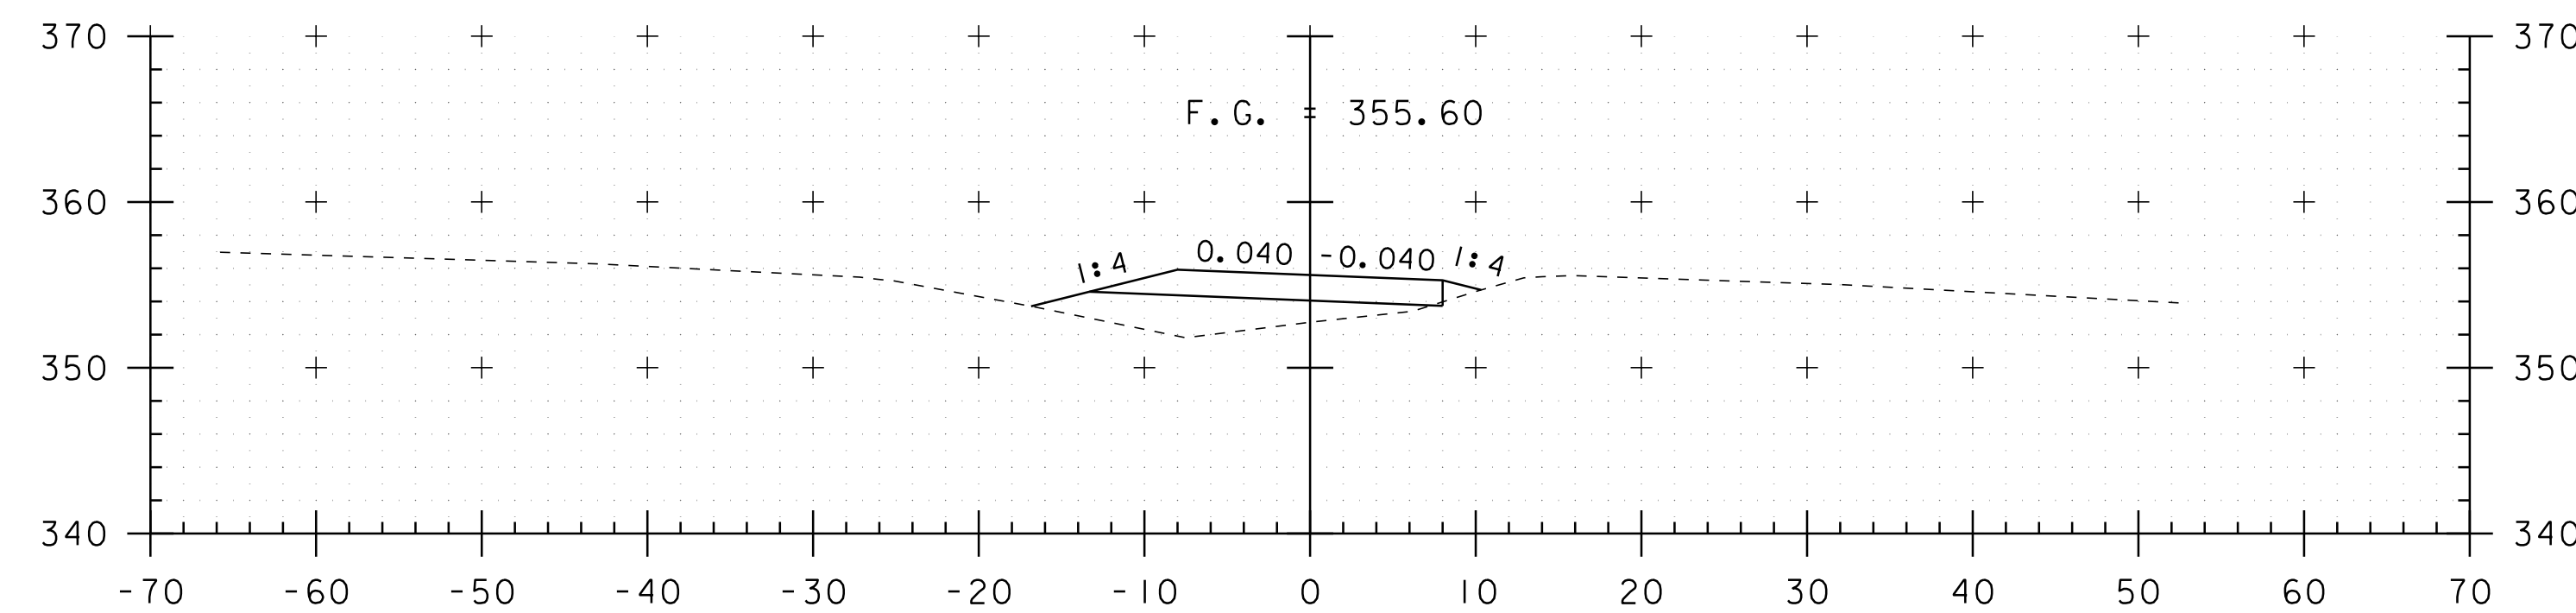

4176+00

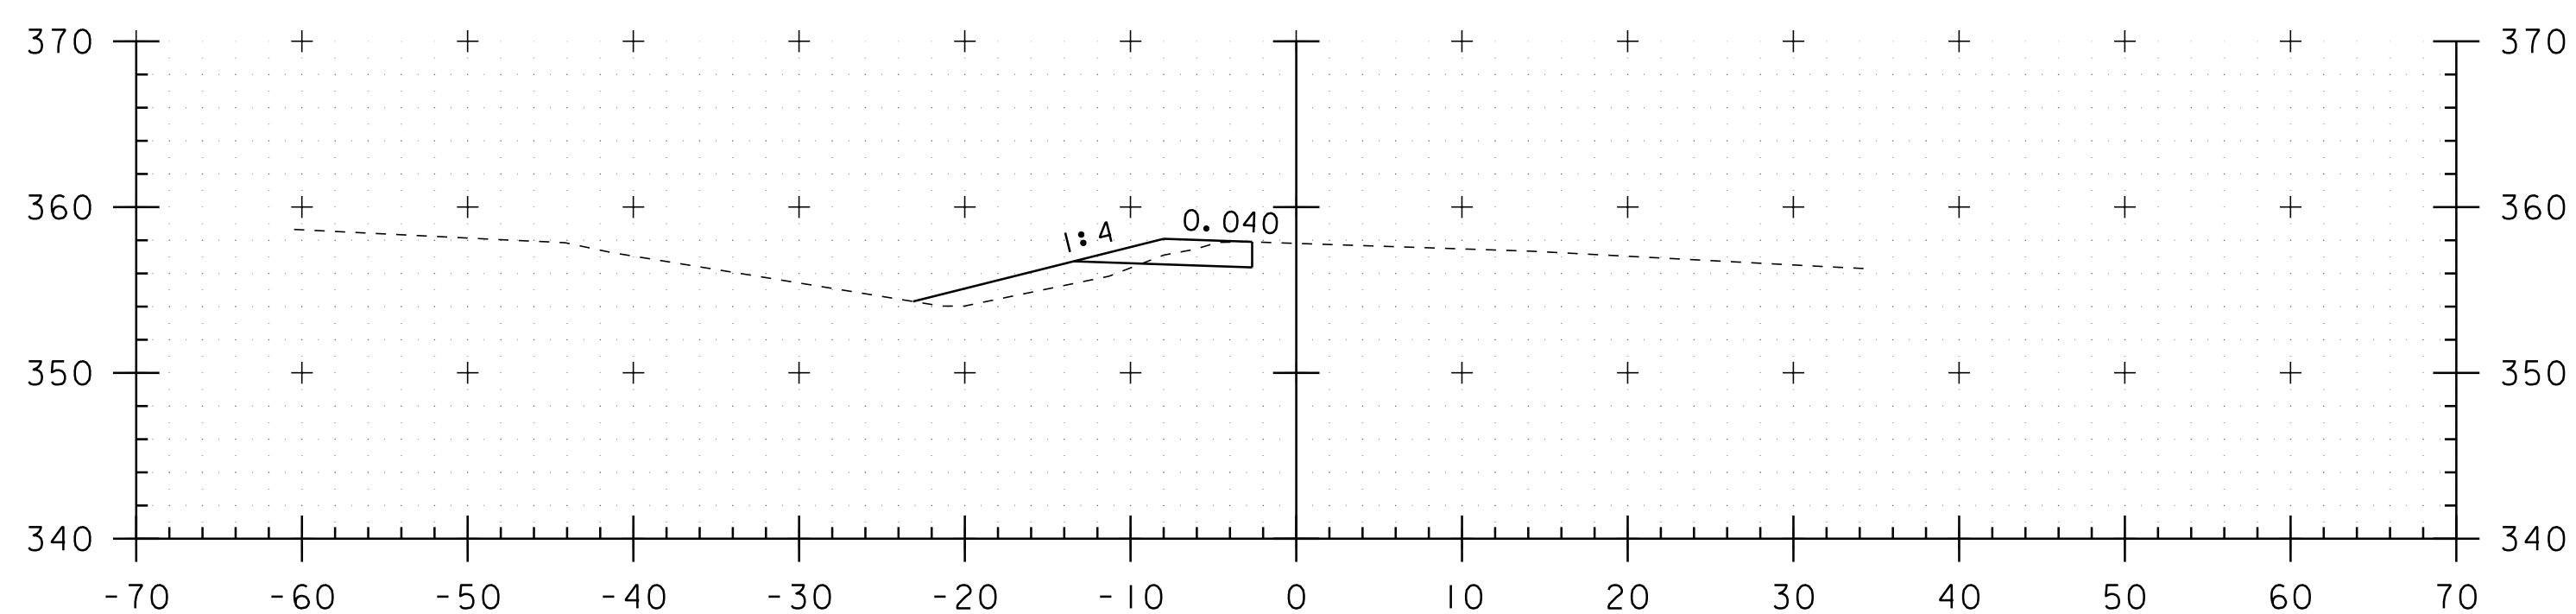

4174+00

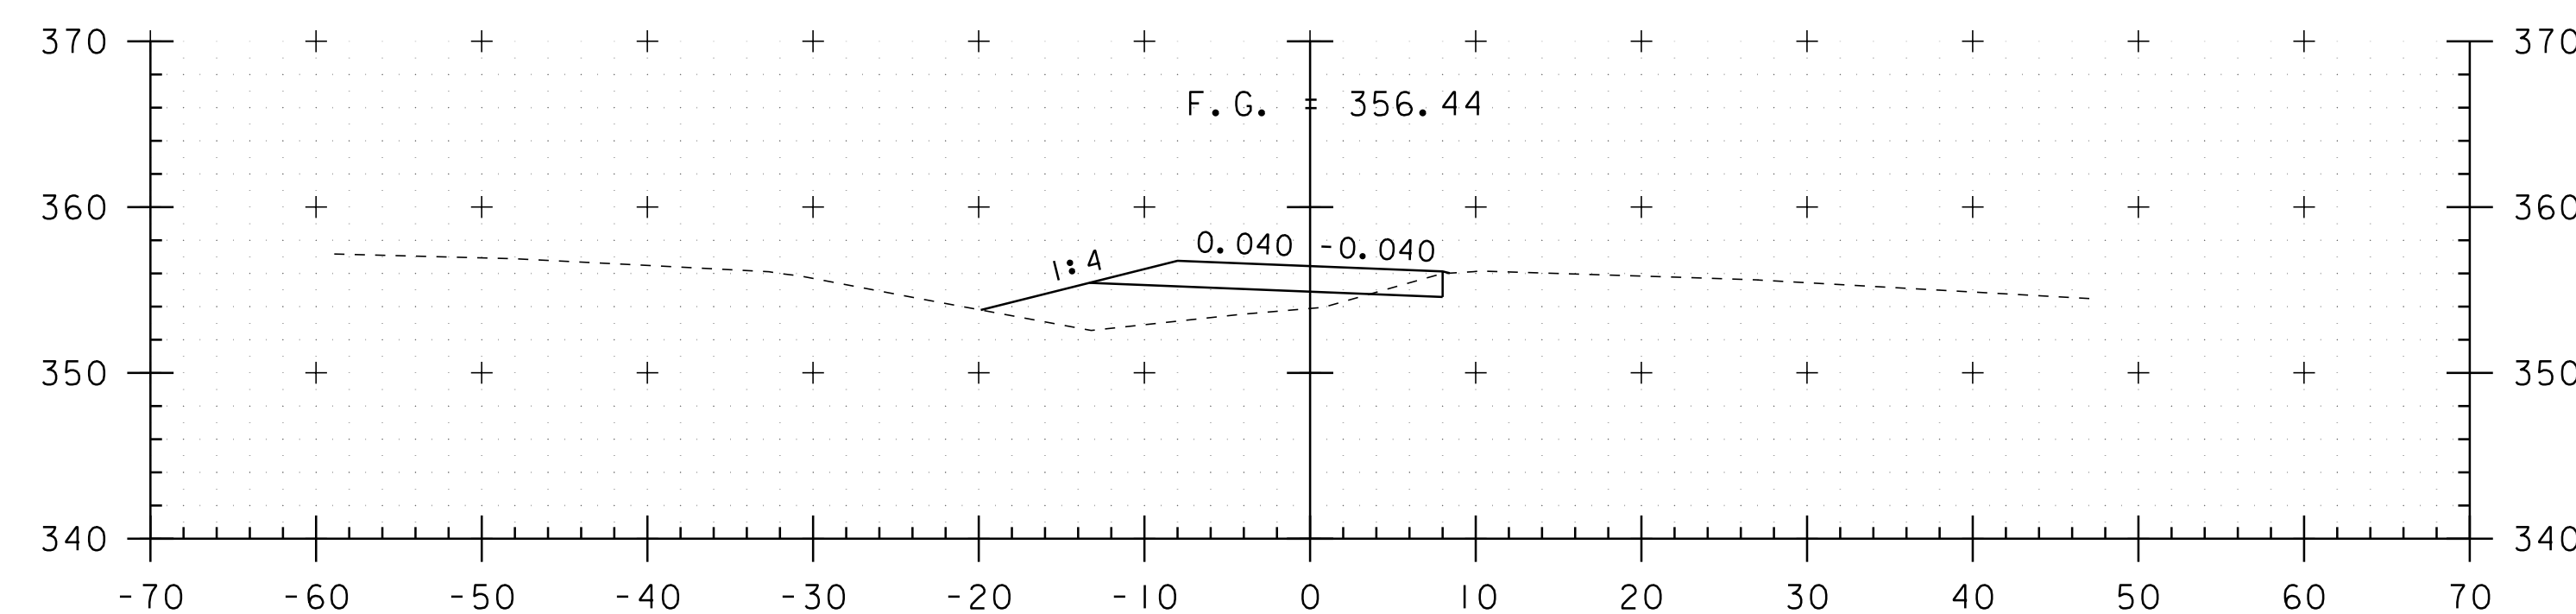


4175+50

CROSSOVER AT MM 79.00

PROJECT NAME: RICHMOND-SOUTH BURLINGTON
 PROJECT NUMBER: IM 089-2(39)

FILE NAME: p05a012.dgn
 PROJECT LEADER: CRB
 DESIGNED BY: JJB
 CLD 07-0313

PLOT DATE: 02-OCT-2012 16:5
 DRAWN BY: JJB/MRS
 CHECKED BY: DH
 SHEET 85 OF 91

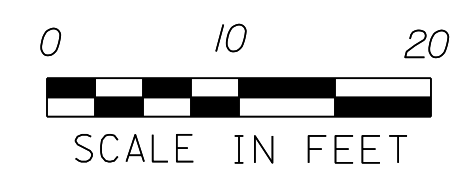

STA. 4174+00 TO STA. 4176+50