




4309+50

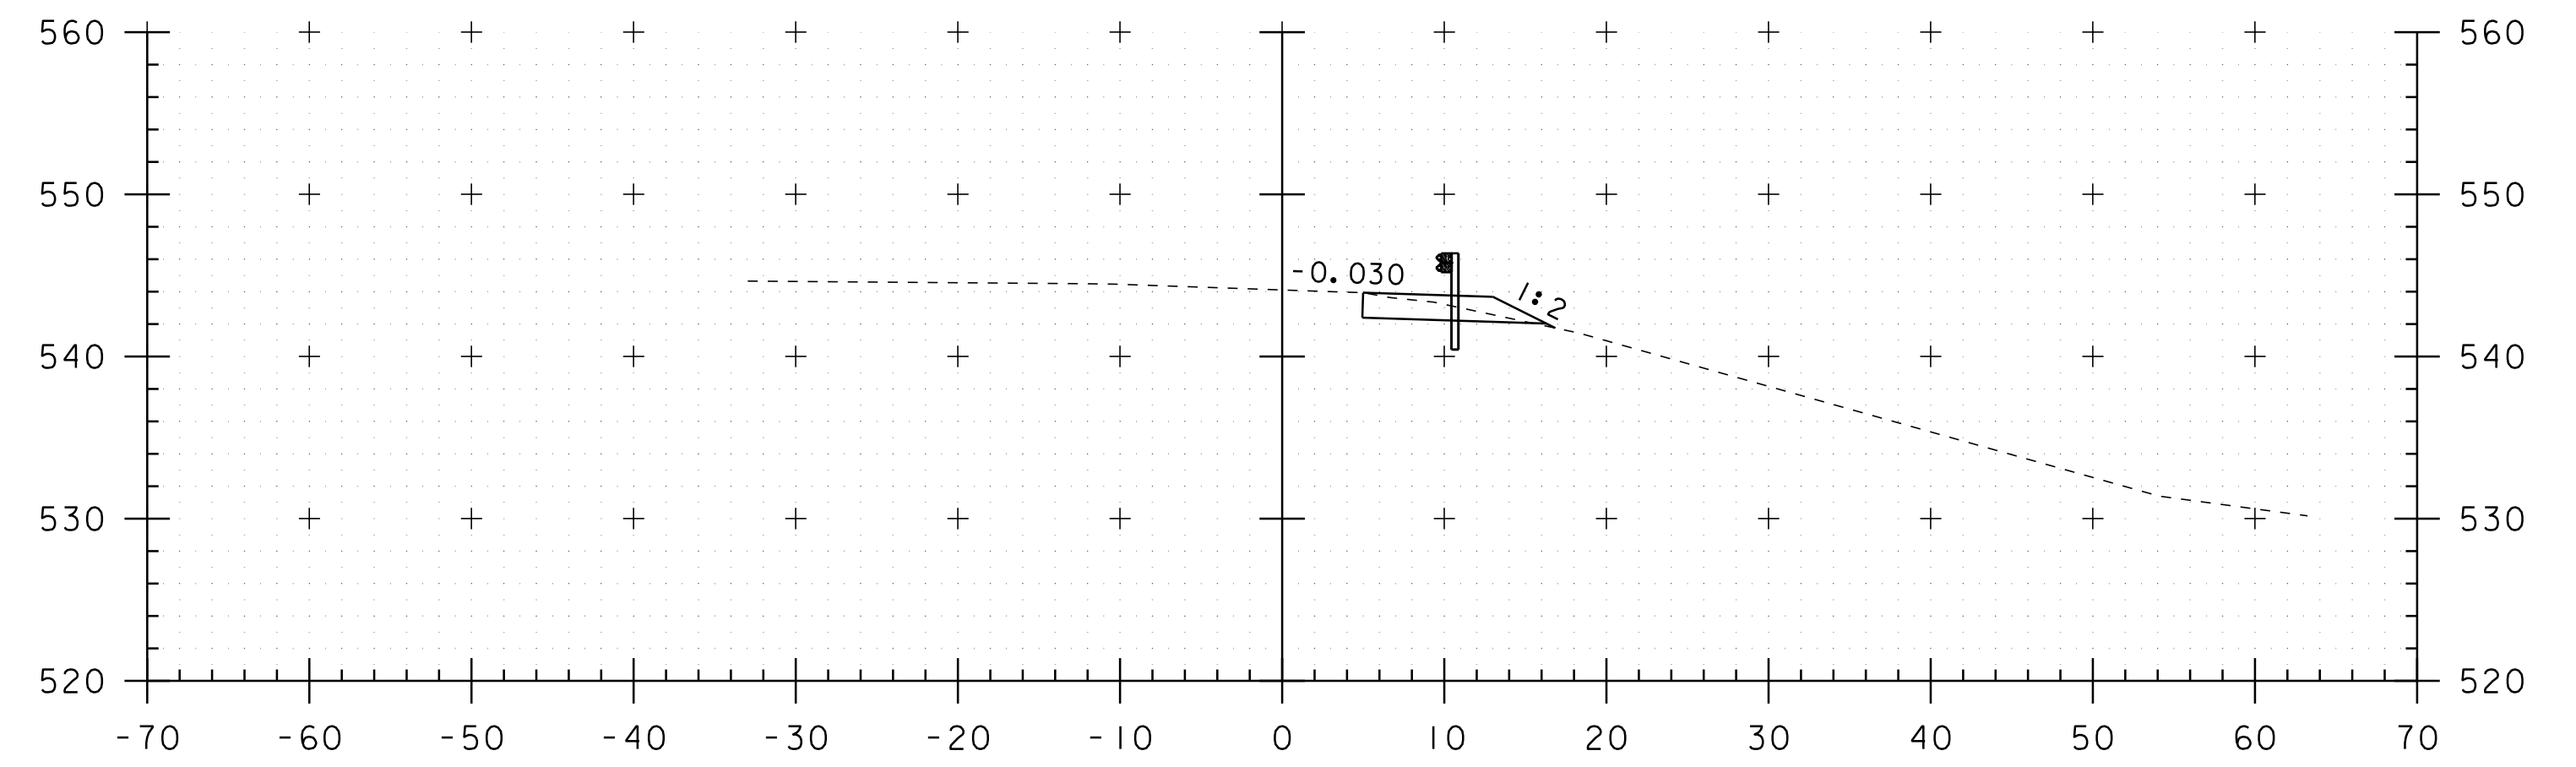


4309+00

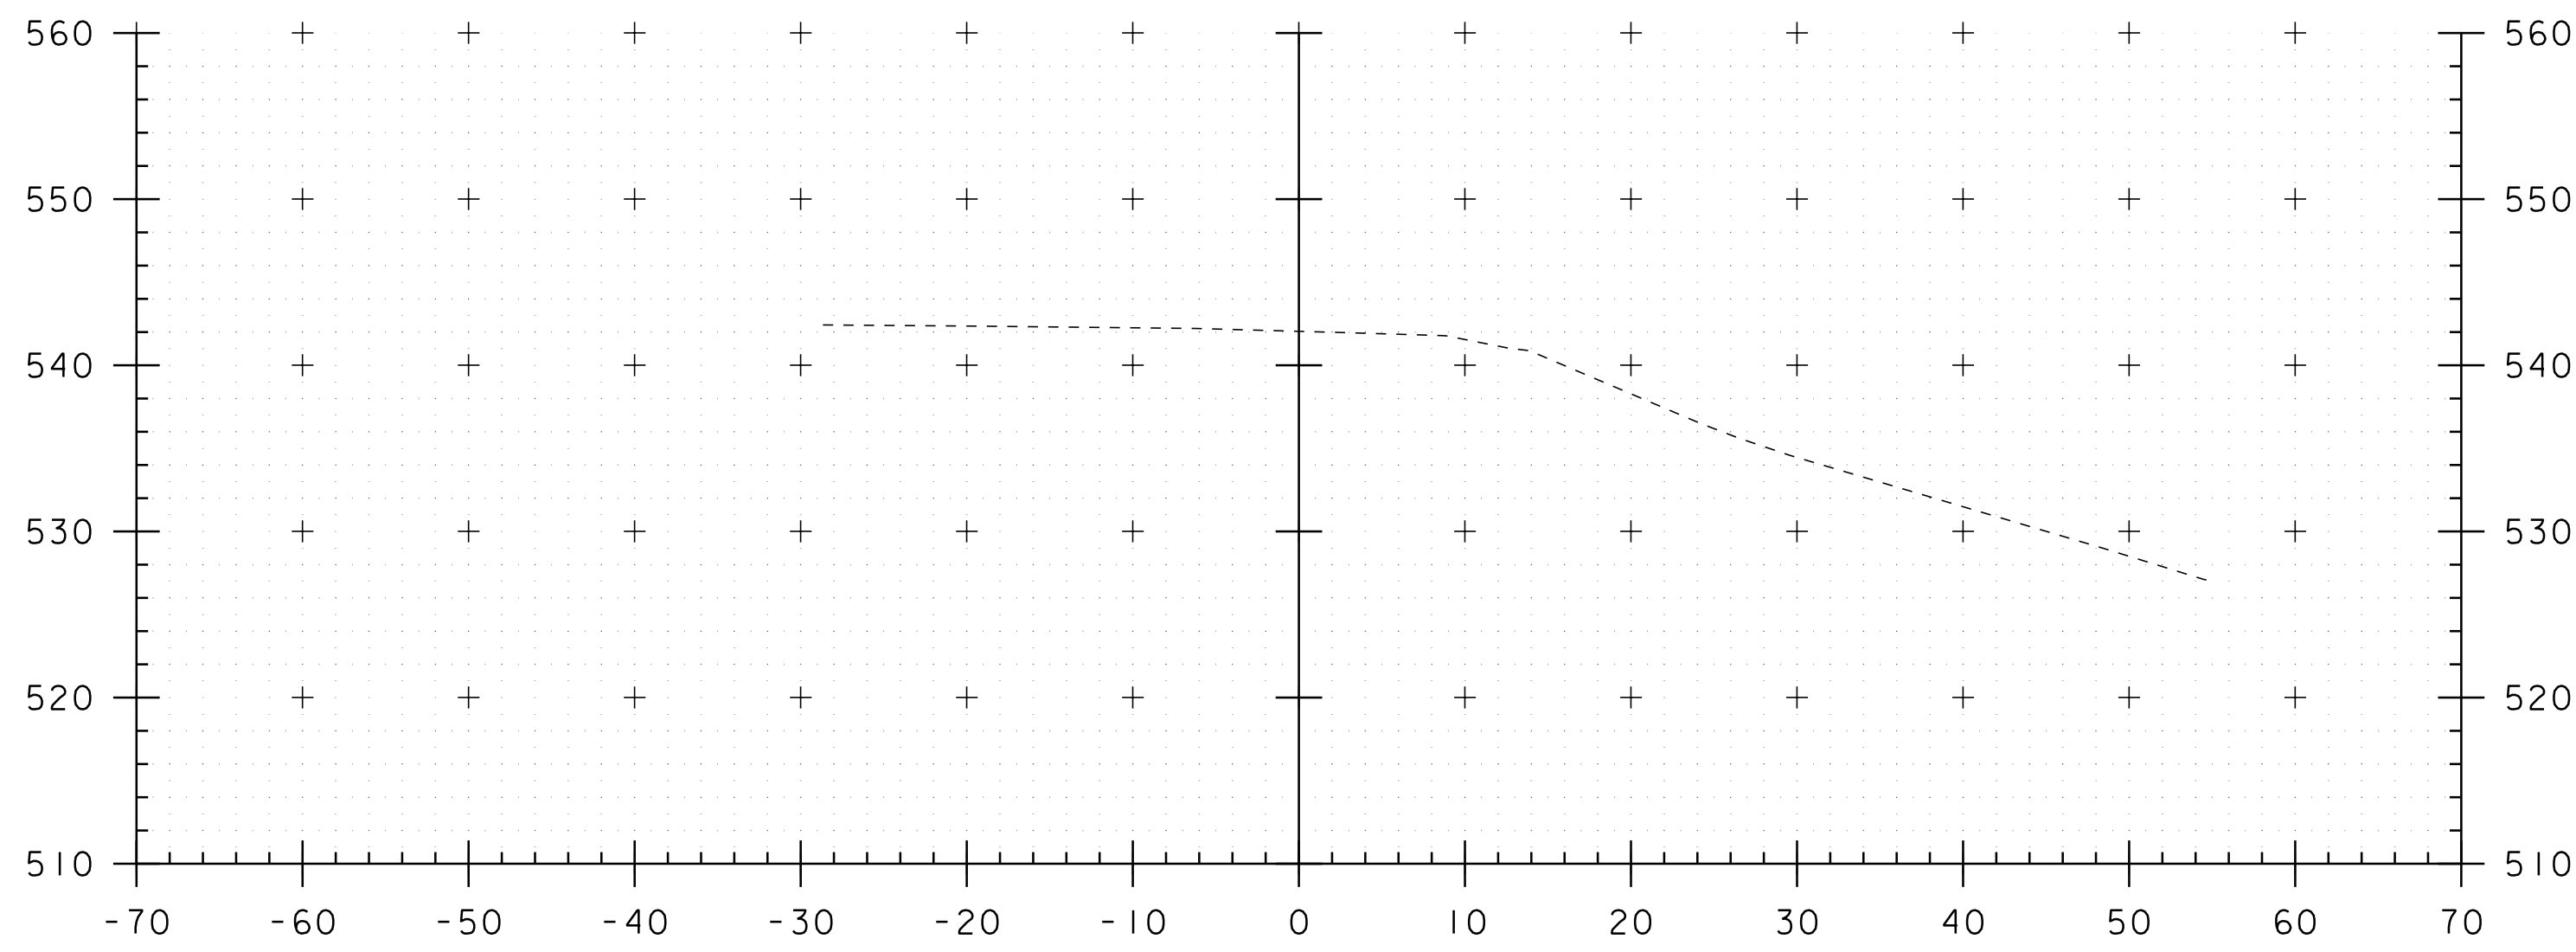

4308+00

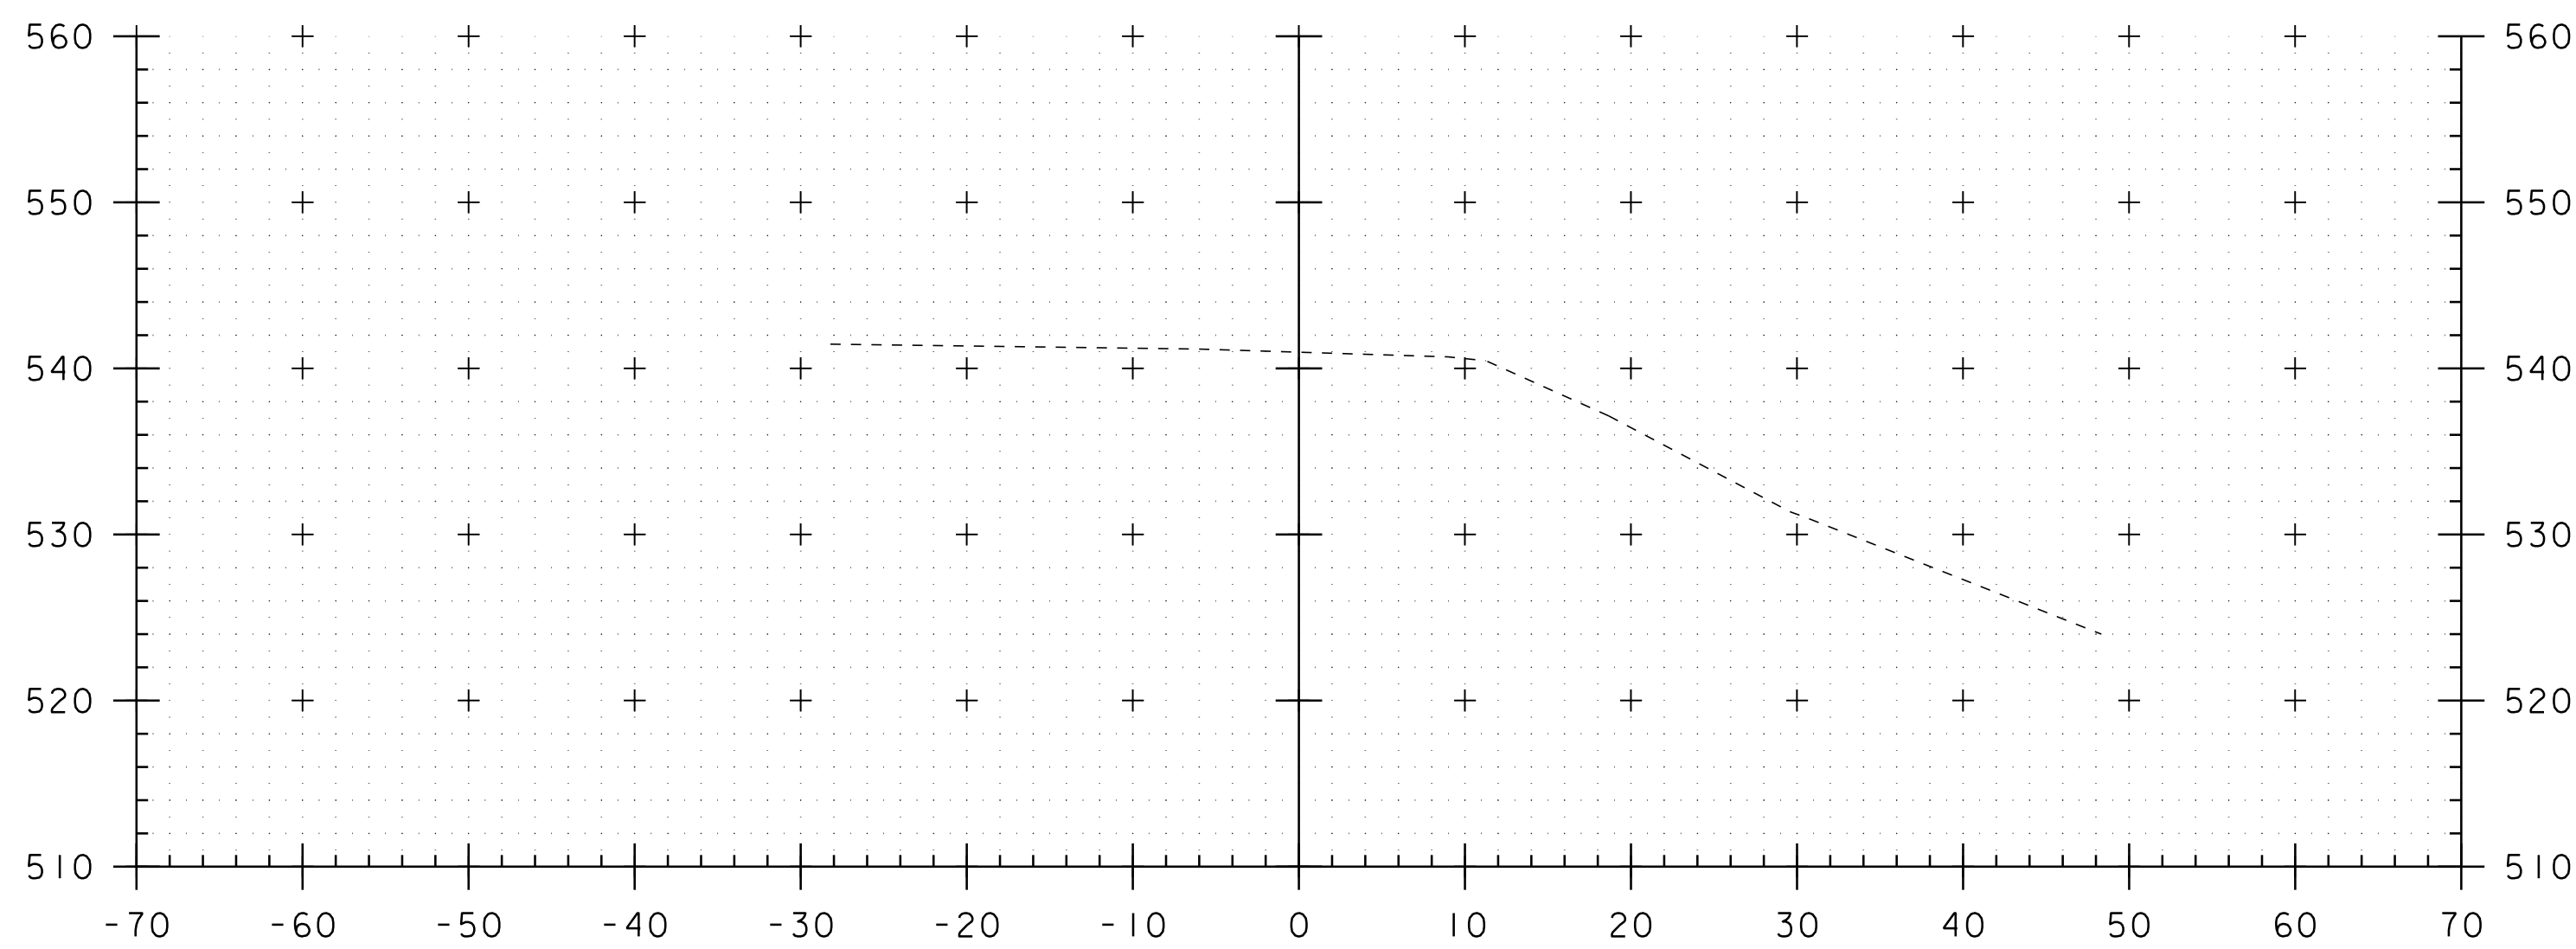

4307+50

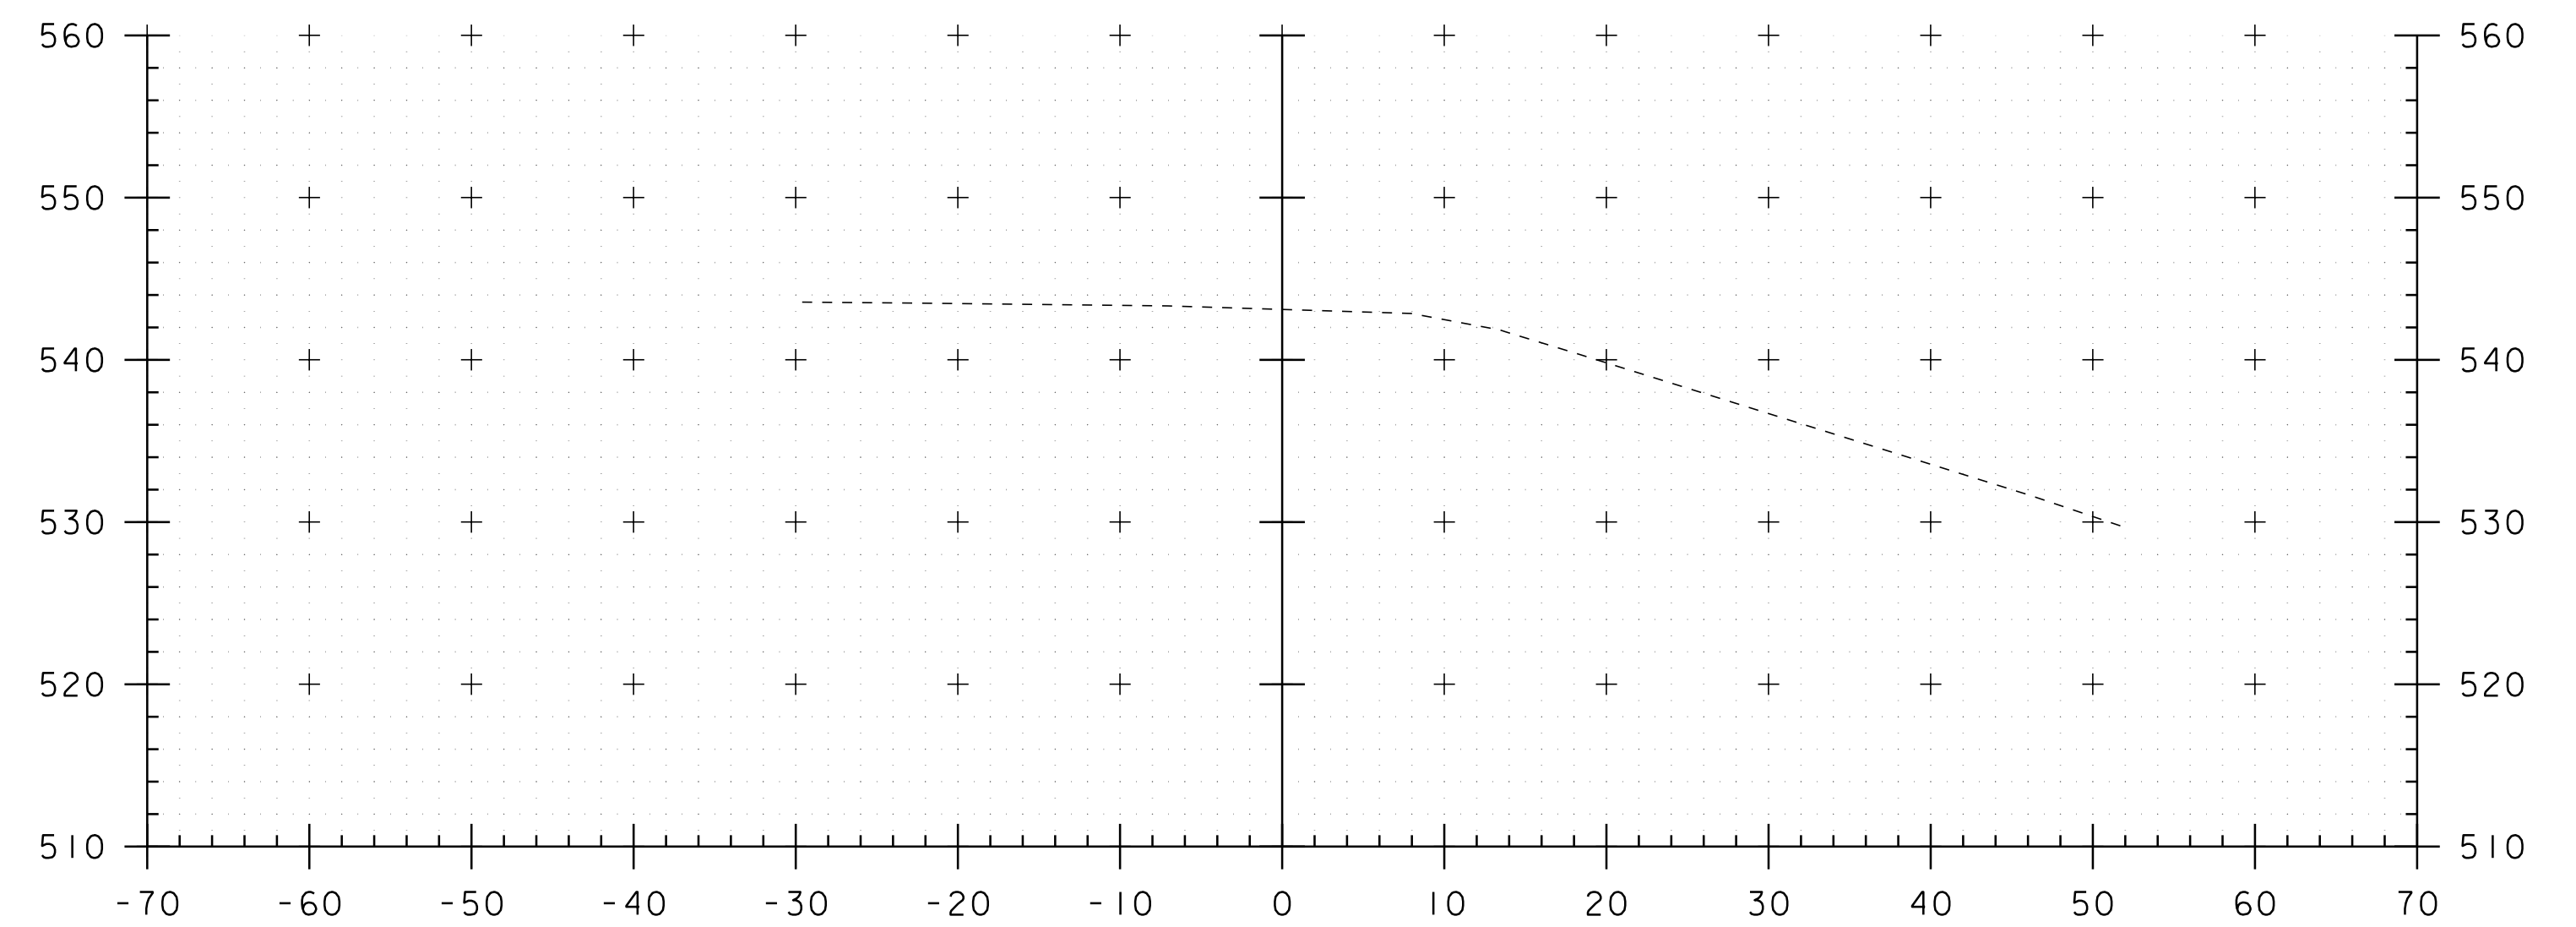

4308+50

CROSSOVER AT MM 81.58

PROJECT NAME: RICHMOND-SOUTH BURLINGTON
 PROJECT NUMBER: IM 089-2(39)

FILE NAME: p05a012.dgn
 PROJECT LEADER: CRB
 DESIGNED BY: JJB
 CLD 07-0313

PLOT DATE: 02-OCT-2012 16:5
 DRAWN BY: JJB/MRS
 CHECKED BY: DH
 SHEET 88 OF 91



STA. 4307+50 TO STA. 4309+50