




4311+00

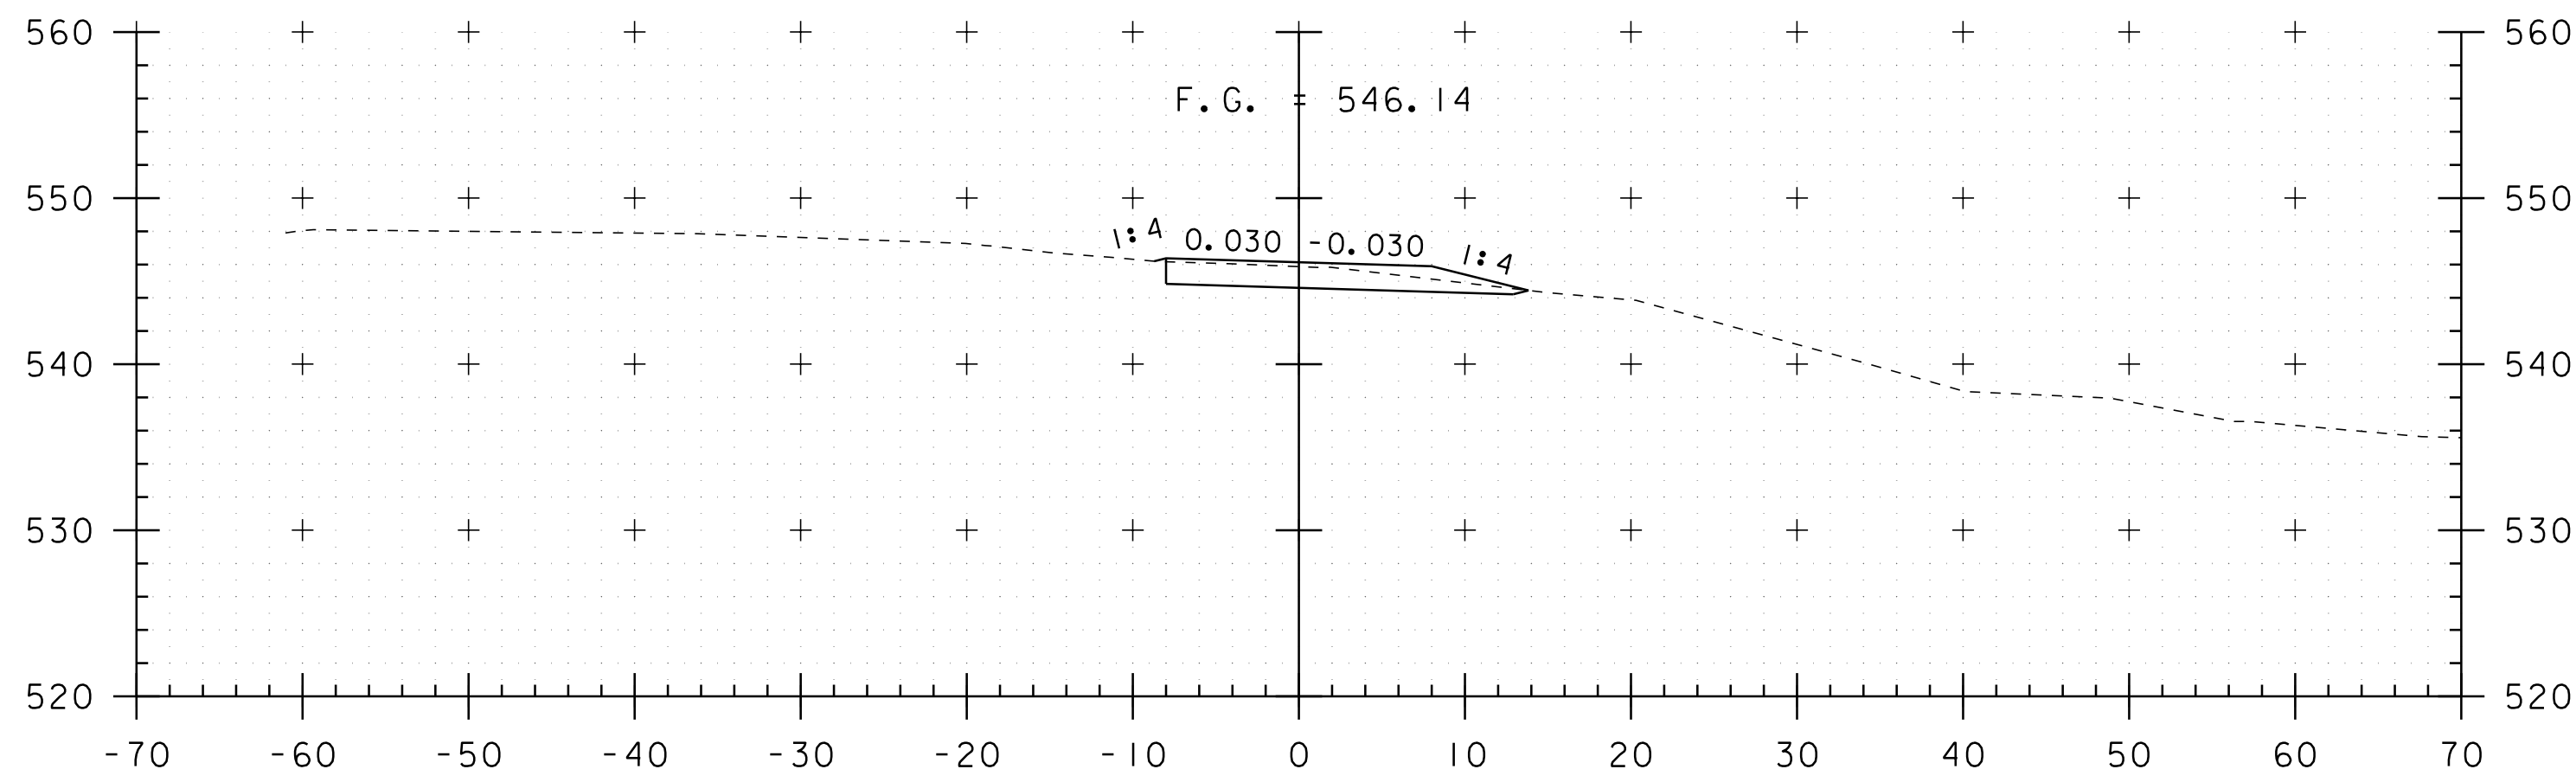


4310+50

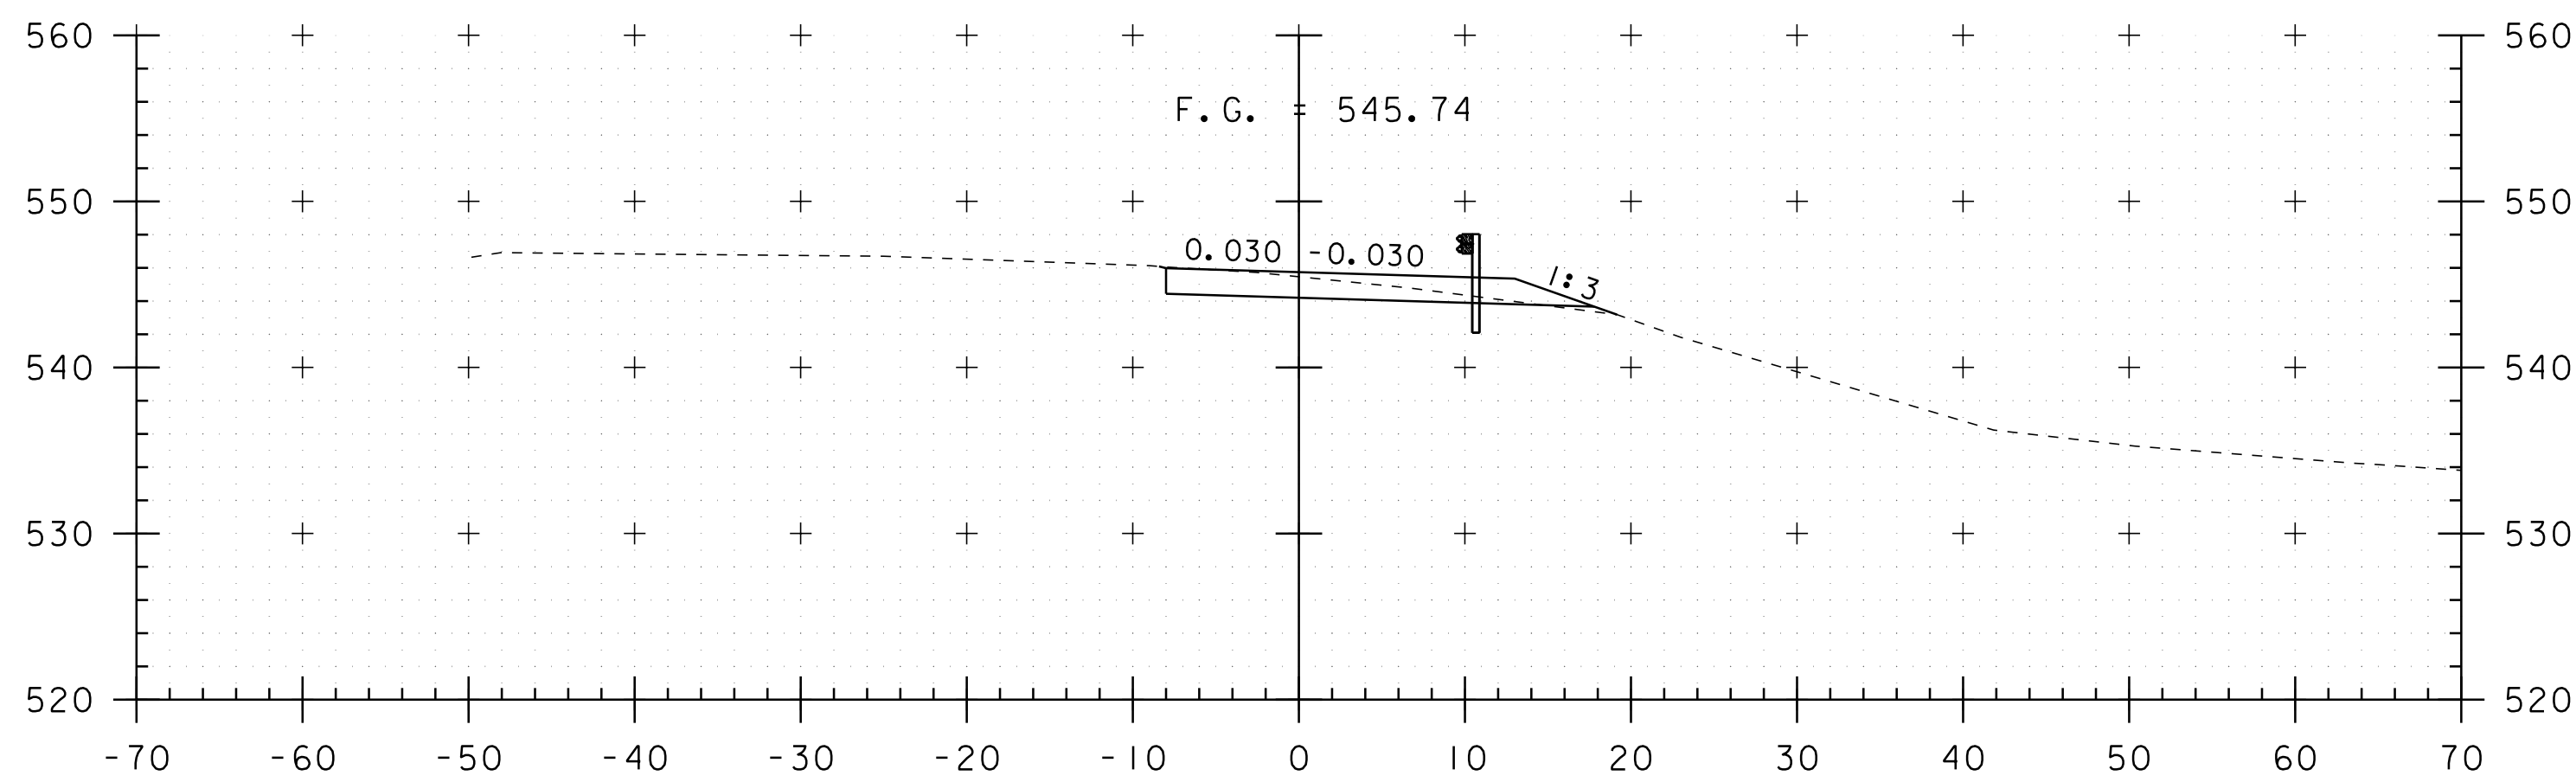

4310+00

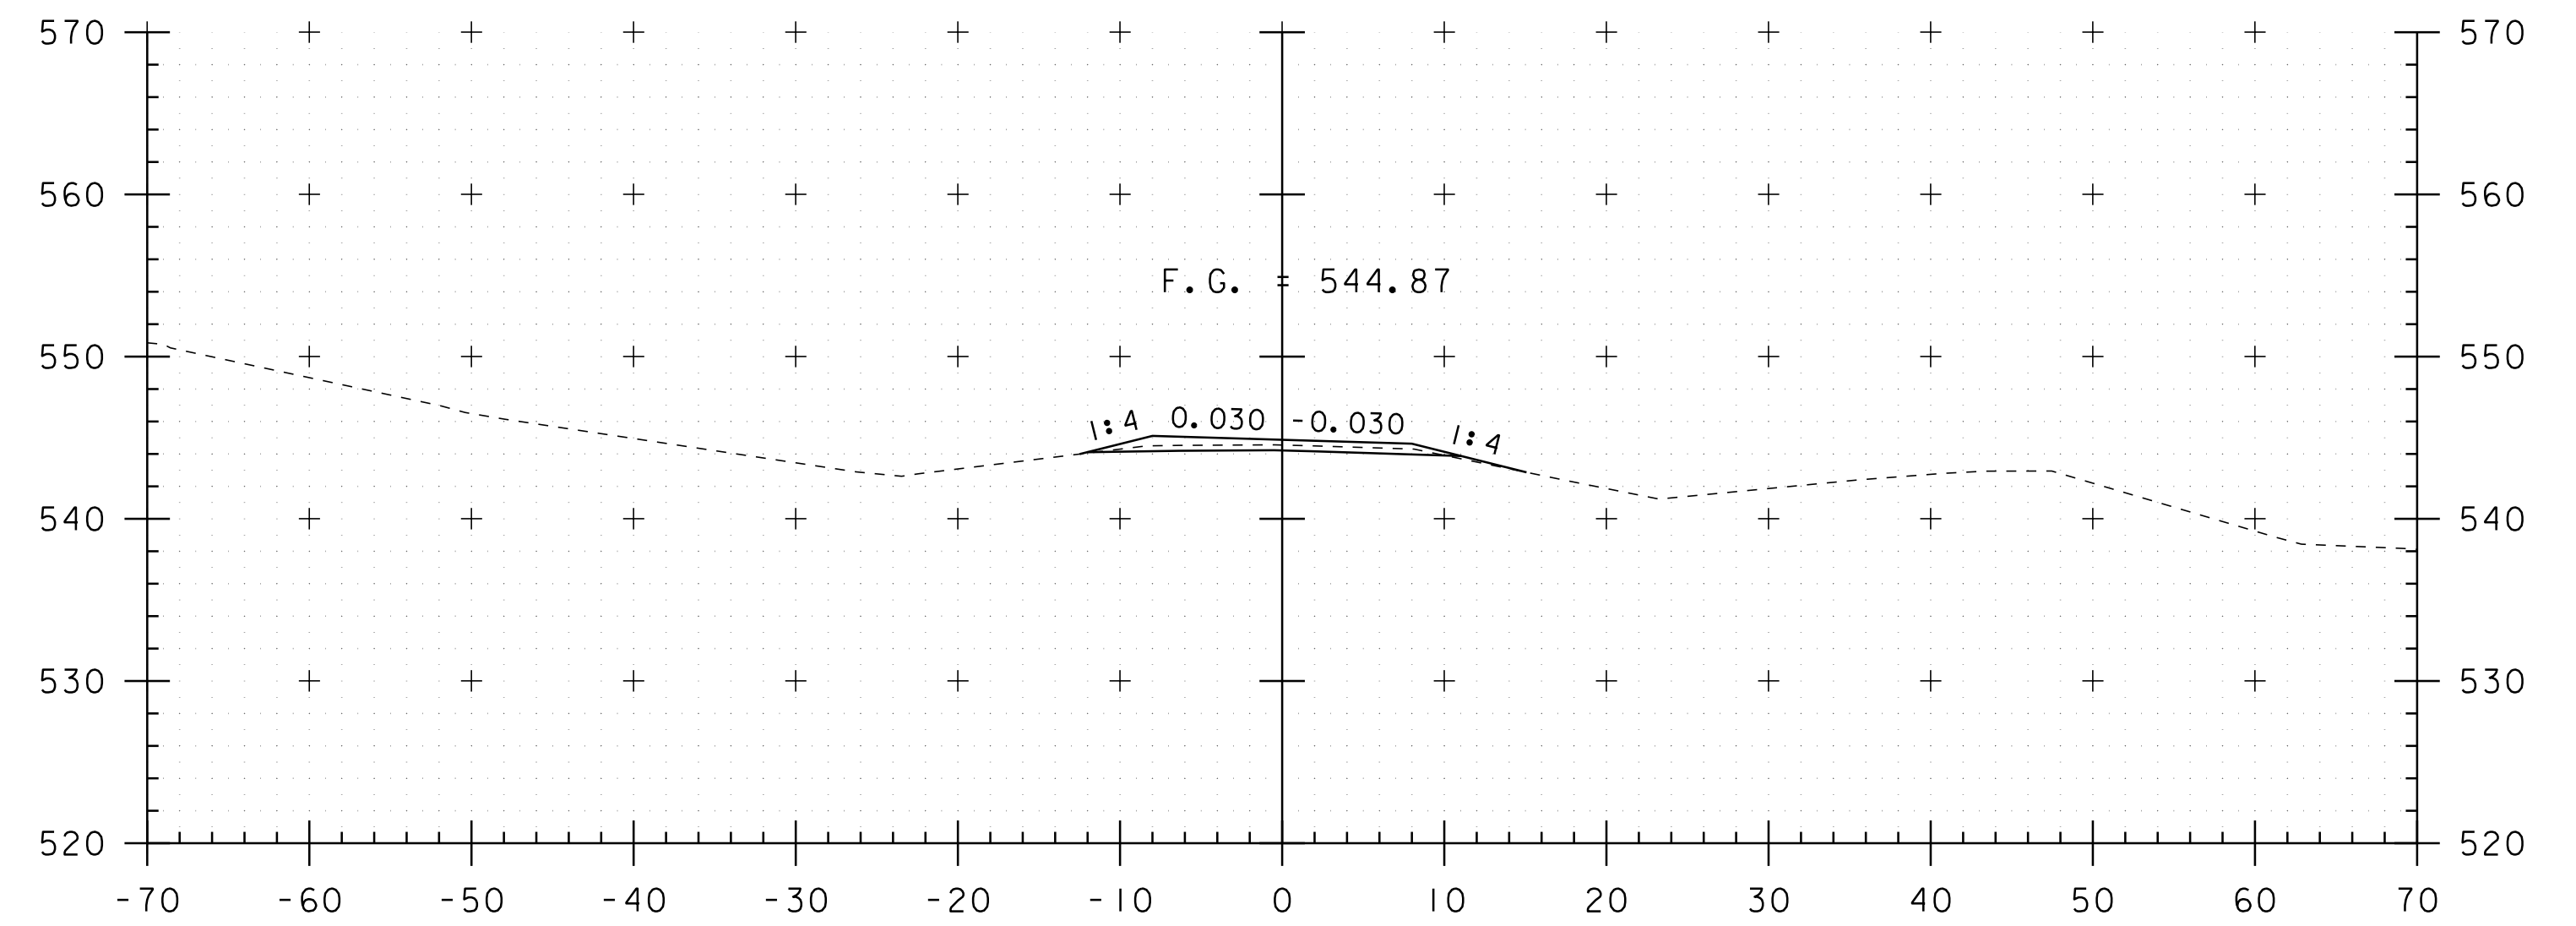

4312+00

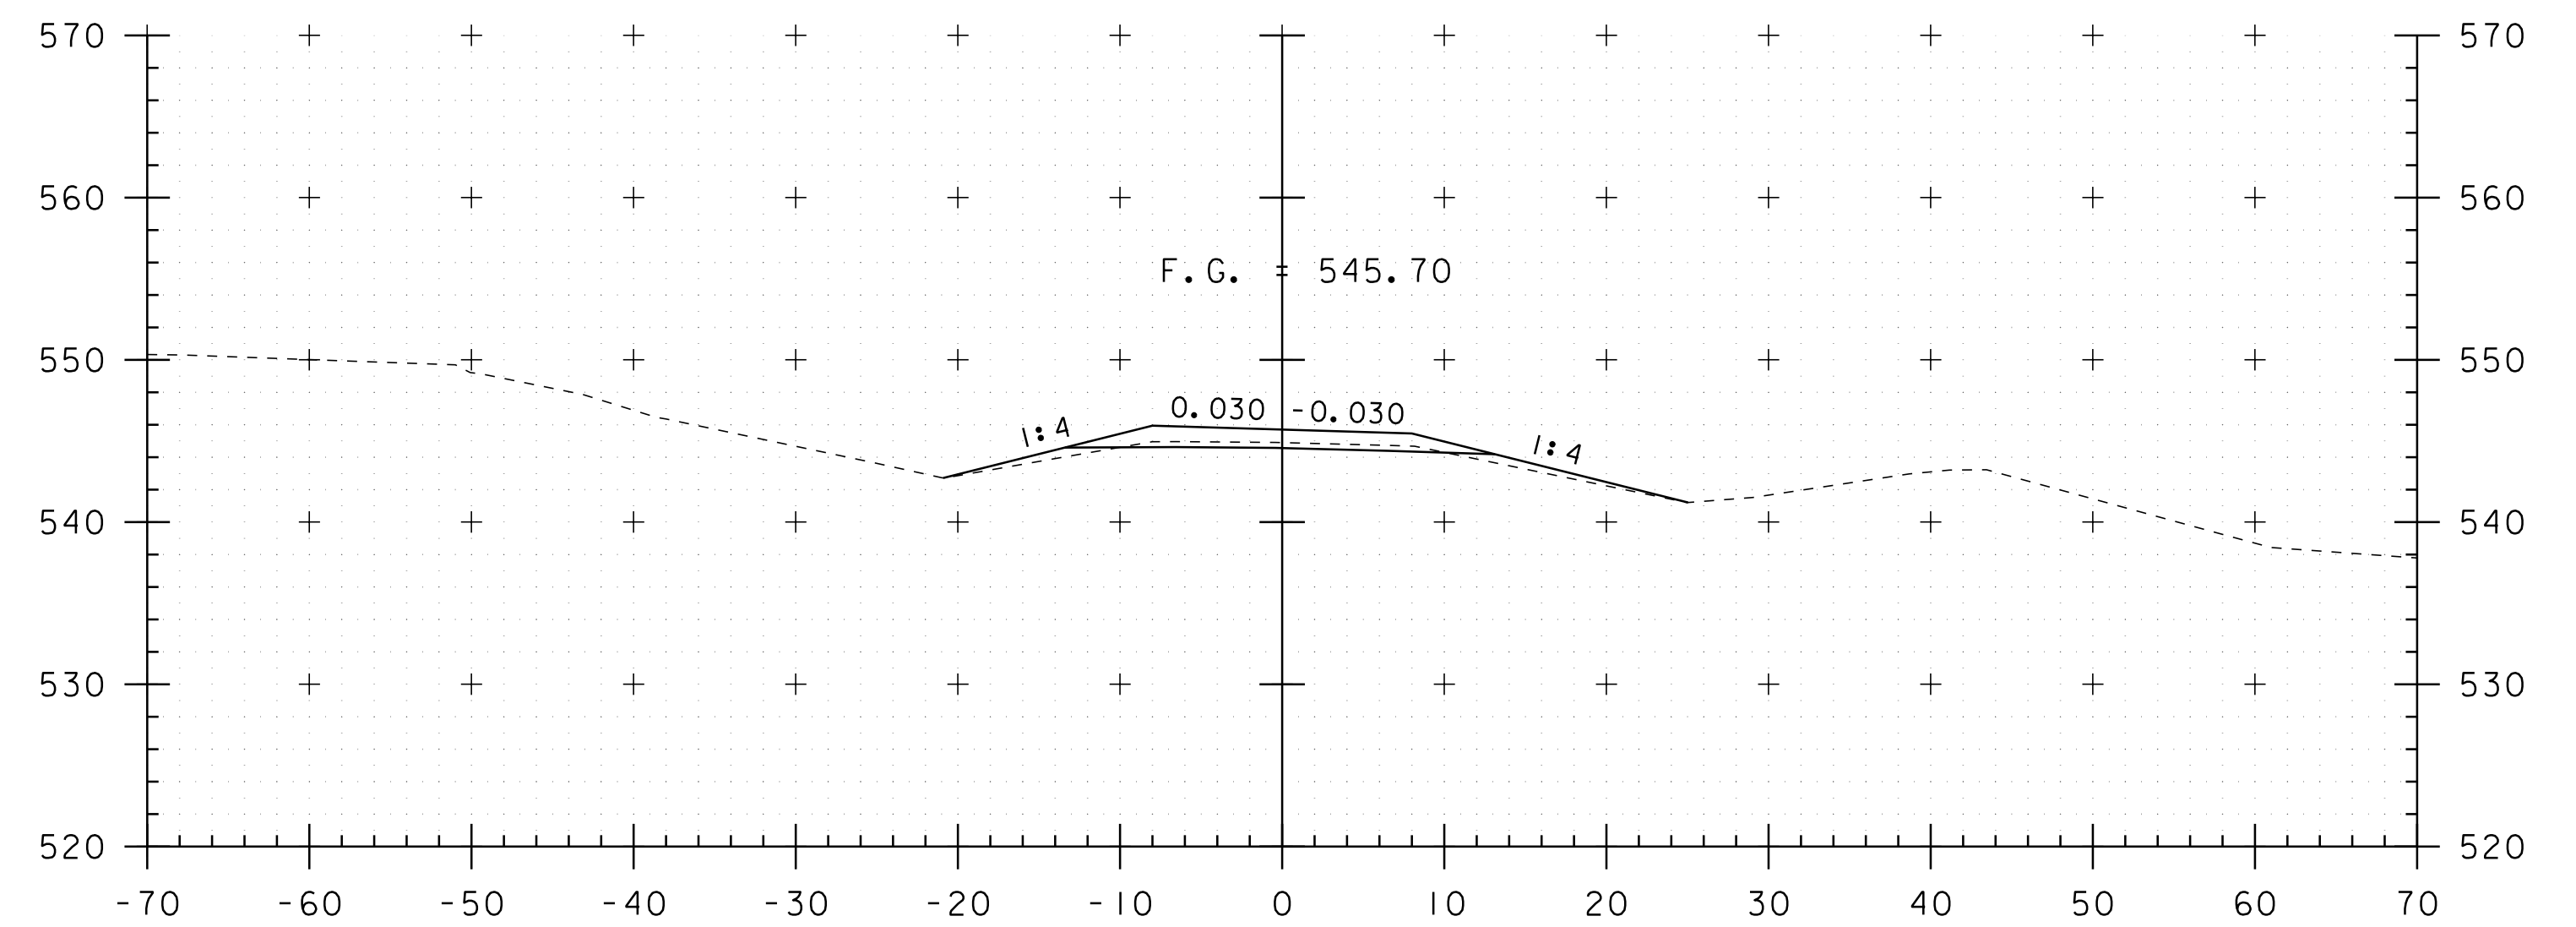

4311+50

CROSSOVER AT MM 81.58

PROJECT NAME: RICHMOND-SOUTH BURLINGTON  
PROJECT NUMBER: IM 089-2(39)

FILE NAME: p05a012.dgn  
PROJECT LEADER: CRB  
DESIGNED BY: JJB  
CLD 07-0313

PLOT DATE: 02-OCT-2012 16:5  
DRAWN BY: JJB/MRS  
CHECKED BY: DH  
SHEET 89 OF 91



STA. 4310+00 TO STA. 4312+00