




4313+50

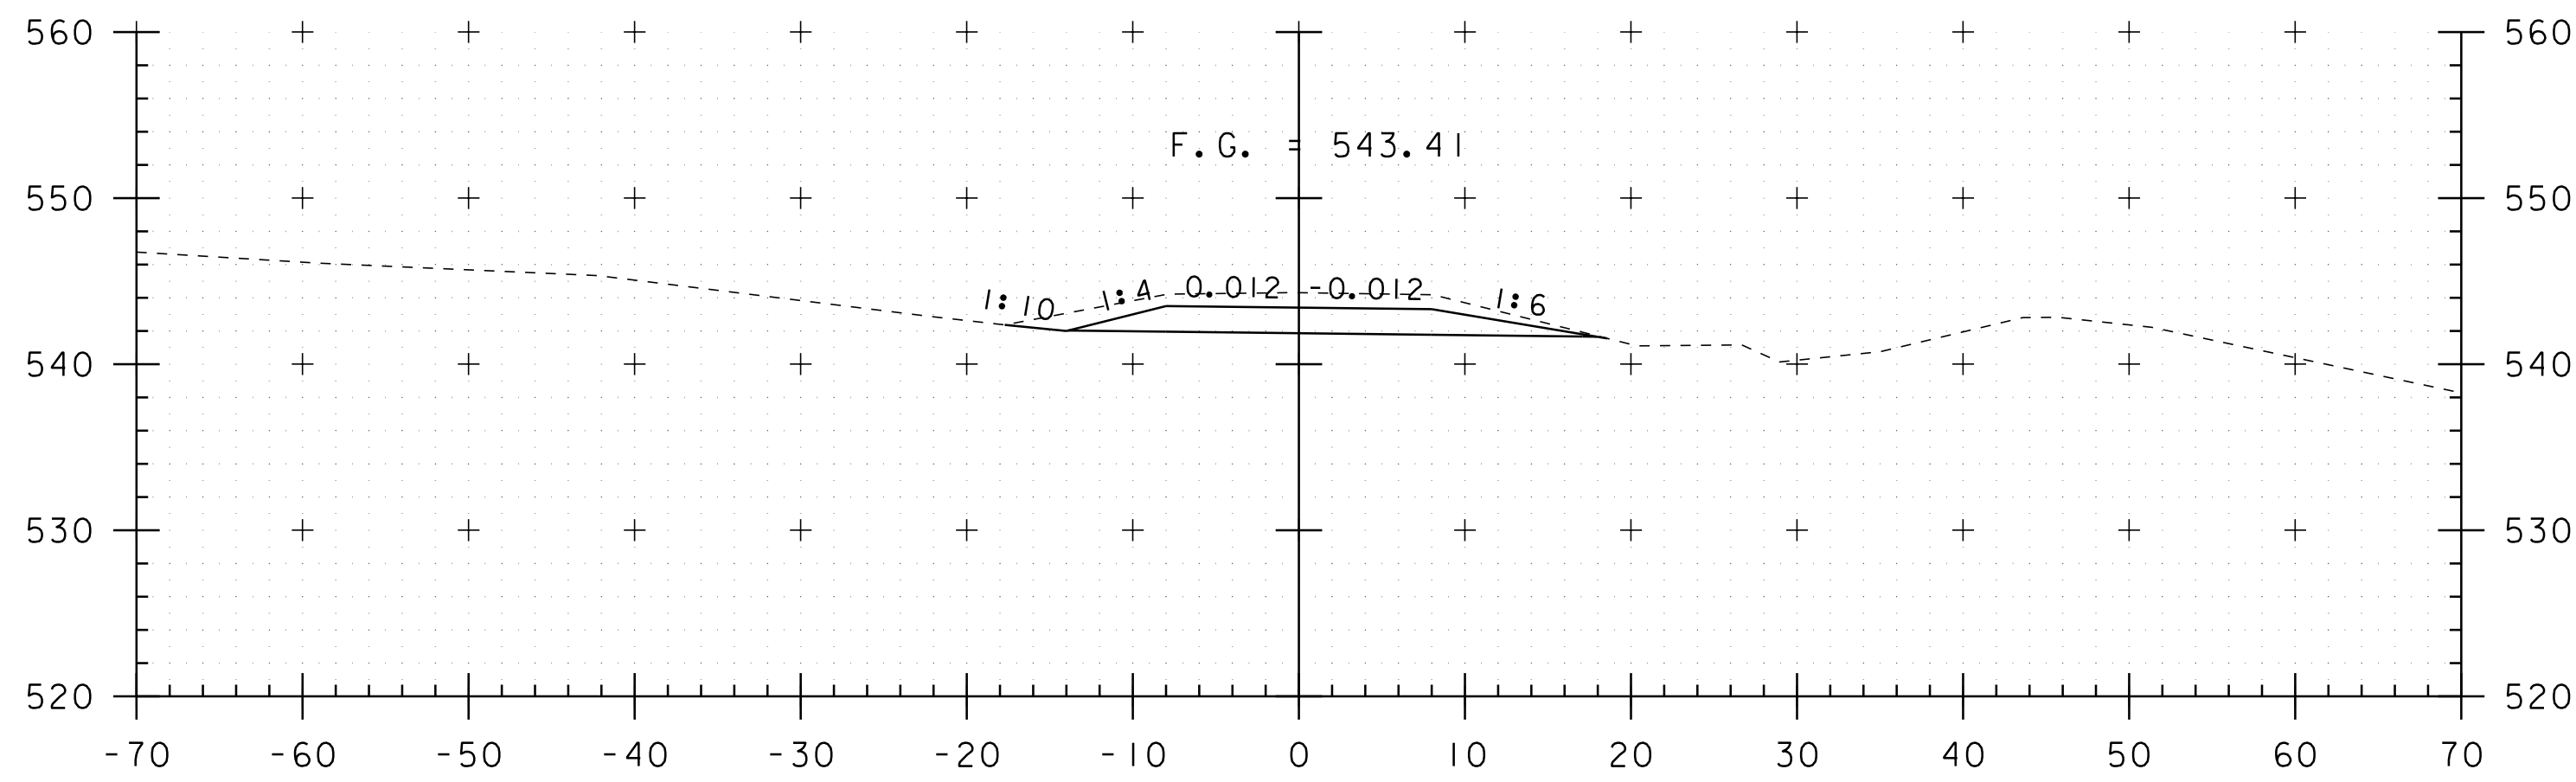


4313+00

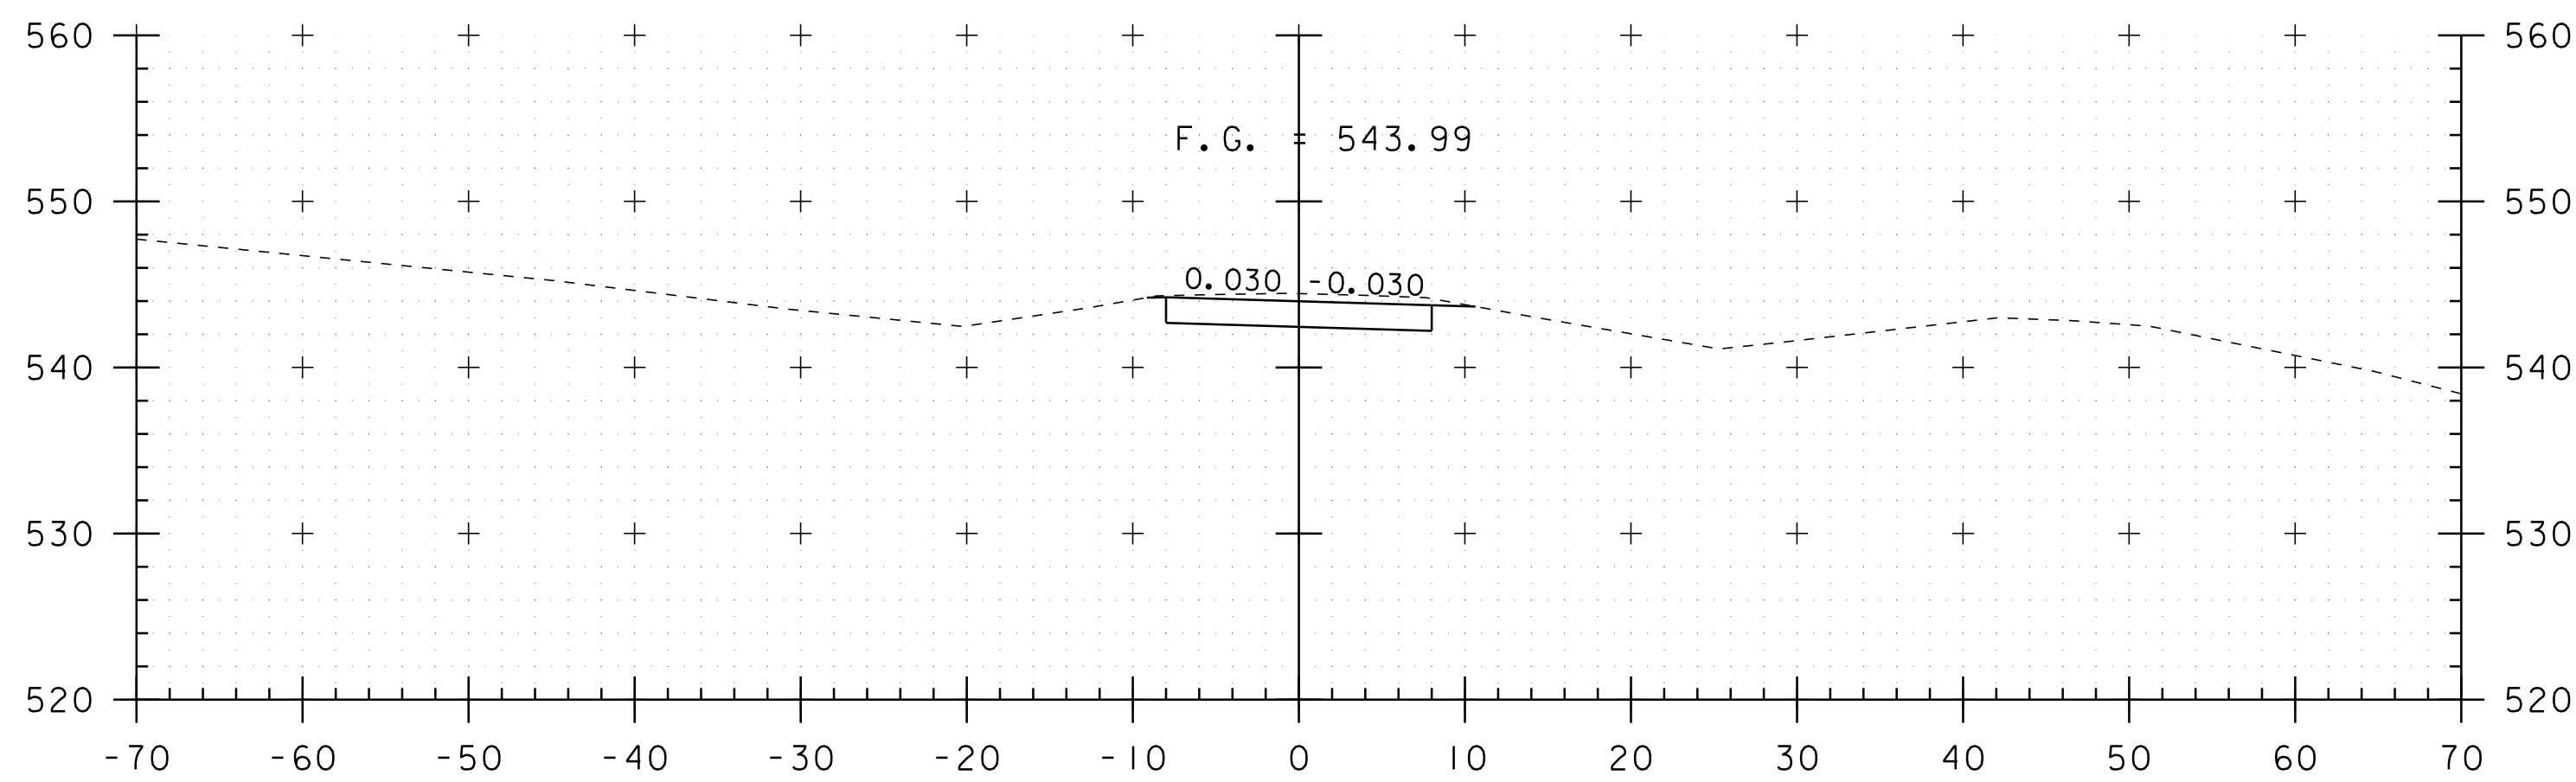


4312+50

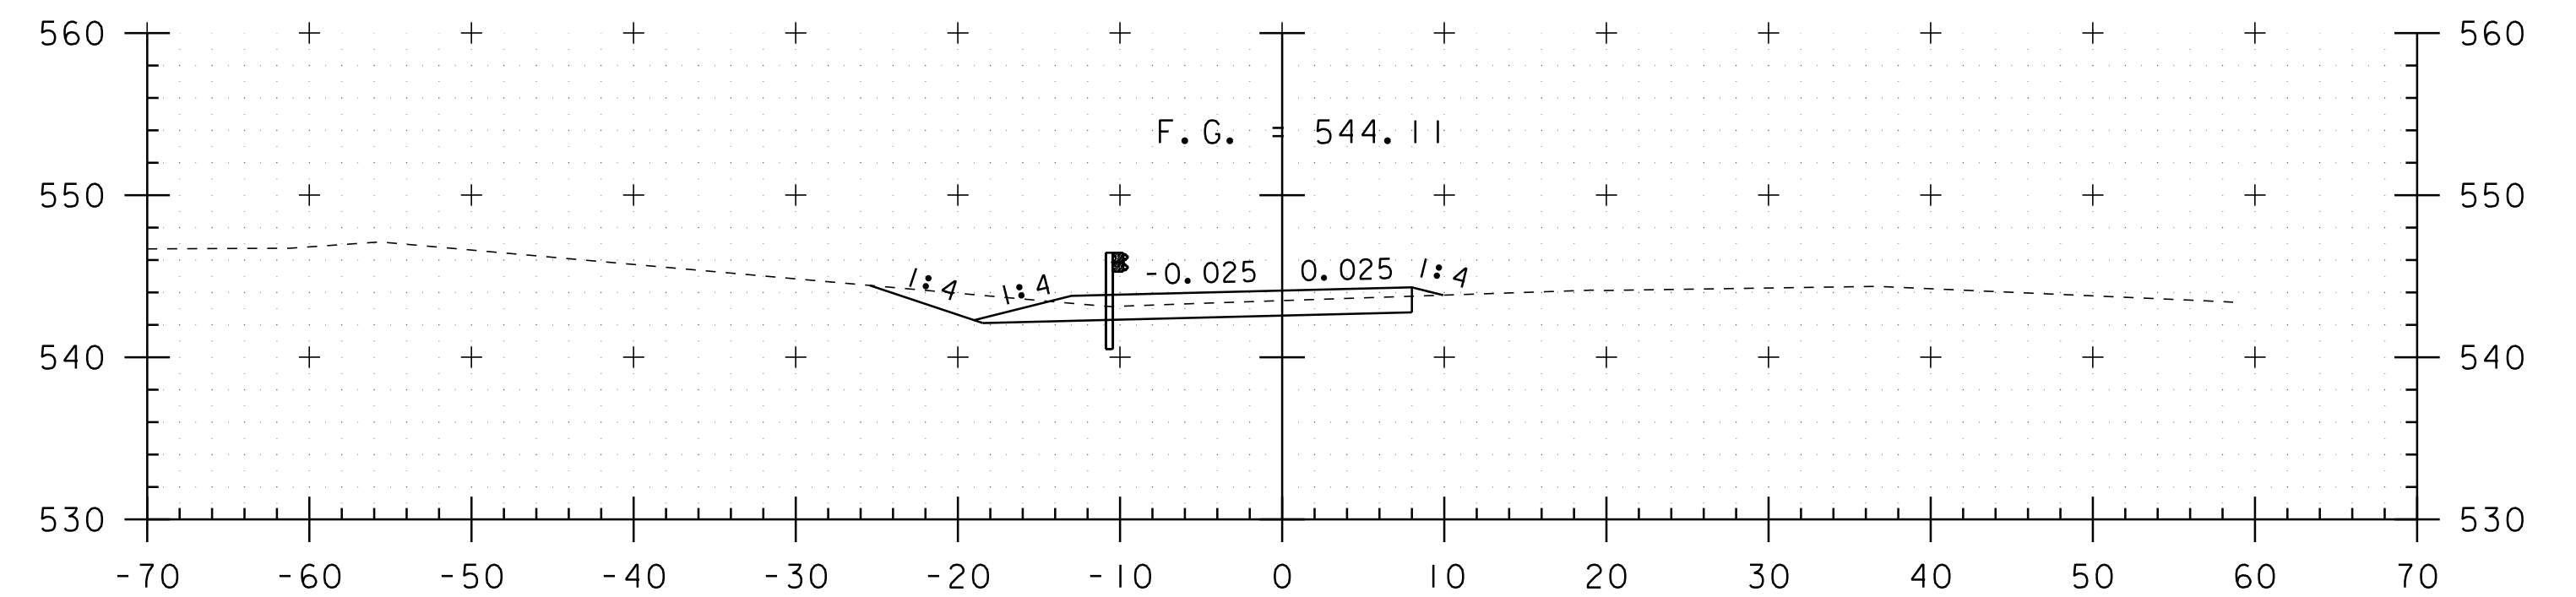

4315+00

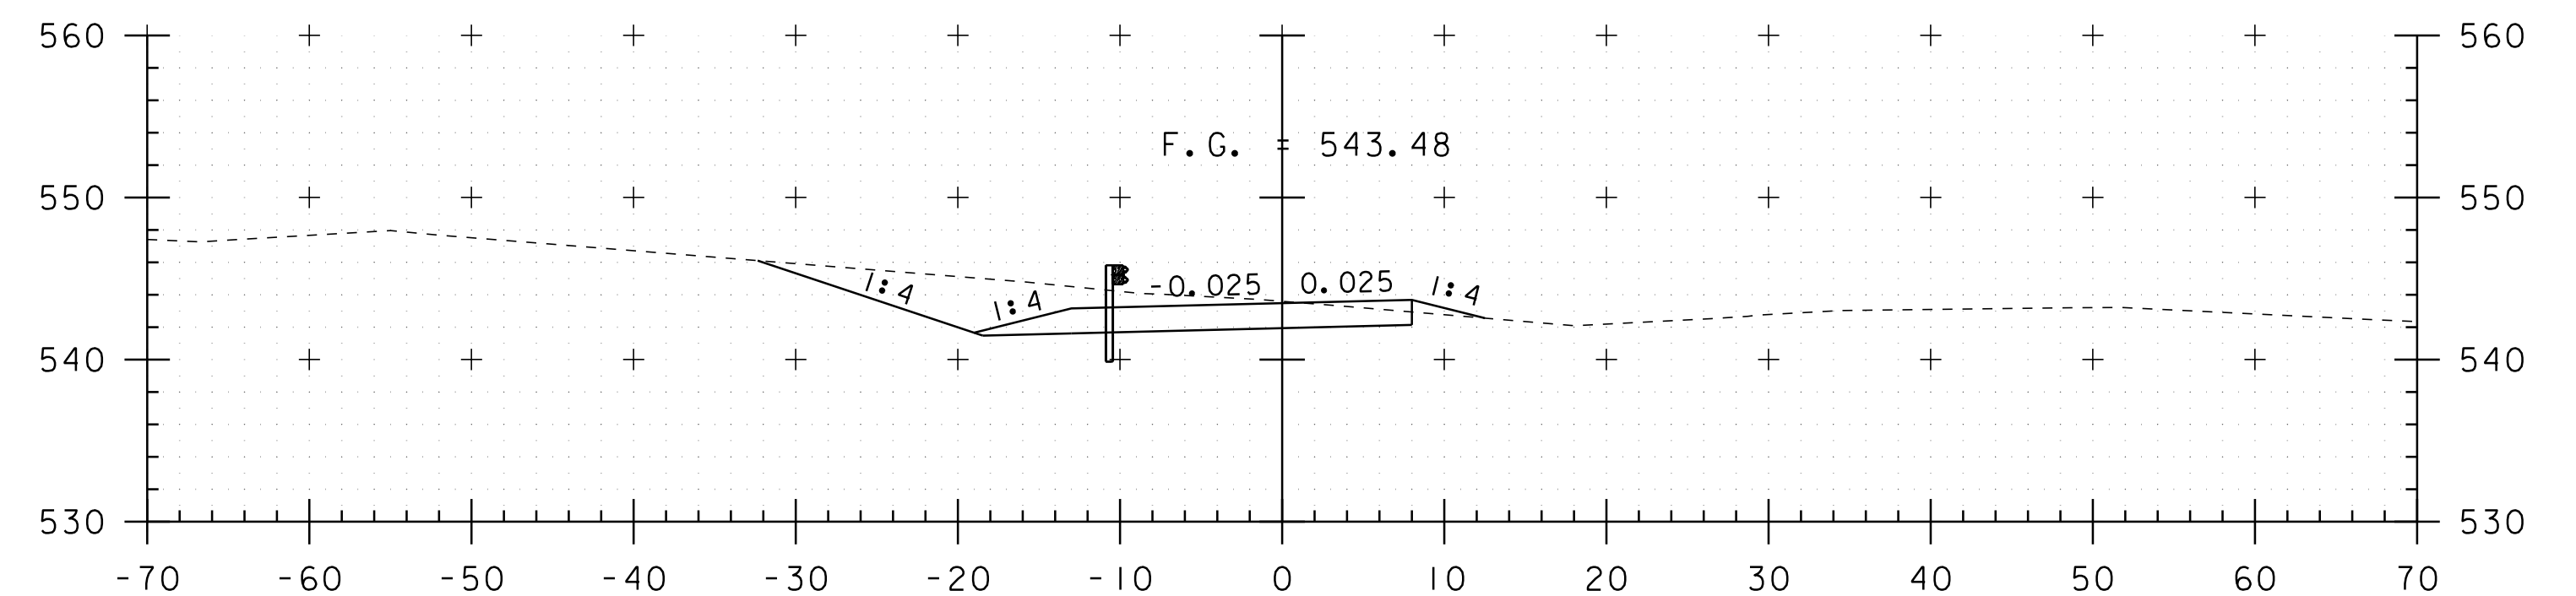

4314+50

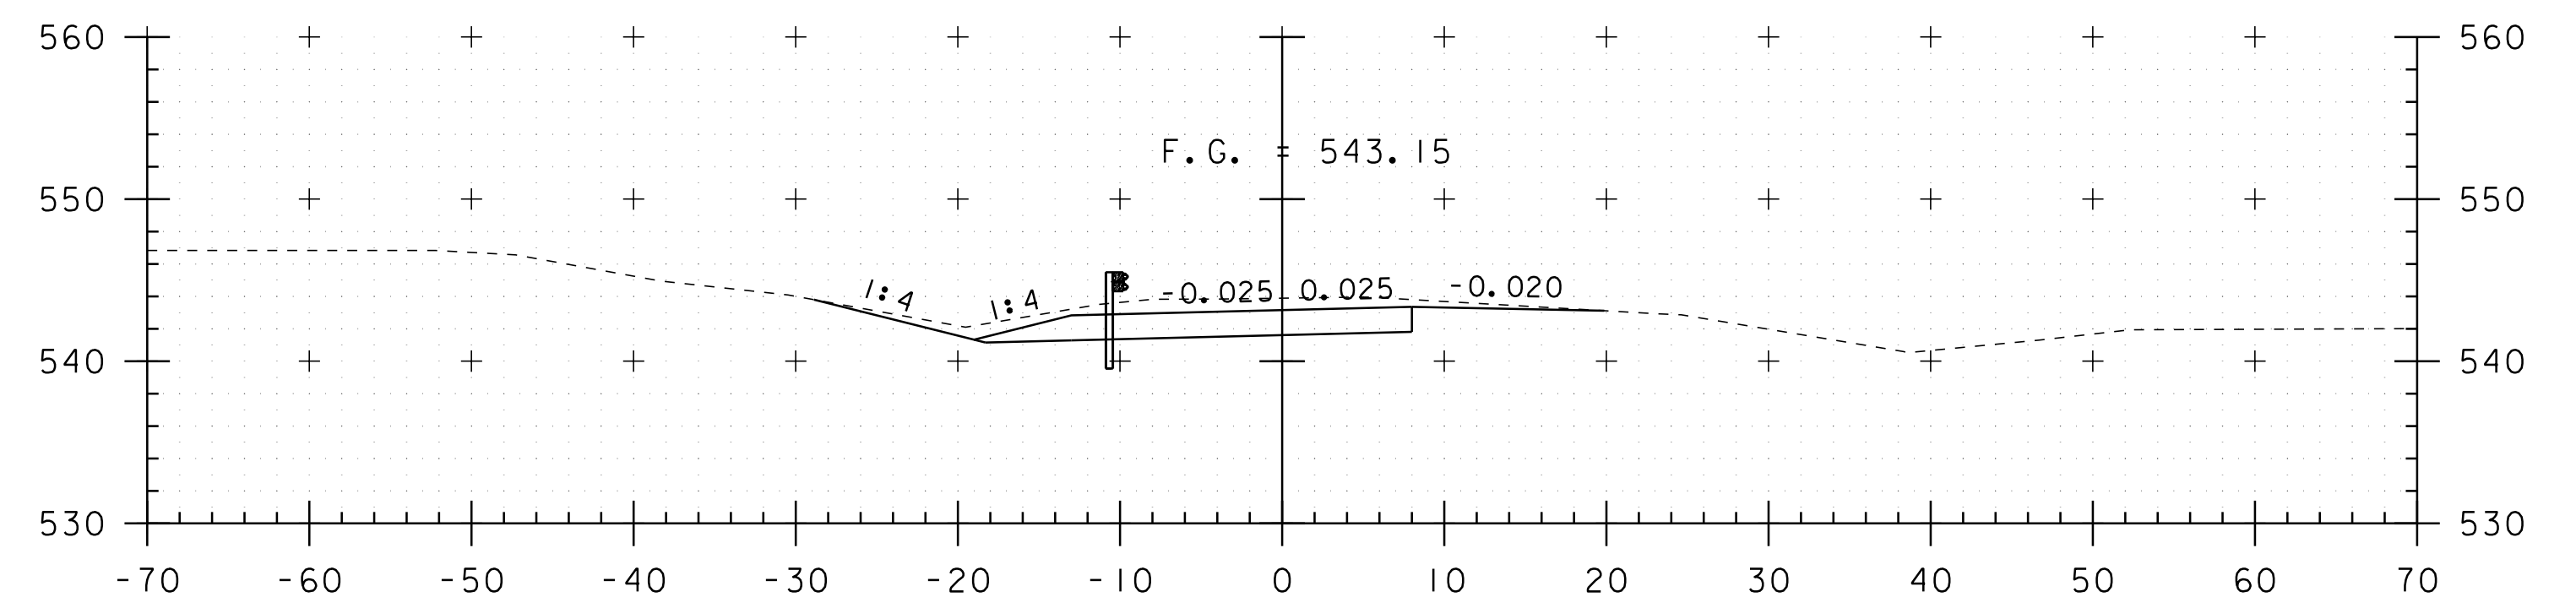

4314+00

CROSSOVER AT MM 81.58

PROJECT NAME: RICHMOND-SOUTH BURLINGTON
PROJECT NUMBER: IM 089-2(39)

FILE NAME: p05a012.dgn
PROJECT LEADER: CRB
DESIGNED BY: JJB
CLD 07-0313

PLOT DATE: 02-OCT-2012 16:5
DRAWN BY: JJB/MRS
CHECKED BY: DH
SHEET 90 OF 91



STA. 4312+50 TO STA. 4315+00