


CONCRETE MEDIAN BARRIER (MOD - CAST IN PLACE)
983+00 - 989+00 CL

REMOVAL AND DISPOSAL OF GUARDRAIL (MOD - CONCRETE MEDIAN BARRIER)
983+00 - 989+00 CL

REMOVE EXISTING DROP INLET
986+01 LT

LANDSCAPING BED
984+00 - 989+00 RT

RELAYING PIPE CULVERTS (MOD. - LINING CULVERT, 18")
986+01 RT

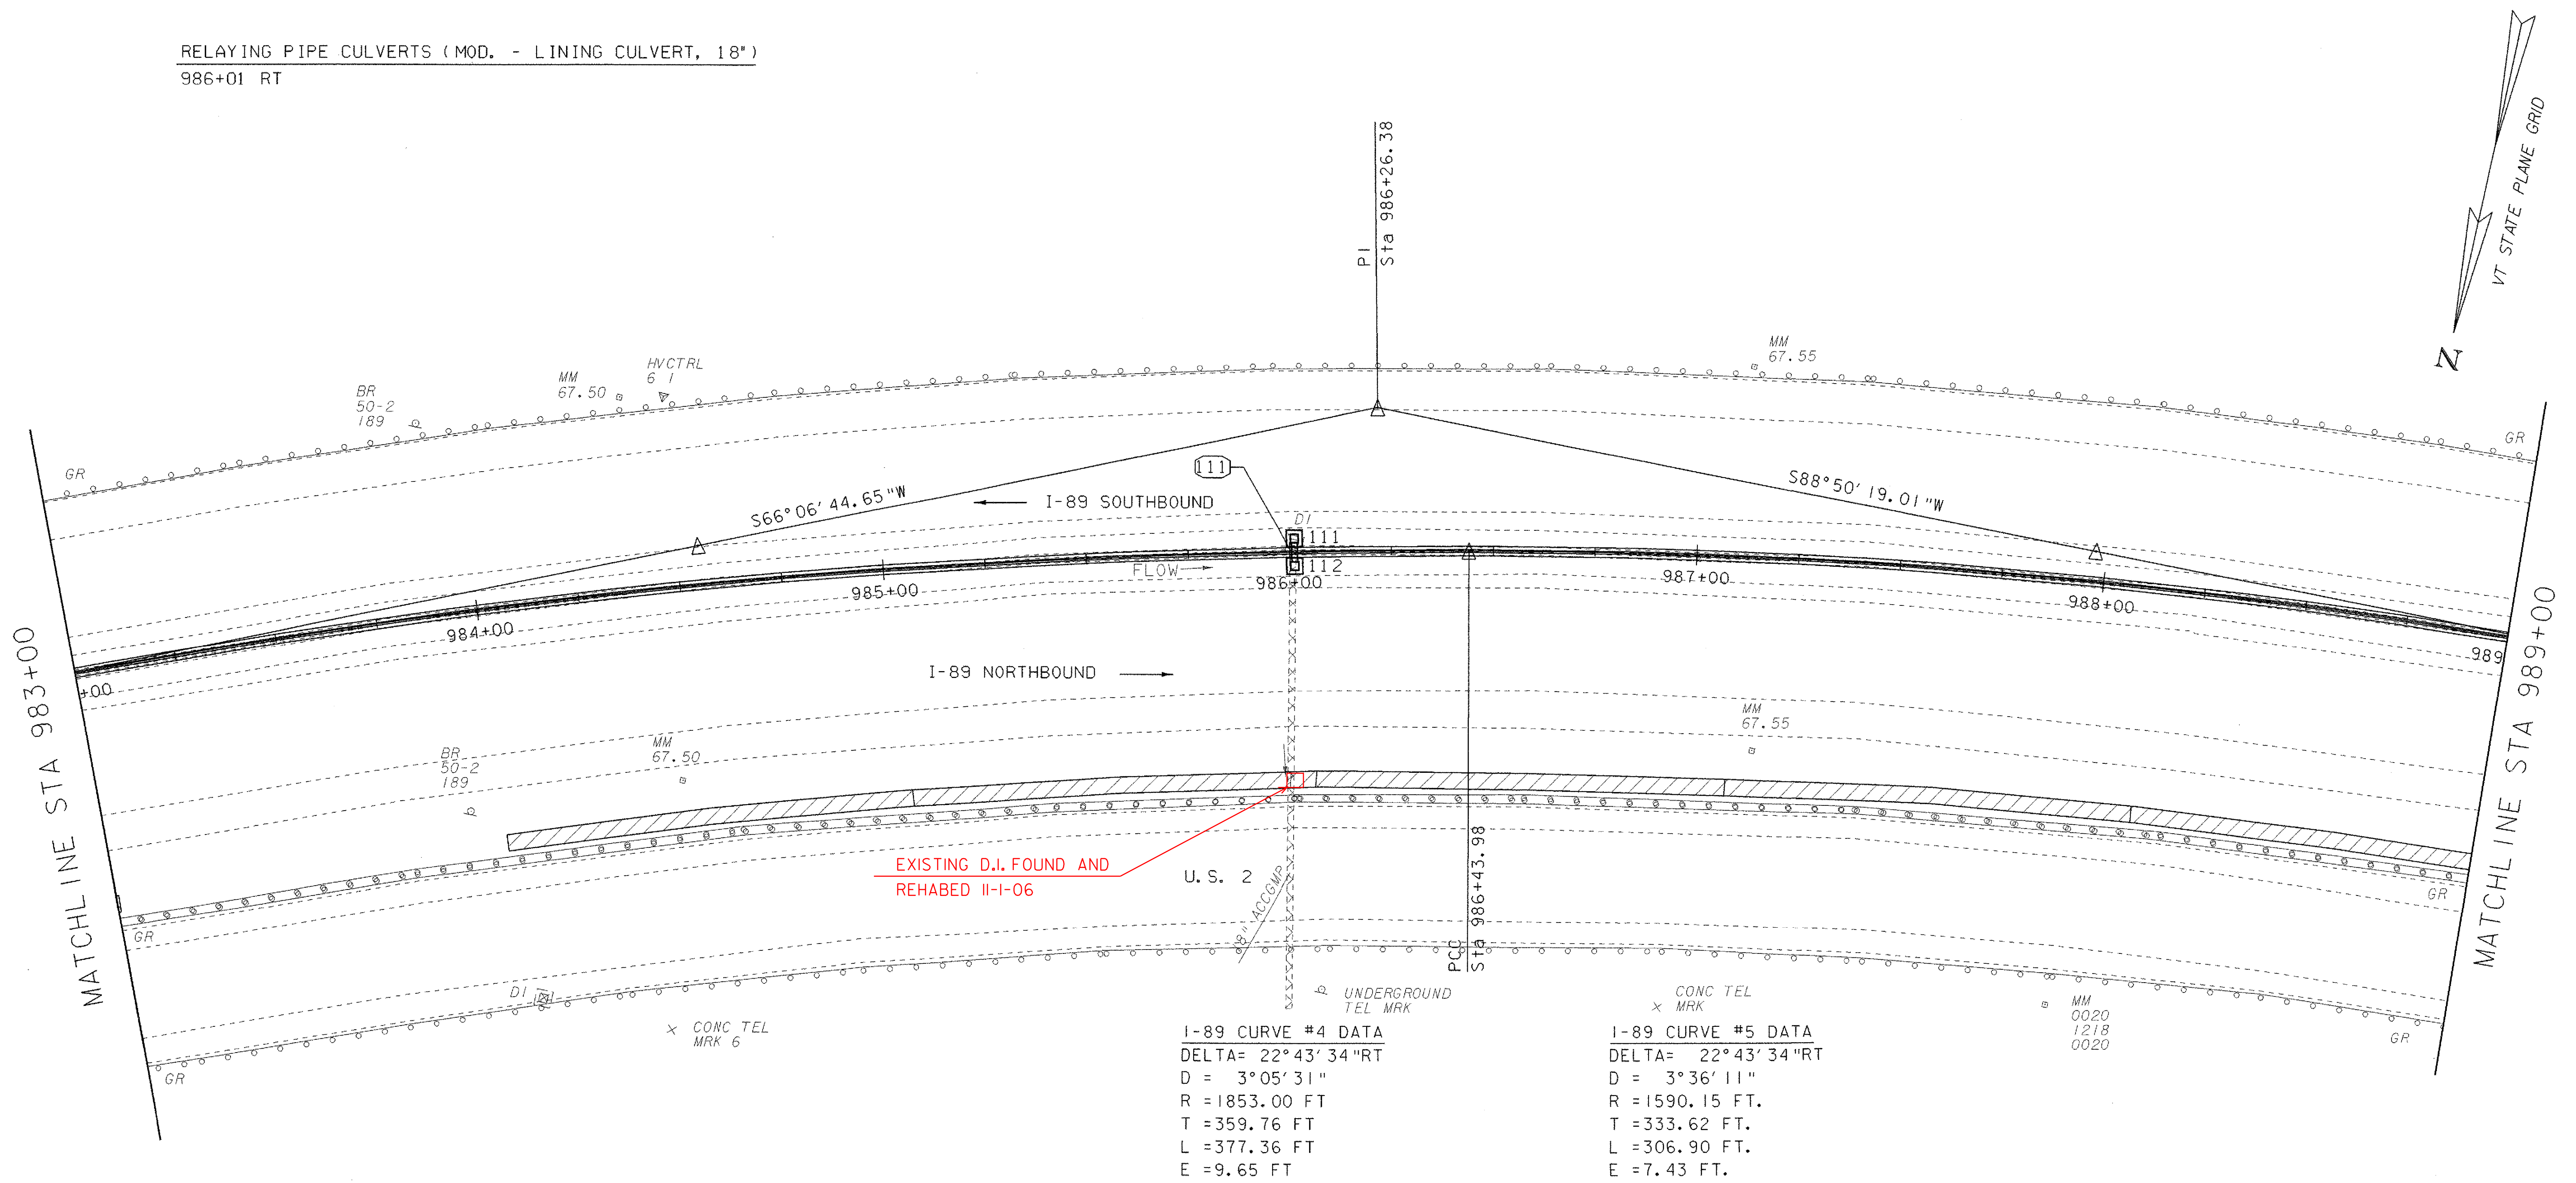

STRUCTURE NO.	CONSTRUCTION & STATION	COMMENTS (SEE NOTE 3)
111	986+01 LT.	DROP INLET, TYPE 'B' GRATE, RIM 439.82
112	986+01 RT.	DROP INLET, TYPE 'B' GRATE, RIM 439.83, CONNECT TO EXIST. 18" ACC WITH 18" PCCSP STUB CONNECT TO EXIST. 6" UNDERDRAIN


(11) CONST. @ 986+01 LT. TO 986+01 RT.
NEW 18" X 5' CPEP CONNECTING TO
NEW DI'S AT 986+01 LT, RT.

NOTES

- ALL EXISTING STORM DRAINAGE PIPES AND STRUCTURES ARE SHOWN BASED ON PREVIOUS DESIGN PLANS. NO AS-BUILT INFORMATION WAS AVAILABLE, AND NO SURVEY WAS POSSIBLE DUE TO THEIR LOCATIONS UNDER THE EXISTING CONCRETE MEDIAN BARRIER.
- FOR DETAILS OF LANDSCAPING BEDS, PLANT LISTS AND PLANTING DETAILS, SEE LANDSCAPING DETAIL SHEETS. BEDS ARE DESIGNED AS A 100' TYPICAL PATTERN WHICH WILL BE REPEATED FOR LONGER BEDS.
- TYPE OF STUB REQUIRED TO CONNECT TO EXISTING STORM DRAIN PIPE IS ASSUMED FOR ALL LOCATIONS. THERE MAY BE LOCATIONS WHERE A STUB IS NOT REQUIRED, STUBS WILL BE USED AS DIRECTED BY THE ENGINEER.
- FOR DETAILS OF UNDERDRAIN CONNECTION AND CLEAN OUT SEE MISC. DRAINAGE DETAILS 2.

LEGEND

CULVERT LINING	
LANDSCAPING BED	
CONCRETE MEDIAN BARRIER	
DROP INLET	
CATCH BASIN	

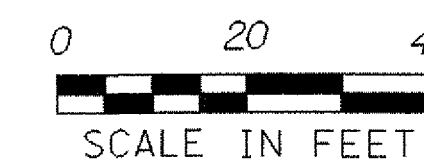

STA 983+00 - STA 989+00

PROJECT NAME: WATERBURY - BOLTON	PLOT DATE: 29-MAR-2006
PROJECT NUMBER: IM 089 - 2(37)	DRAWN BY: J. L. SCHULTZ
FILE NAME: d05a110bdr.dgn	CHECKED BY:
PROJECT LEADER: A.J. BOMBARDIER	SHEET 19 OF 80
DESIGNED BY: J. L. SCHULTZ	
LAYOUT SHEET 6	