


STATE OF VERMONT AGENCY OF TRANSPORTATION



PROPOSED IMPROVEMENT BRIDGE PROJECT TOWN OF RICHMOND COUNTY OF CHITTENDEN ROUTE NO.: INTERSTATE 89, BRIDGE 56 N&S

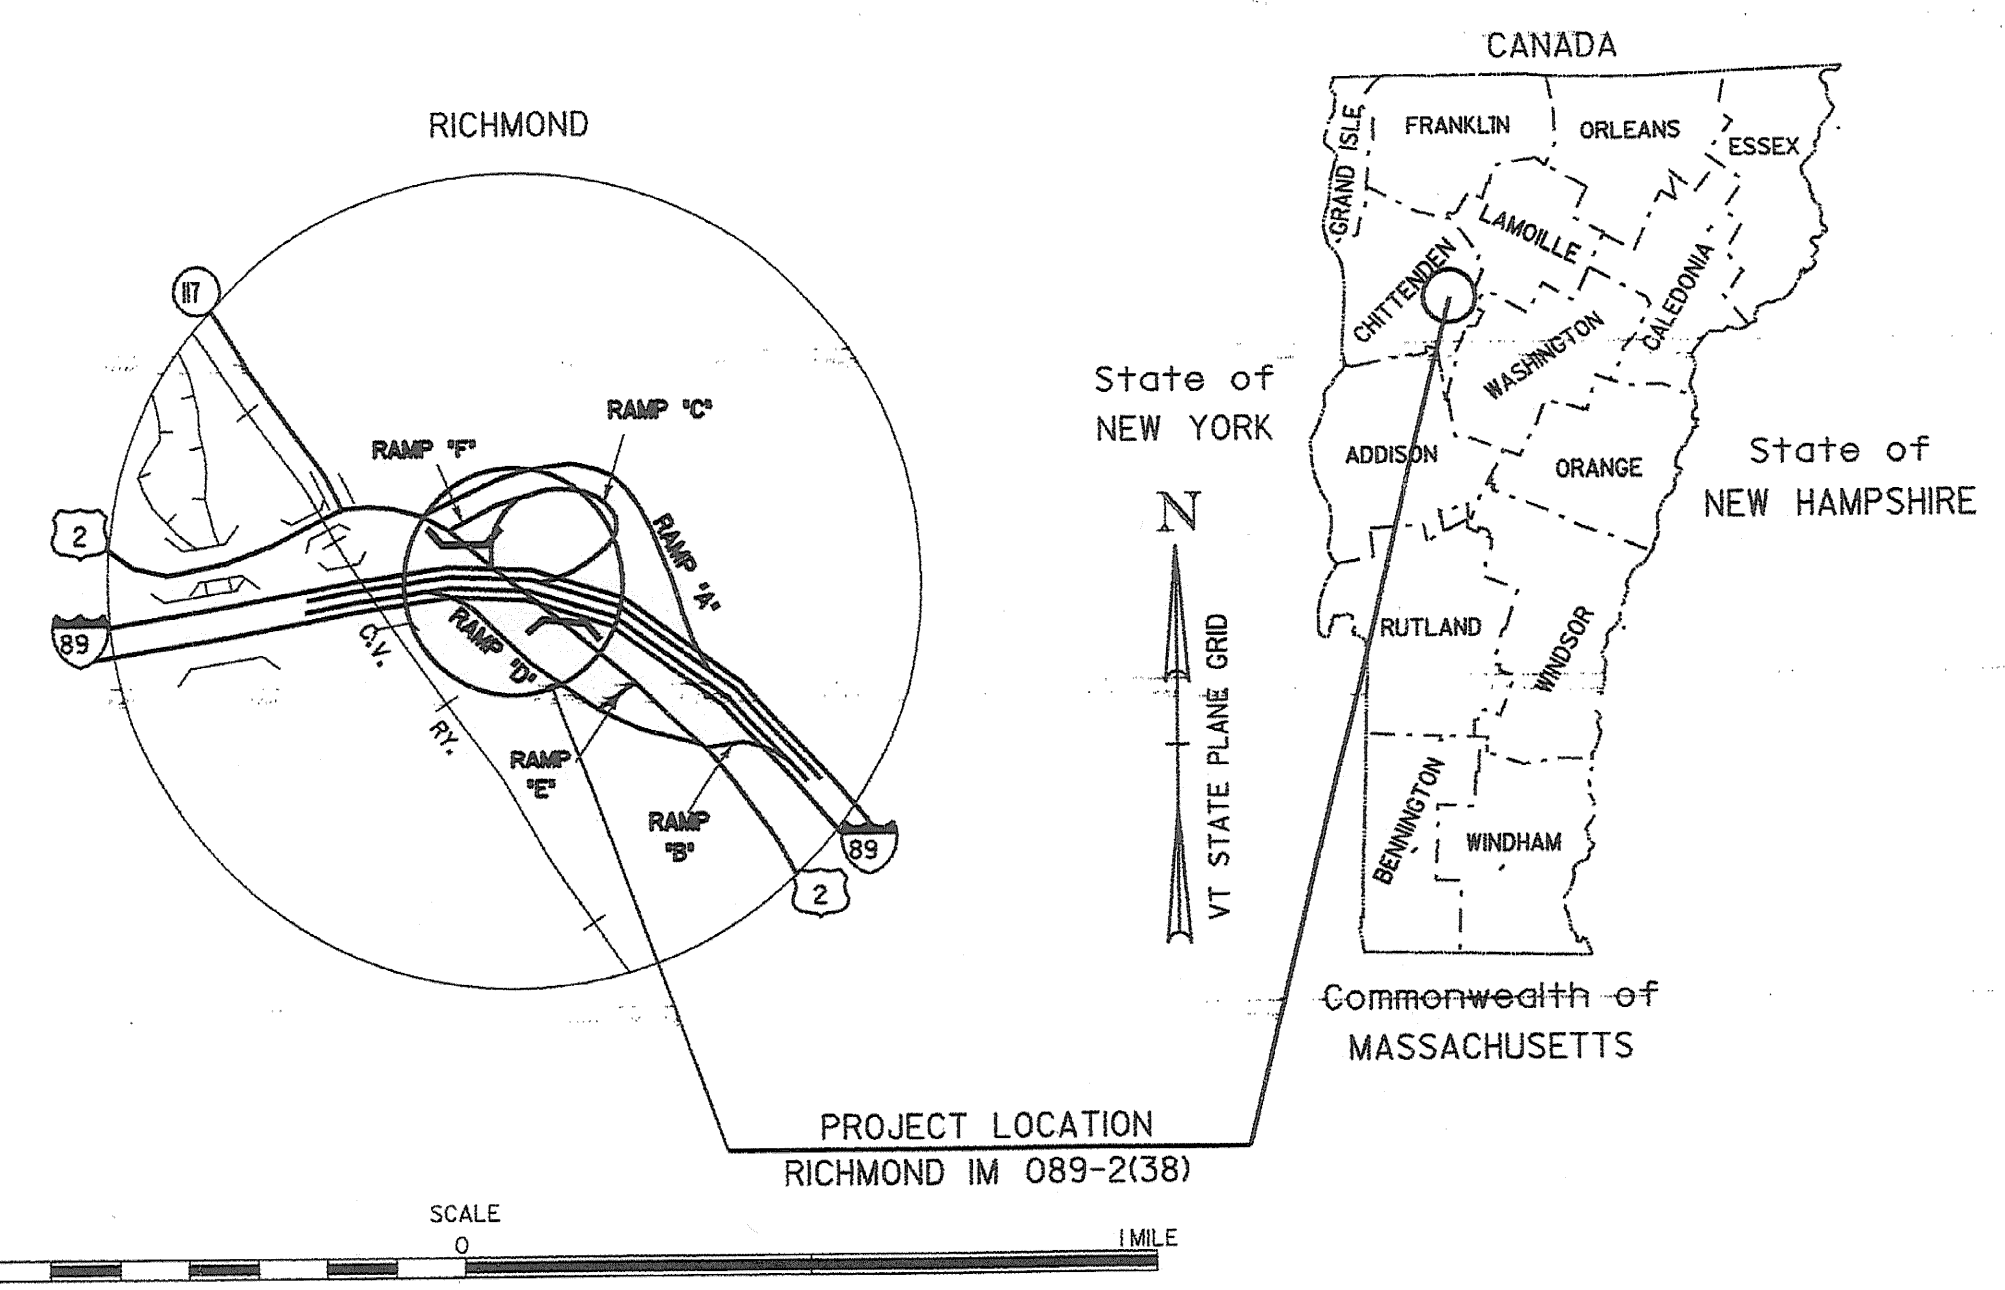


PROJECT LOCATION: BEGINNING AT STA 1555+00 ON I89 IN RICHMOND AND CONTINUING ALONG I89 FOR 600 FEET.

PROJECT DESCRIPTION: REHABILITATION OF BRIDGES 56N & 56S TO INCLUDE PIER REPLACEMENTS.

LENGTH OF STRUCTURE = 227.00 FEET
 LENGTH OF ROADWAY = 373.00 FEET
 LENGTH OF PROJECT = 600.00 FEET

RECORD PLANS	
CONTRACTOR:	FW WHITCOMB CONSTRUCTION CORP. - WALPOLE, NH
RESIDENT ENGINEER:	RICK HALE
CONSTRUCTION BEGAN:	JUNE 28, 2006
CONSTRUCTION COMPLETE:	NOVEMBER 27, 2007
RECORD PLANS BY:	RICK HALE & C. PIERCE
I HEREBY CERTIFY THAT ALL THE CONSTRUCTION REQUIRED BY THIS SET OF DRAWINGS HAS BEEN ACCOMPLISHED AS INDICATED HEREIN.	
BY:	<i>Rick Hale</i> RESIDENT ENGINEER
DATE:	2/12/10
NOTE: Any further information concerning final quantities, amounts or other details relative to this project may be found at Central Files in the electronic archives.	

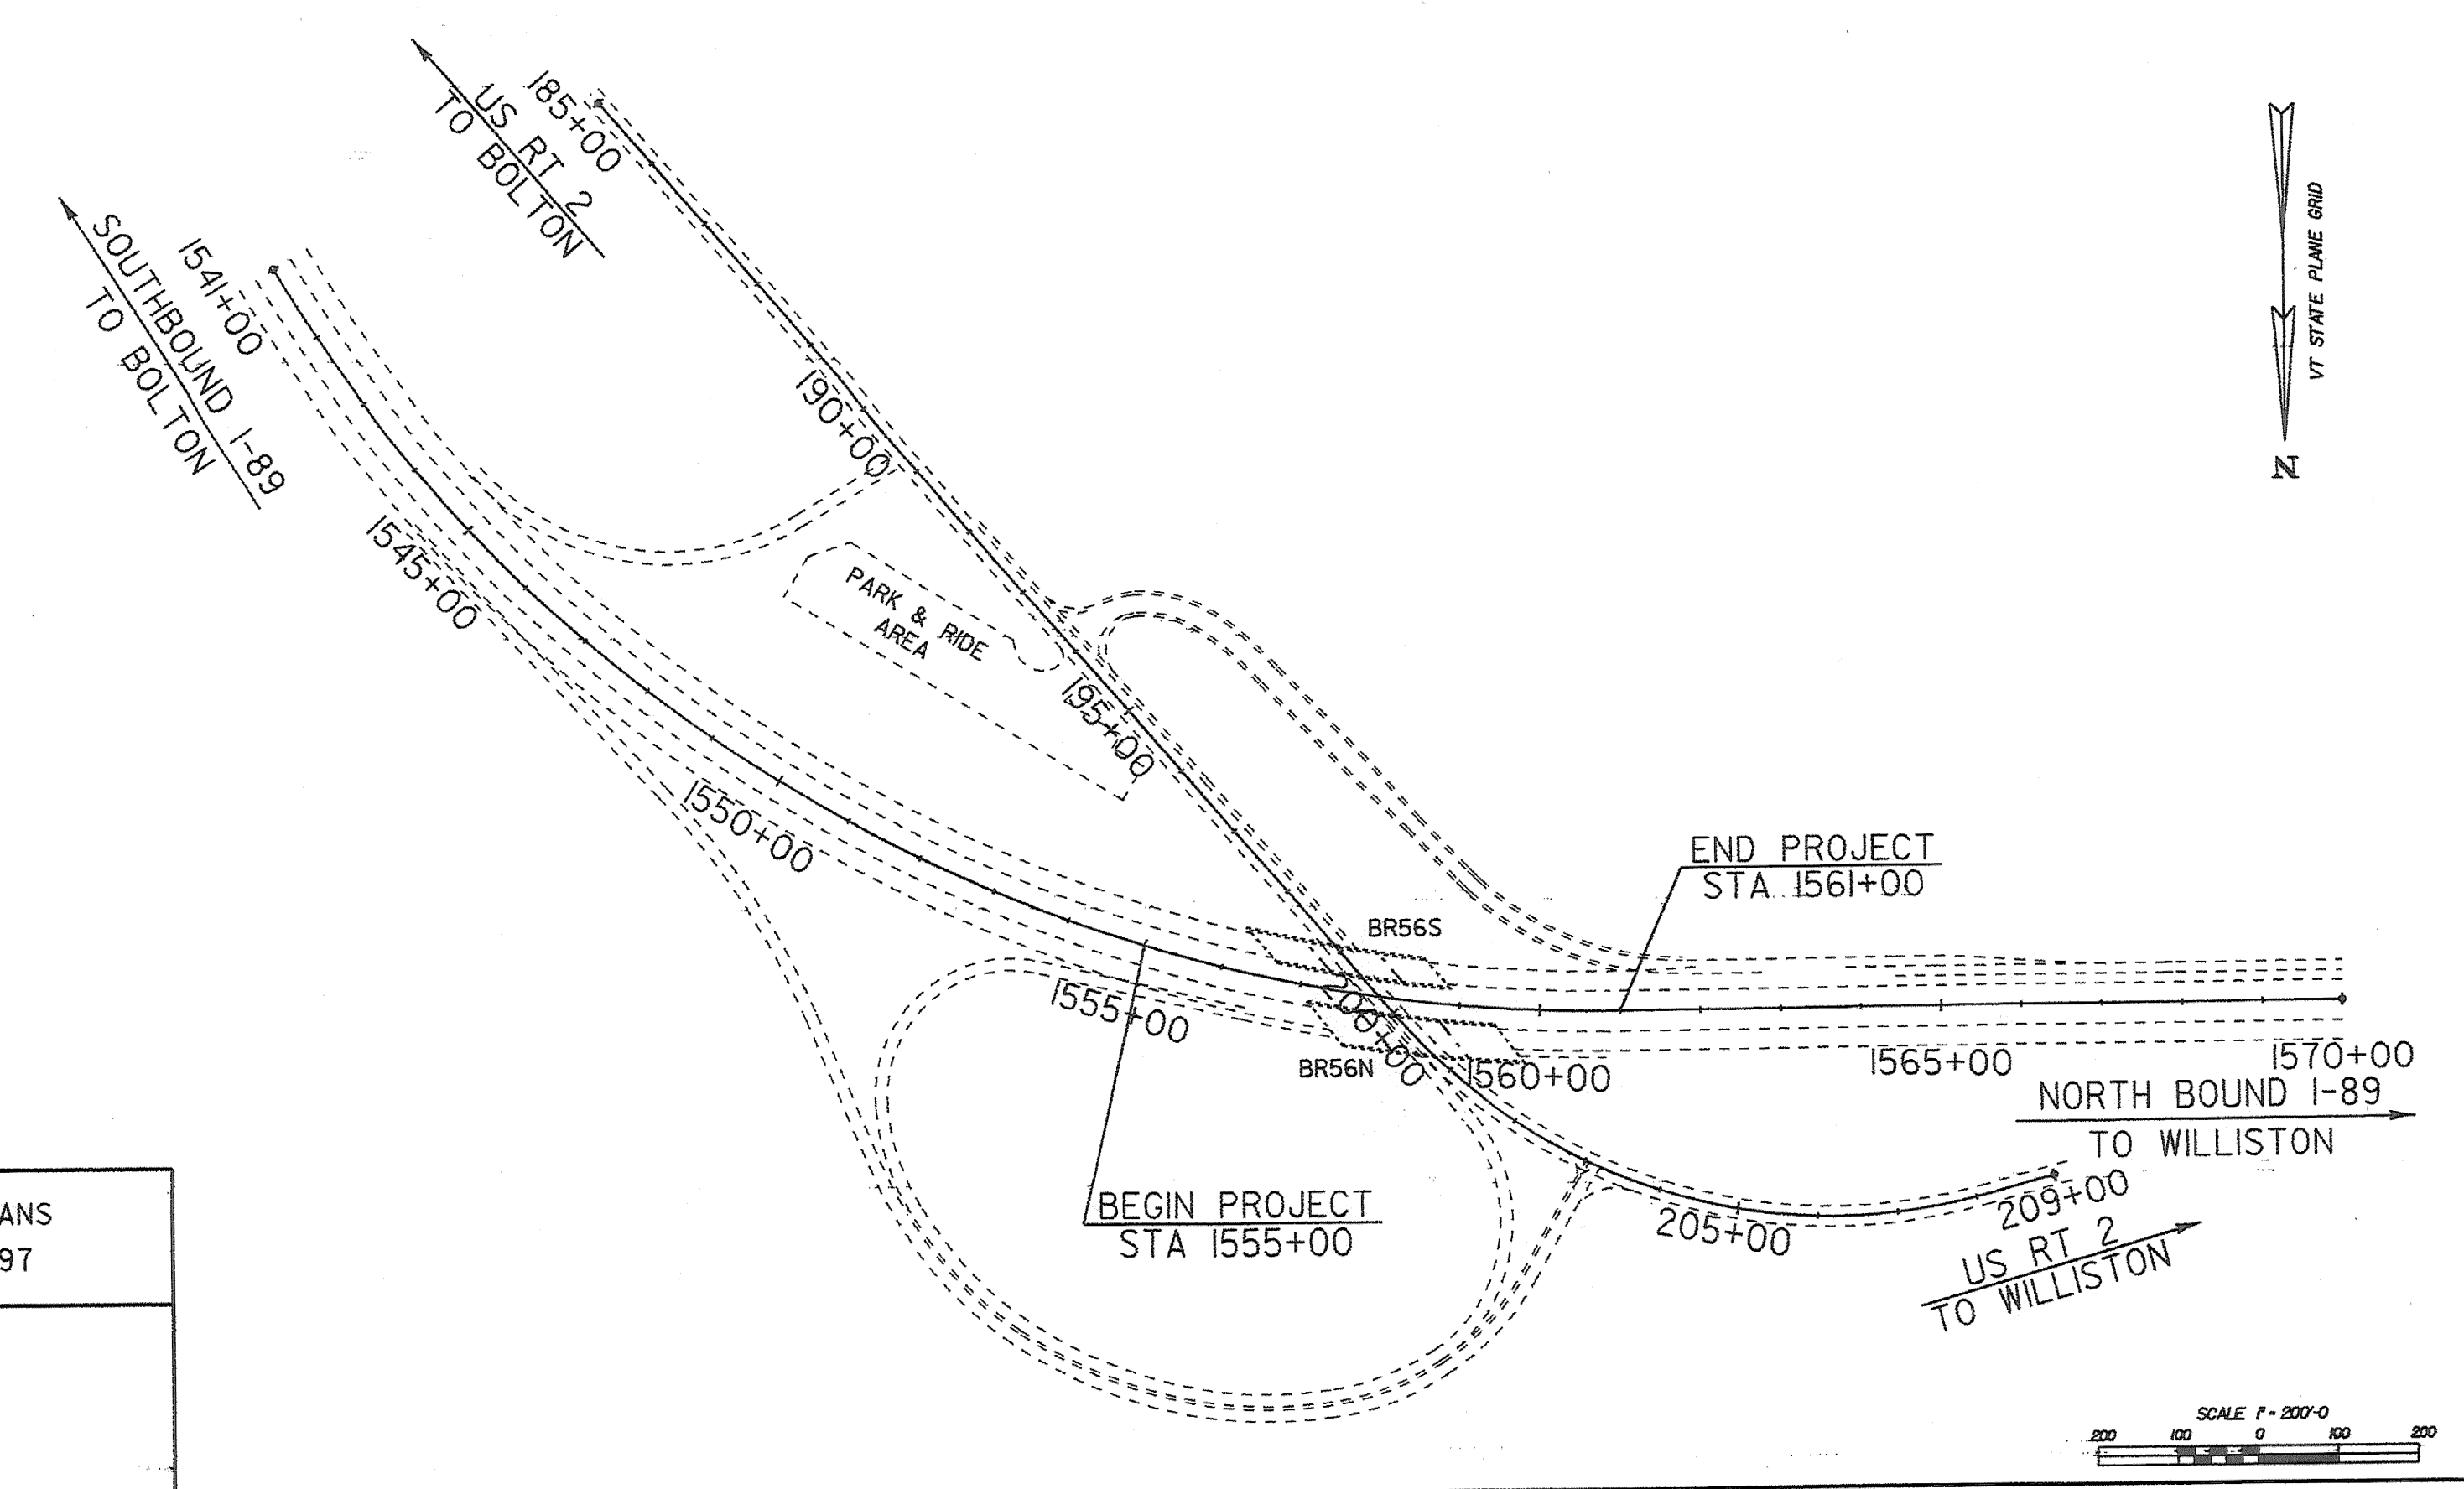

CONVENTIONAL SYMBOLS	
COUNTY LINE	
TOWN LINE	
LIMITS OF ACCESS	
POINT OF ACCESS	
FENCE LINE	
STONE WALL	
TRAVELED WAY	
GUARD RAIL	
RAILROAD	
SURVEY LINE	
CULVERT	
POWER POLE	
TELEPHONE POLE	
TREES	
CONTROL OF ACCESS	
PROPERTY LINE	
R.O.W. TAKING LINE	
SLOPE RIGHTS	
TOP OF CUT	
TOE OF SLOPE	

SURVEYED BY : RECORD PLANS
 SURVEYED DATE : 1960 & 1997

DATUM
 VERTICAL 1929
 HORIZONTAL N/A

THESE PLANS ARE SUBJECT TO SUCH ENGINEERING CHANGES AS MAY BE REQUIRED BY THE FEDERAL HIGHWAY ADMINISTRATION OR THE DIRECTOR OF PROGRAM DEVELOPMENT.

CONSTRUCTION IS TO BE CARRIED ON IN ACCORDANCE WITH THESE PLANS AND THE STANDARD SPECIFICATIONS FOR CONSTRUCTION DATED 2001, AS APPROVED BY THE FEDERAL HIGHWAY ADMINISTRATION ON JANUARY 4, 2001 FOR USE ON THIS PROJECT, INCLUDING ALL SUBSEQUENT REVISIONS AND SUCH REVISED SPECIFICATIONS AND SPECIAL PROVISIONS AS ARE INCORPORATED IN THESE PLANS.

/05a236/structures/sa236bdr.dgn sa236111

DEPARTMENT OF TRANSPORTATION FEDERAL HIGHWAY ADMINISTRATOR	
APPROVED	<i>Mark D. Reutter</i> DATE 5-2-06
DIRECTOR OF PROGRAM DEVELOPMENT	
APPROVED	<i>Sherward Farnsworth</i> DATE 3-27-06
PROJECT MANAGER :	SHERWARD FARNSWORTH
PROJECT NAME :	RICHMOND
PROJECT NUMBER :	IM 089-2 (38)
SHEET 1 OF 43 SHEETS	