



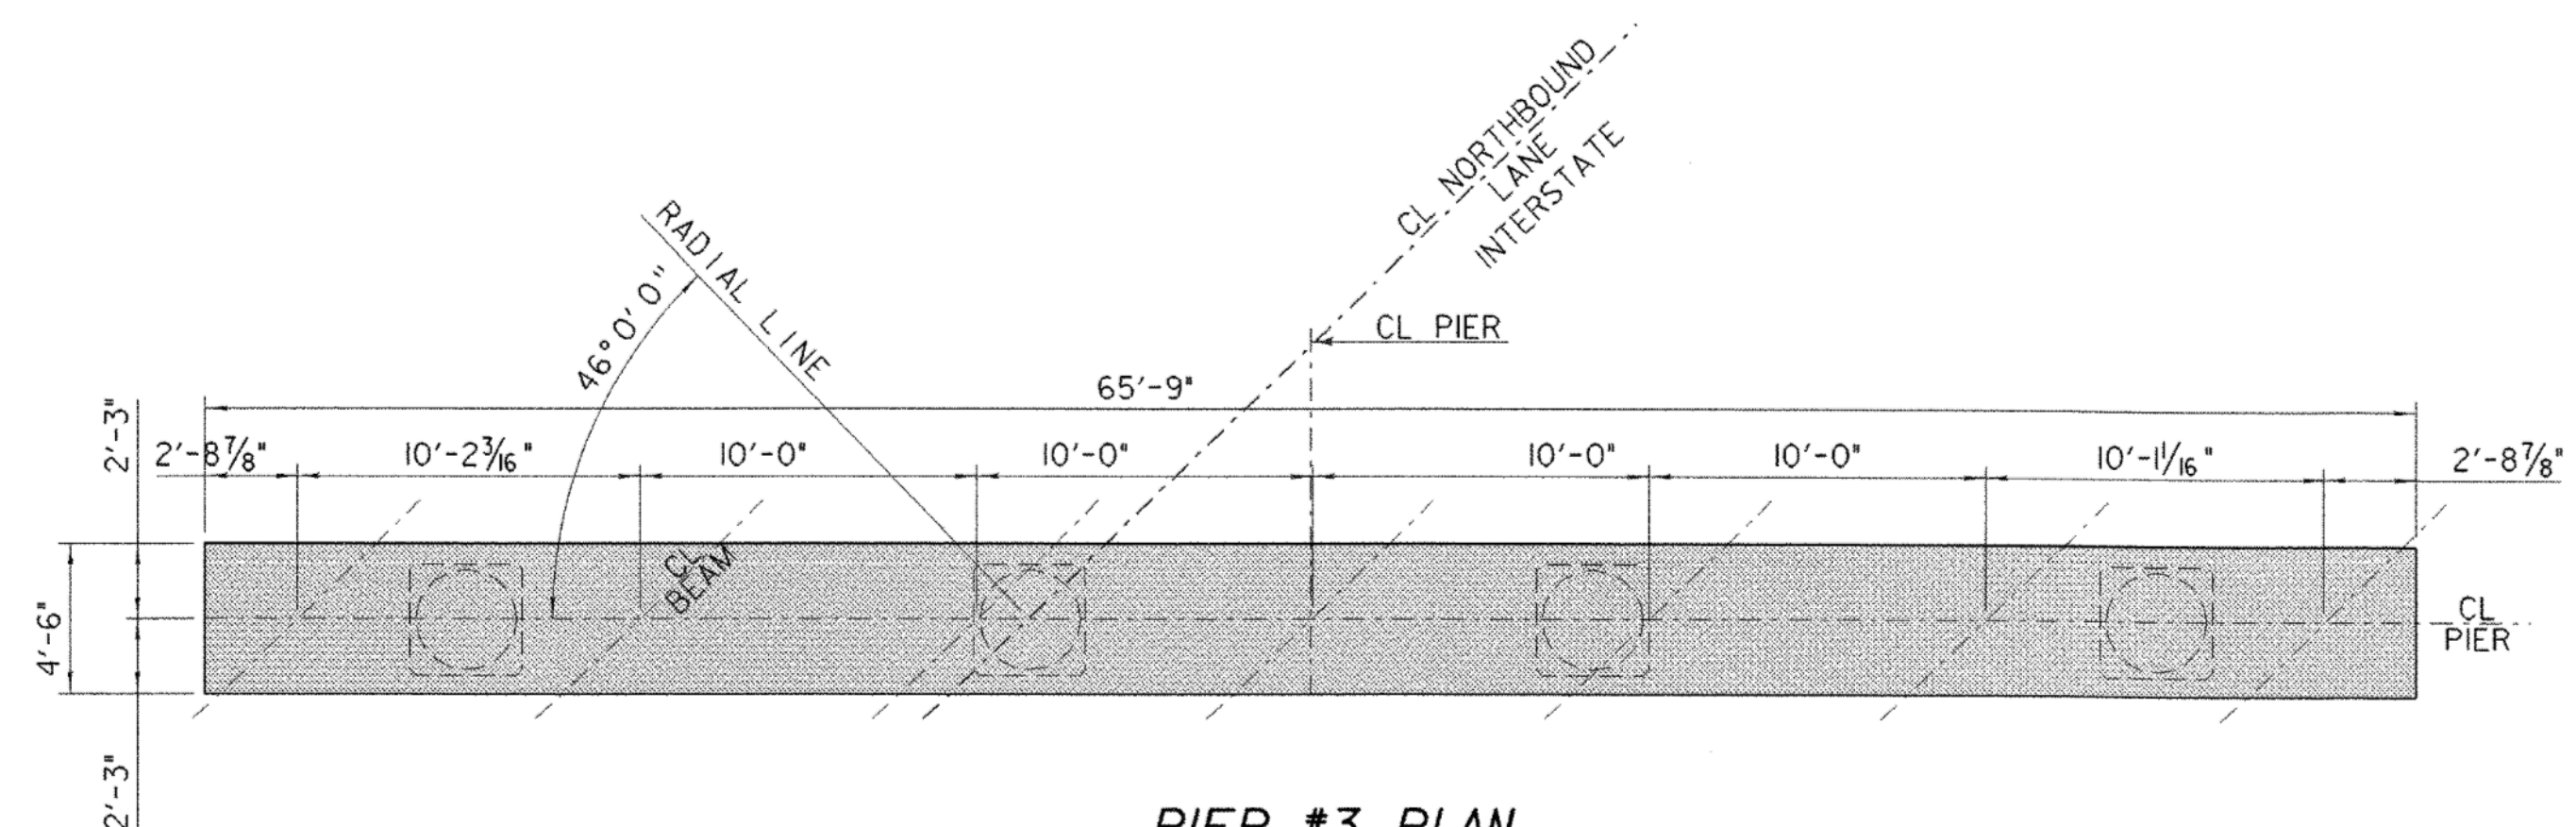



PIER #3 PLAN

SCALE $\frac{3}{16}" = 1'-0"$
1 0 2 4 6 8

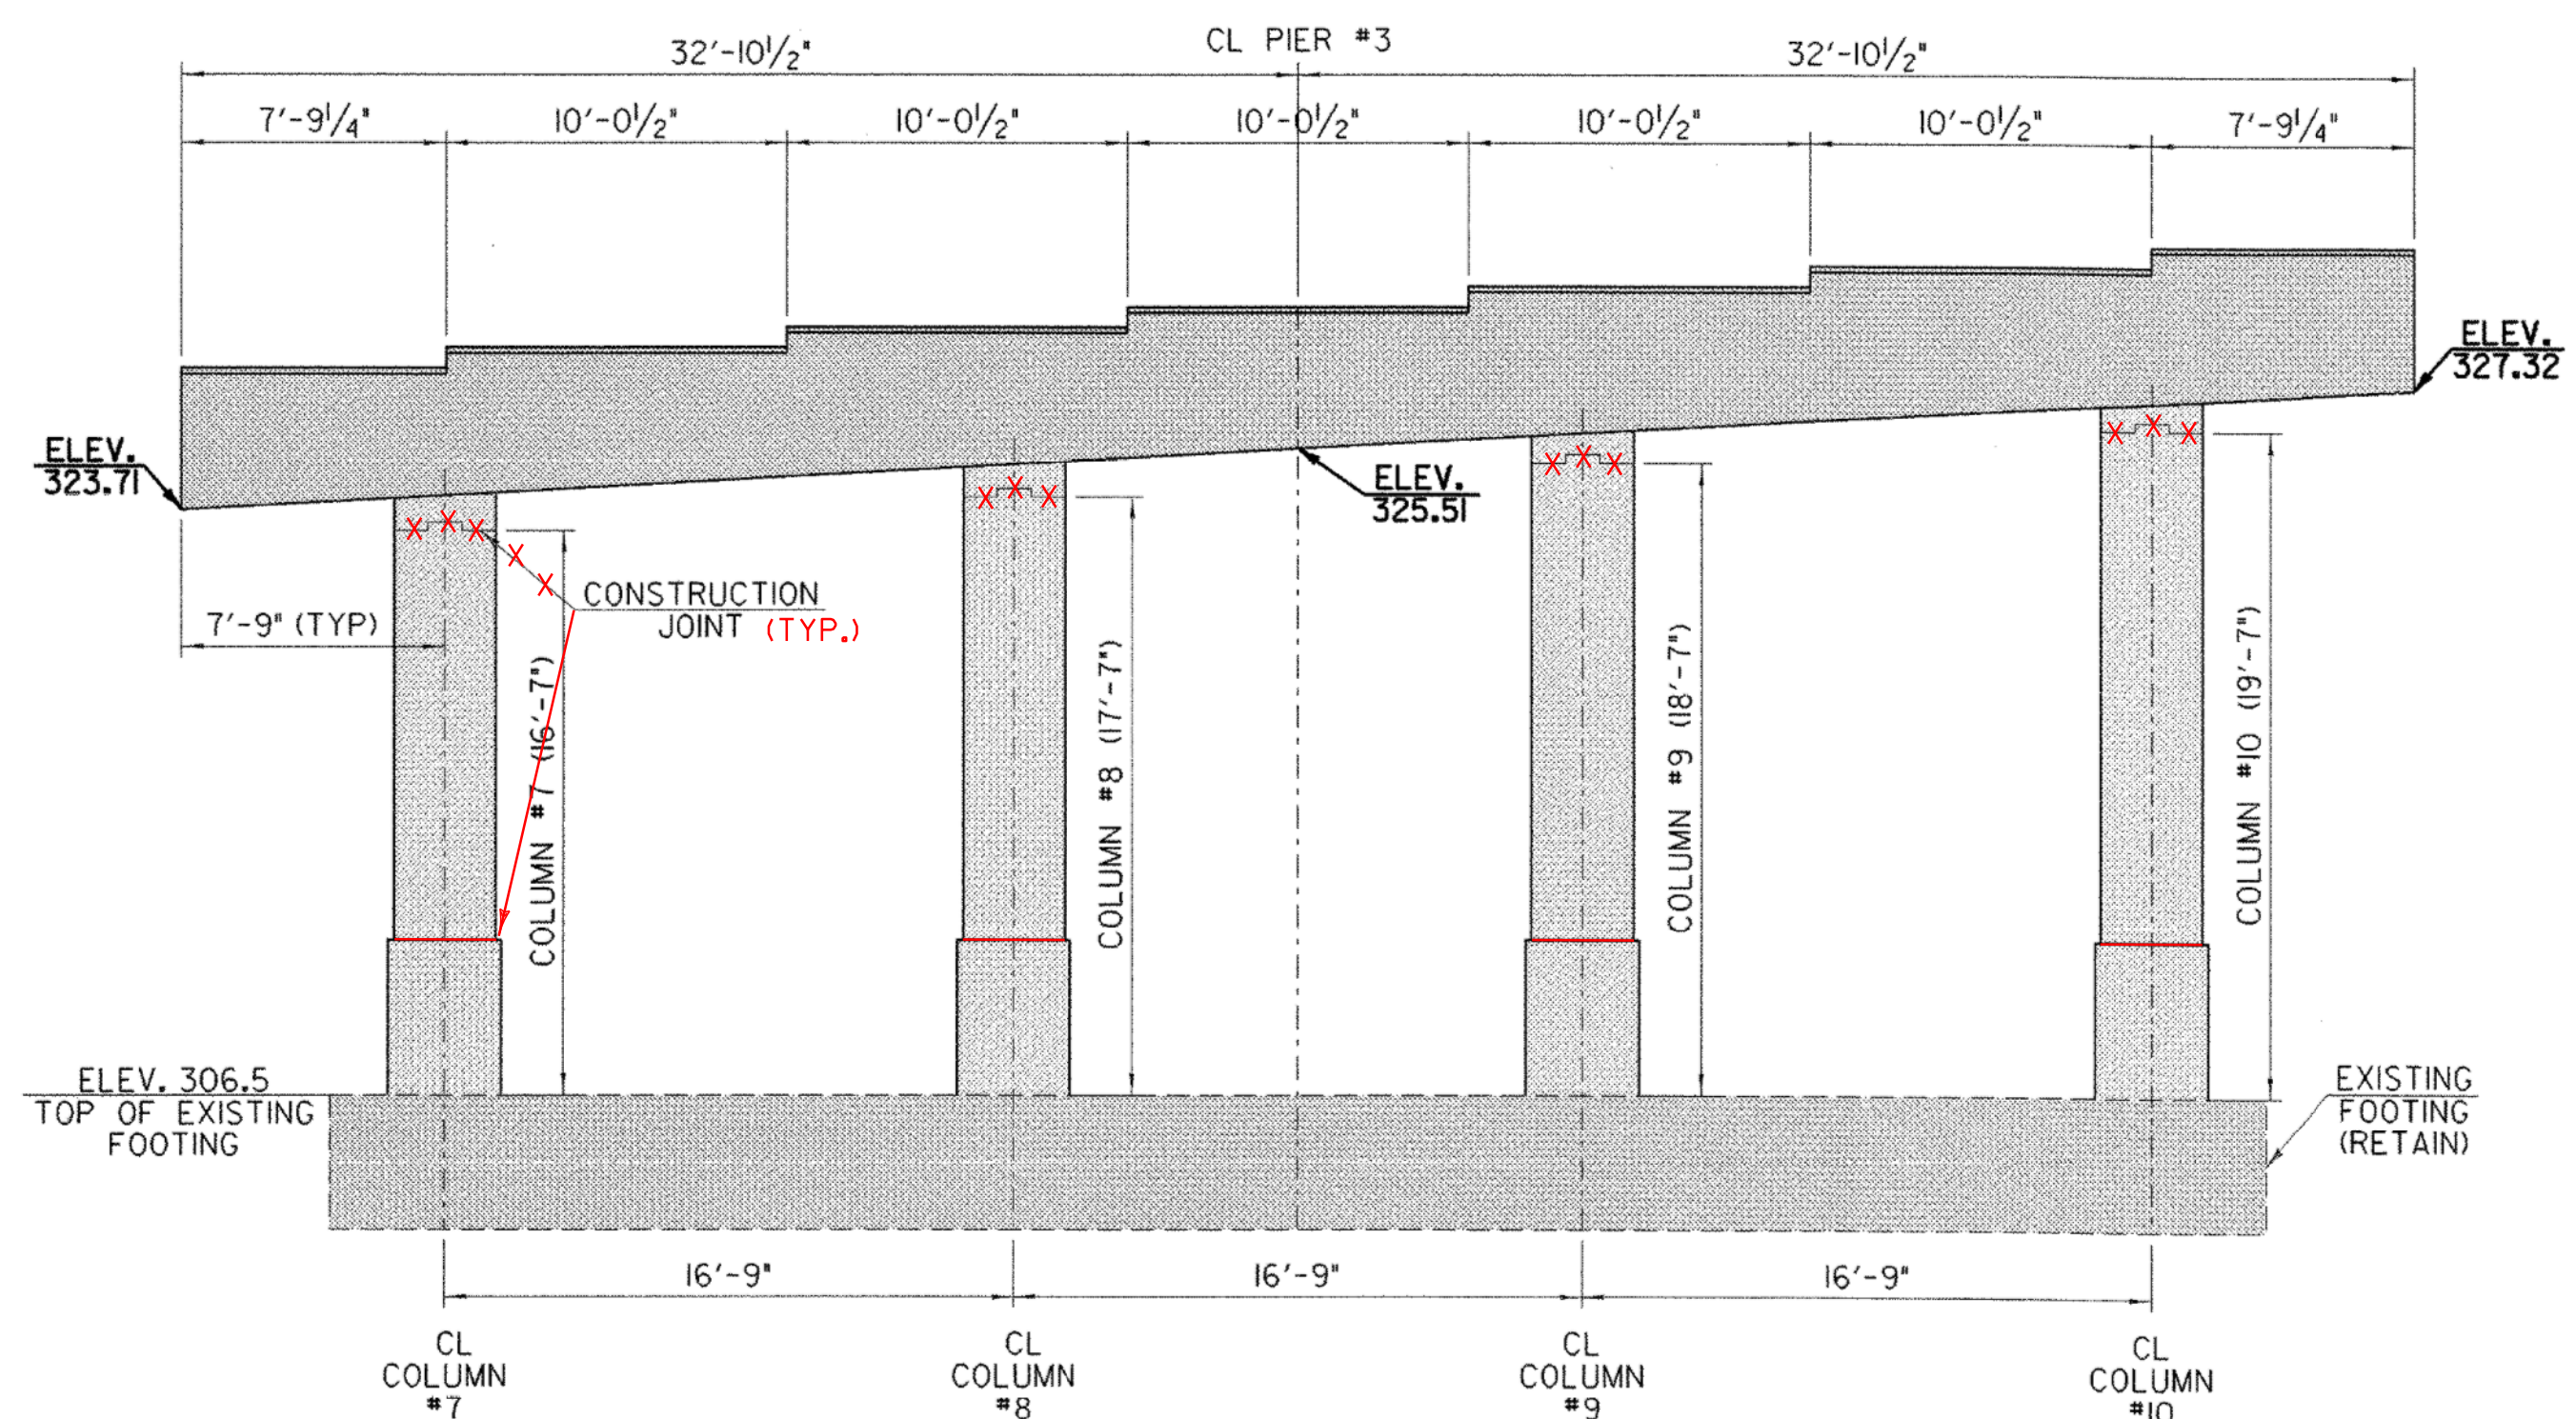


PIER #3 ELEVATION

SCALE $\frac{3}{16}" = 1'-0"$
1 0 2 4 6 8

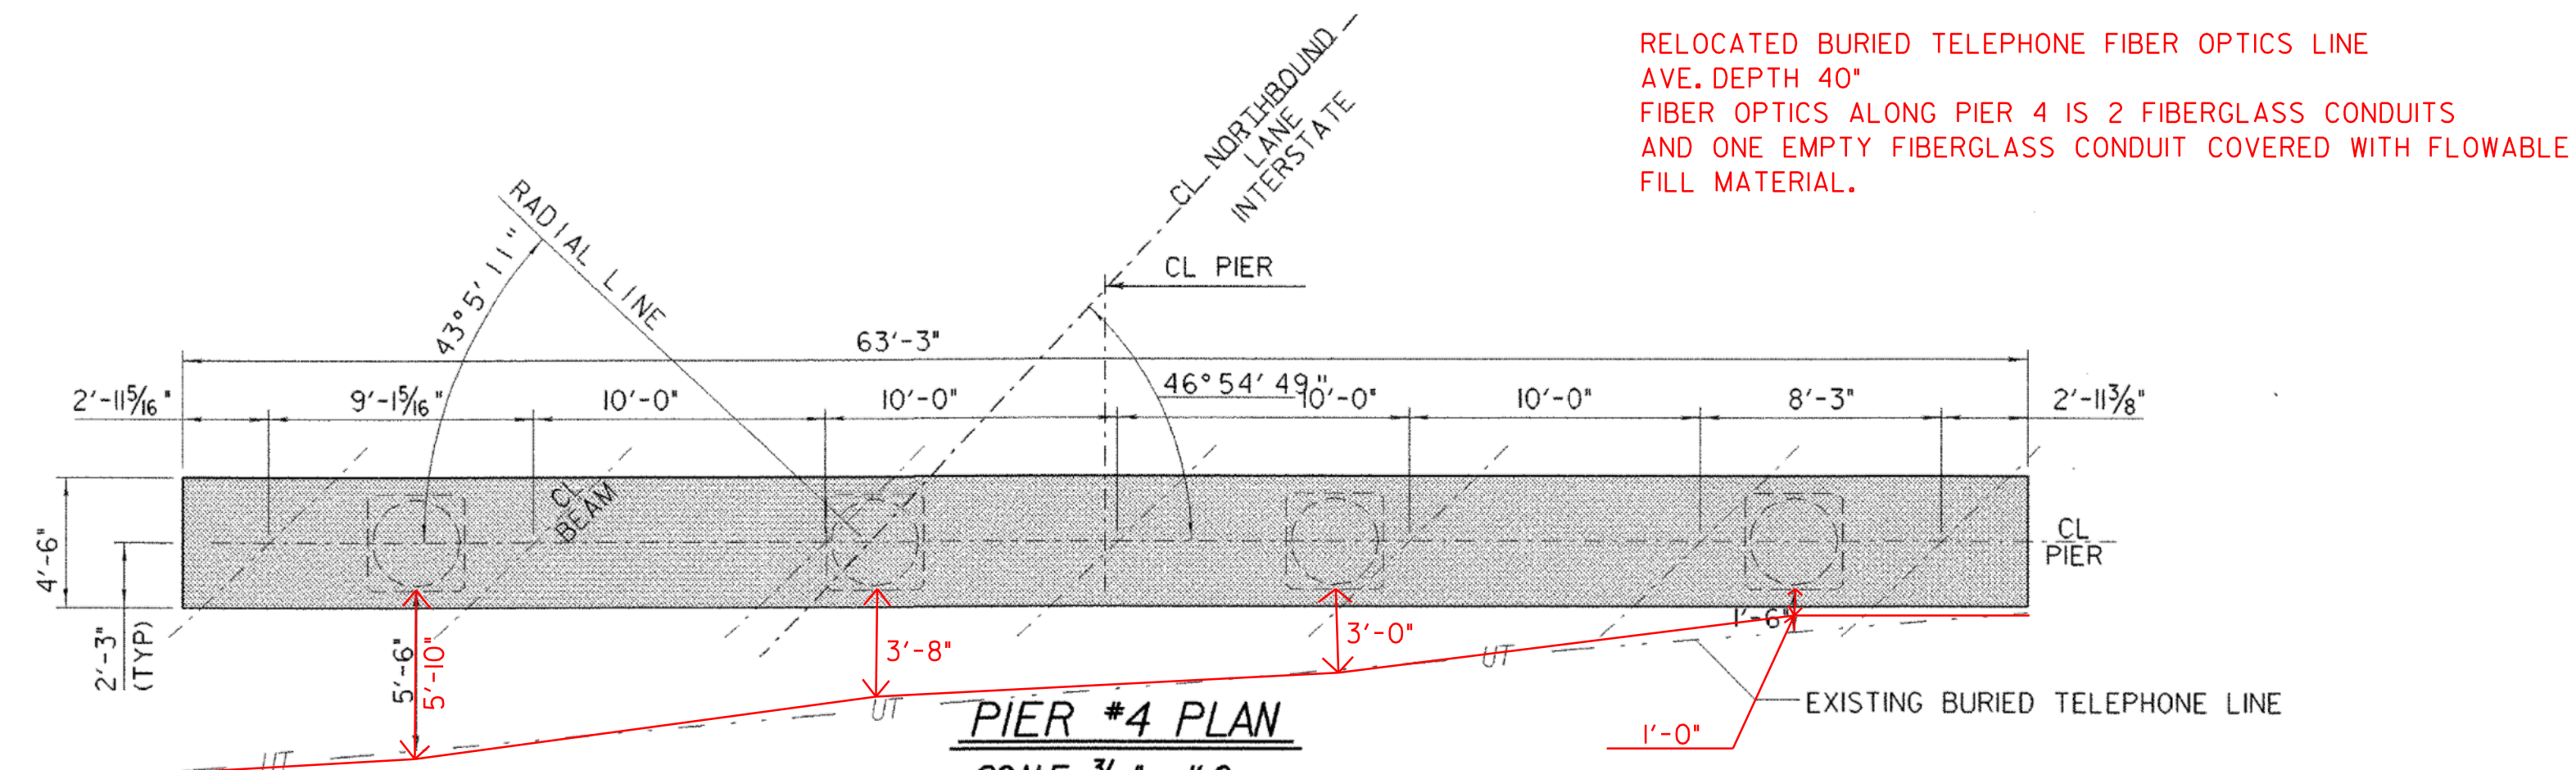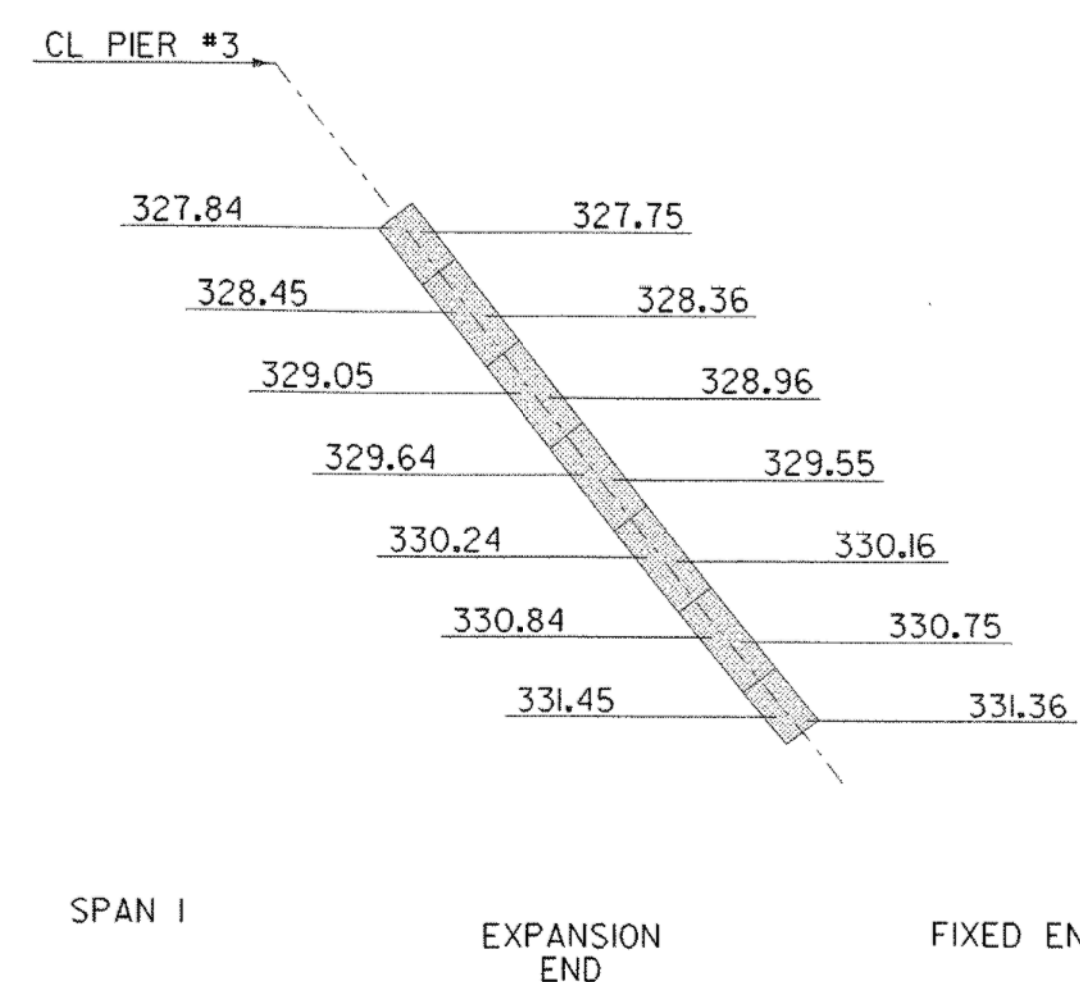


PIER #4 PLAN

SCALE $\frac{3}{16}" = 1'-0"$
1 0 2 4 6 8

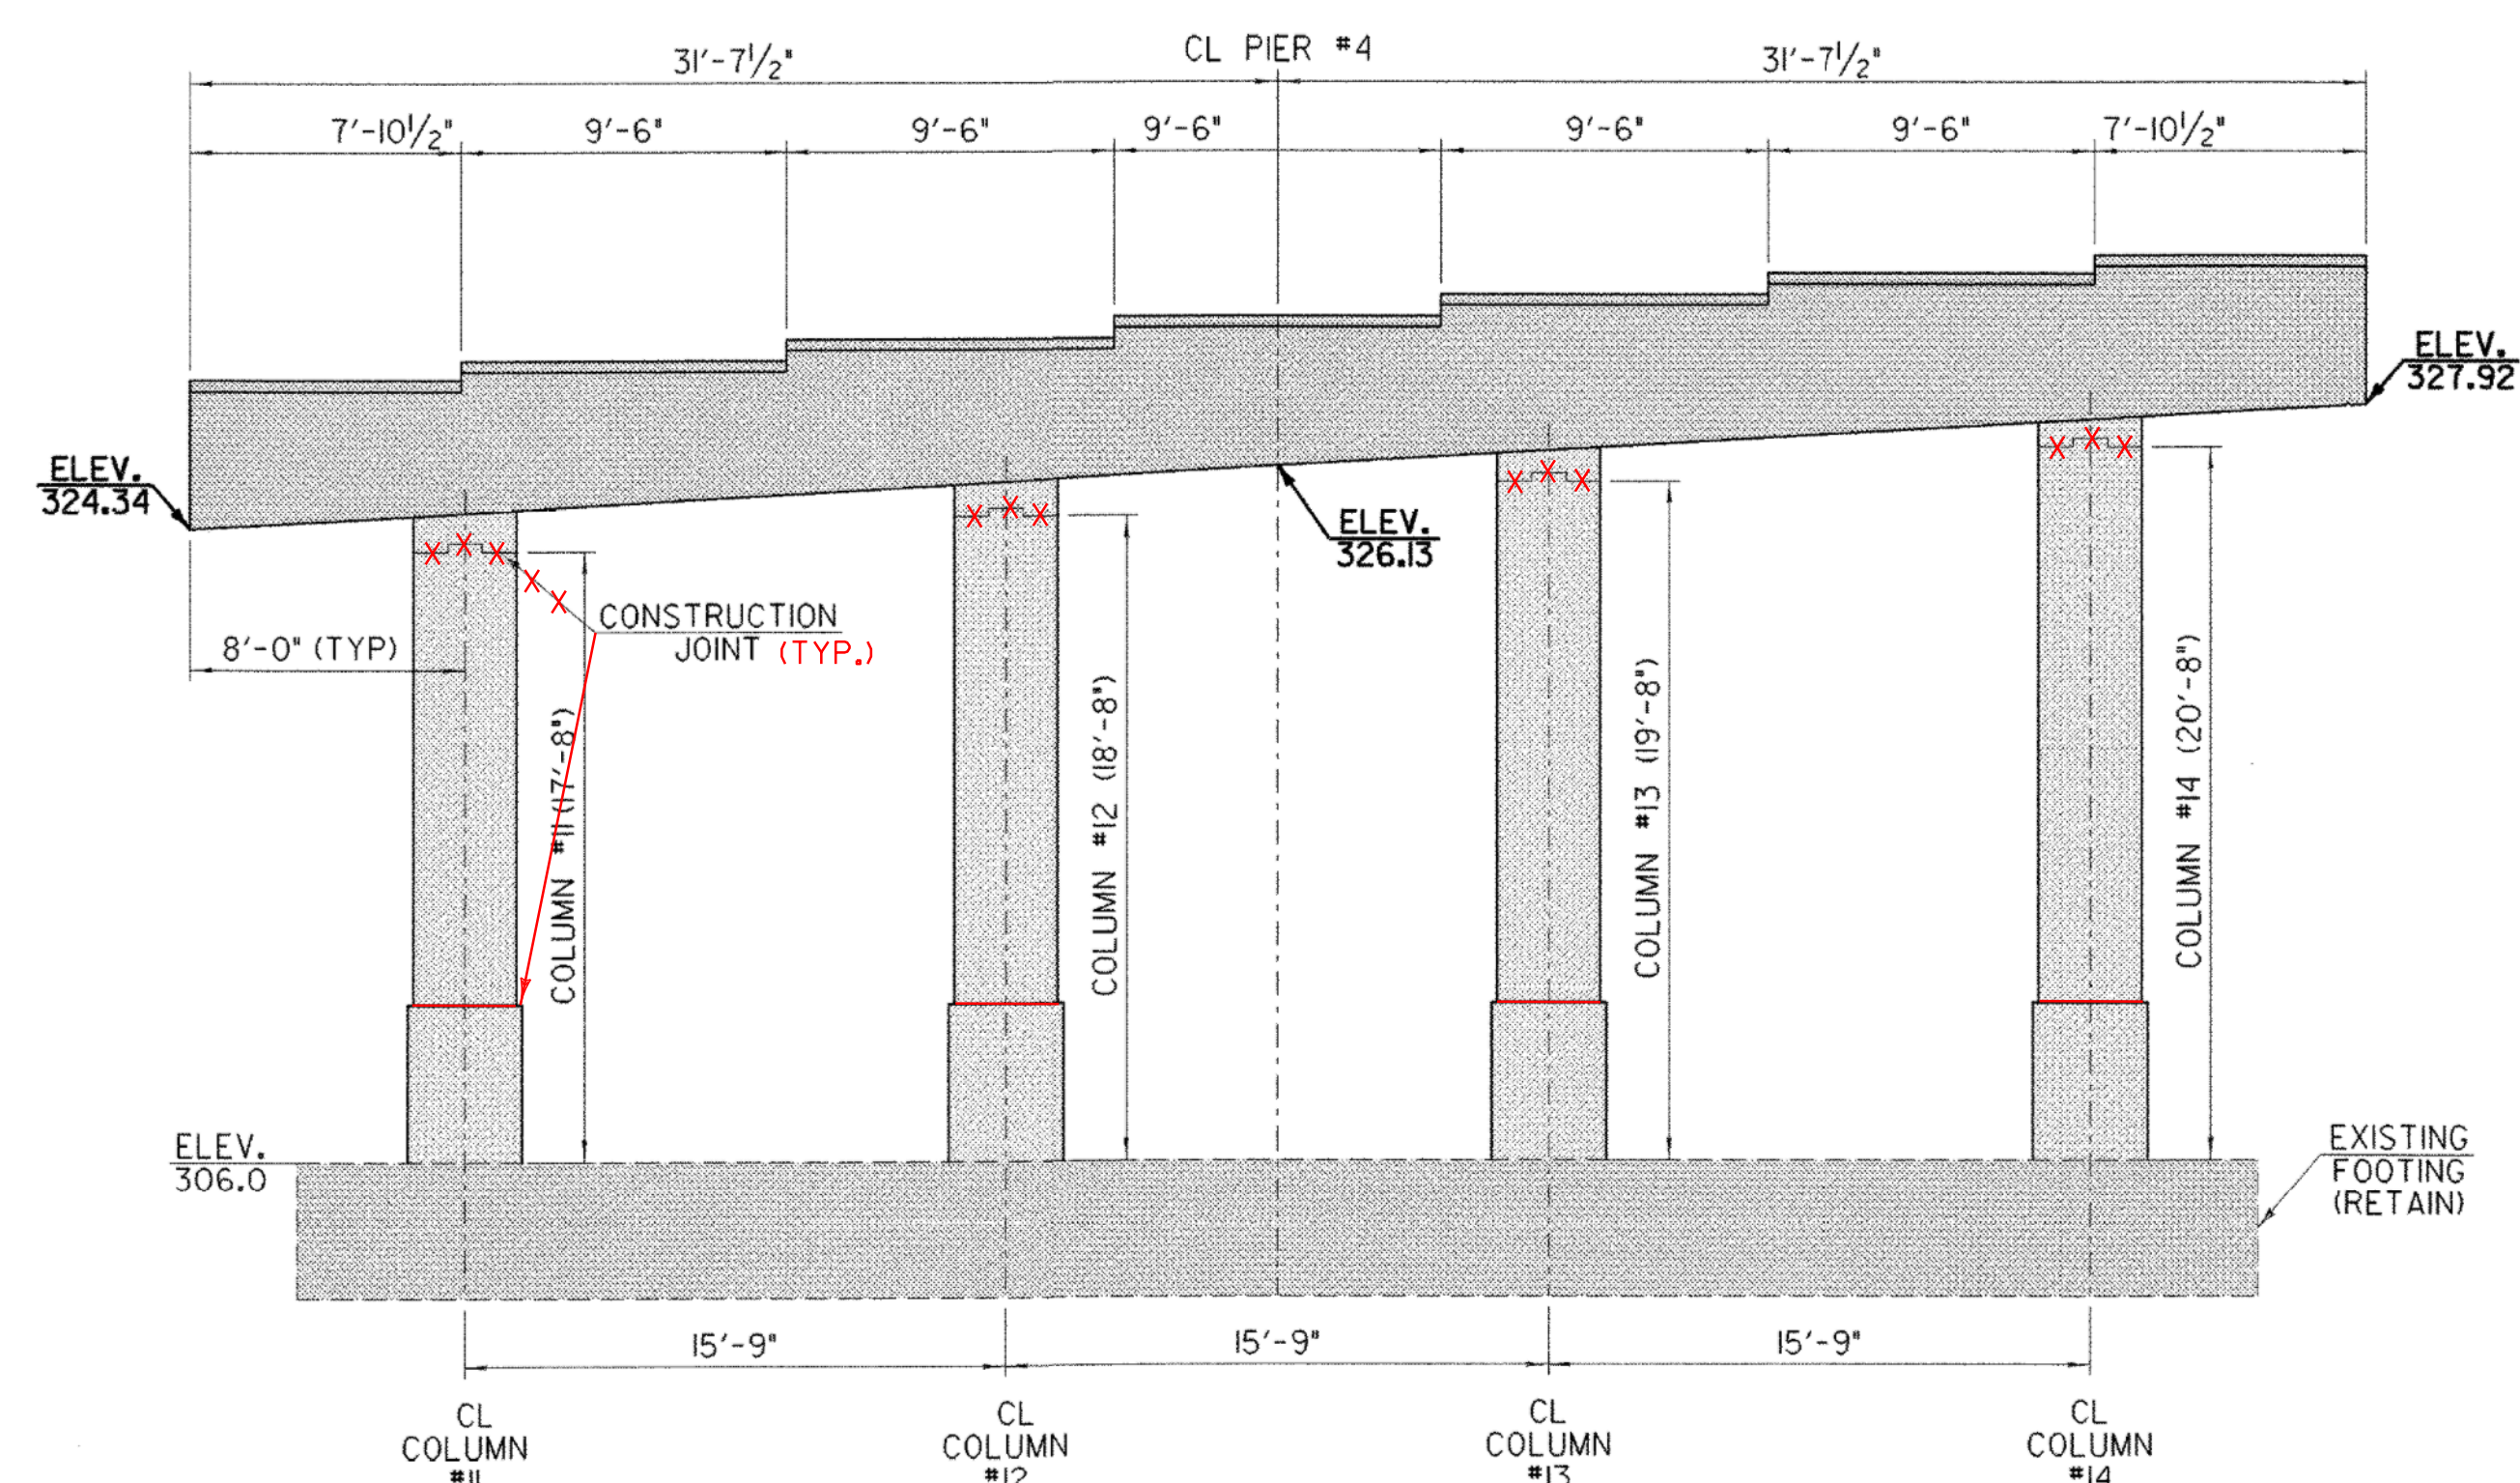

PIER #4 ELEVATION

SCALE $\frac{3}{16}" = 1'-0"$
1 0 2 4 6 8

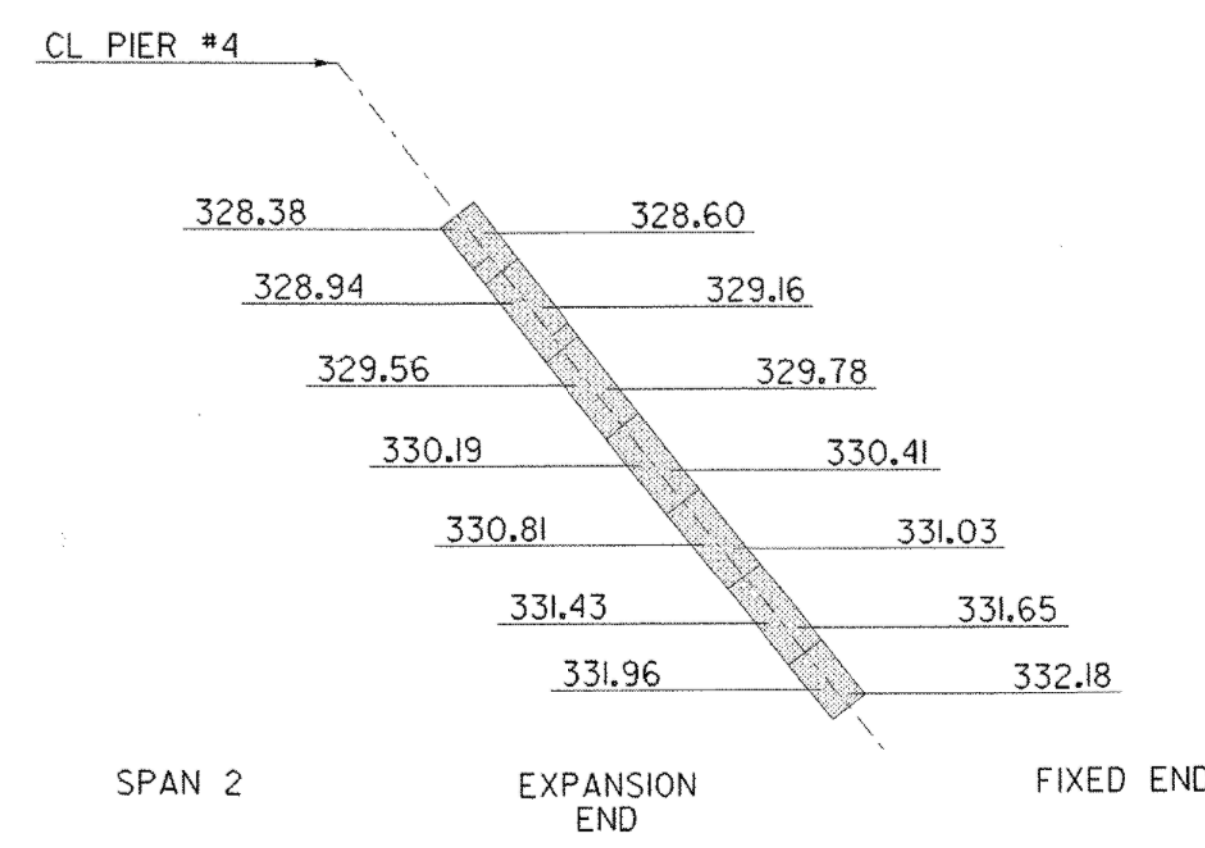

KEY PLAN

N.T.S.

NOTE
1. SEE SHEET 8 & 10 FOR
ADDITIONAL DETAILS.

NORTHBOUND LANE
STATIONING

NB PIER #3 & PIER #4 LAYOUT

PROJECT NAME:	RICHMOND	PLOT DATE:	25-APR-2006
PROJECT NUMBER:	IM 089-2(38)	DRAWN BY:	R. PELLETT
FILE NAME:	05a236\sq236newpiers.dgn	CHECKED BY:	S. FARNSWORTH
PROJECT LEADER:	SHERWARD FARNSWORTH	SHEET 9	OF 43
DESIGNED BY:	G. SPILAK		
NORTHBOUND - PIER #3 & PIER 4			

sa236ppn1