


**INDEX OF SHEETS**


SEE SHEET 2

RECORD PLANS	
CONTRACTOR:	COLD RIVER BRIDGES, LLC- KEENE, NH
RESIDENT ENGINEER:	CHAD GREENWOOD
CONSTRUCTION BEGAN:	APRIL 15, 2011
CONSTRUCTION COMPLETE:	APRIL 27, 2012
RECORD PLANS BY:	CHAD GREENWOOD & JENNA HYDE
I HEREBY CERTIFY THAT ALL THE CONSTRUCTION REQUIRED BY THIS SET OF DRAWINGS HAS BEEN ACCOMPLISHED AS INDICATED HEREIN.	
BY 	RESIDENT ENGINEER
DATE <u>9/30/13</u>	
NOTE: Any further information concerning final quantities, amounts or other details relative to this project may be found at Central Files in the electronic archives.	

STATE OF VERMONT  
AGENCY OF TRANSPORTATION

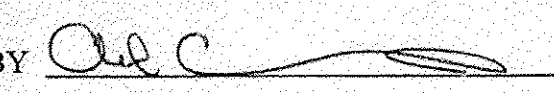

PROPOSED IMPROVEMENT  
BRIDGE PROJECT  
TOWN OF PUTNEY  
COUNTY OF WINDHAM  
BRIDGES NO. 14N&S, 15N&S, 16N&S ON INTERSTATE 91

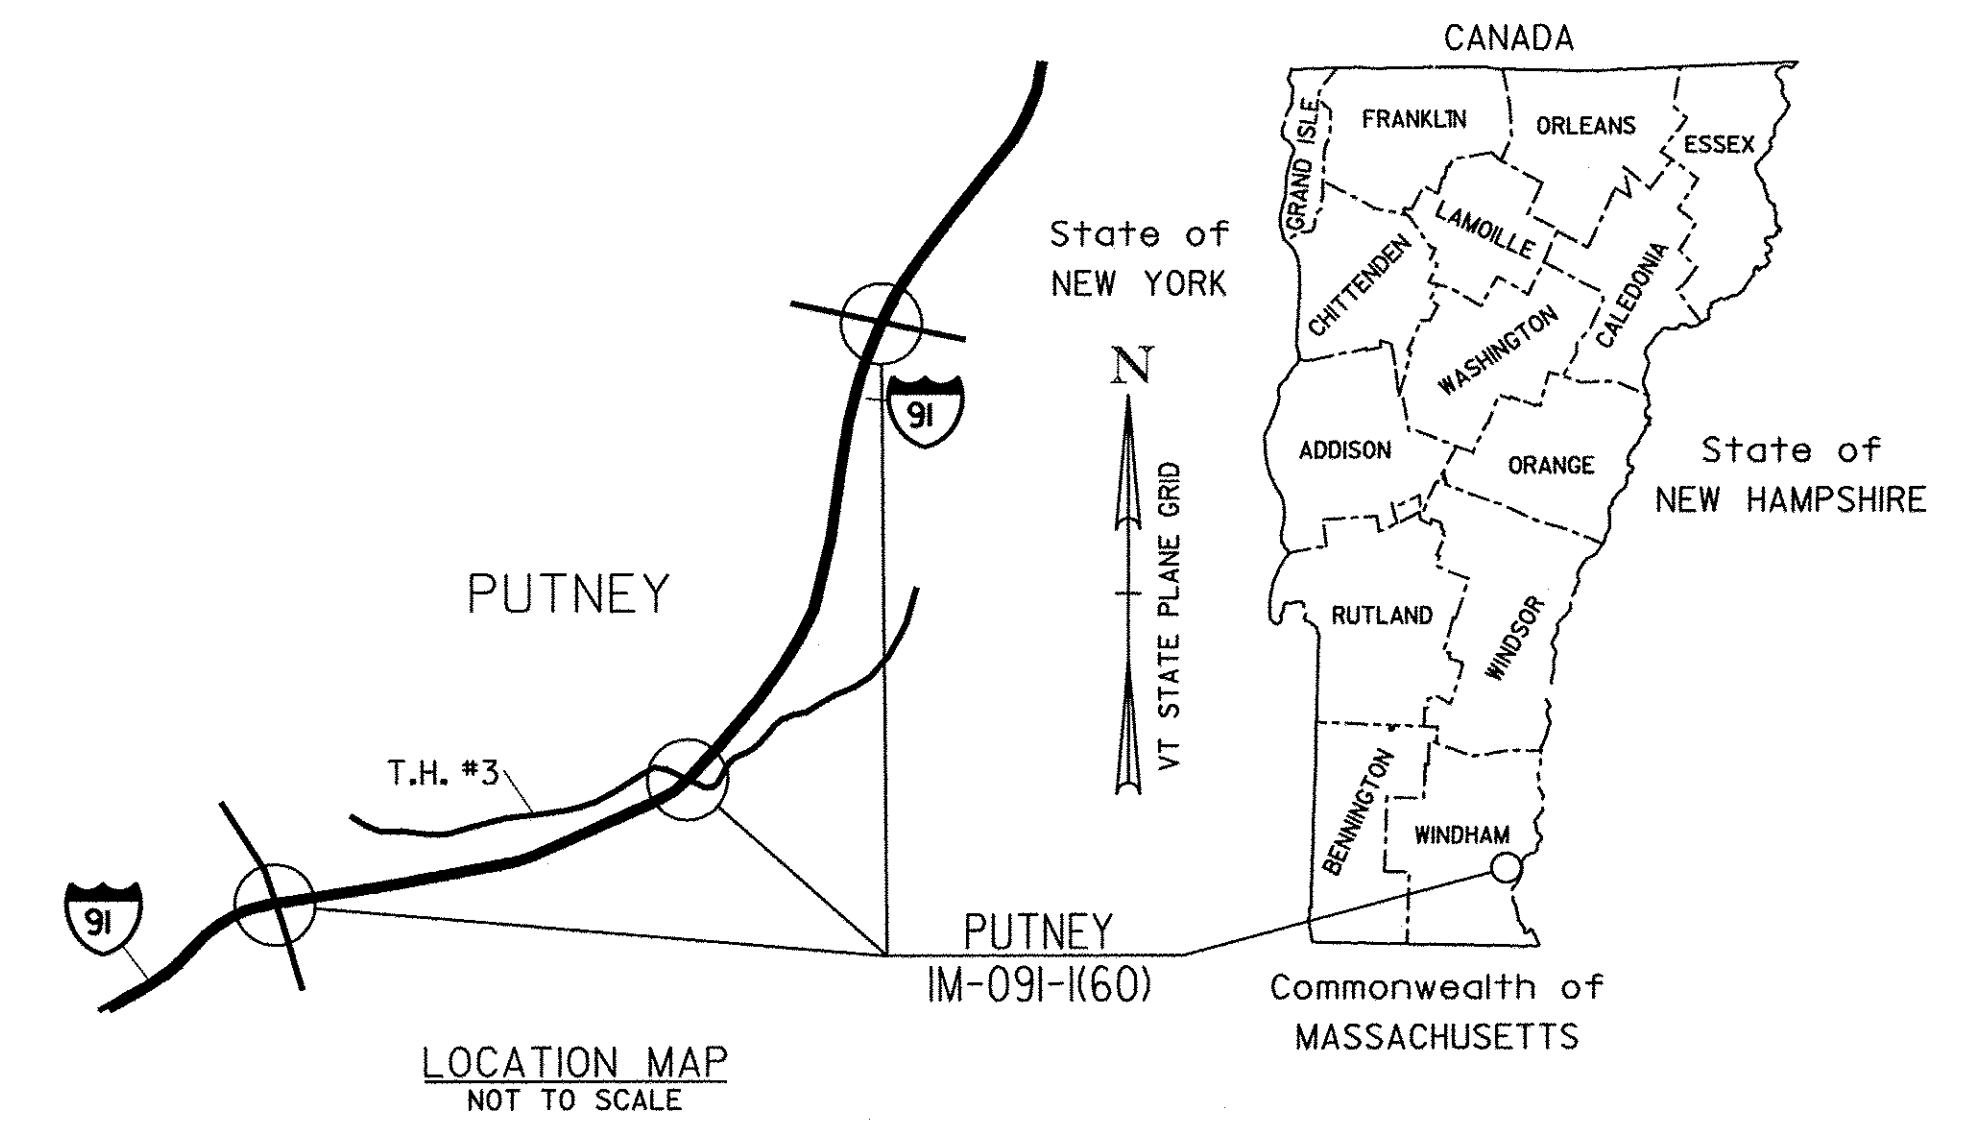


PROJECT LOCATIONS: BRIDGES 14N&S ARE LOCATED ON I-91(M.M. 18.46) OVER SACKETTS BROOK IN THE TOWN OF PUTNEY.  
BRIDGES 15N&S ARE LOCATED ON I-91(M.M. 19.69) OVER T.H. NO. 3 IN THE TOWN OF PUTNEY.  
BRIDGES 16N&S ARE LOCATED ON I-91(M.M. 21.30) OVER T.H. NO. 50 AND PUTNEY BROOK IN THE TOWN OF PUTNEY.

PROJECT DESCRIPTION: REMOVAL AND REPLACEMENT OF BITUMINOUS CONCRETE WEARING SURFACE AND MEMBRANE ON BRIDGES 14N&S, 15N&S, 16N&S, REPLACING PIER DIAPHRAGMS ON BRIDGES 14N&S AND BRIDGES 16N&S AND CONSTRUCTION OF LINK SLABS ON BRIDGES 16N&S AND MINOR ASSOCIATED WORK.

LENGTH OF BRIDGES:	14N	243'
	14S	244'
	15N	299'
	15S	157'
	16N	354'
	16S	350'

TOTAL LENGTH OF BRIDGES: 1647'

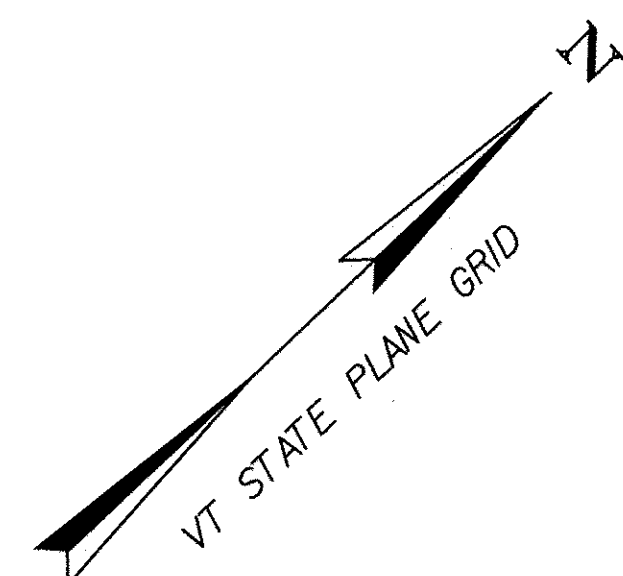


QUALITY ASSURANCE PROGRAM: LEVEL 1

**CONVENTIONAL SYMBOLS**

COUNTY LINE	
TOWN LINE	
LIMITS OF ACCESS	
POINT OF ACCESS	
FENCE LINE	
STONE WALL	
TRAVELED WAY	
GUARD RAIL	
RAILROAD	
SURVEY LINE	
CULVERT	
POWER POLE	
TELEPHONE POLE	
TREES	
CONTROL OF ACCESS	
PROPERTY LINE	
R.O.W. TAKING LINE	
SLOPE RIGHTS	
TOP OF CUT	
TOE OF SLOPE	

SURVEYED BY : N/A  
SURVEYED DATE : N/A  
DATUM  
VERTICAL NAD83 (93)  
HORIZONTAL NAVD88 (03)

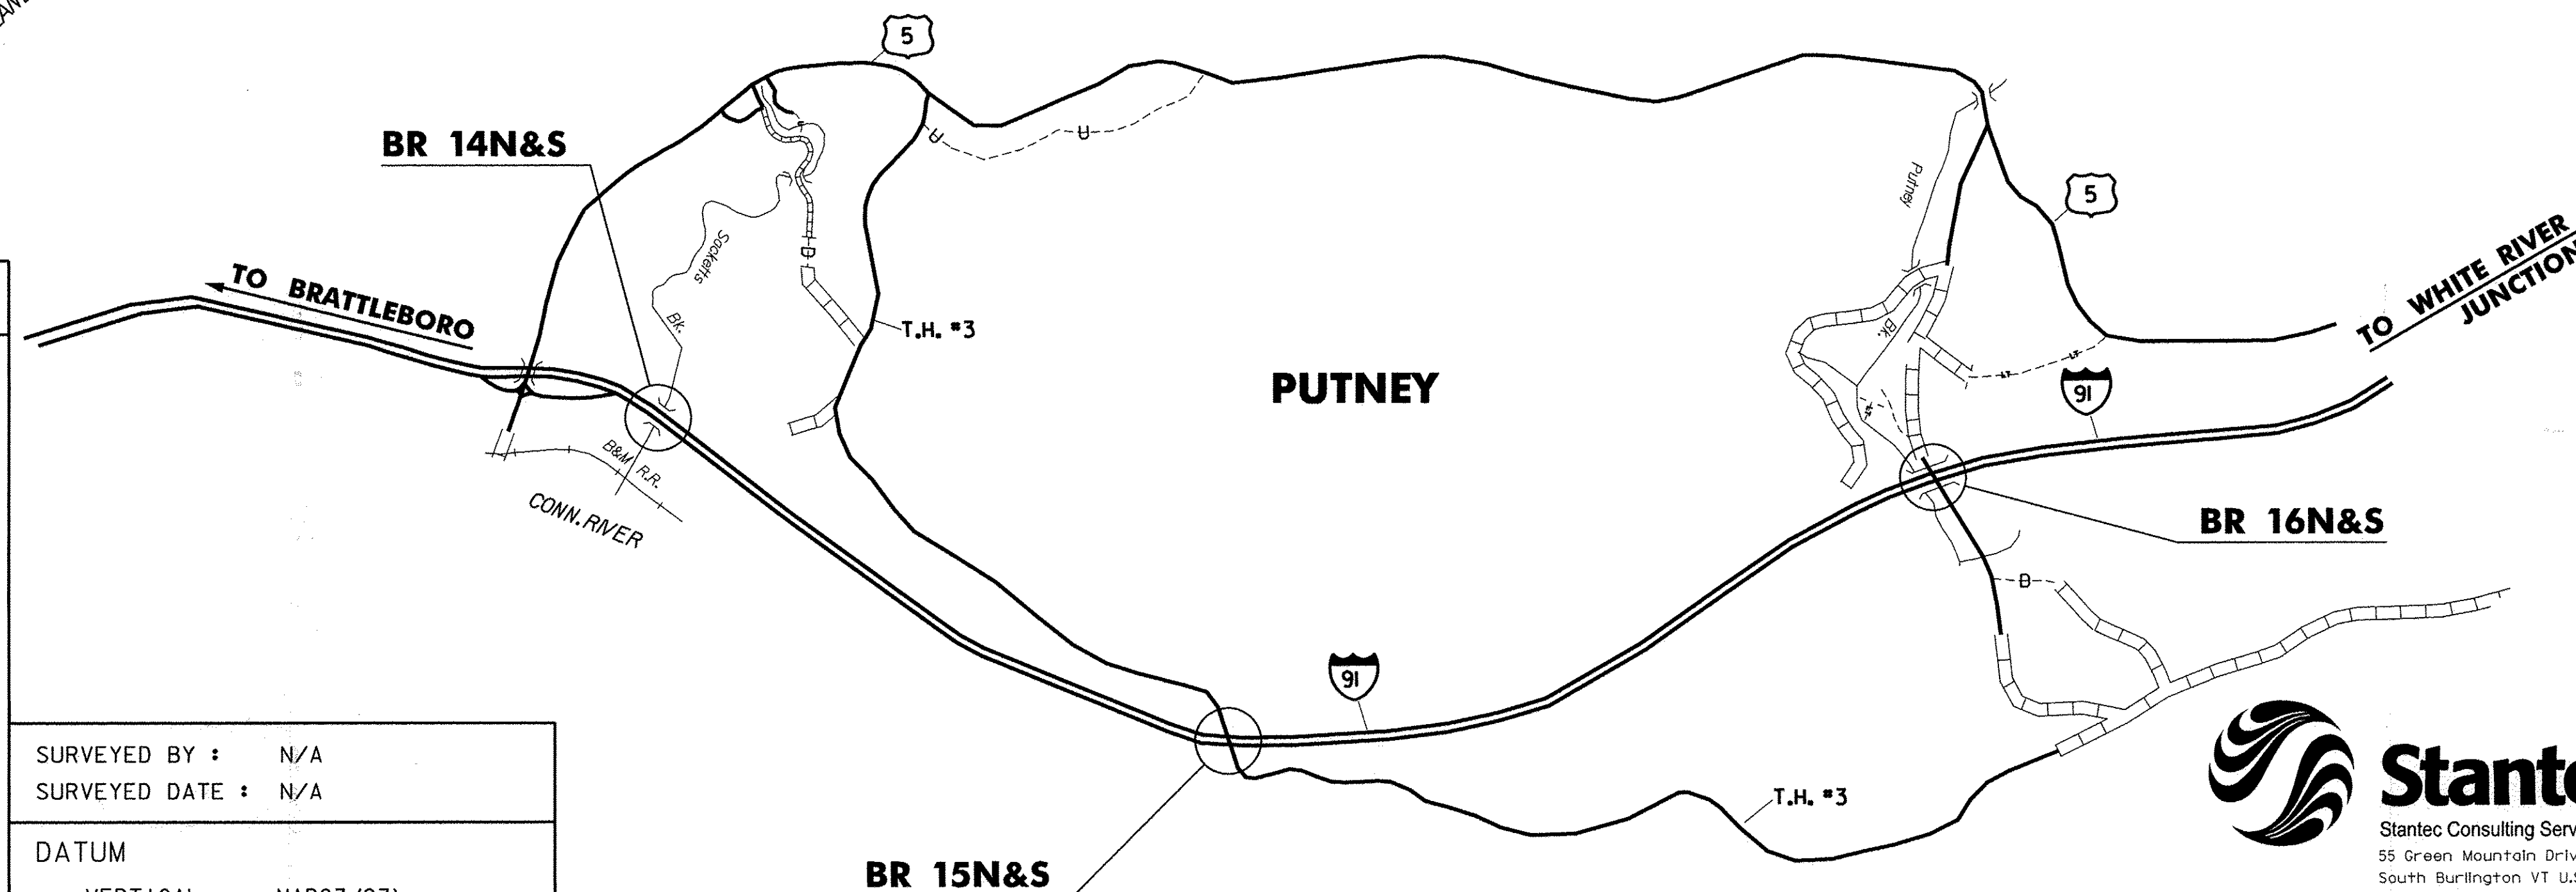


NOT TO SCALE



THESE PLANS ARE SUBJECT TO SUCH ENGINEERING CHANGES AS MAY BE REQUIRED BY THE FEDERAL HIGHWAY ADMINISTRATION OR THE DIRECTOR OF PROGRAM DEVELOPMENT.  
CONSTRUCTION IS TO BE CARRIED ON IN ACCORDANCE WITH THESE PLANS AND THE STANDARD SPECIFICATIONS FOR CONSTRUCTION DATED 2006, AS APPROVED BY THE FEDERAL HIGHWAY ADMINISTRATION ON JUNE 15, 2006 FOR USE ON THIS PROJECT, INCLUDING ALL SUBSEQUENT REVISIONS AND SUCH REVISED SPECIFICATIONS AND SPECIAL PROVISIONS AS ARE INCORPORATED IN THESE PLANS.

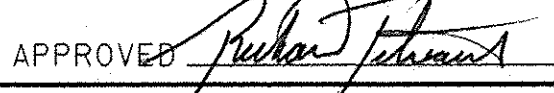

DIRECTOR OF PROGRAM DEVELOPMENT  
APPROVED  DATE 8-2-10  
PROJECT MANAGER : SHERWARD G. FARNSWORTH  
PROJECT NAME : PUTNEY  
PROJECT NUMBER : IM 091-1 (60)  
SHEET 1 OF 45 SHEETS