


FRAMING PLAN  
SCALE - 1" = 10'-0"  
NOTES - SEE SHEET 105

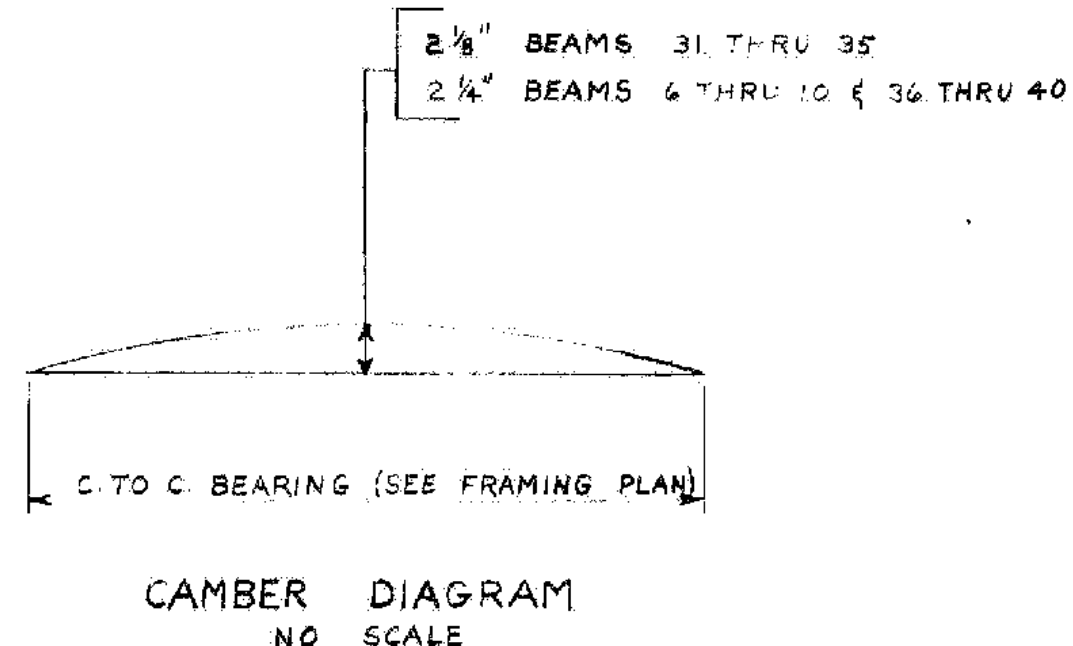

STRUCTURAL STEEL PLAN

STATE OF VERMONT  
DEPARTMENT OF HIGHWAYS

TOWN OF PUTNEY

ROUTE NO. INTERSTATE LOG STA. 1047+03.76  
INTERSTATE OVER SA-3

SA-3 (REL) STA. 16+12.51

SCALE 1" = 10'-0"

SURVEYED BY \_\_\_\_\_  
DRAWN BY CURRIER CHECKED BY W.M.S.

PROJECT NO. I-91-1 (10)  
SHEET 105-A OF 328

CONTRACT NO. 1

PUTNEY  
IM 091-1(60)  
SHEET 35 OF 45  
BRIDGE 15  
FOR REFERENCE ONLY