

INDEX OF SHEETS

- 1. TITLE SHEET
- 2. TYPICAL SHEET
- 3. QUANTITY SHEET
- 4. PROJECT LOCATION SHEET
- 5-7. PAVEMENT MARKING DETAILS

STANDARDS

E-100	CONSTRUCTION APPROACH SIGNS	01/02/04
E-101	CONSTRUCTION SIGN DETAILS	05/30/03
E-102	CONSTRUCTION SIGN DETAILS	06/30/03
E-102A	CONSTRUCTION SIGN DETAILS	05/01/04
E-103	MAINLINE TRAFFIC CONTROL DIVIDED HIGHWAY ONE LANE CLOSED	03/01/04
E-105	TRAFFIC CONTROL FOR CONSTRUCTION VEHICLE	05/01/04
E-106	TRAFFIC CONTROL - MISCELLANEOUS DETAILS	03/01/04
E-107A	BREAKAWAY BARRICADE DETAILS	08/08/95
E-108	CONSTRUCTION ZONE LONGITUDINAL DROP OFFS U-TURNS ON DIVIDED HIGHWAY	08/18/95

# STATE OF VERMONT AGENCY OF TRANSPORTATION



## PROPOSED IMPROVEMENT


### STATEWIDE AC IM RUTF(11) I-89 & I-91 NORTHBOUND & SOUTHBOUND LANES FOR LOCATIONS, SEE PROJECT LOCATION SHEET

WORK TO BE PERFORMED UNDER THIS PROJECT INCLUDES  
CORRECTION OF RUTTED AREAS BY COLD PLANING AND PAVING,  
STRIPING, AND APPROPRIATE TRAFFIC CONTROL OF THE EXISTING  
INTERSTATE HIGHWAY,

PROJECT LOCATIONS

I-89	I-91
<p>14.715 NB MM 14.70 - 15.70 SHARON</p> <p>16.45 NB MM 16.70 - 18.30 ROYALTON</p> <p>NB MM 20.20 - 21.95 ROYALTON</p> <p>SB MM 11.90 - 17.75 SHARON-ROYALTON</p>	<p>NB MM 65.50 - 66.70 HARTLAND</p> <p>NB MM 68.40 - 70.55 HARTFORD</p> <p>NB MM 72.20 - 73.60 HARTFORD</p> <p>SB MM 69.85 - 70.80 HARTFORD 69.81 - 70.81</p> <p>SB MM 74.10 - 76.30 NORWICH 74.00 - 76.30</p> <p>SB MM 108.1 - 110.0 NEWBURY</p>

PROJECT LENGTH 105 600 L.F. = 20.00 MILES

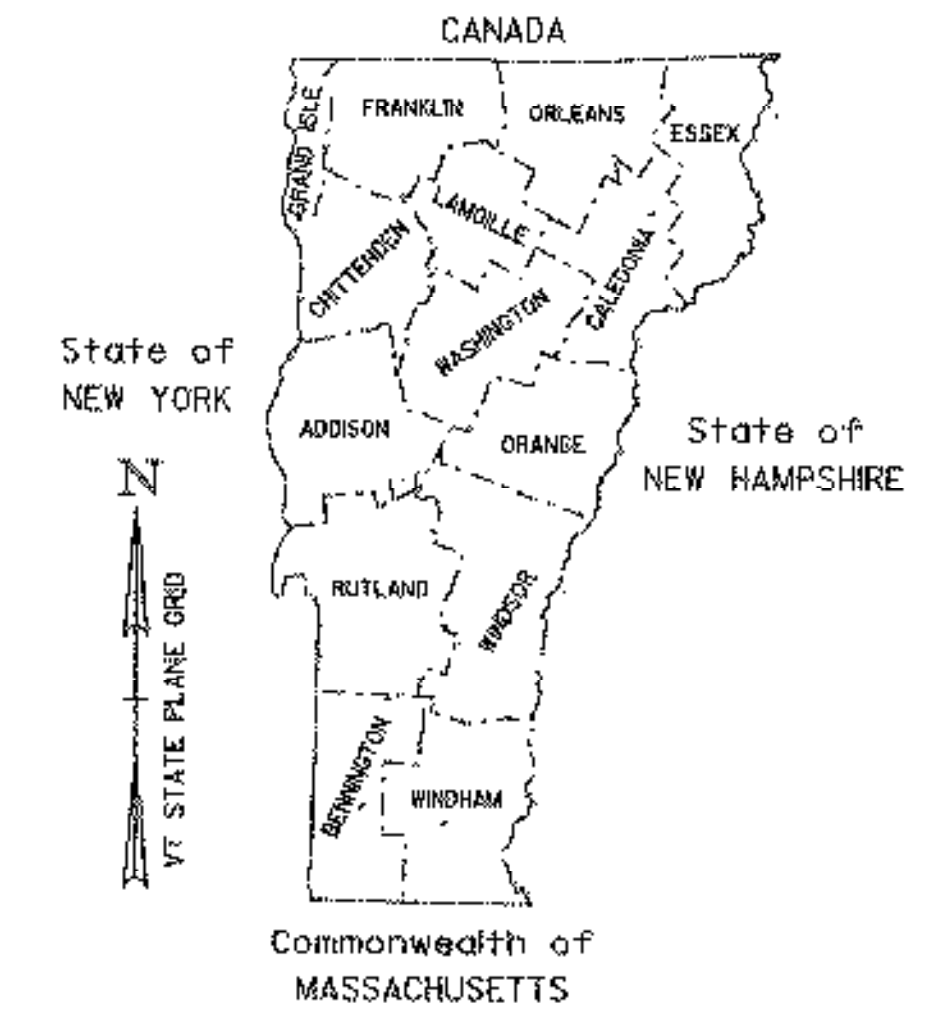

**CONVENTIONAL SIGNS**

COUNTY LINE	----
TOWN LINE	-----
LIMITS OF ACCESS	○-----○
POINT OF ACCESS	○-----○ X
FENCE LINE	—x—x—x—
STONE WALL	○○○○○○○○○○
TRAVELED WAY	-----
GUARD RAIL	○-○-○-○-○-○
RAILROAD	+++++
SURVEY LINE	++
CULVERT	-----
POWER POLE	⊕
TELEPHONE POLE	⊕
TREES	⊗ ⊗
CONTROL OF ACCESS	///
PROPERTY LINE	----
R.O.W. TAKING LINE	----- SR
SLOPE RIGHTS	○-----△
TOP OF CUT	△-----△
TOE OF SLOPE	○-----○

**DATUM**

VERTICAL	N/A
HORIZONTAL	N/A

**RECORD PLANS**

CONTRACTOR: PIKE INDUSTRIES - BERLIN, VT.

RESIDENT ENGINEER: C. BARKER

CONSTRUCTION BEGAN: SEPTEMBER 6, 2005

CONSTRUCTION COMPLETE:

RECORD PLANS BY: C. BARKER, E. POSTER

I HEREBY CERTIFY THAT ALL THE CONSTRUCTION REQUIRED BY THIS SET OF DRAWINGS HAS BEEN ACCOMPLISHED AS INDICATED HEREIN.

BY: *[Signature]* RESIDENT ENGINEER

DATE: 01/23/06

NOTE: Any further information concerning final quantities, amounts or other details relative to this project may be found at Central Files in the electronic archives.

THESE PLANS ARE SUBJECT TO SUCH ENGINEERING CHANGES AS MAY BE REQUIRED BY THE FEDERAL HIGHWAY ADMINISTRATION OR THE DIRECTOR OF PROGRAM DEVELOPMENT. CONSTRUCTION IS TO BE CARRIED ON IN ACCORDANCE WITH THESE PLANS AND THE STANDARD SPECIFICATIONS FOR CONSTRUCTION DATED 2001, AS APPROVED BY THE FEDERAL HIGHWAY ADMINISTRATION ON JANUARY 4, 2001 FOR USE ON THIS PROJECT, INCLUDING ALL SUBSEQUENT REVISIONS AND SUCH REVISED SPECIFICATIONS AND SPECIAL PROVISIONS AS ARE INCORPORATED IN THESE PLANS.

APPROVED *[Signature]* DATE 5-18-06  
DIRECTOR OF PROGRAM DEVELOPMENT

DEPARTMENT OF TRANSPORTATION  
FEDERAL HIGHWAY ADMINISTRATION

APPROVED *[Signature]* DATE 5-27-05  
DIVISION ADMINISTRATOR

PROJECT STATEWIDE  
AC IM RUTF(11)

SHEET 1 OF 7 SHEETS