

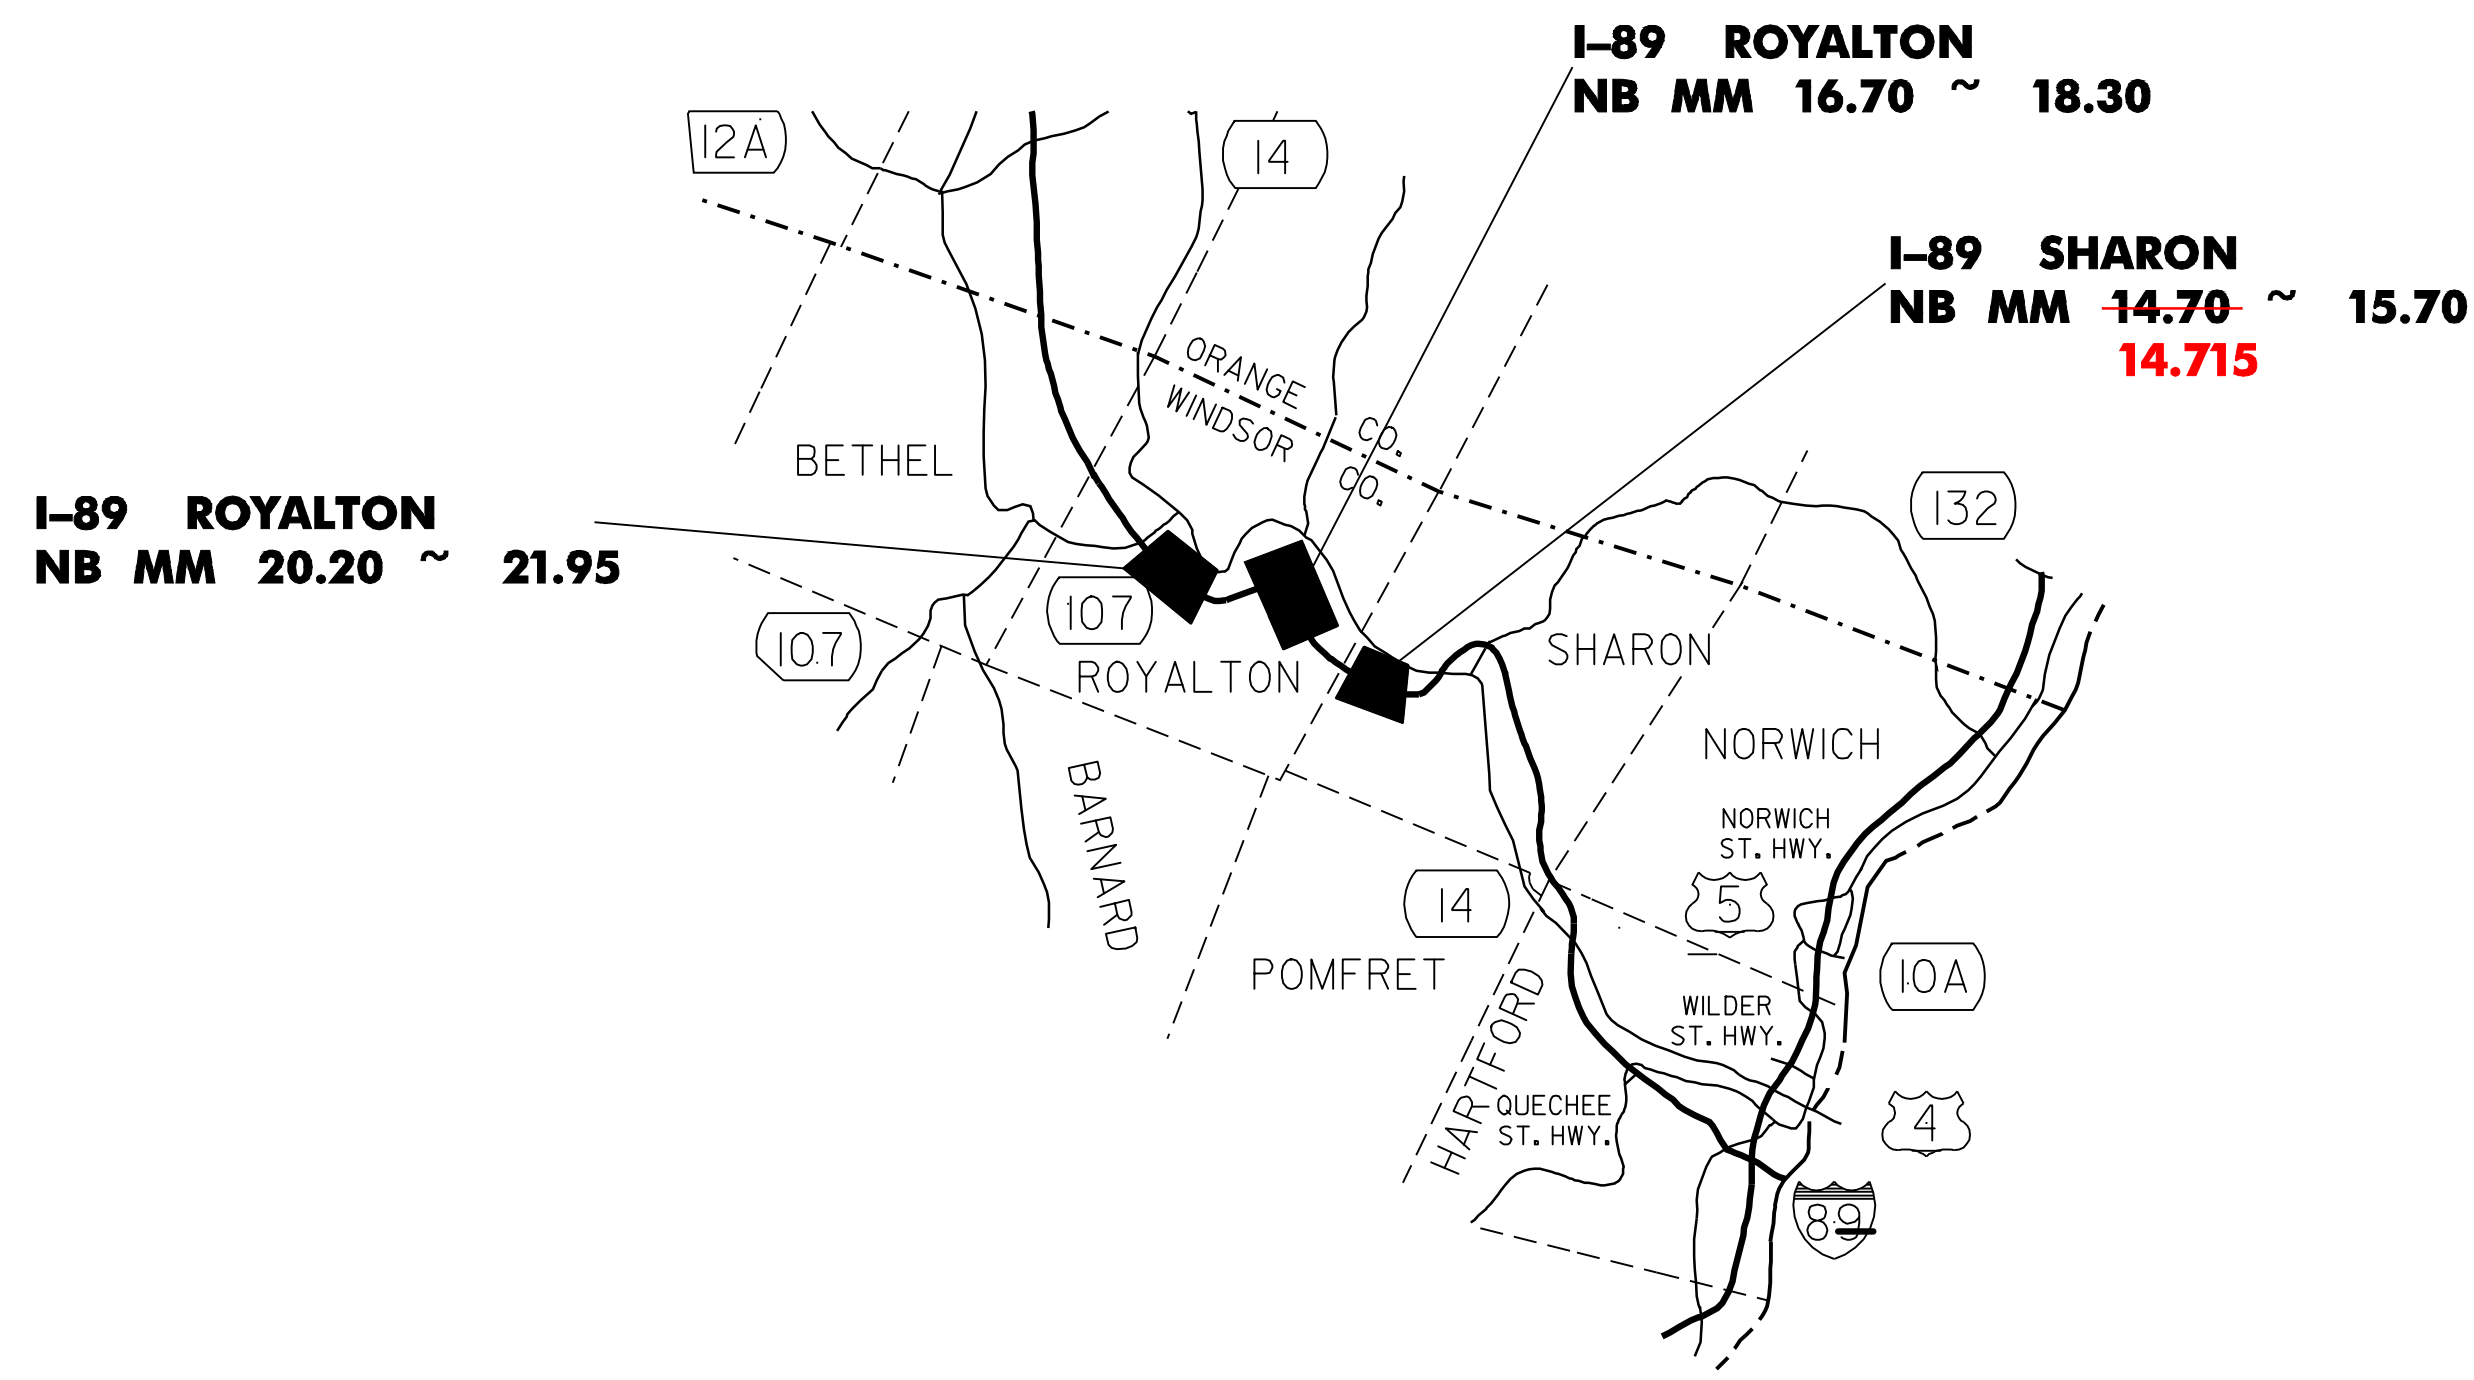
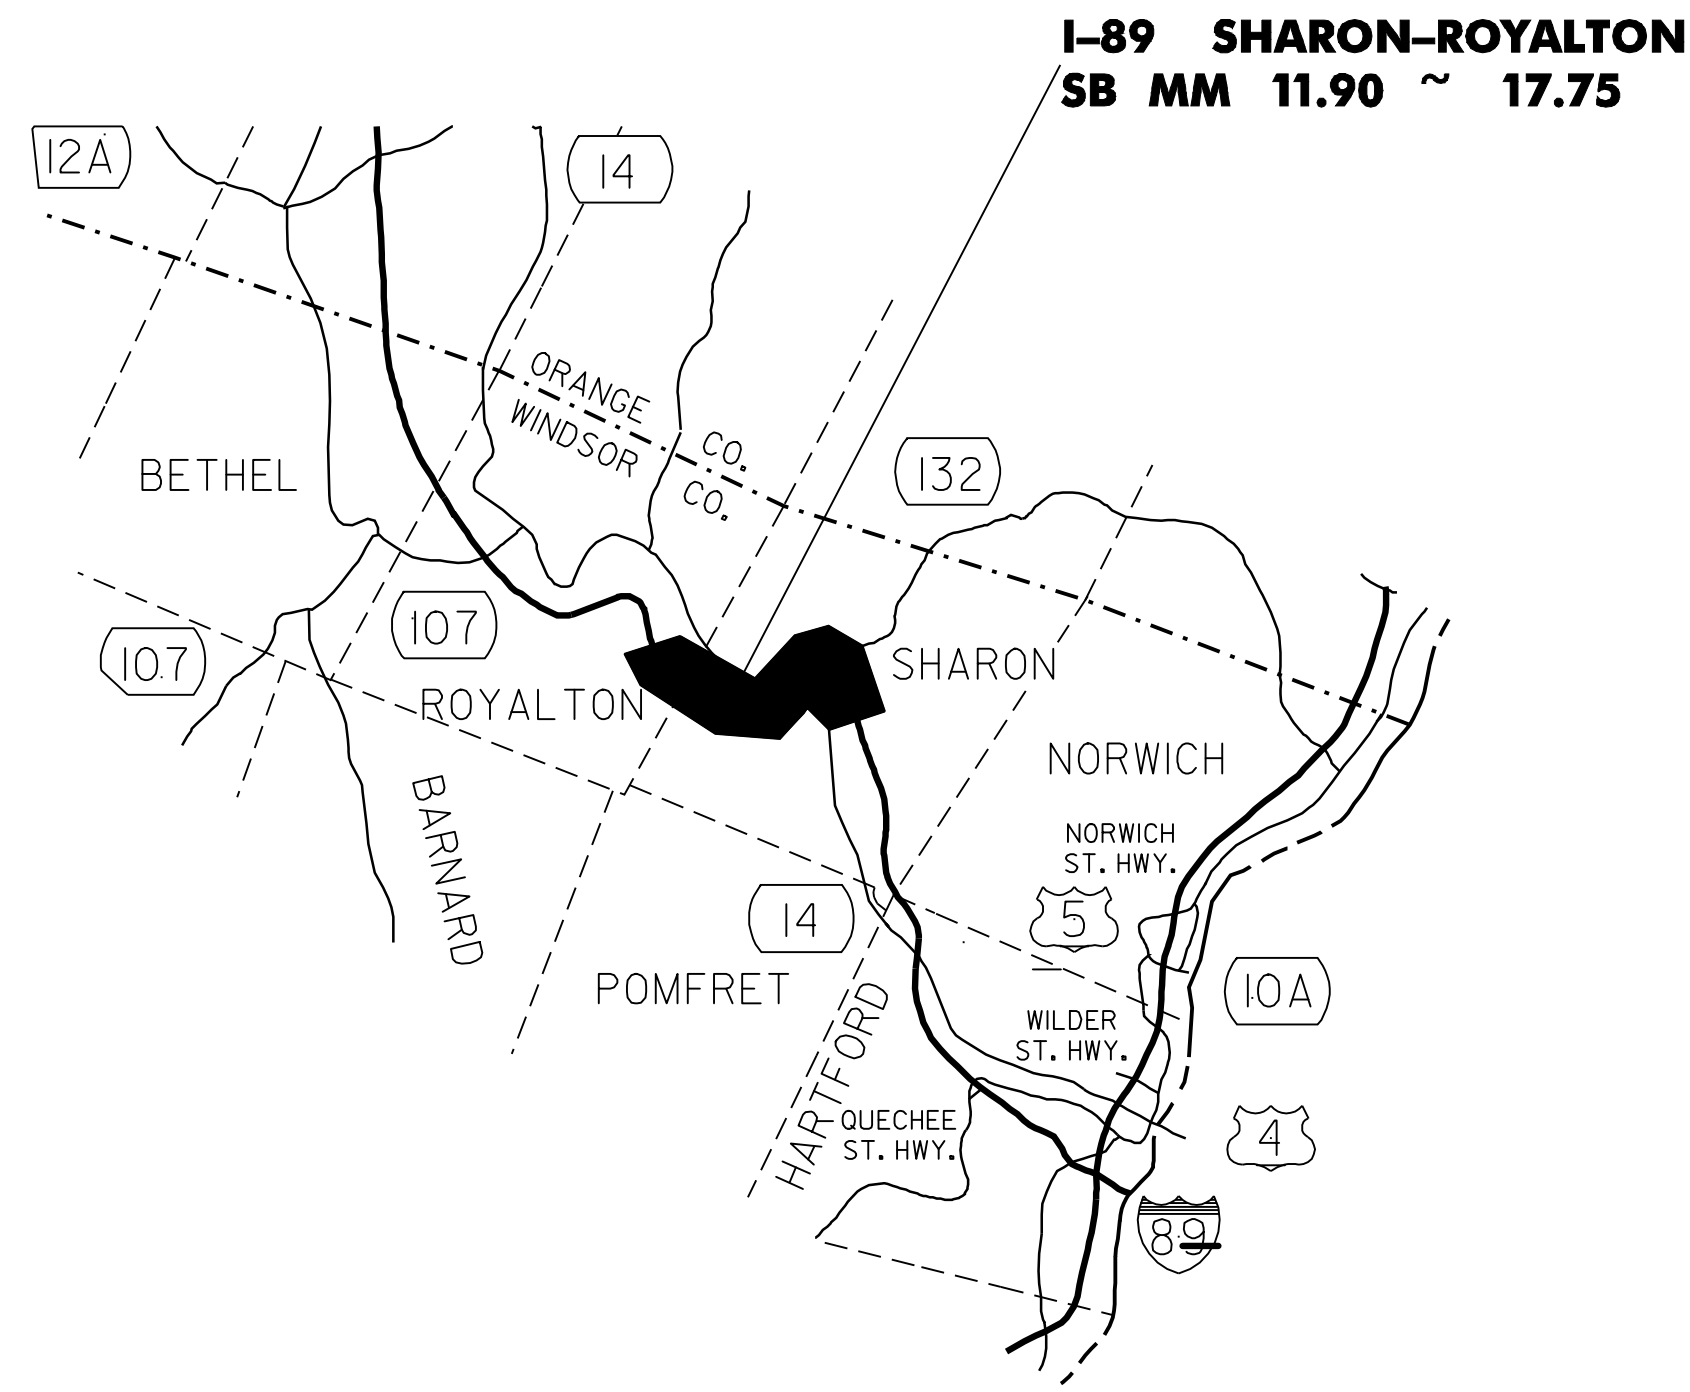
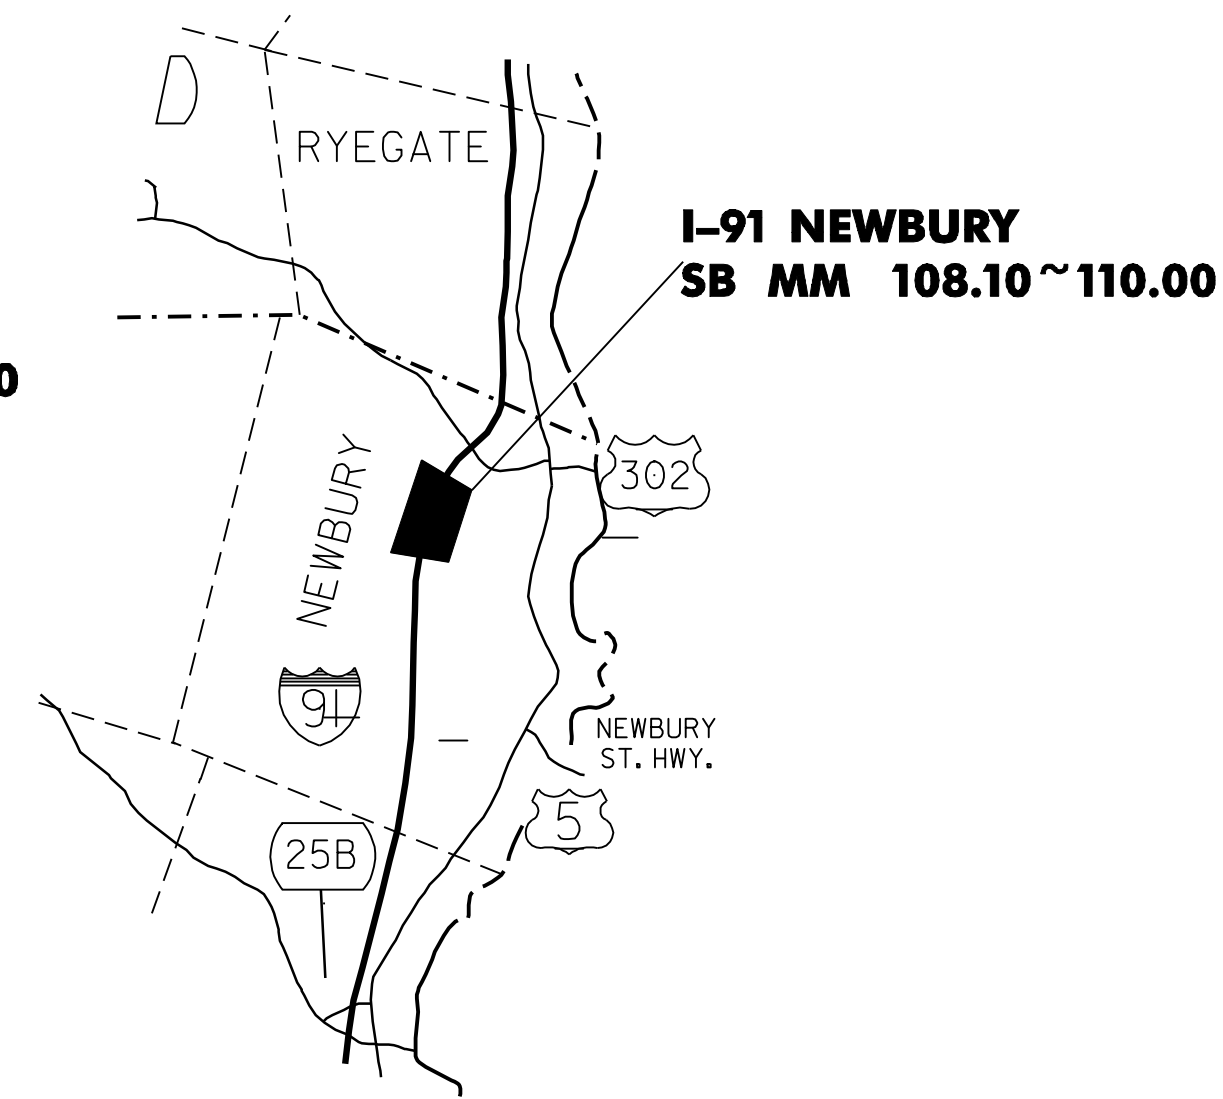


I-89 RUTFILL LOCATIONS

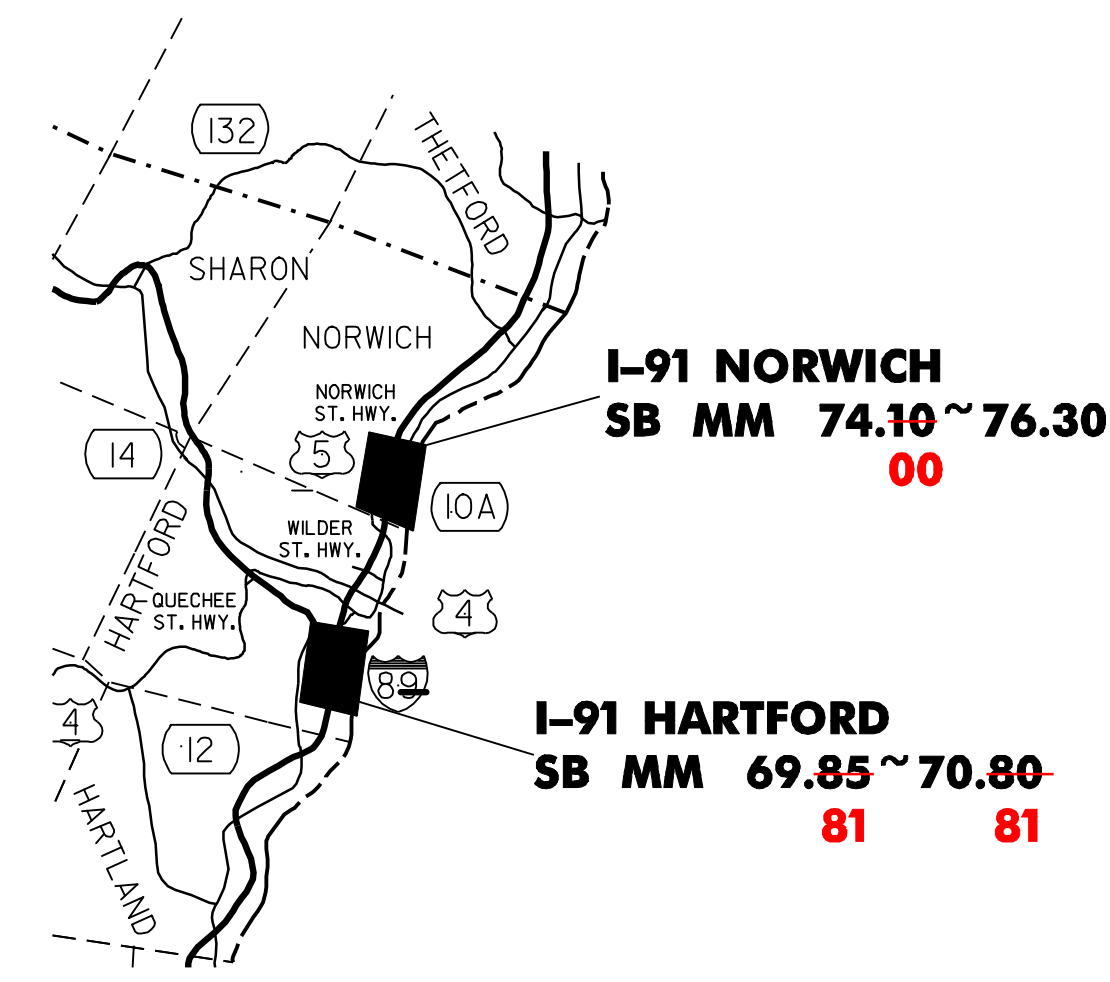

I-91 RUTFILL LOCATIONS

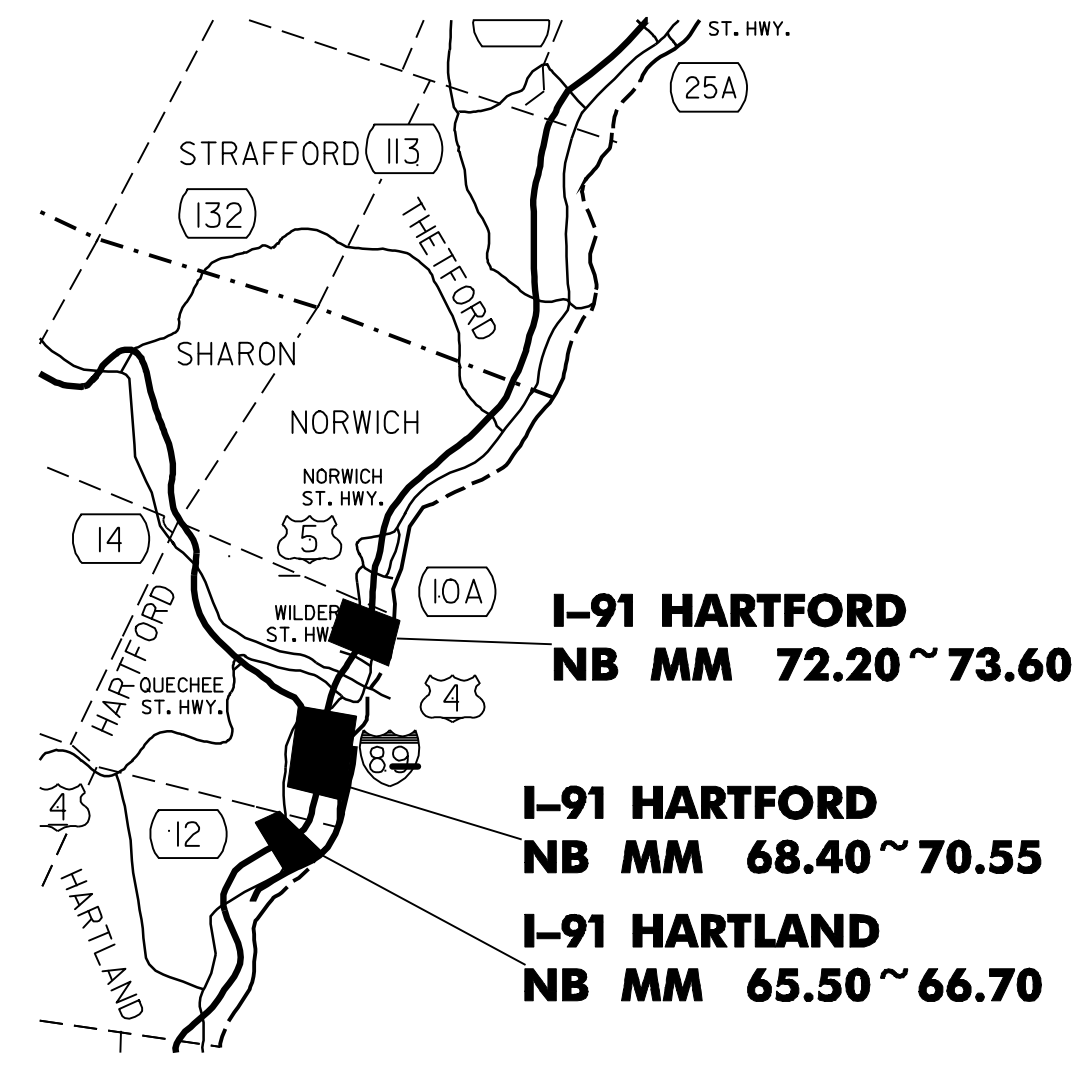

ROUTE	TOWN BEGINNING	MM BEGINNING	TOWN END	MM ENDING	LENGTH (MILES)	LENGTH (FT)	REMARKS
I-89 NB	SHARON	14.70 715	SHARON	15.70	1.00	5 280	MILL 1.25 in, PAVE
	ROYALTON	16.70 45	ROYALTON	18.30	1.60	8 448	MILL 1.25 in, PAVE
	ROYALTON	20.20	ROYALTON	21.95	1.75	9 240	MILL 1.25 in, PAVE
I-89 SB	SHARON	11.90	ROYALTON	17.75	5.85	30 888	MILL 1.25 in, PAVE
I-91 NB	HARTLAND	65.50	HARTLAND	66.70	1.20	6 336	MILL 1.25 in, PAVE
	HARTFORD	68.40	HARTFORD	70.55	2.15	11 352	MILL 1.25 in, PAVE
	HARTFORD	72.20	HARTFORD	73.60	1.40	7 392	MILL 1.25 in, PAVE
I-91 SB	HARTFORD	69.85 81	HARTFORD	70.80 81	0.95	5 016	MILL 1.25 in, PAVE
	NORWICH	74.10 00	NORWICH	76.30	2.20	11 616	MILL 1.25 in, PAVE
	NEWBURY	108.10	NEWBURY	110.00	1.90	10 032	MILL 1.25 in, PAVE
				TOTAL	20.00	105 600	

PROJECT LOCATION SHEET

PROJECT NAME: STATEWIDE
 PROJECT NUMBER: AC_IM_RUTF(II)
 FILE NAME: Z:\pave\05k062\pk062.dgn
 PROJECT LEADER: WOOLAVER
 DESIGNED BY: JLR
 PLOT DATE: 30-JAN-2006 15:00
 DRAWN BY: JLR
 CHECKED BY: JLR
 SHEET 4 OF 7