

CABLE GUARD RAIL (MOD. - BRIFEN WRSF SOCKETED POST)

2985+84 ~ 2987+42 LT (TRANSITION)

2987+42 ~ 3000+36 LT (STANDARD)

3000+36 ~ 3001+93 LT (TRANSITION)


MANUFACTURED TERMINAL SECTION (MOD. - BRIFEN WRGT)

2985+59 ~ 2985+84 LT

3001+93 ~ 3002+18 LT

SUPPLEMENTAL AGREEMENT (ITEM 203.30, EARTH BORROW)

2985+59 LT

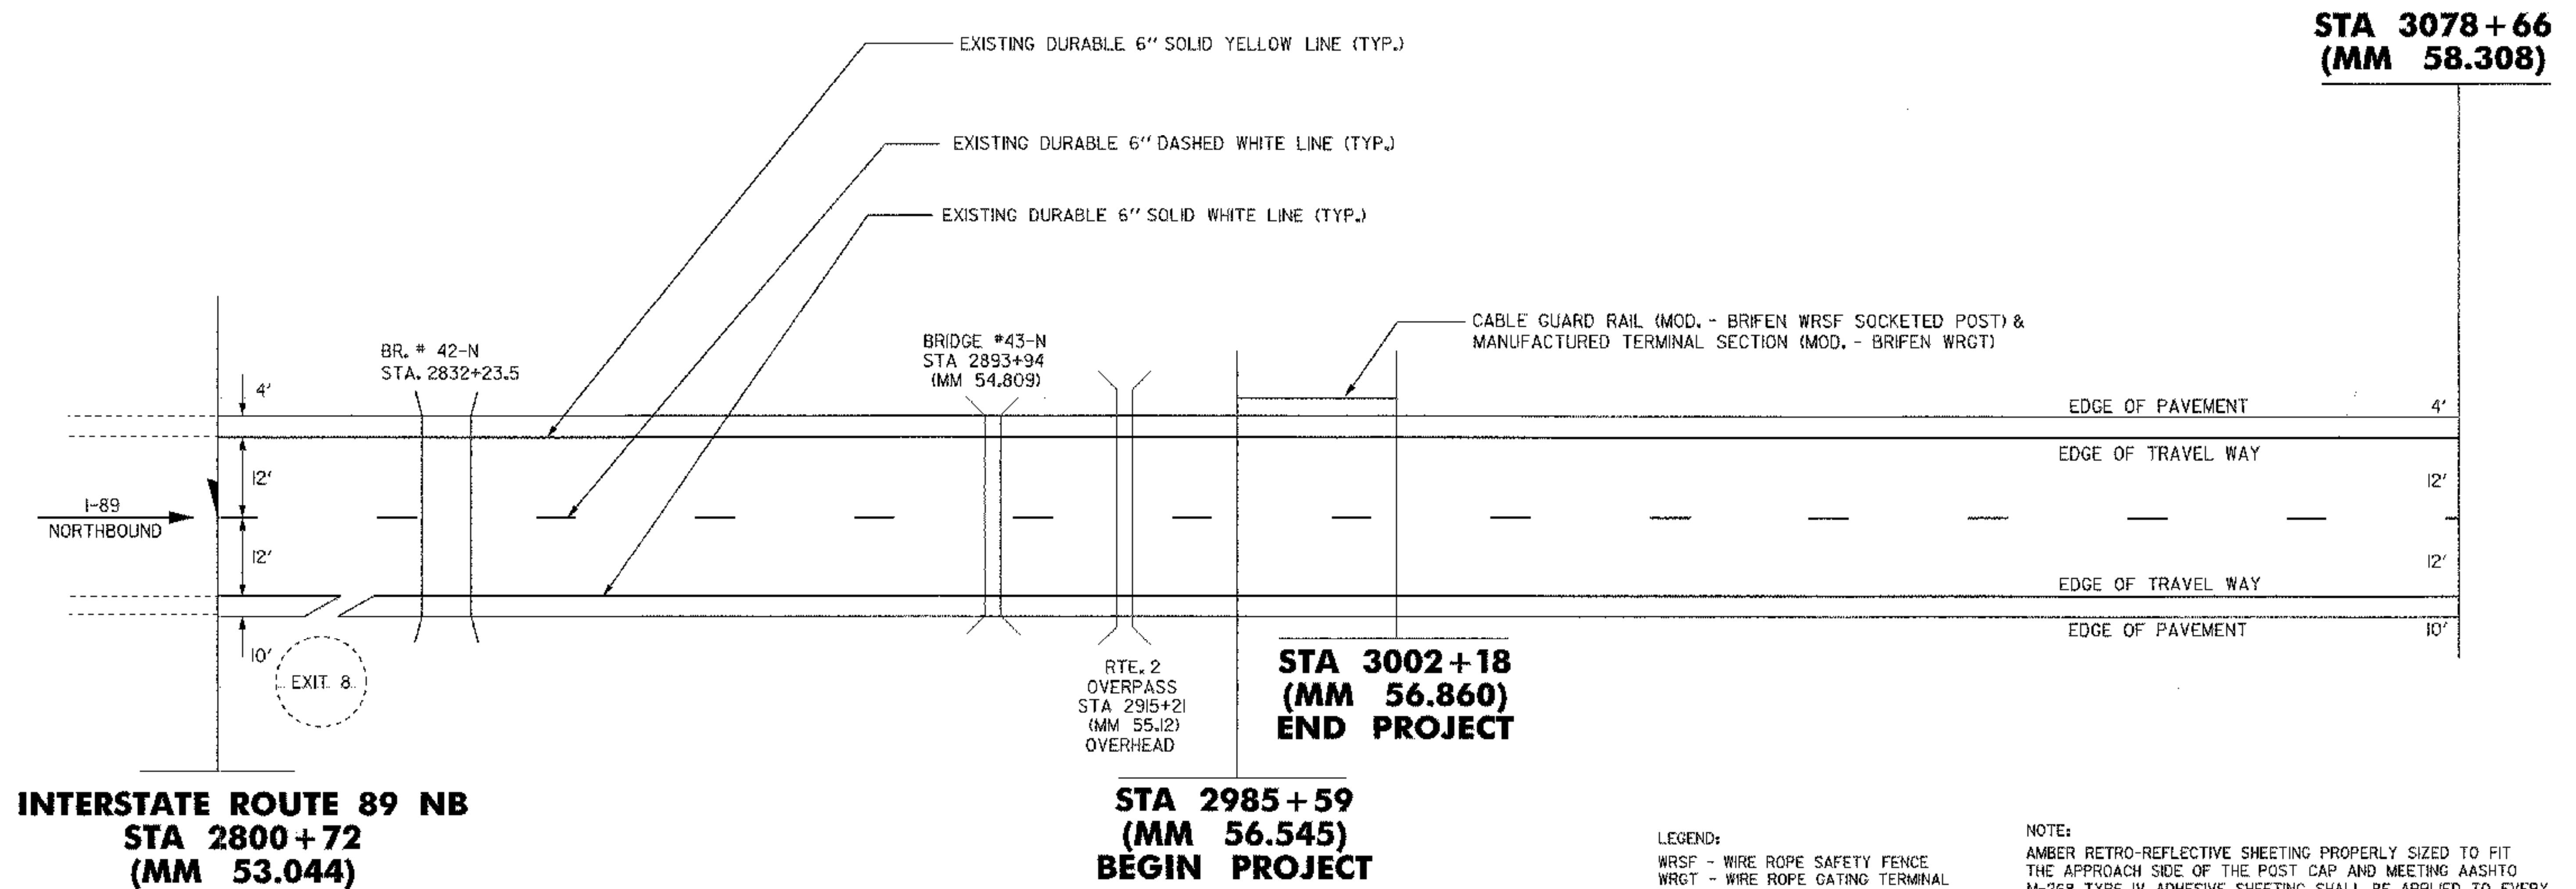

**INTERSTATE ROUTE 89 NB**  
**STA 2800+72**  
**(MM 53.044)**

**STA 2985+59**  
**(MM 56.545)**  
**BEGIN PROJECT**

**STA 3002+18**  
**(MM 56.860)**  
**END PROJECT**

**STA 3078+66**  
**(MM 58.308)**

LEGEND:  
WRSF - WIRE ROPE SAFETY FENCE  
WRGT - WIRE ROPE GATING TERMINAL  
LON - LENGTH OF NEED

NOTE:  
AMBER RETRO-REFLECTIVE SHEETING PROPERLY SIZED TO FIT THE APPROACH SIDE OF THE POST CAP AND MEETING AASHTO M-268 TYPE IV ADHESIVE SHEETING SHALL BE APPLIED TO EVERY THIRD POST. THE MINIMUM SIZE SHALL BE 7.875 / SQ. IN. SHEETING TO BE APPLIED ONLY TO THE TRAFFIC APPROACH SIDE.

NOT TO SCALE

**LAYOUT SHEET**

|                                      |                        |
|--------------------------------------|------------------------|
| PROJECT NAME:                        | STATEWIDE              |
| PROJECT NUMBER:                      | STP CARD(I)            |
| FILE NAME:                           | PLOT DATE: 13-FEB-2006 |
| PROJECT LEADER: MARIO DUPIGNY-GIROUX | DRAWN BY: BRM          |
| DESIGNED BY: MARIO DUPIGNY-GIROUX    | CHECKED BY: AJB        |
| IPARM NAME: brifentl                 | SHEET 4 OF 9           |