




**INTERSTATE 91 SB
BEGIN AC IM 091-2(76)**

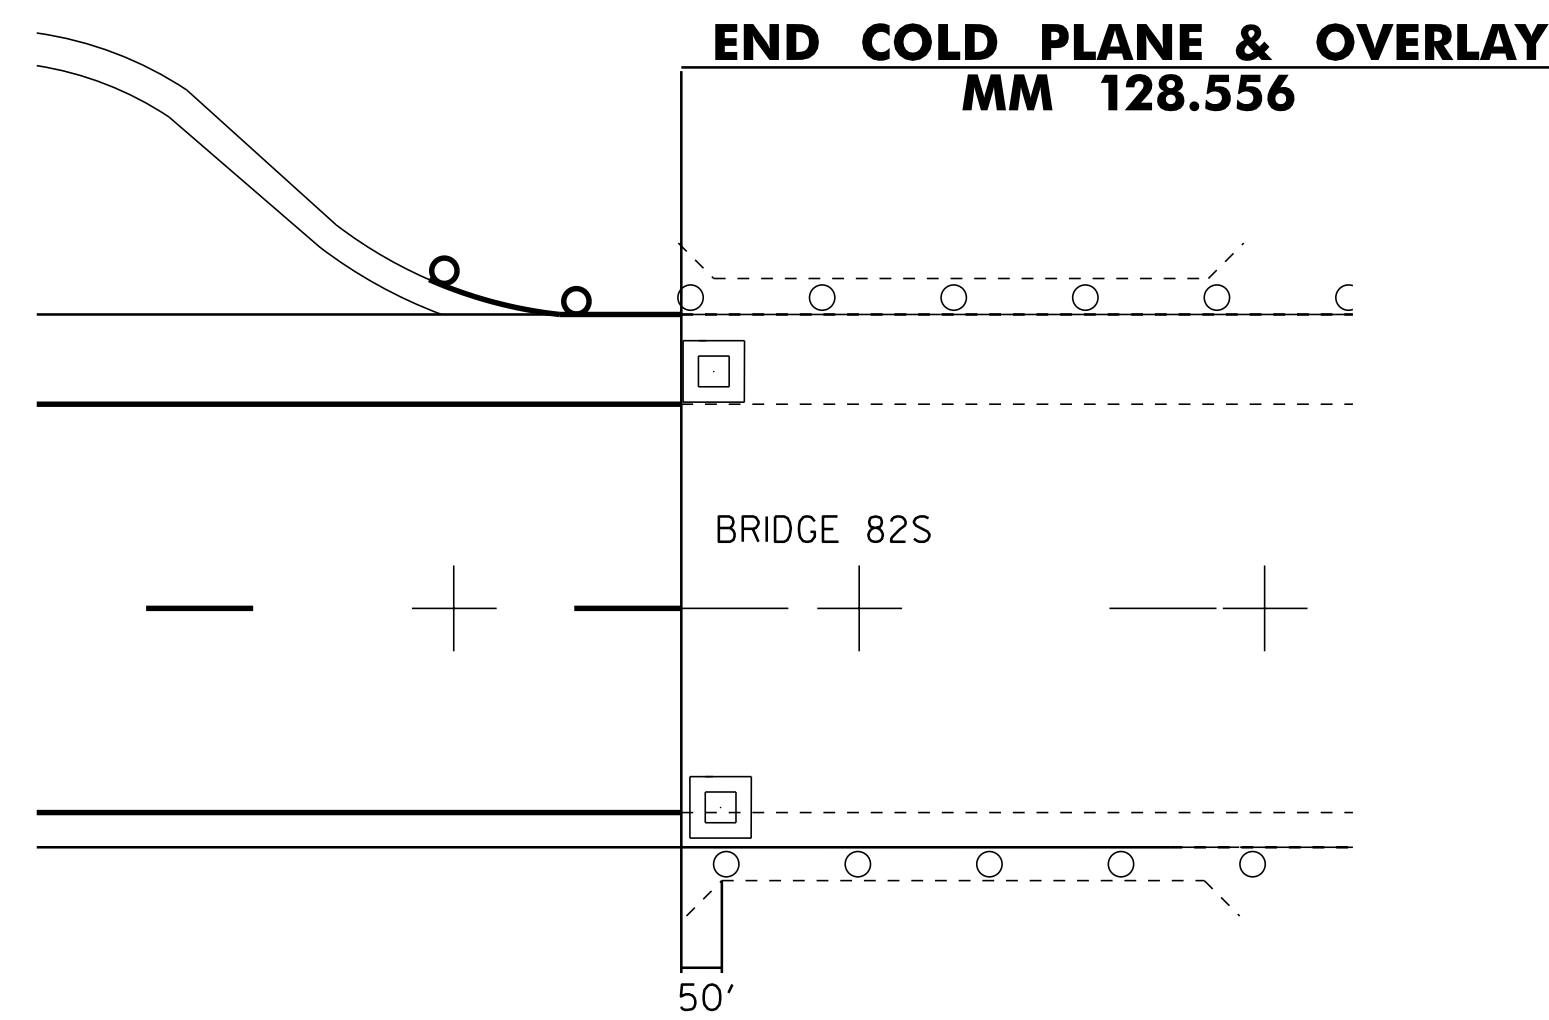


**INTERSTATE 91 SB
END AC IM 091-2(76)**

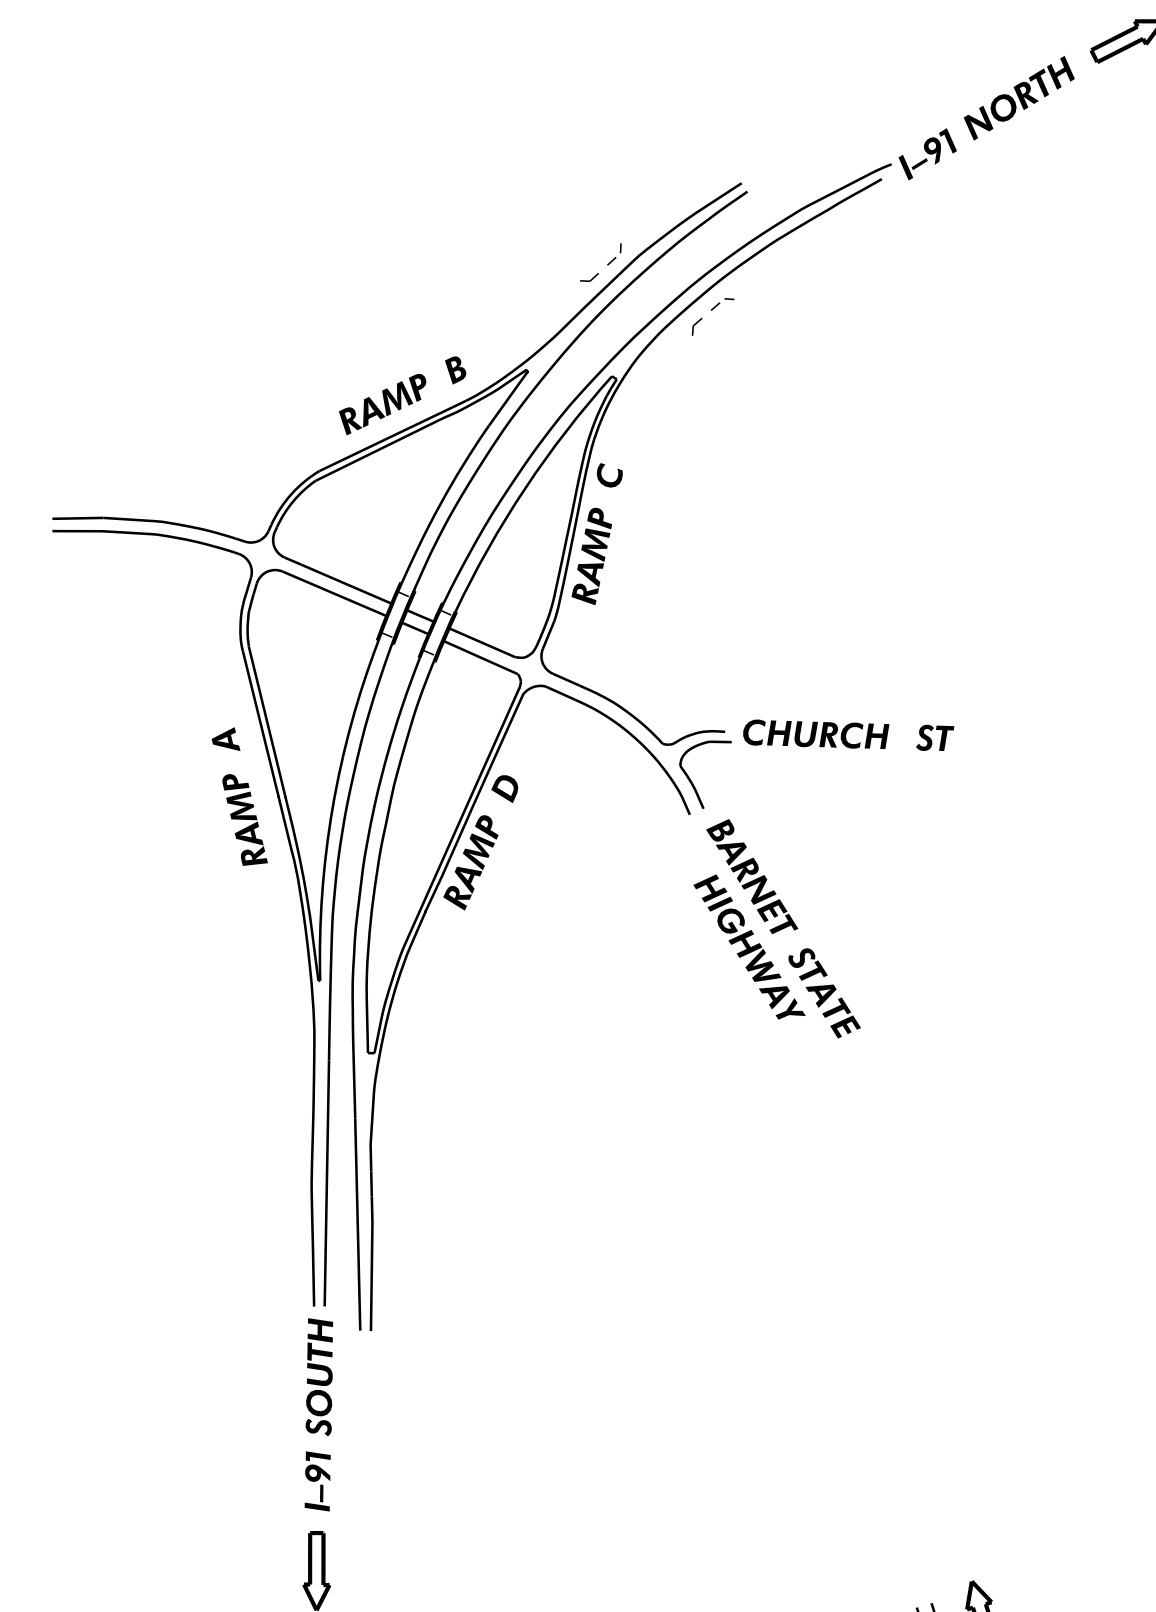


EXIT 18 LAYOUT

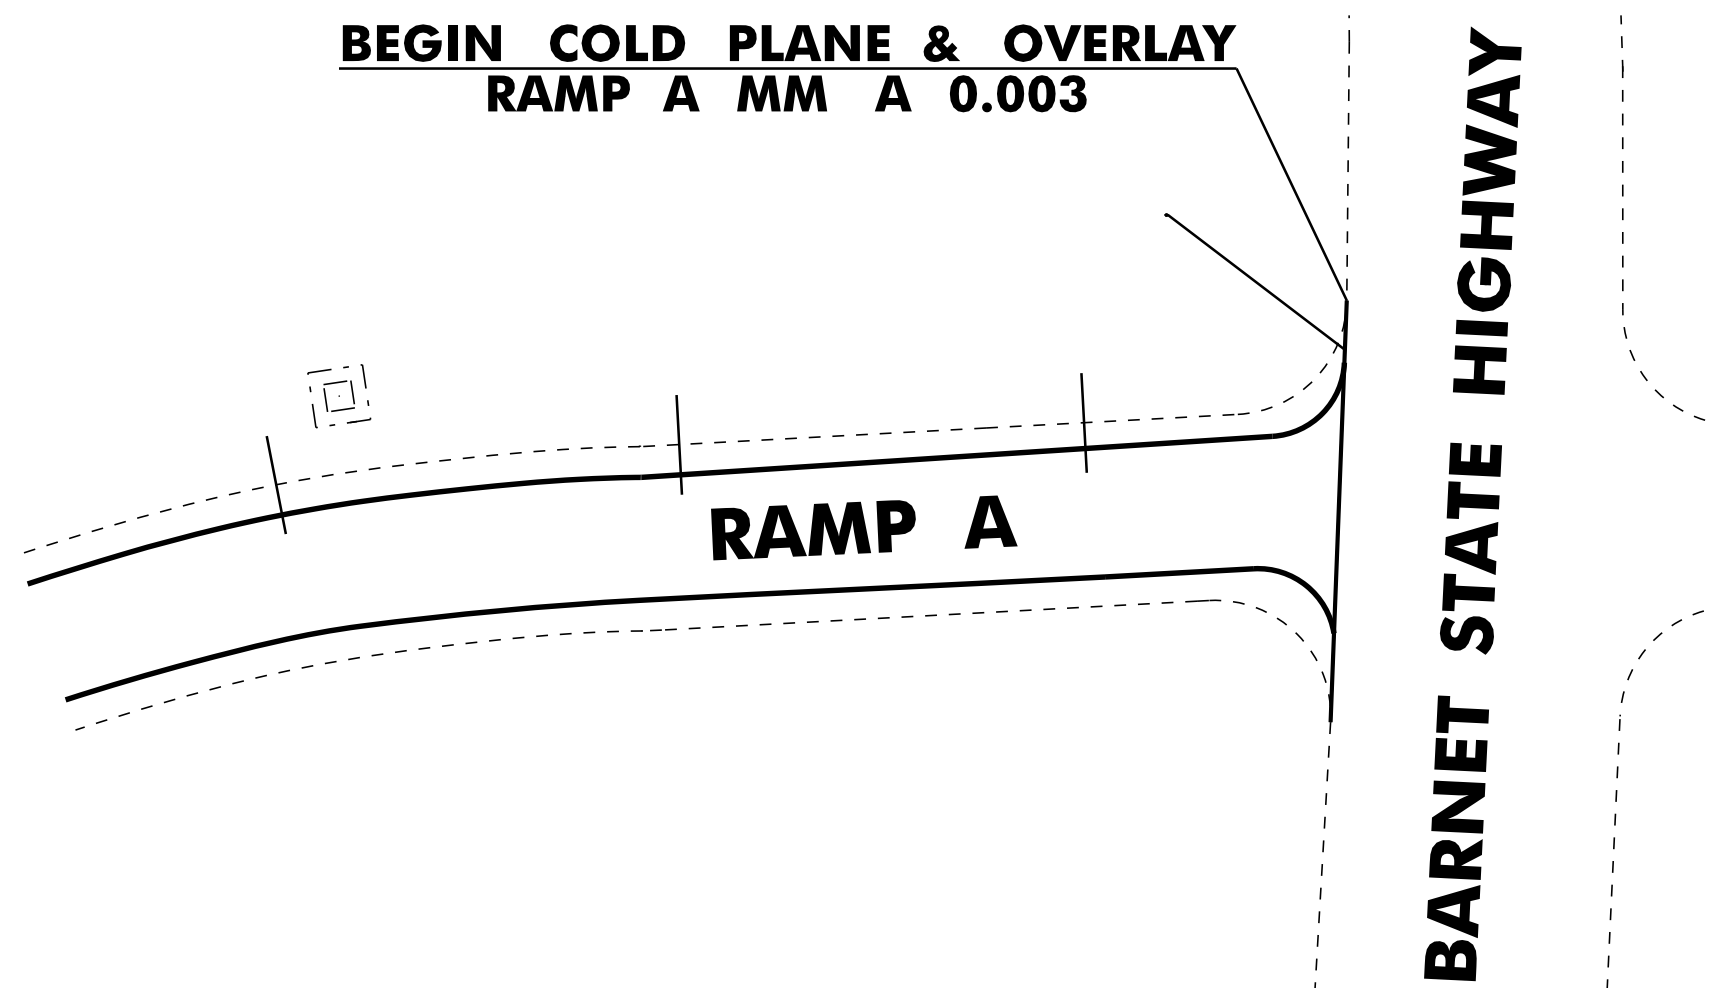


**EXIT 18 - RAMP A
SOUTHBOUND ON RAMP**

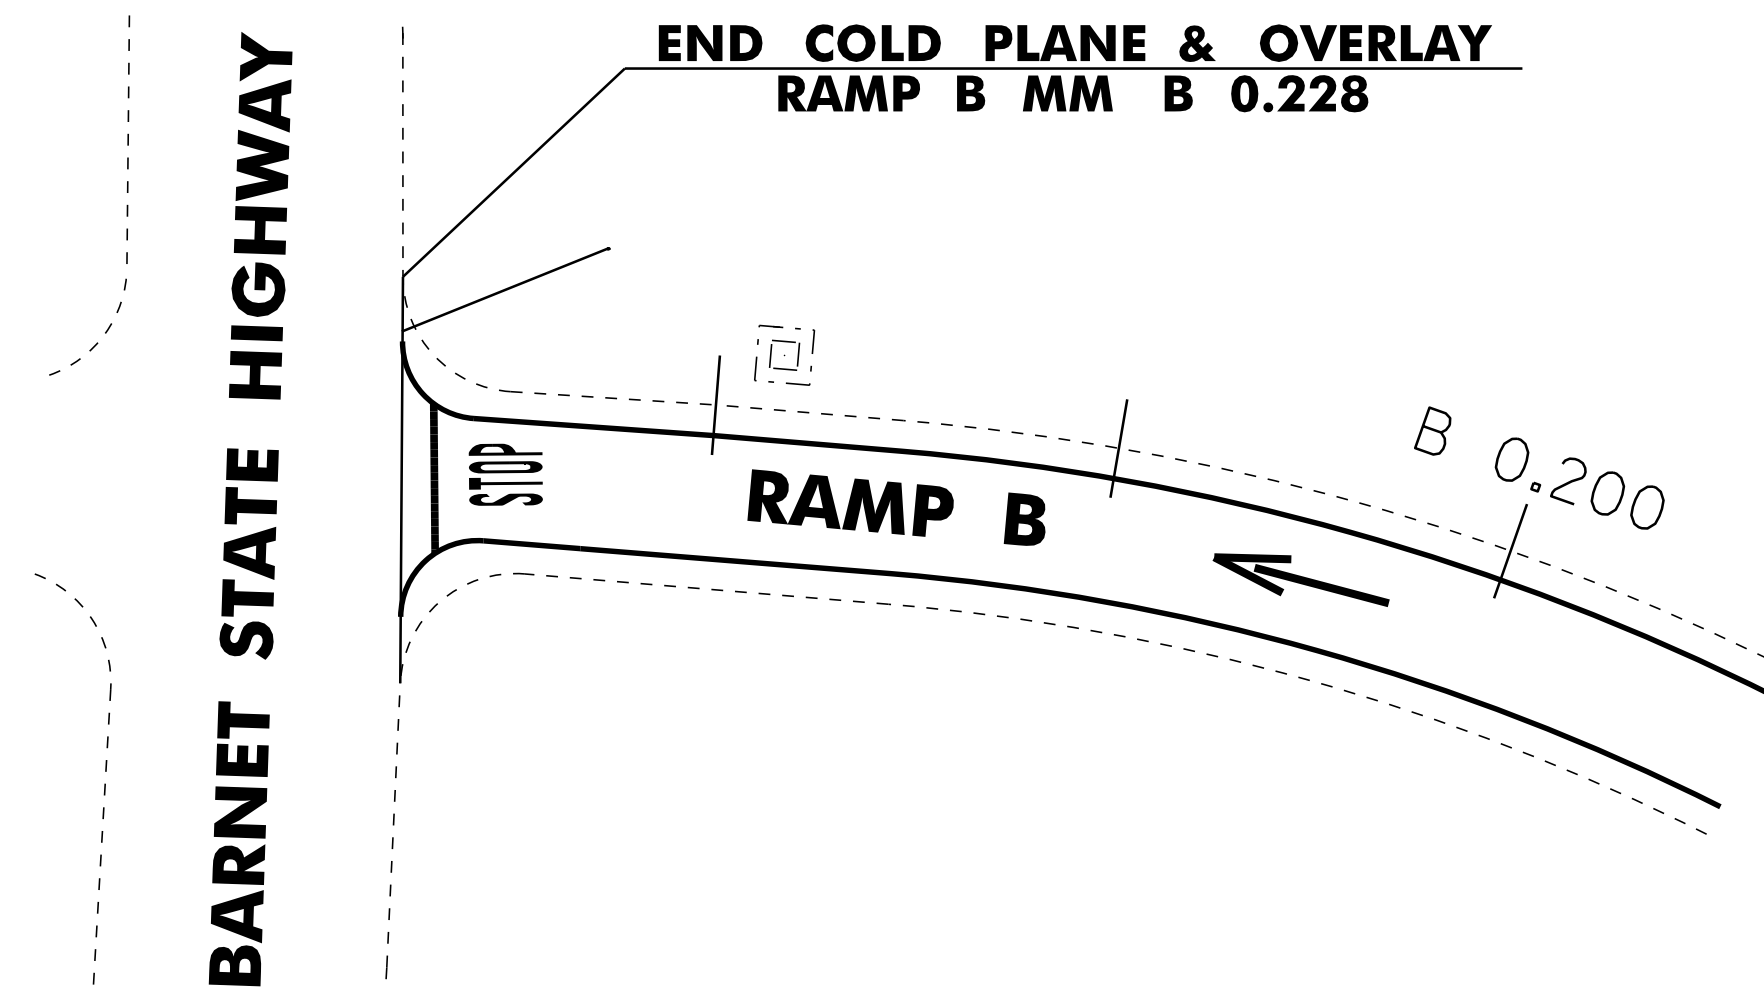


**EXIT 18 - RAMP B
SOUTHBOUND OFF RAMP**

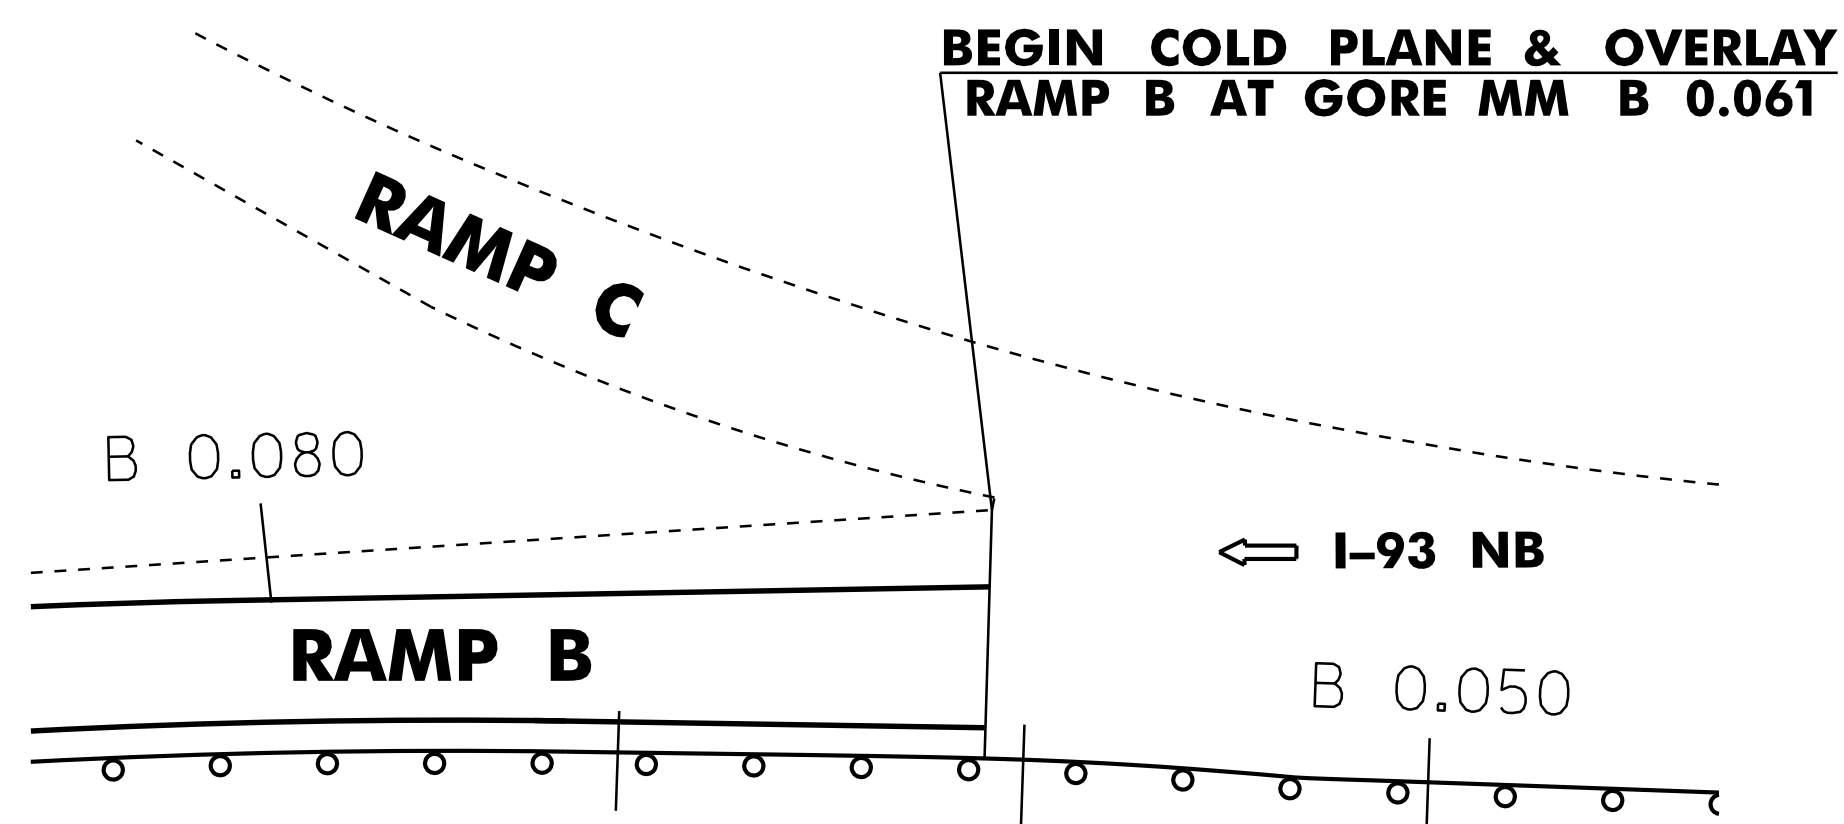

**EXIT 19 - RAMP B
SOUTHBOUND ON RAMP**

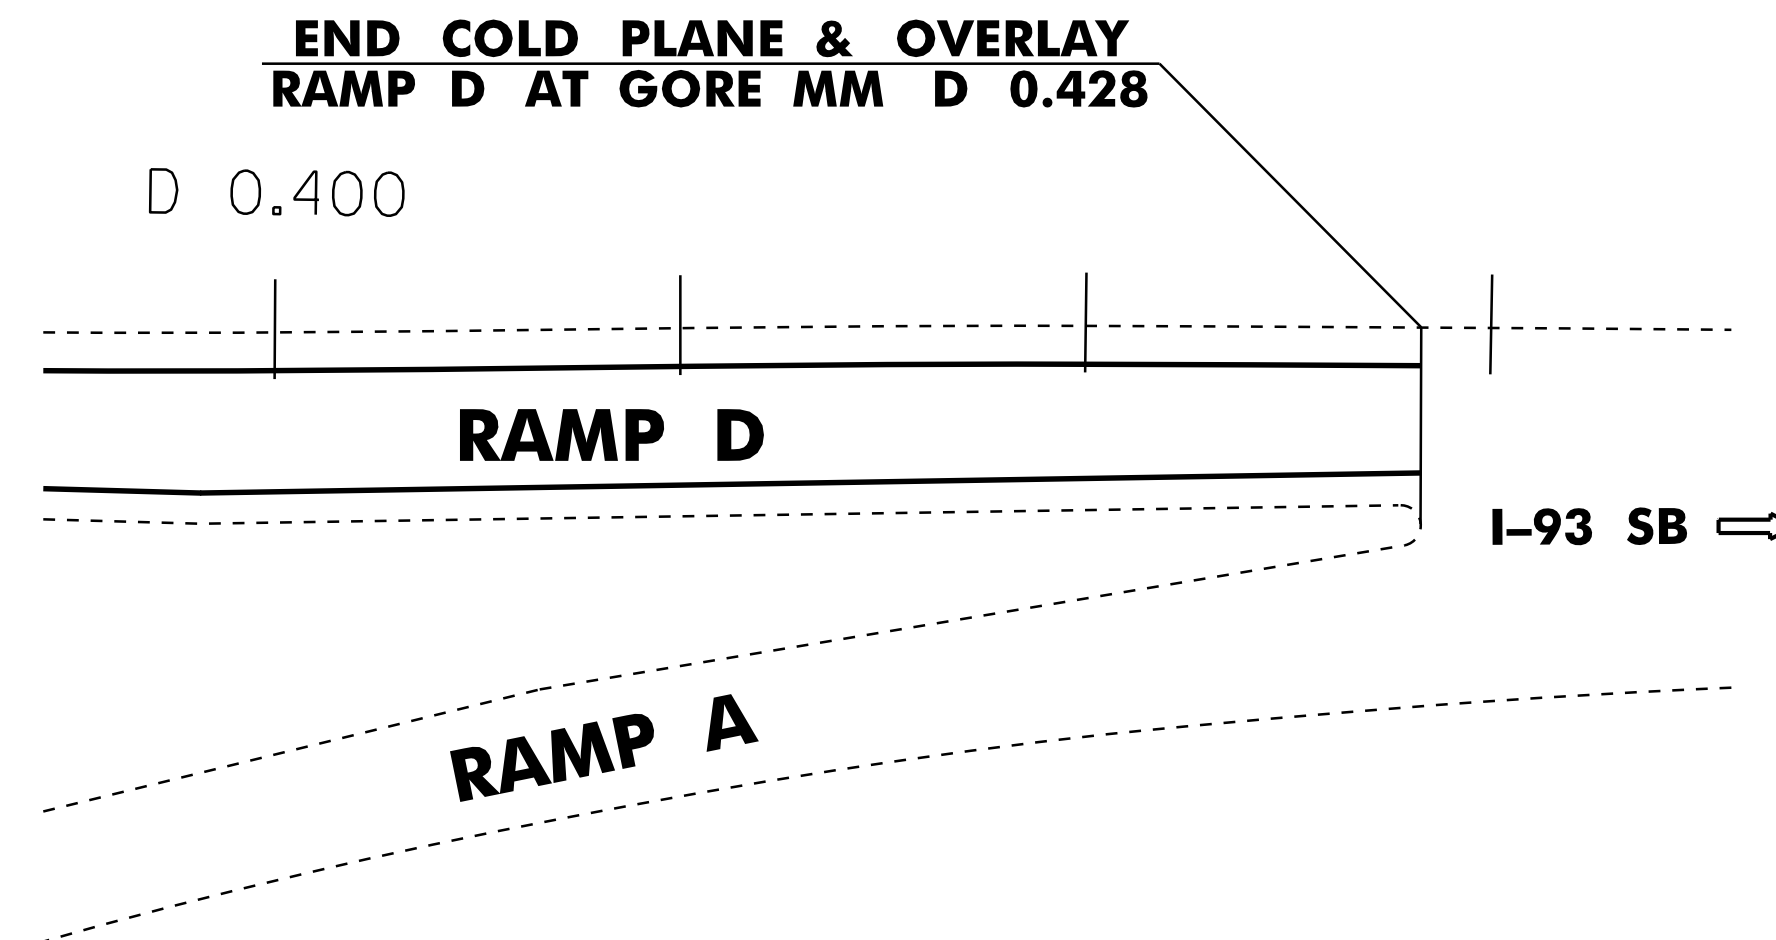

**EXIT 19 - RAMP D
SOUTHBOUND OFF RAMP**

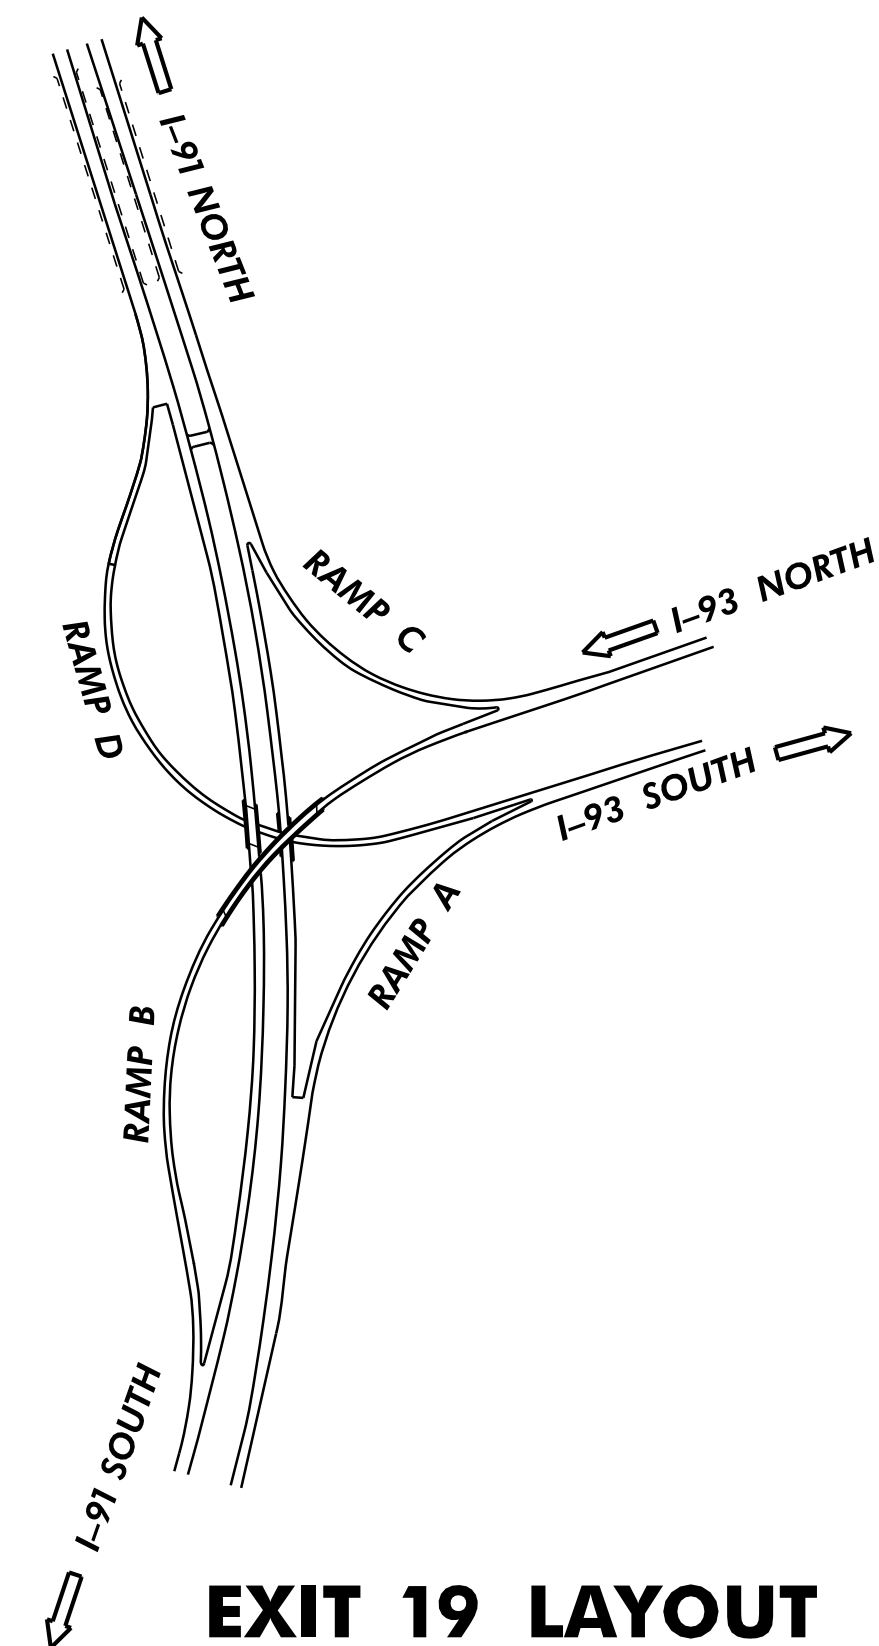

EXIT 19 LAYOUT

TIE SHEET

PROJECT NAME: NEWBURY-ST. JOHNSBURY
PROJECT NUMBER: AC IM 091-2(76)

FILE NAME: 06a046
PROJECT LEADER: PTS
DESIGNED BY: NULL
IPARM FILE NAME: 06A046_03

PLOT DATE: 29-JUL-2014 16:40
DRAWN BY: JLS
CHECKED BY: PTS
SHEET 3 OF 33

NOT TO SCALE