



GUARDRAIL TREATMENT - BRIDGE 71 S

NOTE

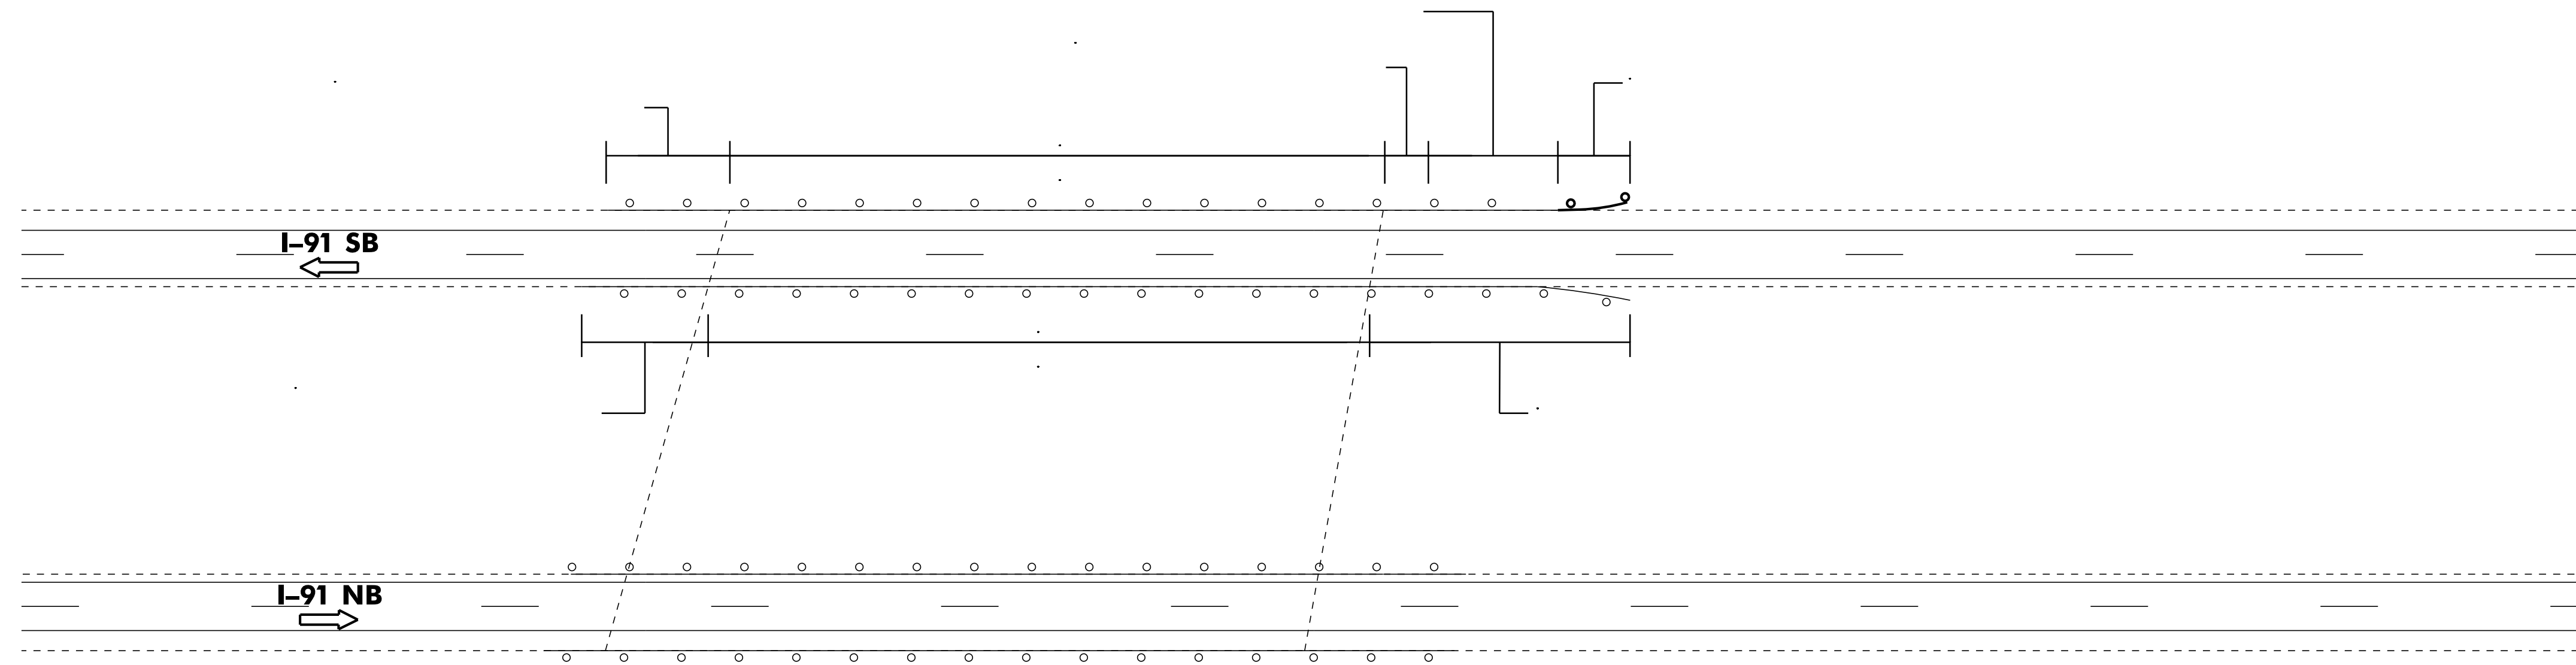

GUARDRAIL TREATMENT - BRIDGE 76 S

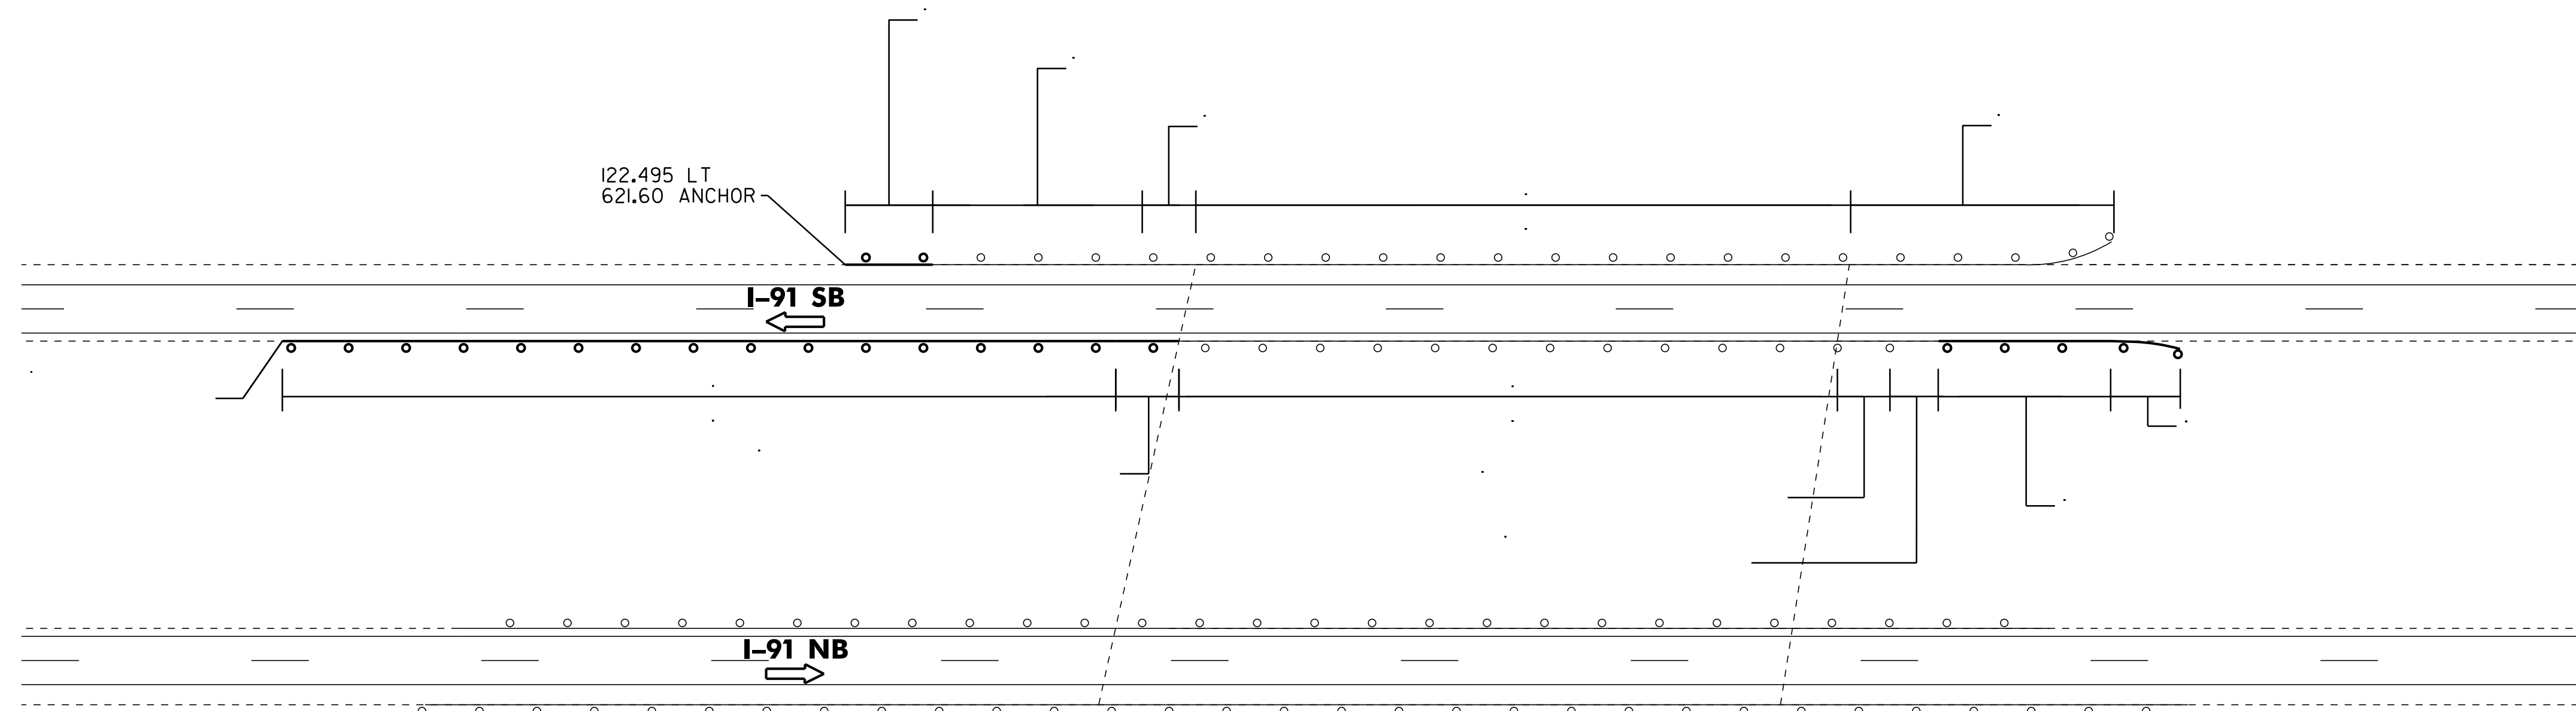

**BRIDGE /GUARDRAIL
TREATMENT DETAIL SHEET 2**

PROJECT NAME: NEWBURY-ST. JOHNSBURY	PLOT DATE: 29-JUL-2014 16:46
PROJECT NUMBER: AC IM 091-2(76)	DRAWN BY: JLS
FILE NAME: 06a046	CHECKED BY: PTS
DESIGNED BY: NULL	SHEET 17 OF 33
IPARM FILE NAME: 06A046_I7	

NOT TO SCALE