



**GUARDRAIL TREATMENT - BRIDGE 81 S**

**NOTE**

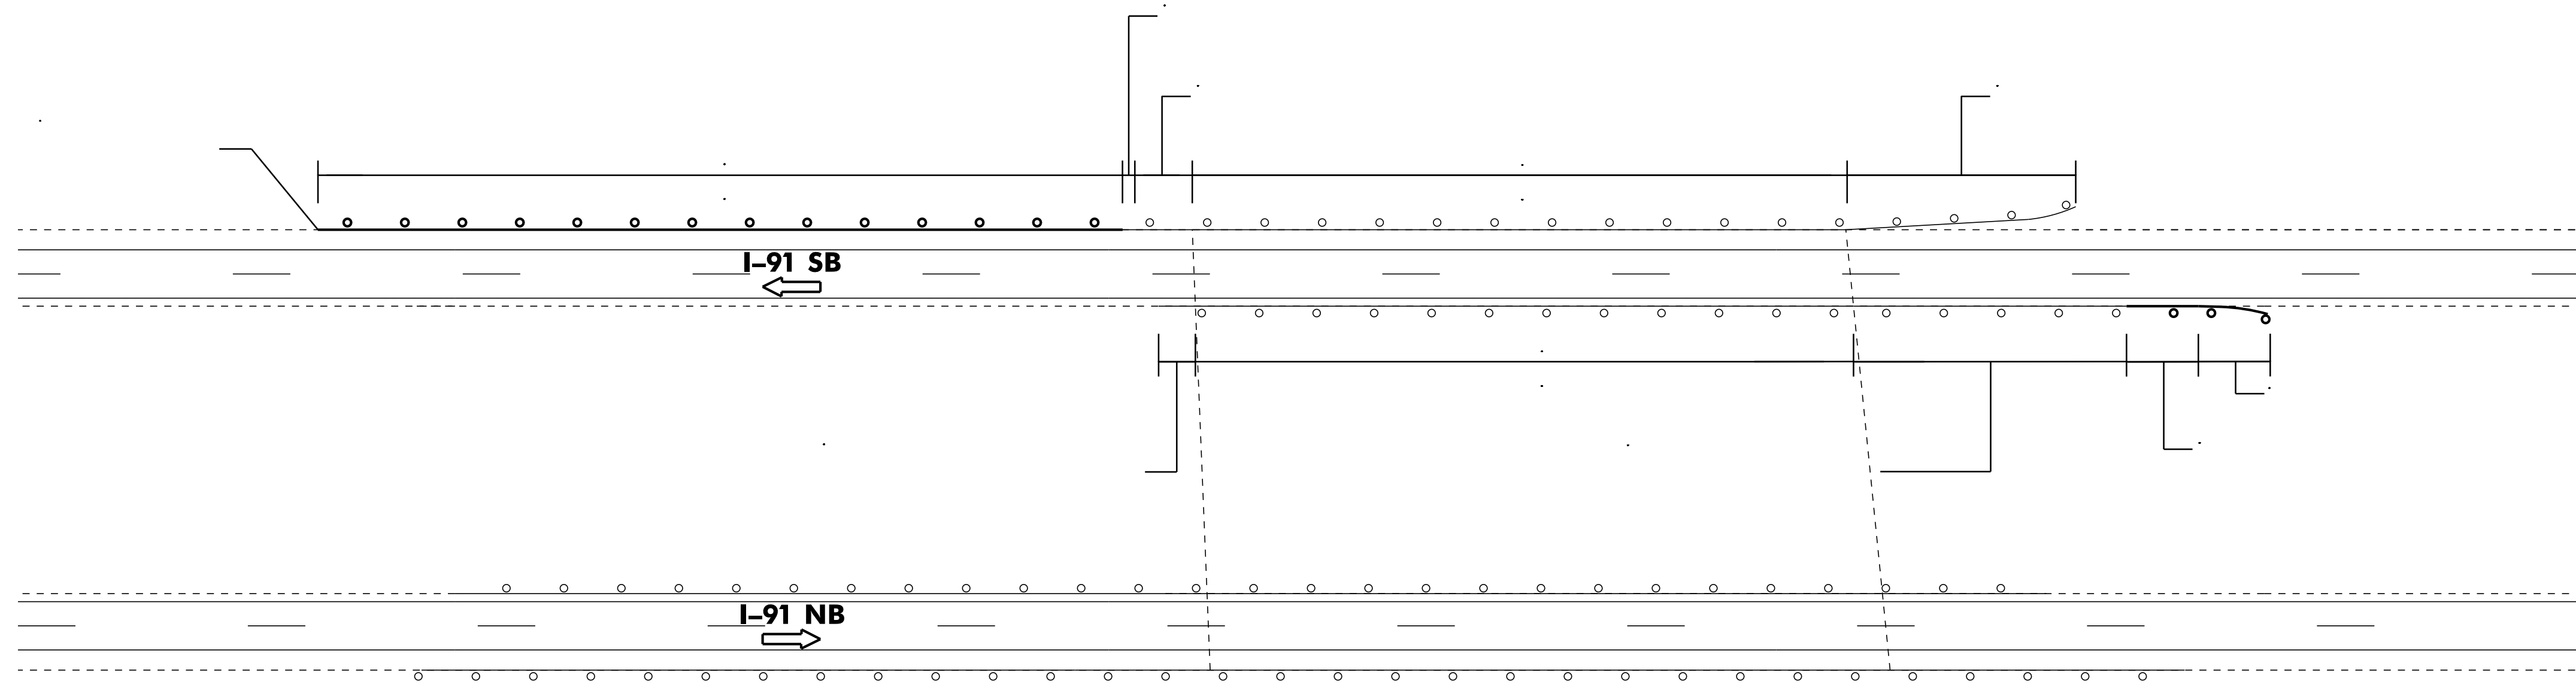

**GUARDRAIL TREATMENT - BRIDGE 81-B-1**

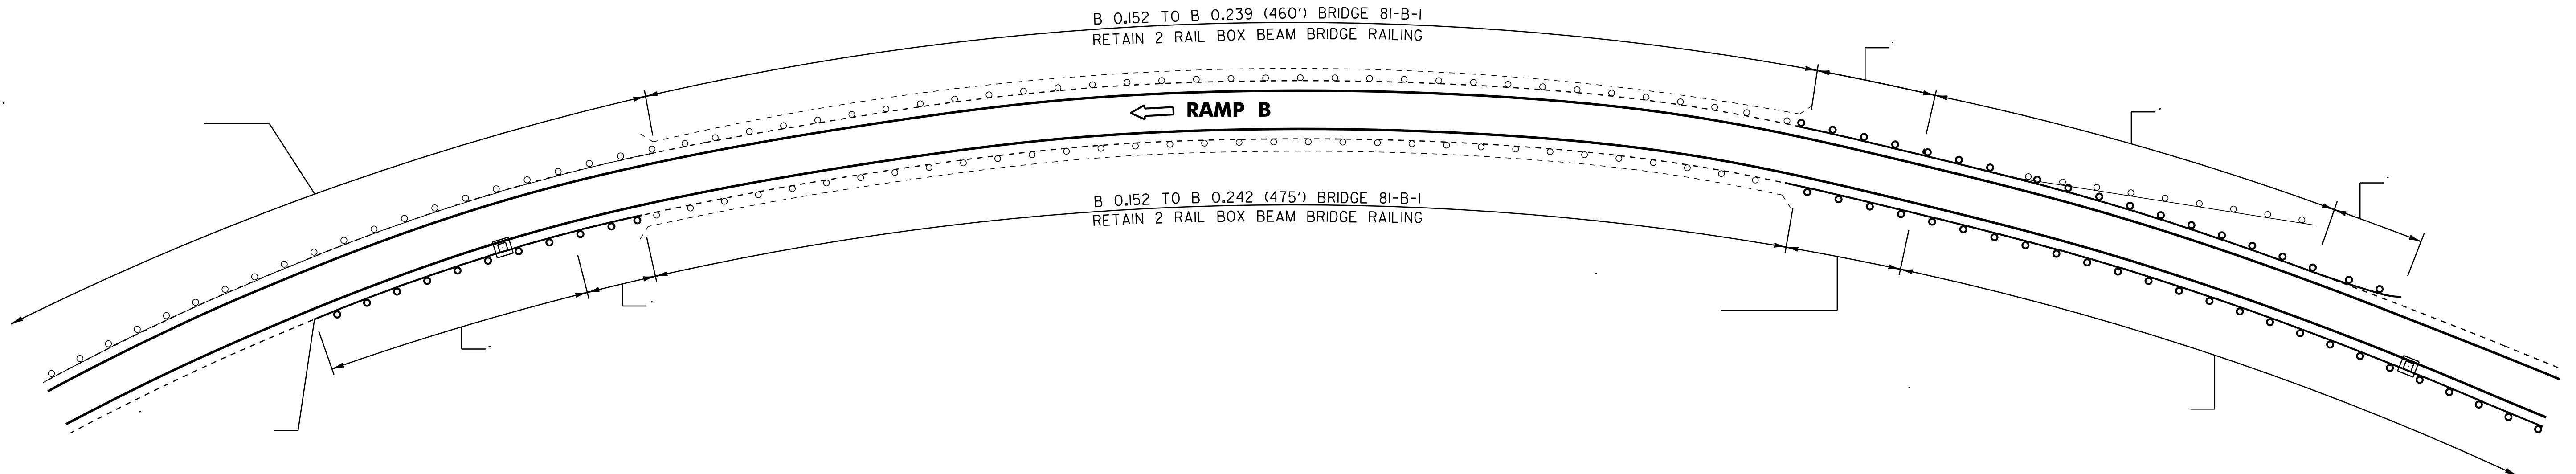

**BRIDGE /GUARDRAIL  
TREATMENT DETAIL SHEET 3**

PROJECT NAME: NEWBURY-ST. JOHNSBURY	PLOT DATE: 29-JUL-2014 16:46
PROJECT NUMBER: AC IM 091-2(76)	DRAWN BY: JLS
FILE NAME: 06a046	CHECKED BY: PTS
DESIGNED BY: NULL	SHEET 18 OF 33
IPARM FILE NAME: 06A046_I8	

NOT TO SCALE