


- TEMPORARY 6" WHITE LINE, PAINT
 DURABLE 6" WHITE LINE, RECESSED OPTION
 A 0.041 TO A 0.282 (RAMP A) SOLID RT
 A 0.092 TO A 0.221 (RAMP B) SOLID LT
 115.117 TO 115.280 DOTTED LT
 115.554 TO 115.651 DOTTED LT
- TEMPORARY 6" YELLOW LINE, PAINT
 DURABLE 6" YELLOW LINE, RECESSED OPTION
 A 0.041 TO A 0.071 (RAMP A) SOLID LT
 A 0.071 TO A 0.225 (RAMP B) SOLID LT
 A 0.092 TO A 0.221 (RAMP A) SOLID LT
 A 0.225 TO A 0.282 (RAMP A) SOLID LT
- TEMPORARY 12" WHITE LINE, PAINT
 DURABLE 12" WHITE LINE, RECESSED OPTION
 A 0.019 TO A 0.041 SOLID LT
 A 0.019 TO A 0.041 SOLID LT (GORE STRIPES)
 A 0.088 TO A 0.092 SOLID LT (RAMP A)
 A 0.088 TO A 0.092 SOLID LT (RAMP B)
 A 0.221 TO A 0.224 SOLID LT (RAMP A)
 A 0.221 TO A 0.224 SOLID LT (RAMP B)
 A 0.282 TO A 0.298 SOLID LT (RAMP A)
 115.280 TO 115.306 SOLID LT
 115.522 TO 115.554 SOLID LT
- TEMPORARY LETTER OR SYMBOL, PAINT
 DURABLE LETTER OR SYMBOL OPTION
 A 0.070 WRONG WAY ARROW
 A 0.220 YIELD MARKINGS (6)

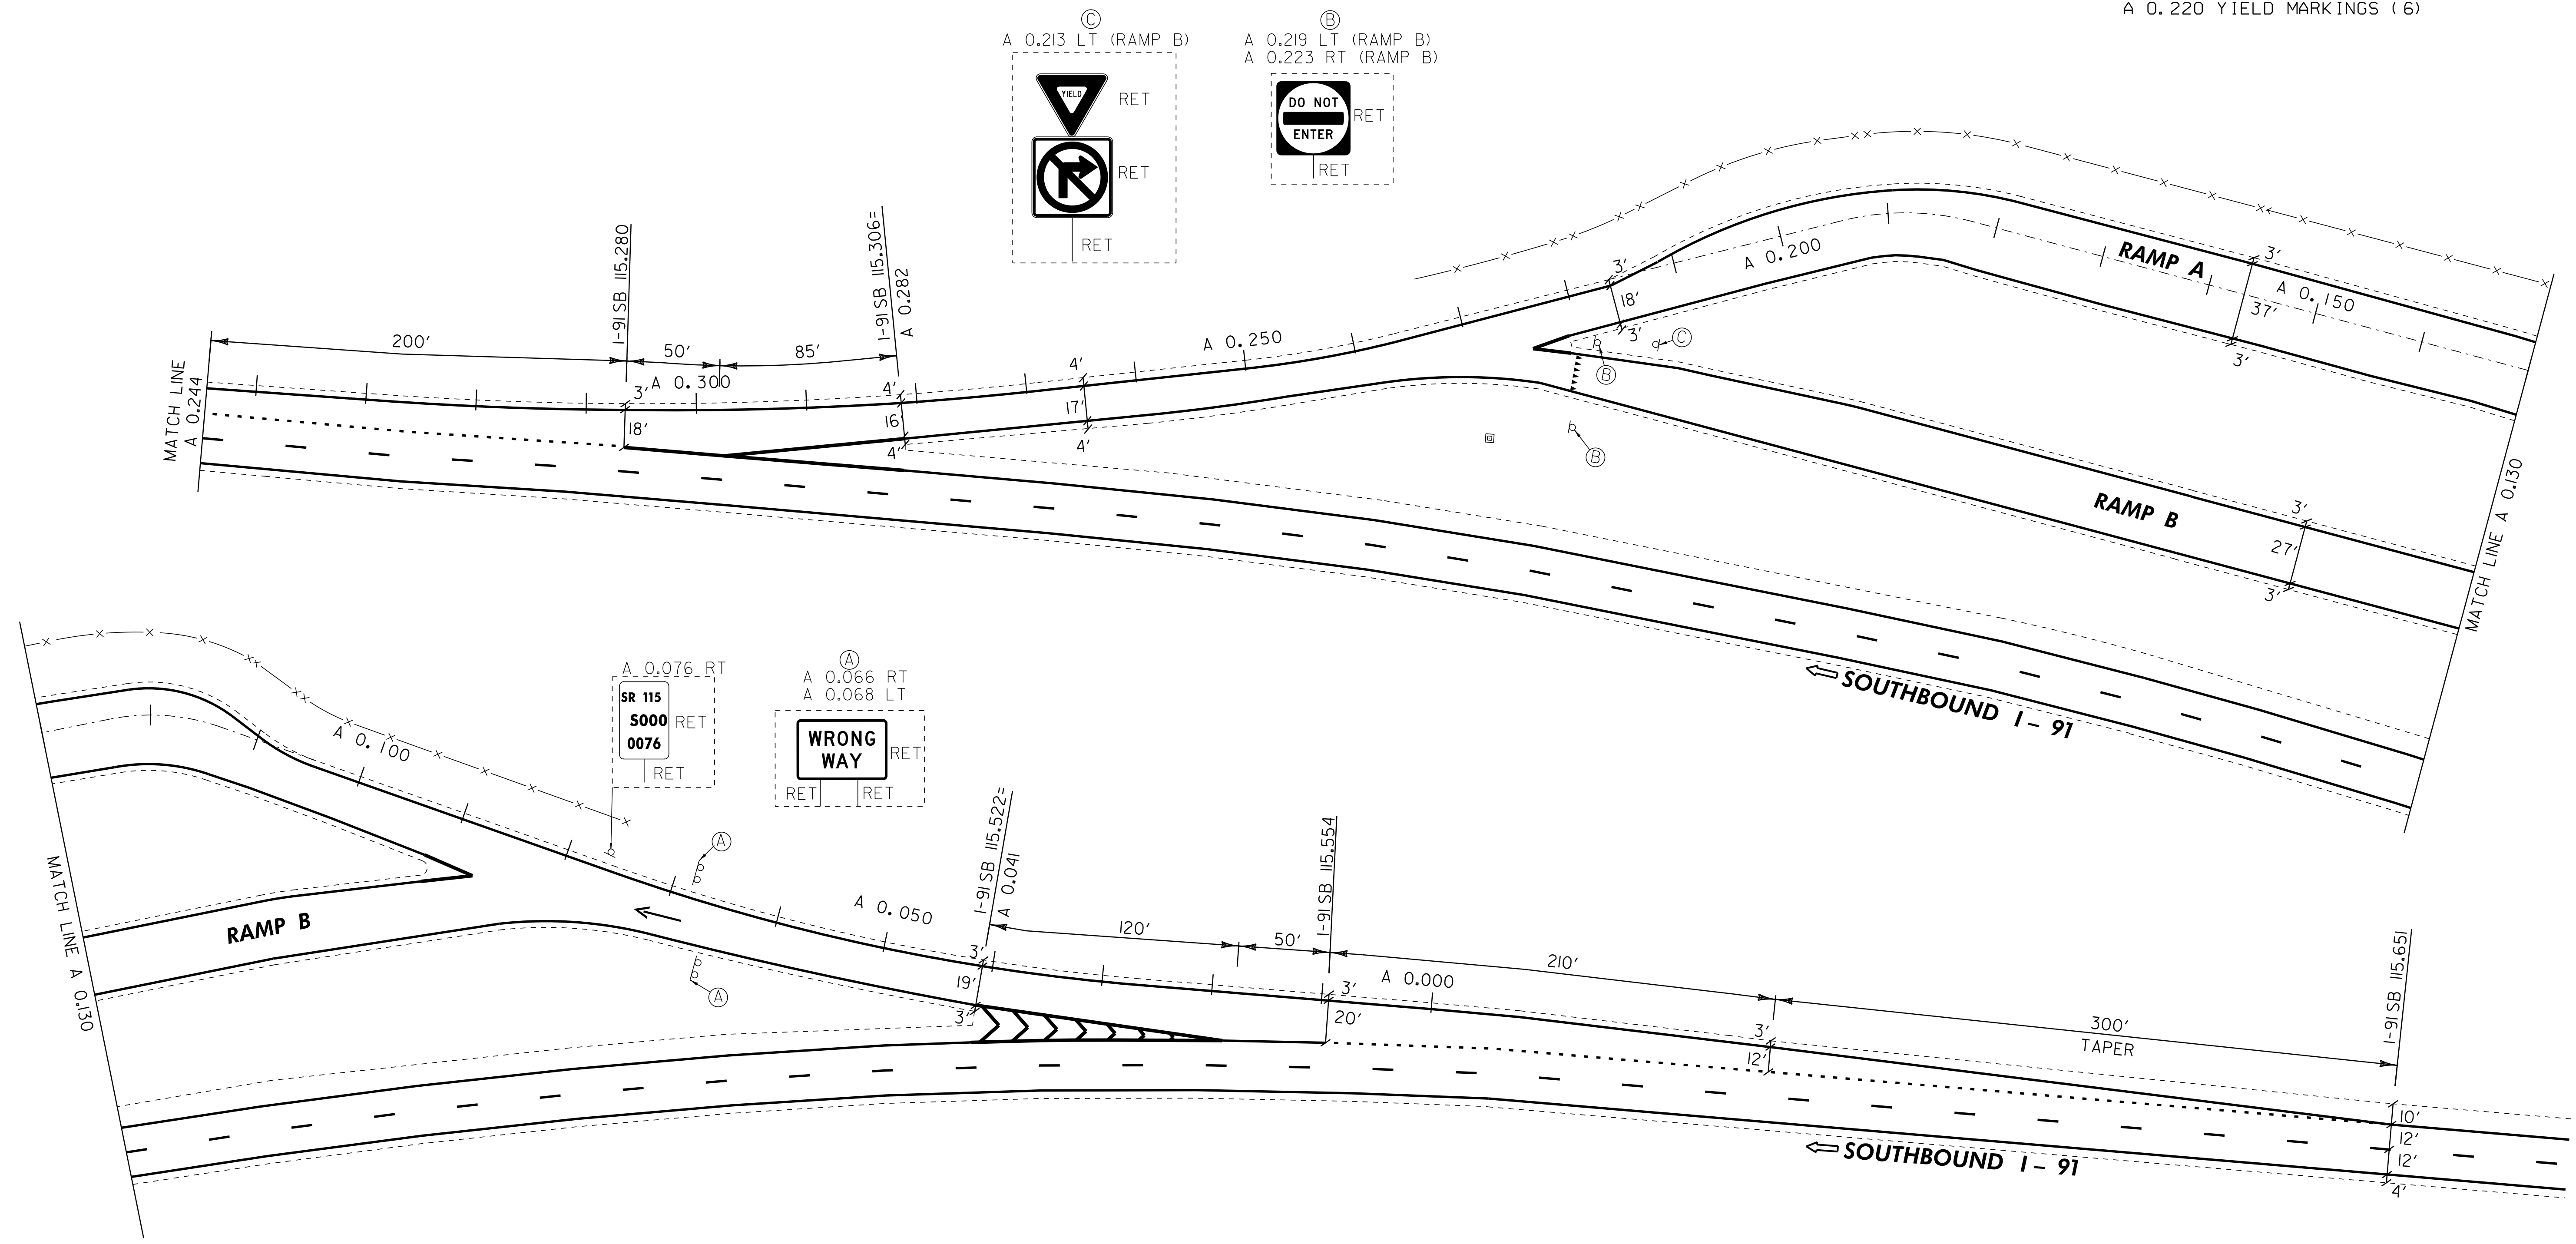

LEGEND

	#	MM	DEPTH	PCC	
	1	115.40	6.00"	NO	PARKING AREA (TRUCKS)
	2	115.40	7.25"	NO	PARKING AREA (AUTOS)

NOT TO SCALE

PARKING AREA DETAIL SHEET

PROJECT NAME: NEWBURY-ST. JOHNSBURY	FILE NAME: 06a046	PLOT DATE: 29-JUL-2014 16:46
PROJECT NUMBER: AC IM 091-2(76)	PROJECT LEADER: PTS	DRAWN BY: JLS
	DESIGNED BY: NLL	CHECKED BY: PTS
	IPARM FILE NAME: 06A046_28	SHEET 28 OF 33