


TEMPORARY 6" WHITE LINE, PAINT
 DURABLE 6" WHITE LINE, RECESSED OPTION
 B 0.061 TO B 0.465 SOLID RT
 127.803 TO 128.000 DOTTED LT
 TEMPORARY 6" YELLOW LINE, PAINT
 DURABLE 6" YELLOW LINE, RECESSED OPTION
 B 0.061 TO B 0.465 SOLID LT

TEMPORARY 12" WHITE LINE, PAINT
 DURABLE 12" WHITE LINE, RECESSED OPTION
 B 0.465 TO B 0.485 SOLID LT
 128.000 TO 128.029 SOLID LT

REHAB. DROP INLETS,
 CATCH BASINS, OR MANHOLES,
 CLASS I, CLASS II
 B 0.101 LT (DI)
 B 0.253 LT (DI)
 B 0.451 RT (DI)

BITUMINOUS CONCRETE CURB, TYPE A
 STEEL BEAM GUARDRAIL, GALVANIZED
 MANUFACTURED TERMINAL SECTION, FLARED
 ANCHOR FOR STEEL BEAM RAIL
 GUARDRAIL APPROACH SECTION, TYPE I
 GUARDRAIL APPROACH SECTION, TYPE II
 REPLACE GUARDRAIL POST ASSEMBLY
 REPLACE GUARDRAIL BEAM UNIT
 REMOVAL AND DISPOSAL OF GUARDRAIL
 DELINEATOR WITH STEEL POST
 SEE ITEM DETAIL SUMMARY SHEETS

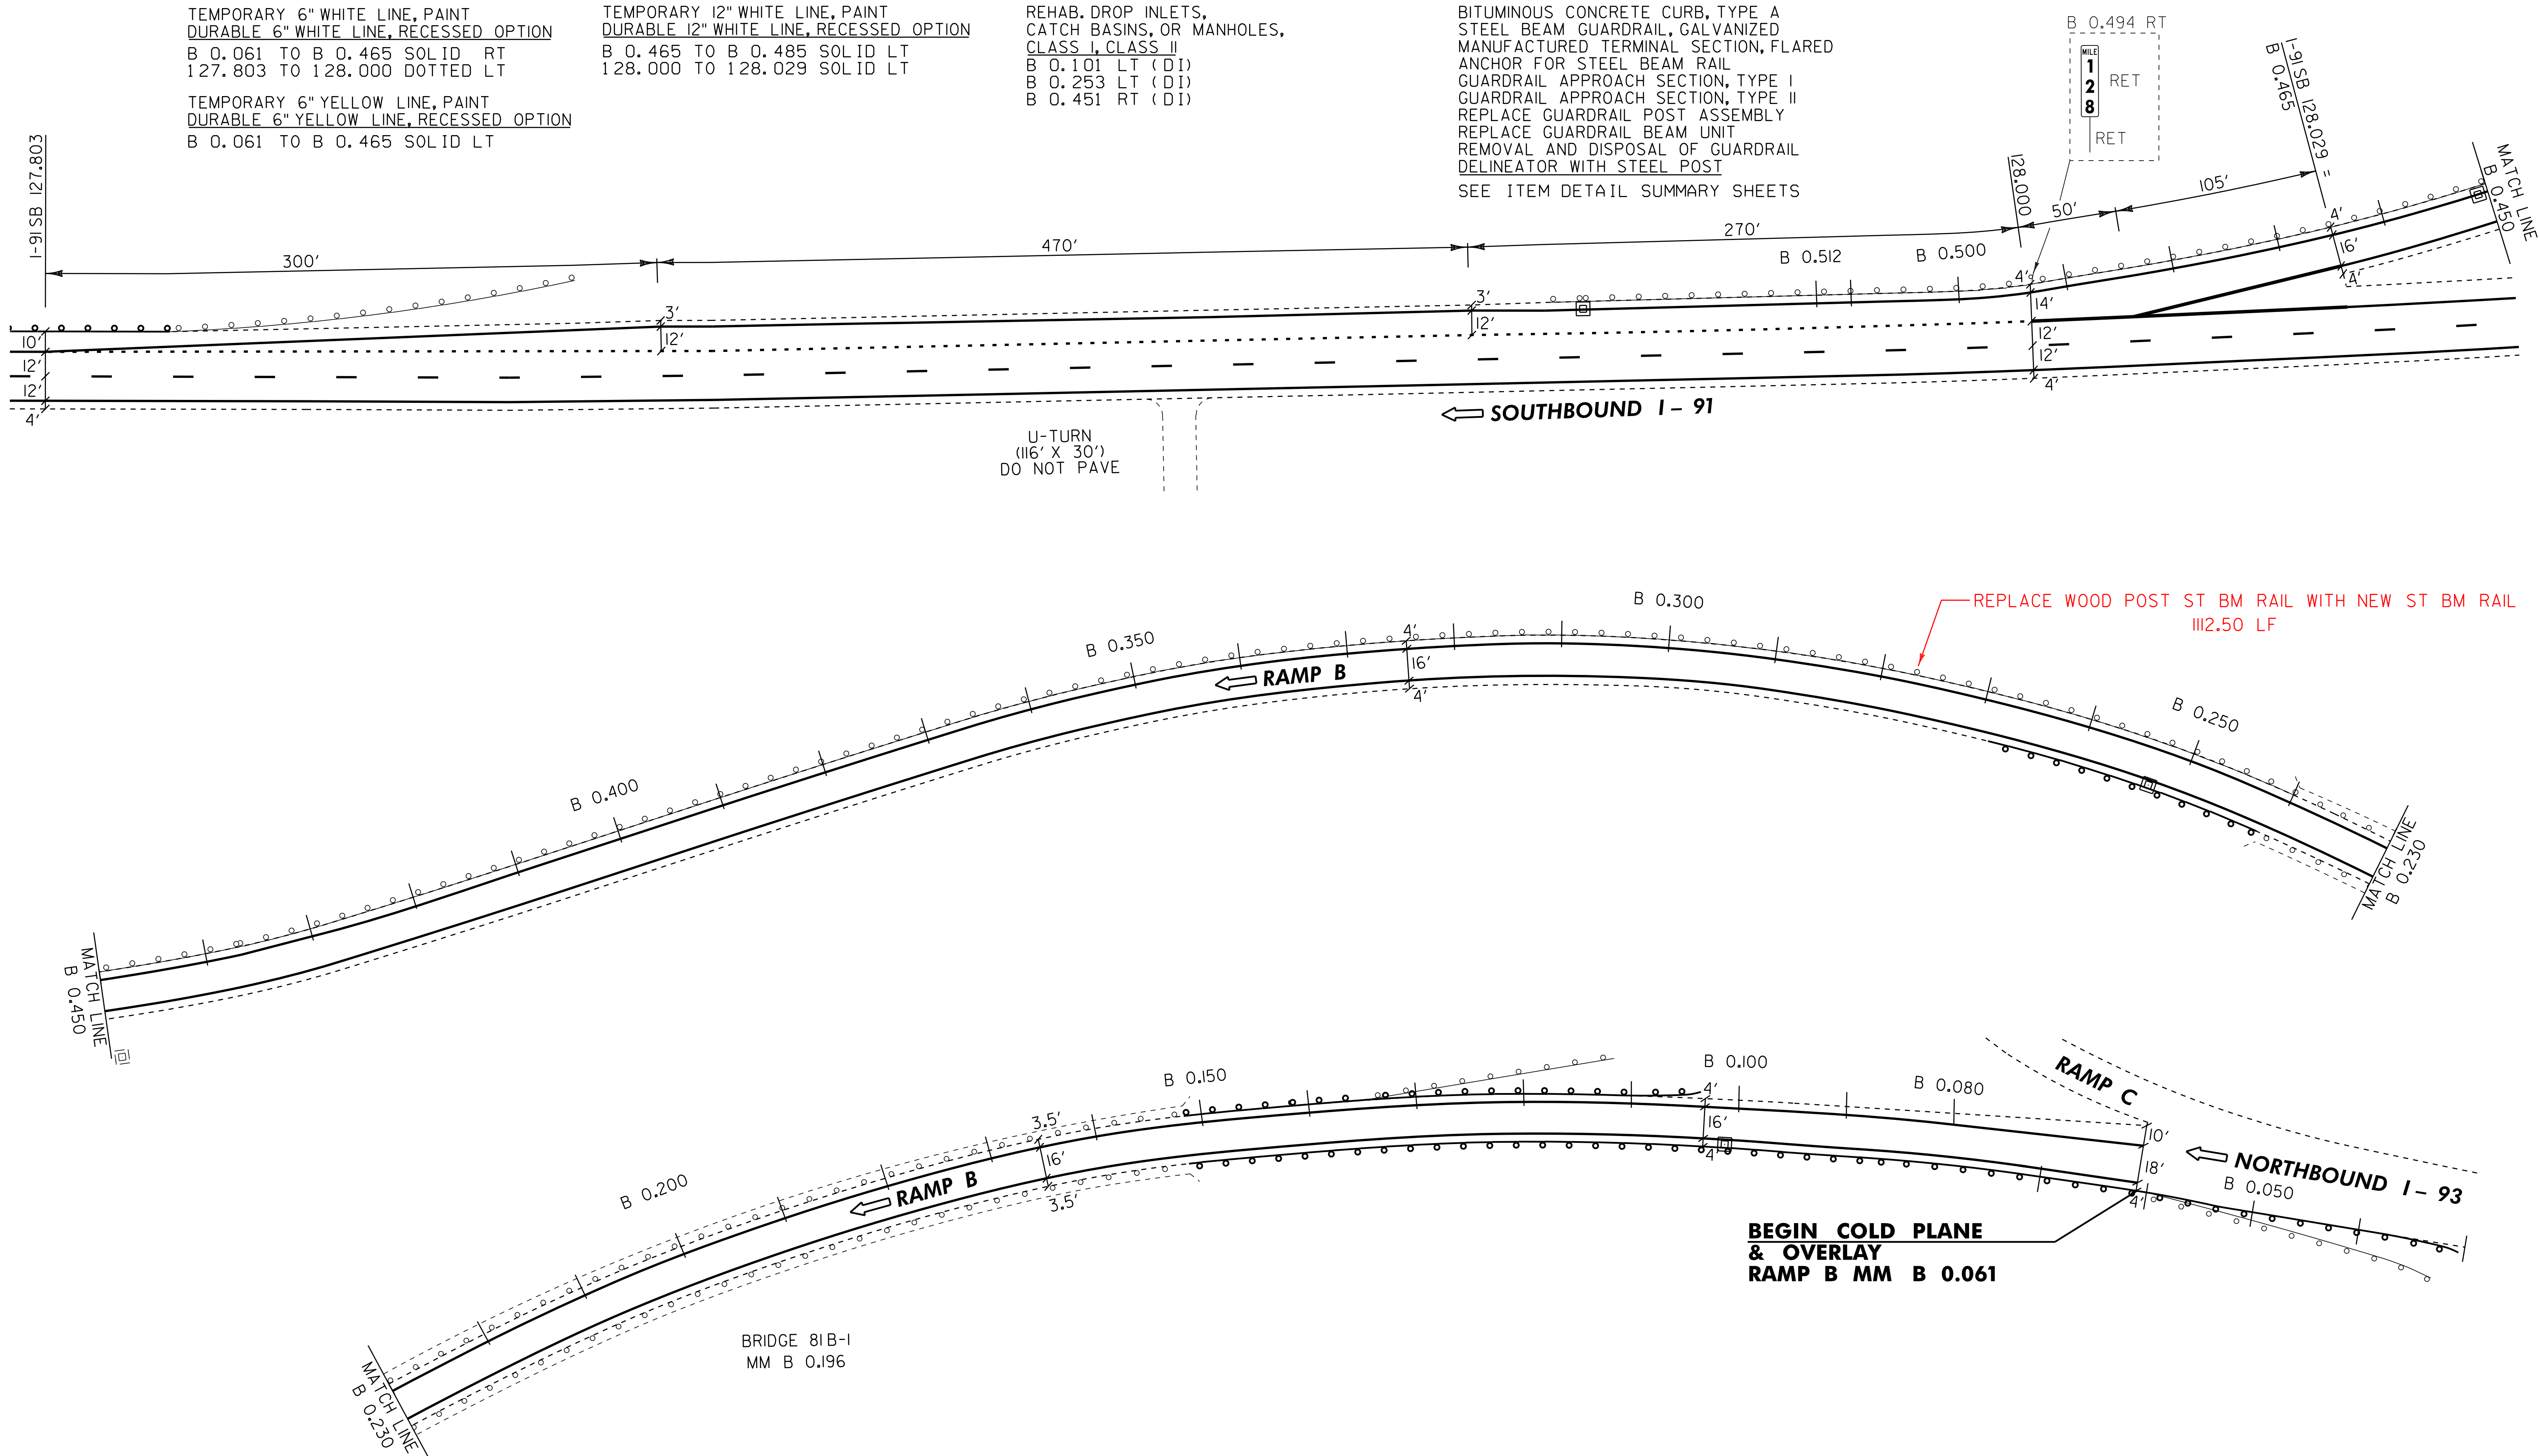

EXIT 19 ON RAMP DETAIL SHEET

PROJECT NAME: NEWBURY-ST. JOHNSBURY	
PROJECT NUMBER: AC IM 091-2(76)	
FILE NAME: 06a046	PLOT DATE: 29-JUL-2014 16:46
PROJECT LEADER: PTS	DRAWN BY: JLS
DESIGNED BY: NULL	CHECKED BY: PTS
IPARM FILE NAME: 06A046_31	SHEET 31 OF 33

NOT TO SCALE