


**INTERSTATE ROUTE 91 NB
BEGIN PROJECT
NEWBURY-ST. JOHNSBURY
IM 091-2(78)
(MM 110.677)**

- 646.622 TEMPORARY 6" WHITE LINE, PAINT
- 646.426 DURABLE 6" WHITE LINE, RECESSED POLYUREA OR
- 646.428 DURABLE 6" WHITE LINE, RECESSED THERMOPLASTIC OR
- 646.429 DURABLE 6" WHITE LINE, RECESSED EPOXY PAINT.
- 110.677 TO 116.600 SOLID RT
- 110.677 TO 116.600 DASHED CL
- 646.632 TEMPORARY 6" YELLOW LINE, PAINT
- 646.436 DURABLE 6" YELLOW LINE, RECESSED POLYUREA OR
- 646.438 DURABLE 6" YELLOW LINE, RECESSED THERMOPLASTIC OR
- 646.439 DURABLE 6" YELLOW LINE, RECESSED EPOXY PAINT.
- 110.677 TO 116.600 SOLID LT
- 613.10 STONE FILL, TYPE I
- 613.11 STONE FILL, TYPE II
- SEE DITCH CLEANING SHEET

- 604.412, 604.415 REHAB. DROP INLETS, CATCH BASINS, OR MANHOLES, CLASS I OR CLASS II
- ~~112.954 RT (DI)~~ 114.828 RT (DI)
- 113.105 RT (DI) 115.668 RT (DI)
- 113.105 LT (DI) 115.723 RT (DI)
- 114.197 LT (DI) 115.762 RT (DI)
- 114.580 RT (DI) 115.804 RT (DI)
- 900.620 SPECIAL PROVISION (DECOMMISSION CURB DROP INLET)
- 112.474 RT (DI) 116.056 RT (DI)
- 112.550 RT (DI) 116.084 RT (DI)
- 112.626 RT (DI) 116.122 RT (DI)
- 112.701 RT (DI) 116.160 RT (DI)
- 112.784 RT (DI) 116.197 RT (DI)
- 112.852 RT (DI) 116.244 RT (DI)
- 112.954 LT (DI) 116.293 RT (DI)
- 112.954 RT (DI)

- 601.0005 12" CSP .064(2-3/8 X 1/2)
- 616.305 BITUMINOUS CONCRETE CURB, TYPE A
- 616.41 REMOVAL OF EXISTING CURB
- 621.20 STEEL BEAM GUARDRAIL, GALVANIZED
- 621.205 STEEL BEAM GUARDRAIL, GALVANIZED W/8 FEET POSTS
- 621.50 MANUFACTURED TERMINAL SECTION, FLARED
- 621.60 ANCHOR FOR STEEL BEAM RAIL
- 621.76 REPLACE GUARDRAIL POST ASSEMBLY
- 621.77 REPLACE GUARDRAIL BEAM UNIT
- 621.80 REMOVAL AND DISPOSAL OF GUARDRAIL
- 900.620 SPECIAL PROVISION (CABLE GUARDRAIL J-BOLT, GALVANIZED)
- 900.620 SPECIAL PROVISION (CABLE GUARDRAIL SPLICE UNIT)
- 900.620 SPECIAL PROVISION (DELINEATOR WITH STEEL POST)
- 900.640 SPECIAL PROVISION (REPLACEMENT OF GUARDRAIL CABLE)
- SEE ITEM DETAIL SUMMARY SHEETS

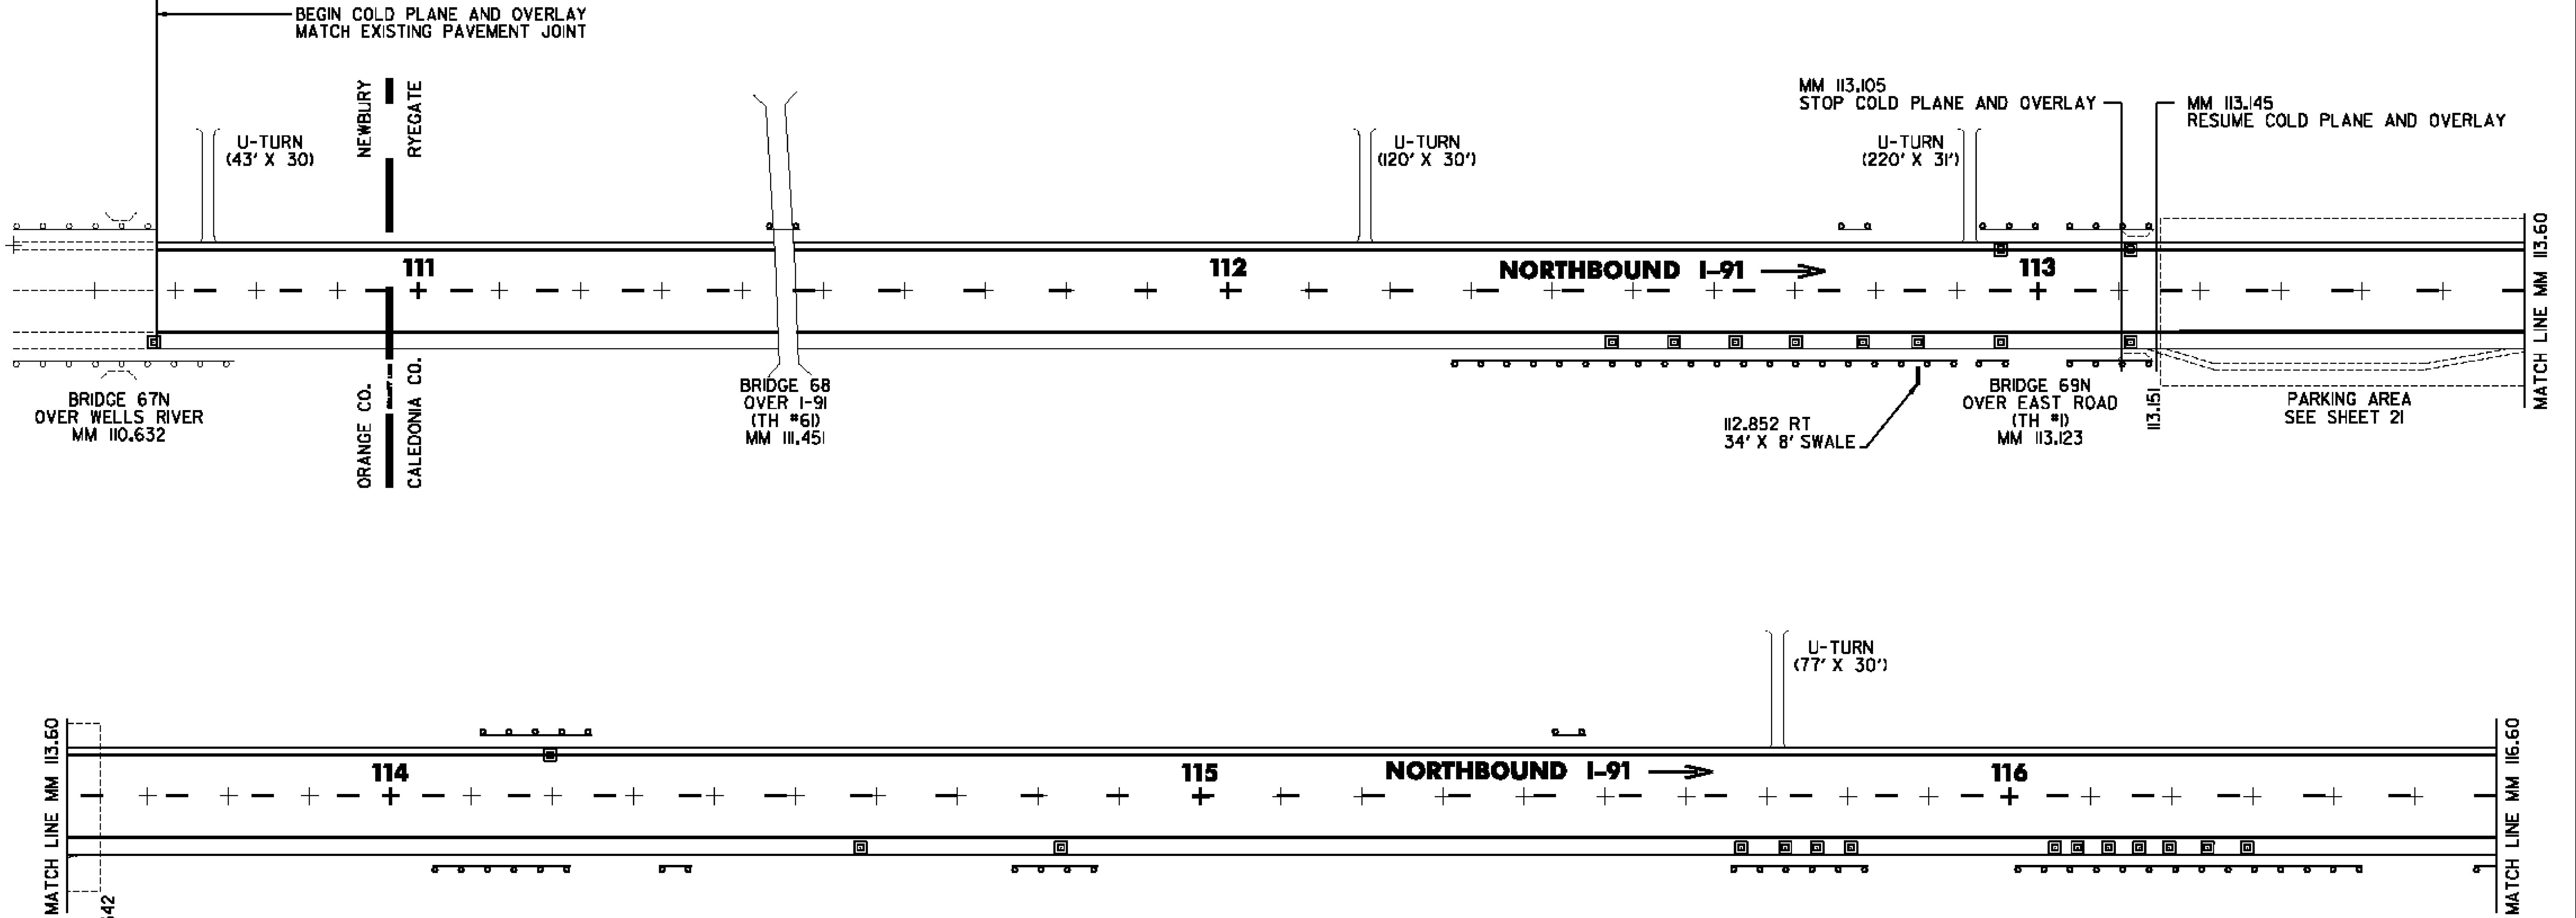

PAVEMENT CORES IN (SHOULDERS)

#	MM	DEPTH	PCC
1	110.75	3.5'	NO
2	111.00	2.875'	NO
3	111.25	2.5'	NO
4	111.55	3.0'	NO
5	112.00	2.5'	NO
6	112.30	2.5'	NO
7	112.60	3.0'	NO
8	113.00	3.375'	NO
9	113.40	6.25'	NO
10	113.40	6.5'	NO
11	113.45	3.75'	NO
12	114.05	2.875'	NO
13	114.55	2.5'	NO
14	115.00	2.75'	NO
15	115.50	3.0'	NO
16	116.00	3.625'	NO
17	116.55	3.0'	NO

- LEGEND**
- = EXISTING GUARDRAIL
 - = PROPOSED GUARDRAIL
 - = YELLOW LINE
 - = WHITE LINE
 - = DELINEATOR
 - = DI

NOT TO SCALE

MAINLINE LAYOUT 1

PROJECT NAME: NEWBURY-ST. JOHNSBURY	PLOT DATE: 8/5/2011
PROJECT NUMBER: IM 091-2(78)	DRAWN BY: WWG
FILE NAME: /pave/06a044/pa044	CHECKED BY: PTS
PROJECT LEADER: PTS	SHEET 18 OF 33
DESIGNED BY: NLL	
IPARM FILE NAME: 06A044.18	