


GUARDRAIL TREATMENT - BRIDGE 77 N

MM 123.246

INTERSTATE 91 OVER US ROUTE 5 & PASSUMPSIC RIVER

NOTE

1. SEE ITEM DETAIL SHEET FOR REMOVAL OF EXISTING GUARDRAIL.

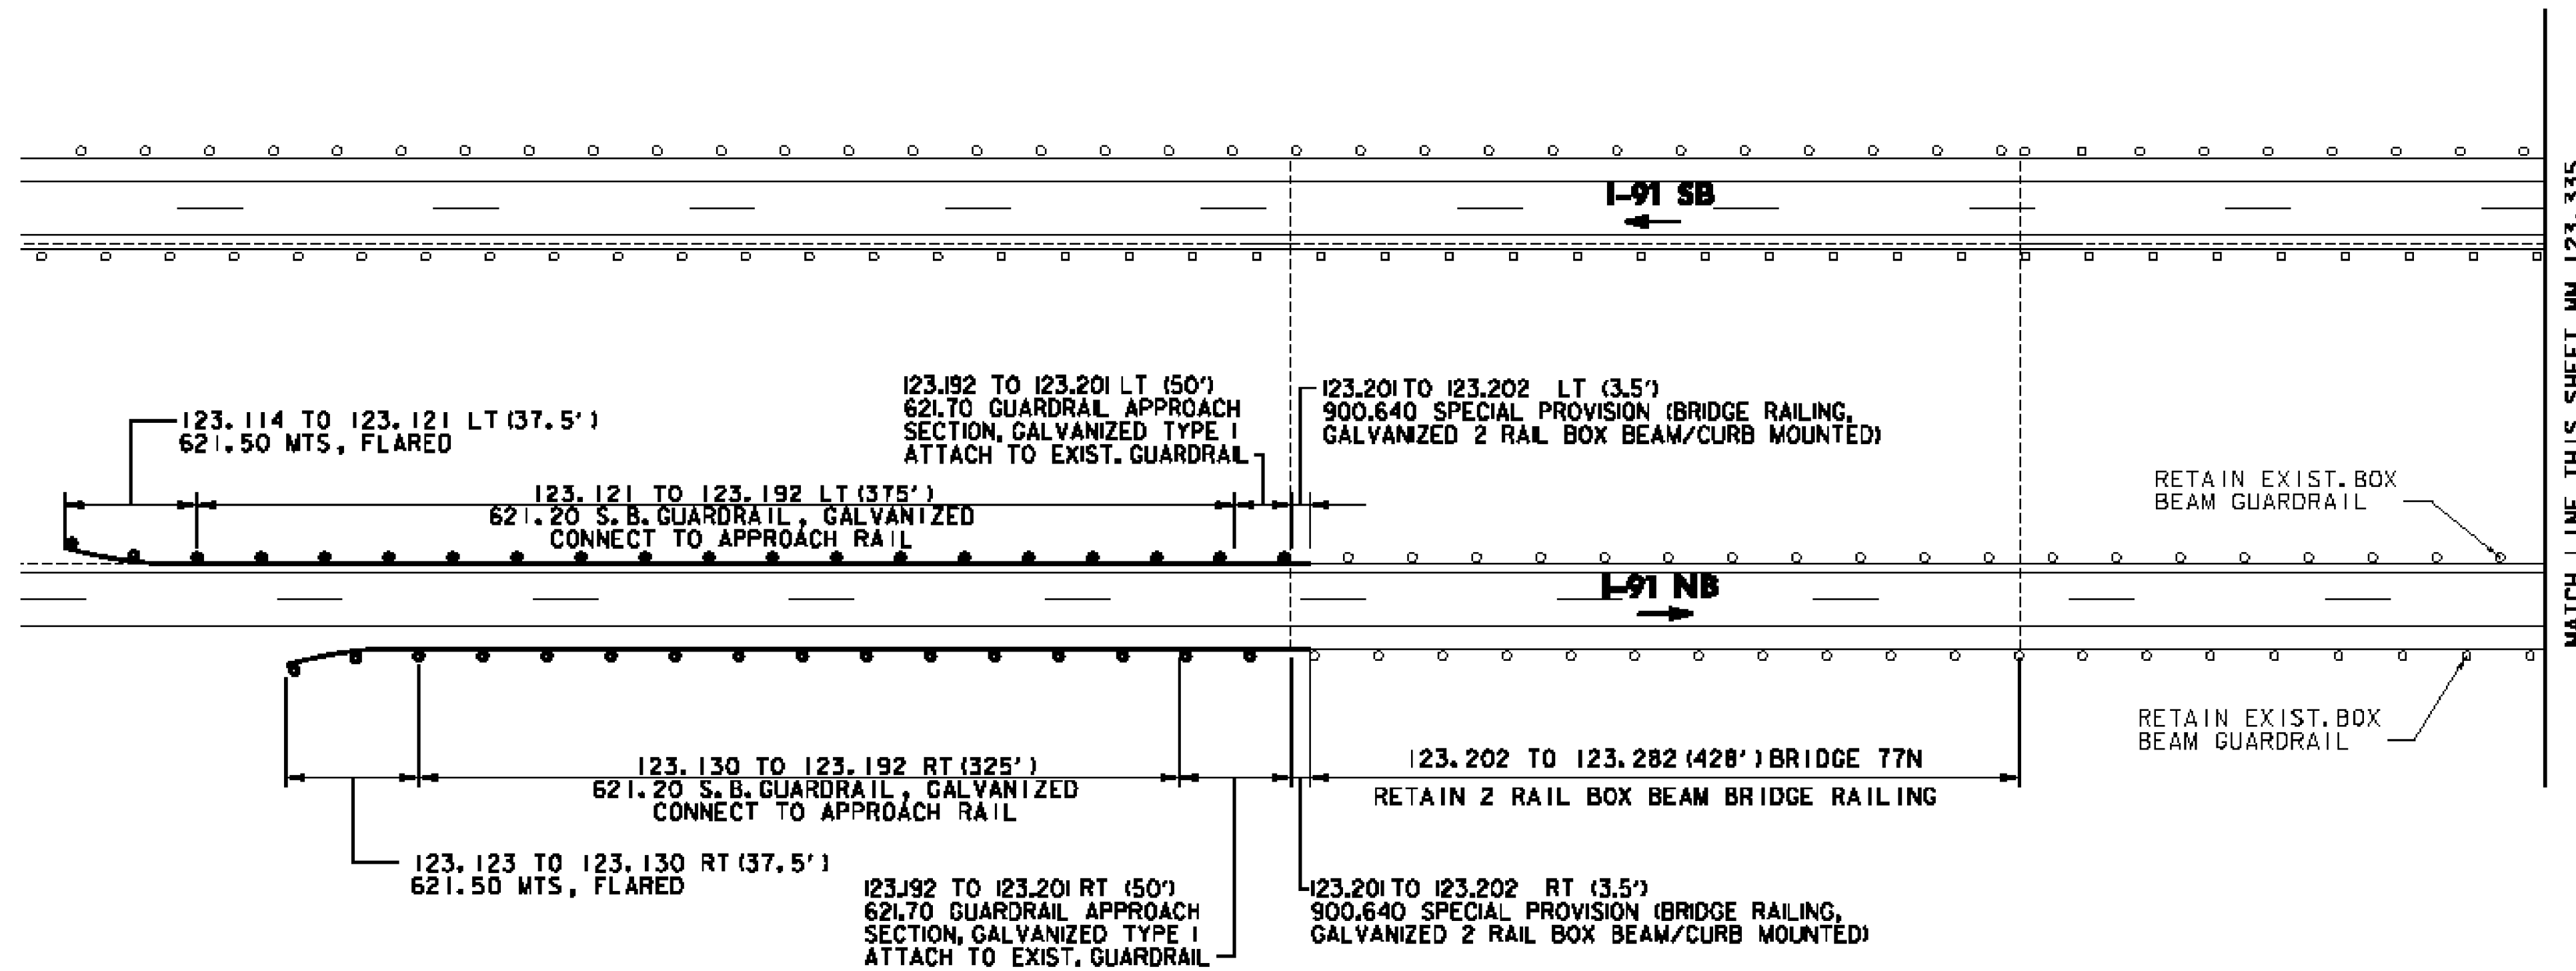


MATCH LINE THIS SHEET MM 123.335

GUARDRAIL TREATMENT - BRIDGE 78 N

MM 123.414

INTERSTATE 91 OVER RAILROAD & OLD SILO ROAD (TH#12)

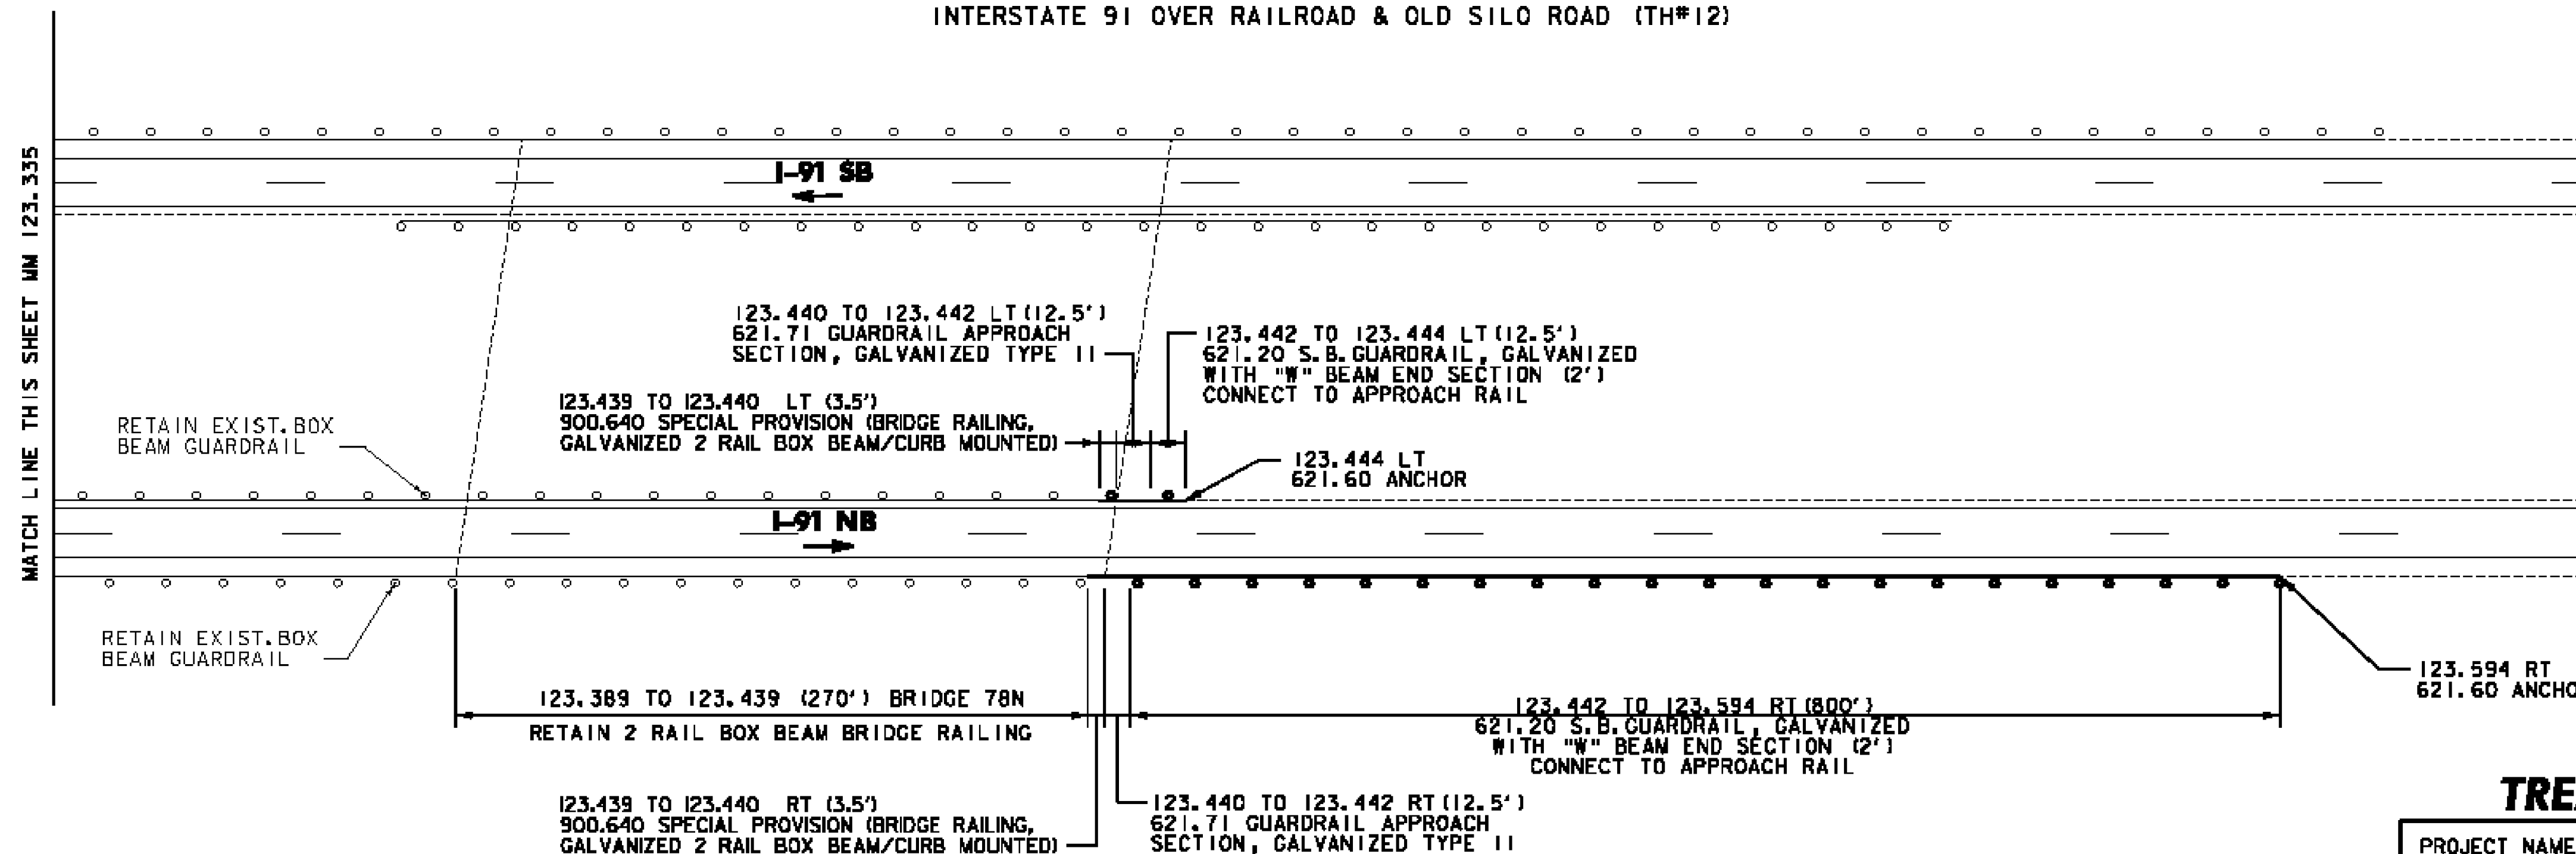

MATCH LINE THIS SHEET MM 123.335

BRIDGE /GUARDRAIL TREATMENT DETAIL SHEET 2

PROJECT NAME: NEWBURY-ST. JOHNSBURY

PROJECT NUMBER: IM 091-2(78)

FILE NAME: /pave/06a044/pa044

PROJECT LEADER: PTS

DESIGNED BY: NLL

IPARM FILE NAME: 06A044.28

PLOT DATE: 8/5/2011

DRAWN BY: WWG

CHECKED BY: PTS

SHEET 28 OF 33

NOT TO SCALE