


PLAN

ITEM 621.70 GUARDRAIL APPROACH SECTION, TYPE I

POST NO.	SPACING
1	3'-1 1/2"
2	3'-1 1/2"
3	3'-1 1/2"
4	3'-1 1/2"
5	3'-1 1/2"
6	3'-1 1/2"
7	3'-1 1/2"
8	3'-1 1/2"
9	3'-1 1/2"
10	4'-2"
11	4'-2"
12	4'-2"
13	6'-3"
14	6'-3"

50'-0" PAY LENGTH GUARDRAIL APPROACH SECTION, TYPE I

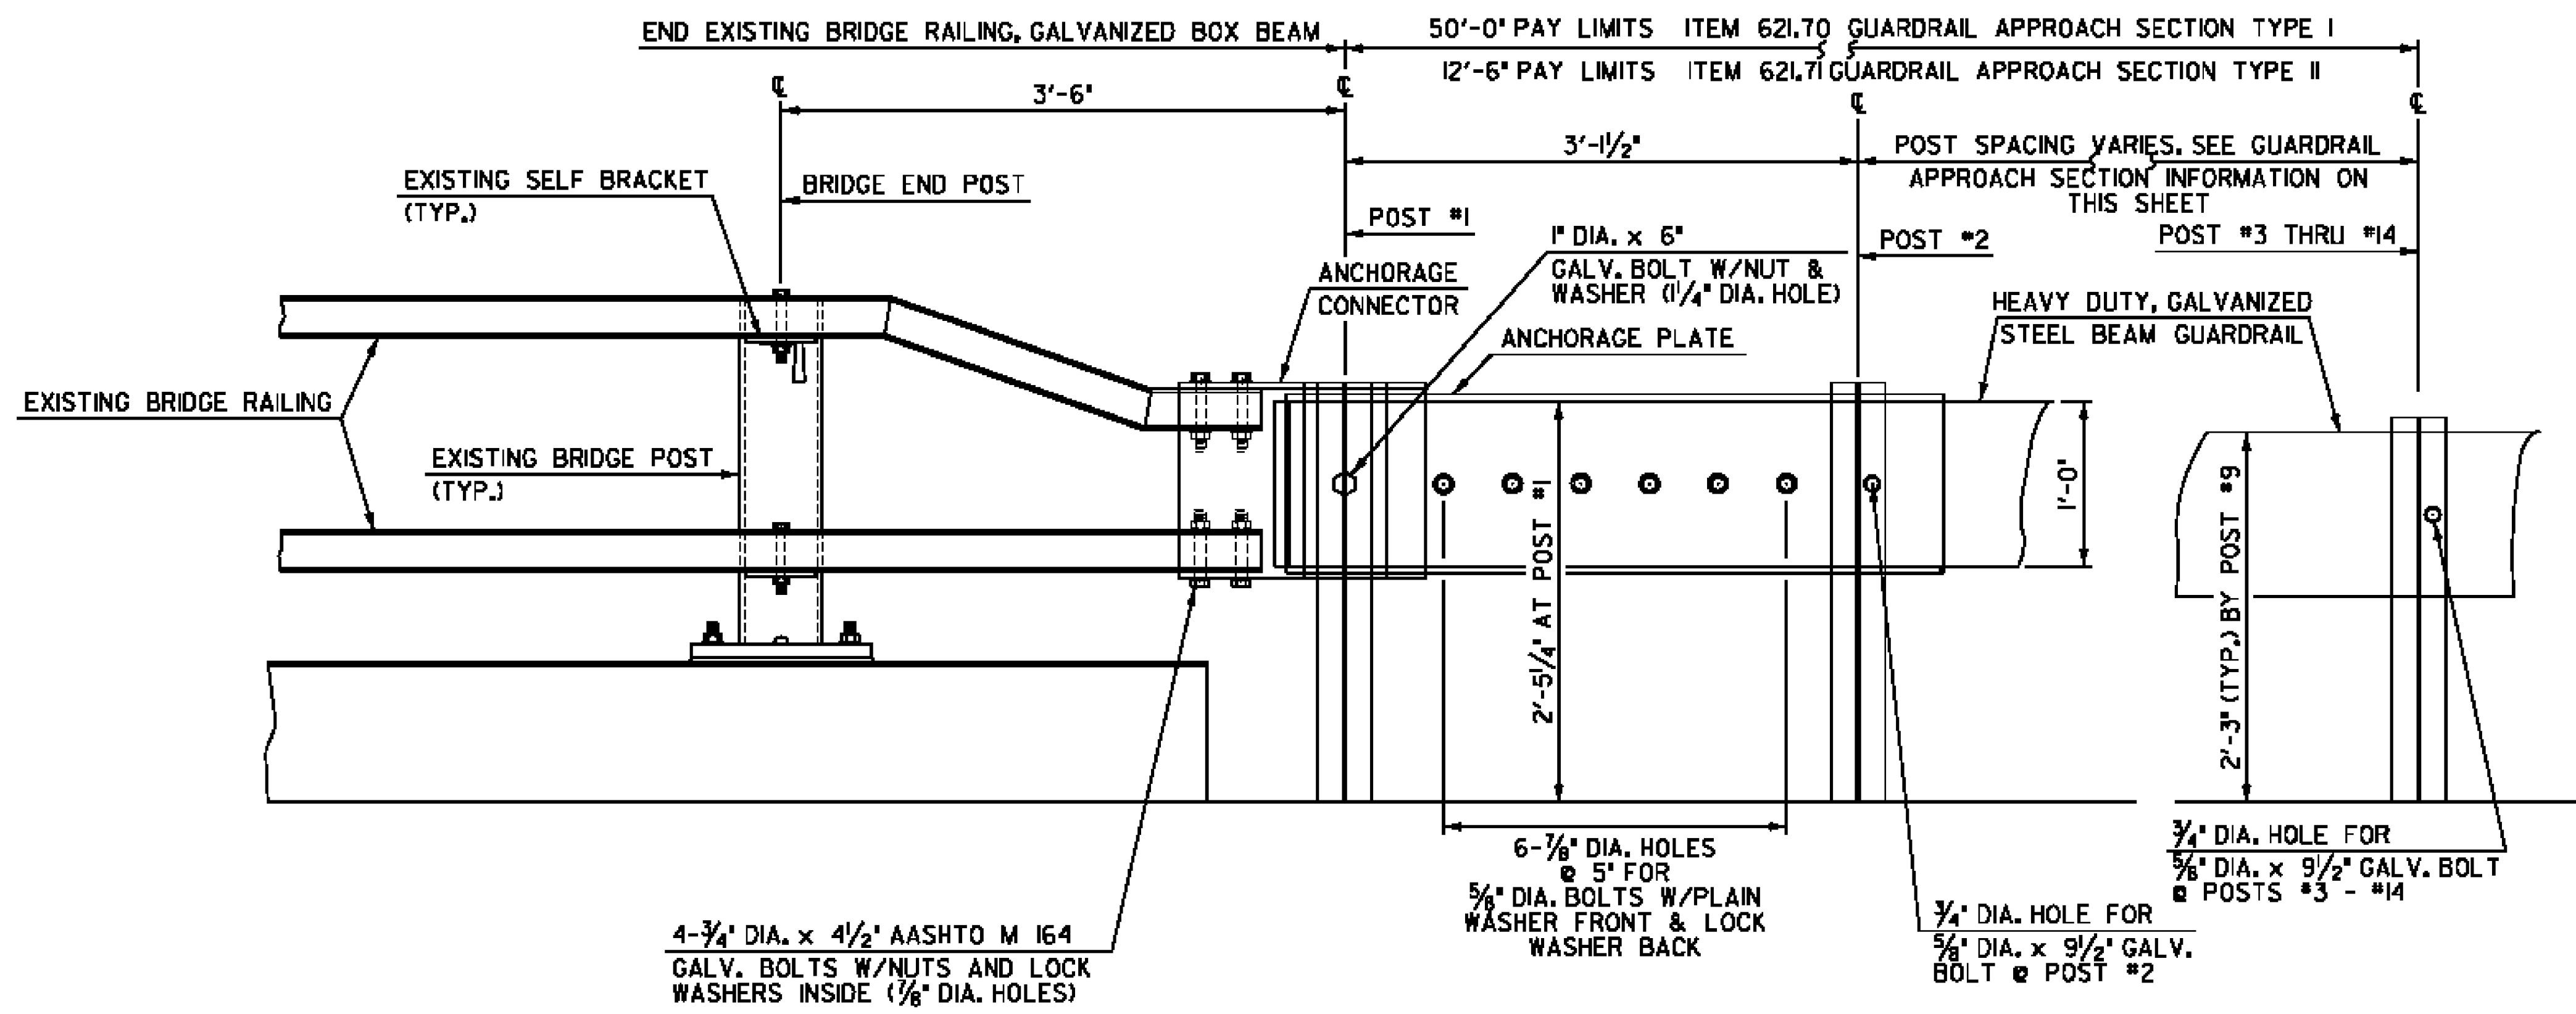

ELEVATION

ITEM 621.71 GUARDRAIL APPROACH SECTION, TYPE II

POST NO.	SPACING
1	3'-1 1/2"
2	4'-8 1/4"
3	4'-8 1/4"
4	4'-8 1/4"

12'-6" PAY LENGTH GUARDRAIL APPROACH SECTION, TYPE II

GUARDRAIL APPROACH SECTION DETAIL

NOT TO SCALE

GUARDRAIL APPROACH SECTION DETAIL SHEET 1

PROJECT NAME:	NEWBURY-ST. JOHNSBURY
PROJECT NUMBER:	IM 09I-2(78)
FILE NAME:	/pave/06a044/pa044
PROJECT LEADER:	PTS
DESIGNED BY:	NLL
IPARM FILE NAME:	06A044.29
PLOT DATE:	8/5/2011
DRAWN BY:	WWC
CHECKED BY:	PTS
SHEET	29 OF 33

MODEL: Default
CLD 10-0341 206A044.dgn