

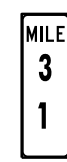






TRAFFIC SIGN SUMMARY SHEET 1

MILEMARKER, STATION, OR SIGN NUMBER	SIGN LEGEND	SIGN DIMENSIONS		NEW & SALVAGED SIGNS				EXIST POST RETAIN	SALVAGE	NO. OF POSTS	NEW SIGN POSTS																REMARKS	SIGN DETAIL	
				"A"	"B"	SALV SIGN	SALV TIS				FLANGED CHANNEL			SQUARE STEEL (in)			TUBULAR ALUMINUM (in)			TUBULAR STEEL (in)				W-SHAPE STEEL		DETAIL ON DWG. NUMBER		STD. SHEET NUMBER	
		EA	WIDTH (in)								HEIGHT (in)	1.2	2.0	3.0	1.75	2.0	2.5	3.0	4.0	4.0 MOD	3.0	3.5	4.0	5.0	24"				30"
		lb/ft	lb/ft	lb/ft	lb/ft	lb/ft	lb/ft				lb/ft	lb/ft	lb/ft	lb/ft	lb/ft	lb/ft	lb/ft	lb/ft	lb/ft	lb/ft	lb/ft	lb/ft	lb/ft	lb/ft					
NORTHBOUND: 30.896,RT	10/16/07 	1	6	8	0.33					1	1-9 X		X														SIGN ID CODE VD-701	E-134	
30.940,RT	10/11/07 	1	48	48	16.00					2																	SIGN SHALL BE MOUNTED ON TWO FLANGED CHANNEL SIGN POSTS SIGN ID CODE W4-1	E-150	
31.000,RT	10/11/07 	1	12	36	3.00					1																	SIGN ID CODE DIO-2	E-139	
31.086,RT	10/11/07 	1	6	8	0.33					1	1-9.0 X		X														SIGN ID CODE VD-701	E-134	
31.177,LT	10/02/07 	1	36	12	3.00					2																	SIGN SHALL BE MOUNTED ON TWO FLANGED CHANNEL SIGN POSTS SIGN ID CODE R6-1R	E-142	
31.434,RT	10/11/07 	1	6	8	0.33					1	1-08.0 X		X														SIGN ID CODE VD-701	E-134	
31.502,LT	10/09/07 	1	36	36	9.00					2																	SIGN SHALL BE MOUNTED ON TWO FLANGED CHANNEL SIGN POSTS SIGN ID CODE R3-4	E-143	
											FT 26.0 42.0	FT 11.0 (85.0)	FT 14.0 (84.0)	FT 42.0	FT 14.0	EA	LB	LB	LB	LB	LB	LB	EA.	EA.	LB				
				TOTALS	SF 31.99	SF	EA.	SF			FT 56.0 (85.0)	FT 37.0 (84.0)	NON OPT	FT 56.0	EA.	LB	EA.	EA.	LB										

FILE NAME = \$FILES
DATE/TIME = \$DATE\$
USER = \$NTUSER\$

FINAL POST LENGTHS ARE TO BE DETERMINED IN THE FIELD. POST SIZES ARE COMPUTED BASED ON INFORMATION FURNISHED ON THE STANDARD SHEETS AND THE TRAFFIC OPERATIONS SECTION "SIGN POST DESIGN GUIDELINE."

PROJECT NAME: RANDOLPH - BROOKFIELD
PROJECT NUMBER: IM 089-1(22)
FILE NAME: p99a200.dgn
PROJECT LEADER: D.E.G.
DESIGNED BY: D.W.E.
IPARM FILE: p06A048sssl.i
PLOT DATE: \$DATE\$
DRAWN BY: K.A.R.
CHECKED BY: D.E.G.
SHEET 40 OF 61