


FILE NAME = \$FILES\$
DATE/TIME = \$DATE\$
USER = \$USER\$

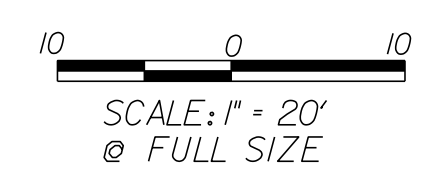

TRAFFIC SIGN CROSS SECTION SHEET #1	PROJECT NAME: RANDOLPH - BROOKFIELD	FILE NAME: p99a200.dgn	PLOT DATE: \$DATE\$
	PROJECT NUMBER: IM 089-1(22)	PROJECT LEADER: D.E.G.	DRAWN BY: C.A.K.
	DESIGNED BY: D.W.E.	CHECKED BY: D.W.E.	
	IPARM FILE: p06A048scxl.i	SHEET 59 OF 61	