
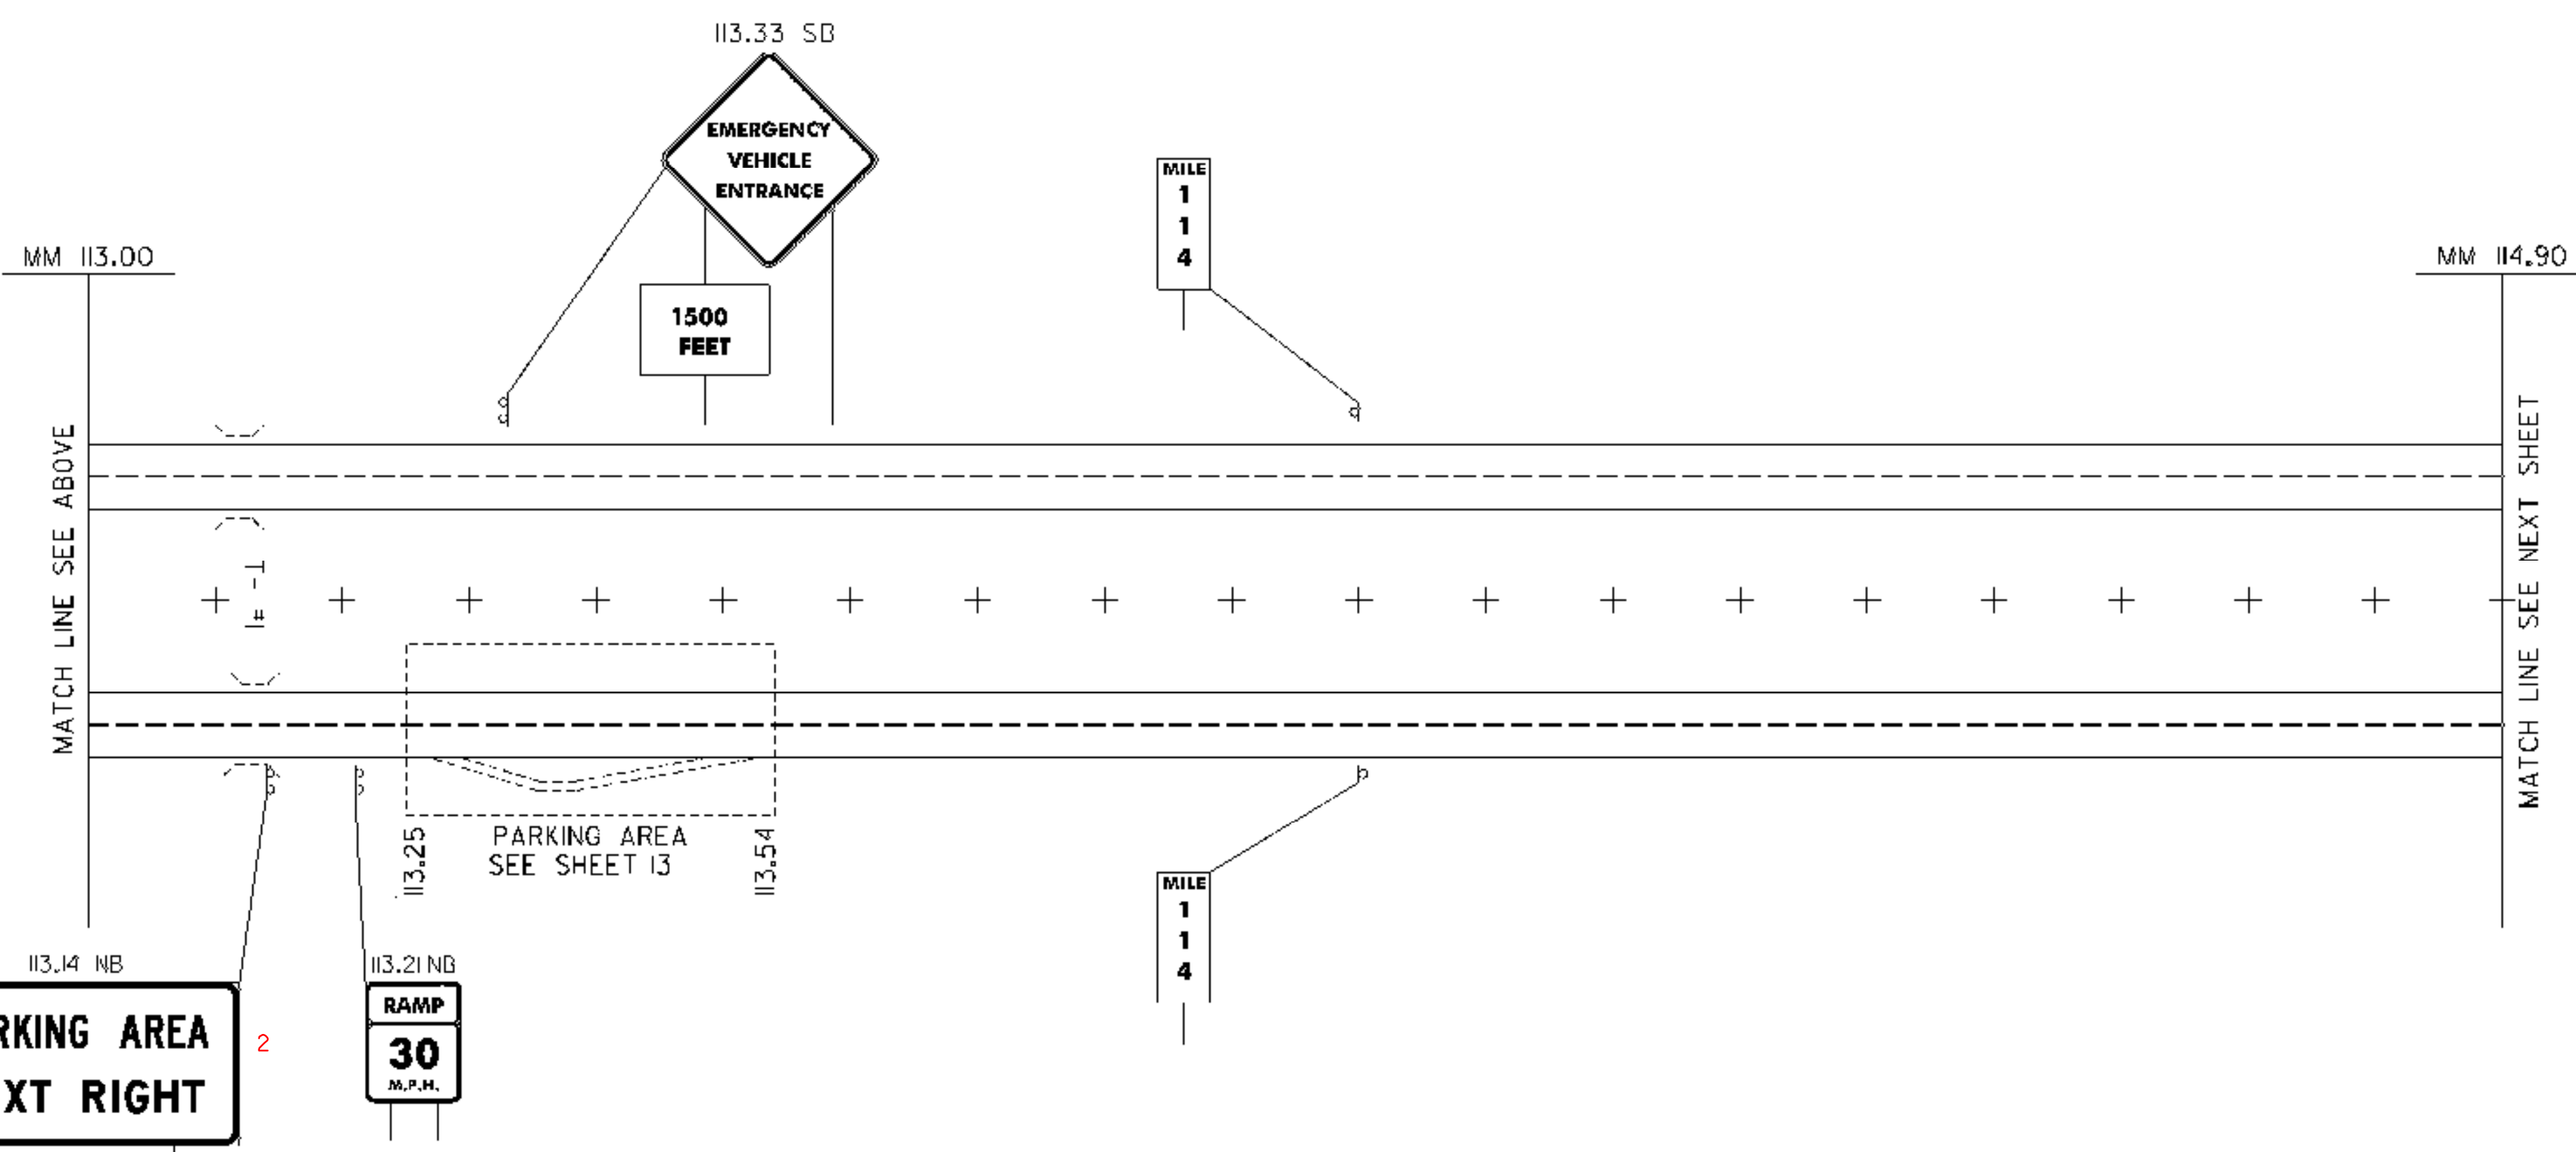


**BEGIN PROJECT**  
**IM 091-2(73)**  
**(MM 110.96)**

**REMOVING SIGNS**

NB - TYPE A: 6  
 TYPE B: 2  
 BRIDGE PLAQUE: 5 (NOT SHOWN)

SB - TYPE A: 7  
 TYPE B: 0  
 BRIDGE PLAQUE: 5 (NOT SHOWN)

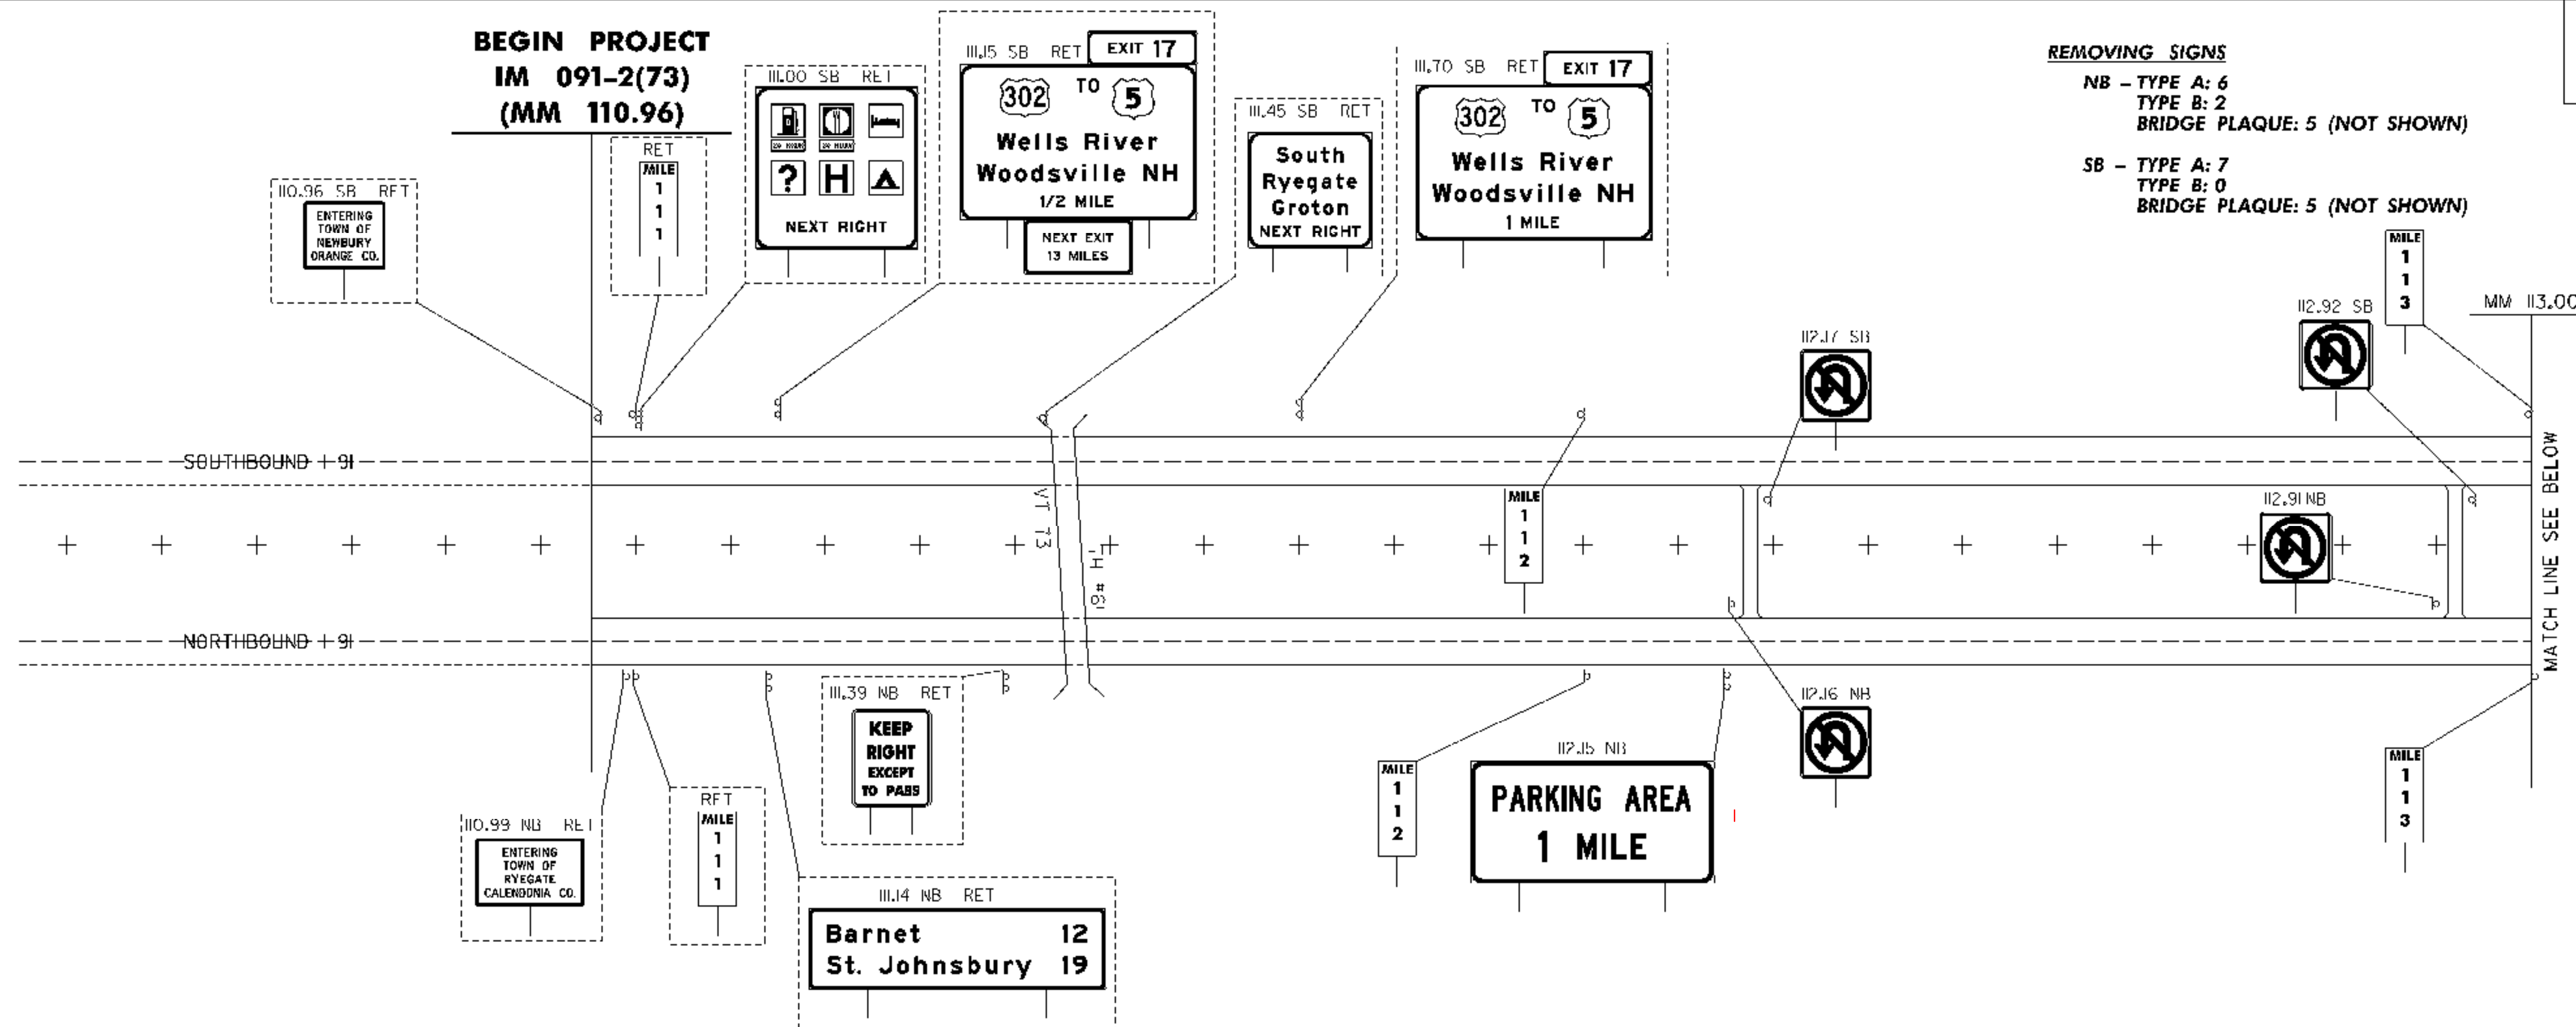

**LEGEND**  
 [Dashed Box] RET - RETAINED

**ALL SIGNS AND POSTS WILL BE REMOVED UNLESS OTHERWISE NOTED**

**EXISTING SIGNS**

PROJECT NAME:	RYEGATE-ST. JOHNSBURY
PROJECT NUMBER:	IM 091-2(73)
FILE NAME:	97194s-m1.dgn
PROJECT LEADER:	CRB
DESIGNED BY:	DAM
CLD REF. NO.:	97-0194
PLOT DATE:	12/13/2006
DRAWN BY:	JCS
CHECKED BY:	DAM
SHEET	6 OF 88