
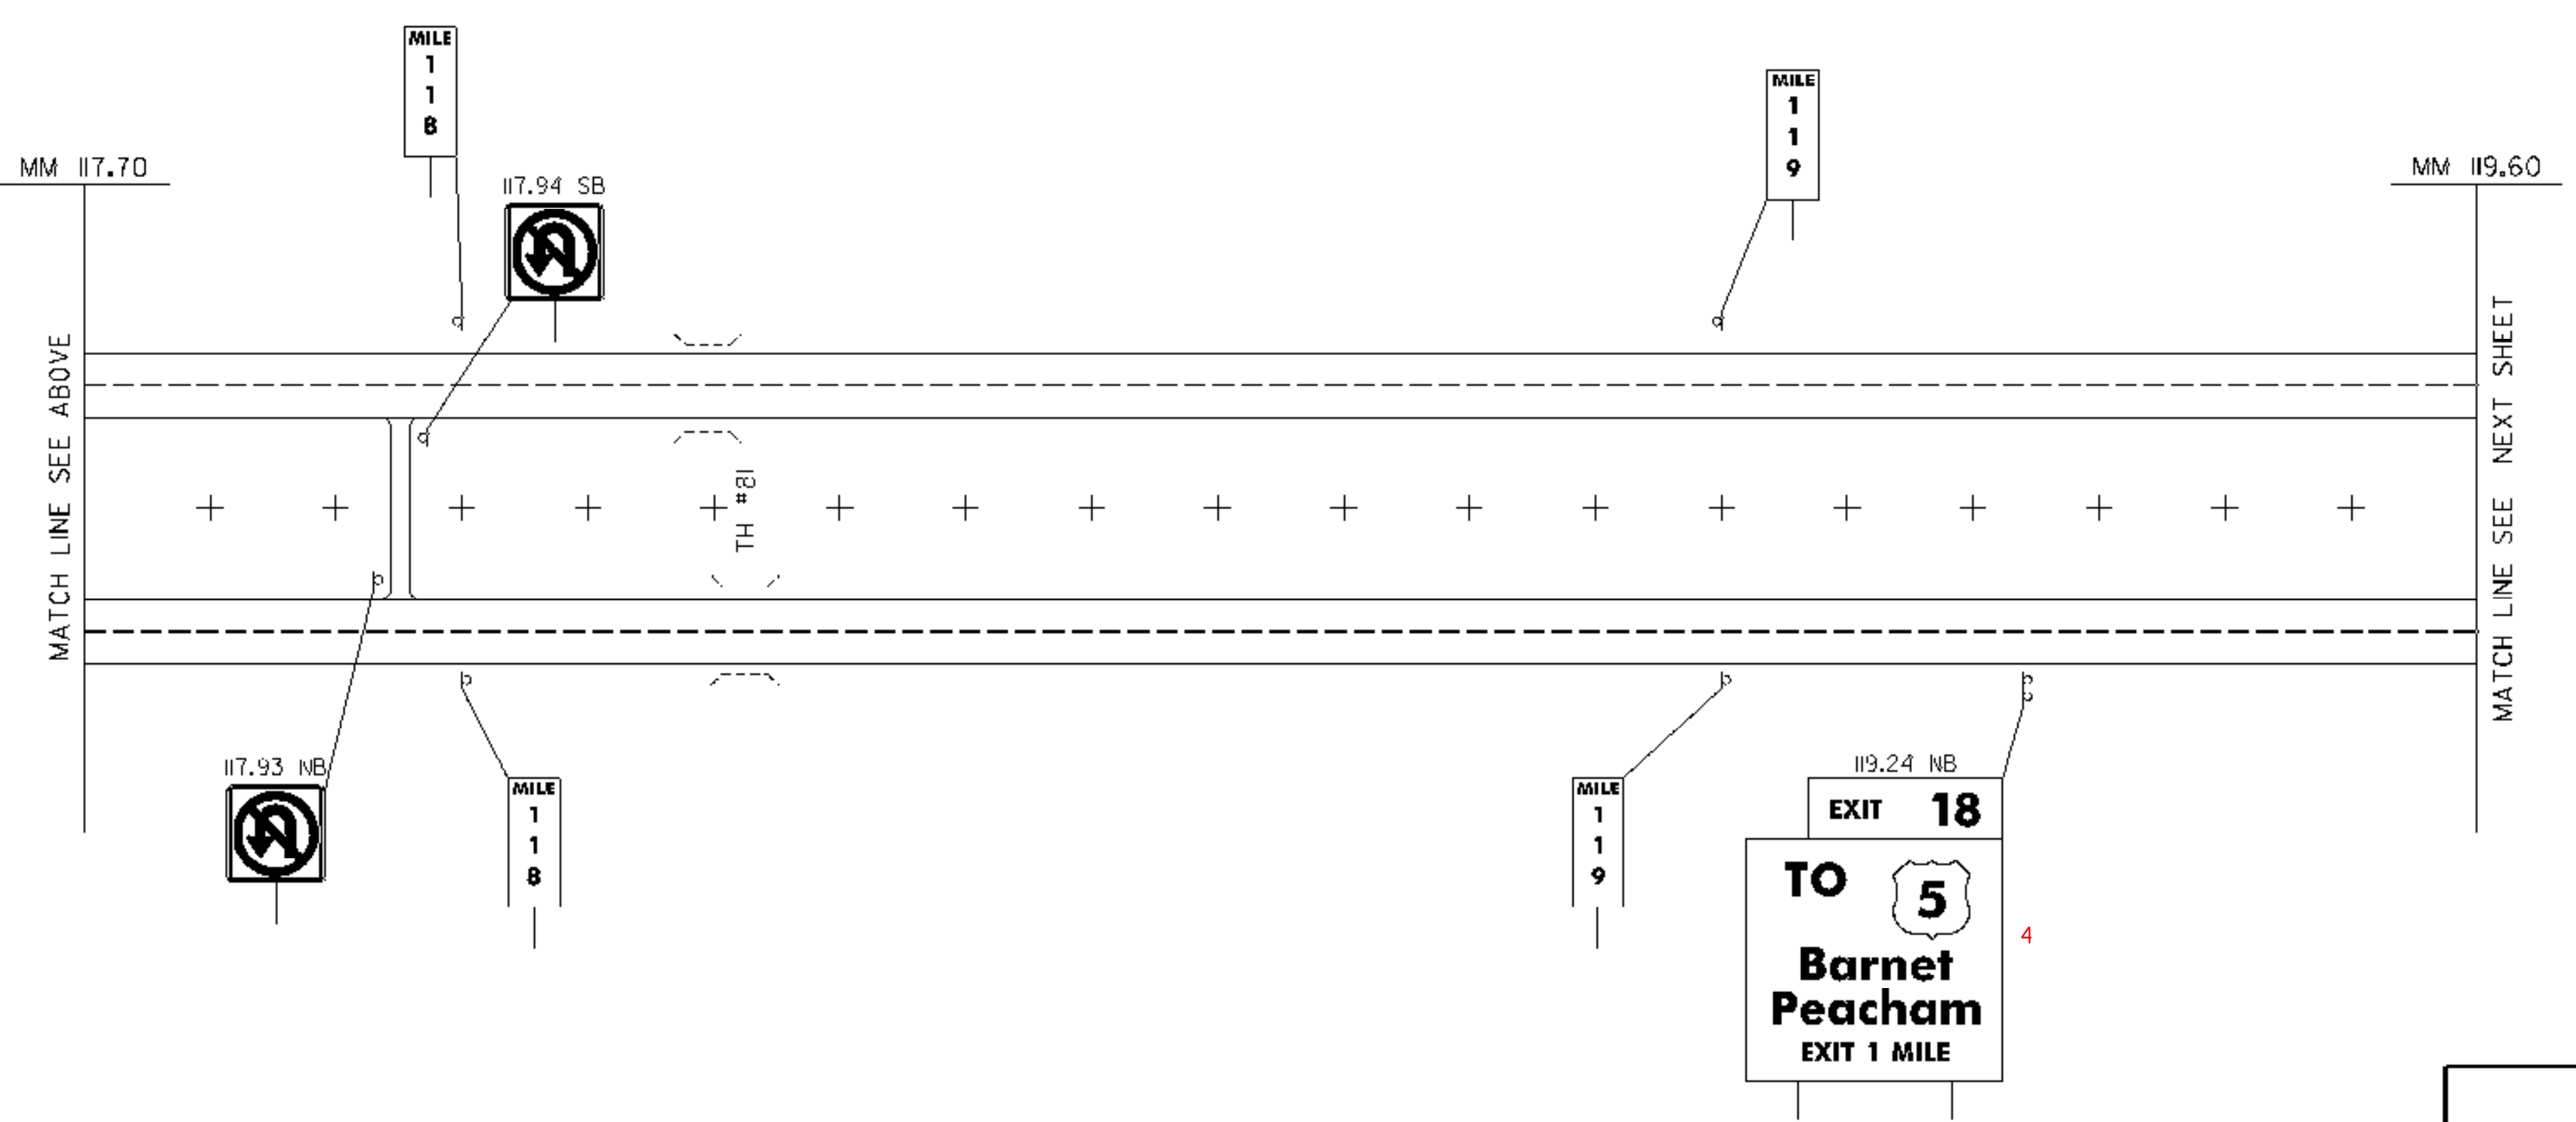


REMOVING SIGNS
 NB - TYPE A: 9
 TYPE B: 1
 BRIDGE PLAQUE: 4 (NOT SHOWN)
 SB - TYPE A: 9
 TYPE B: 2
 BRIDGE PLAQUE: 4 (NOT SHOWN)

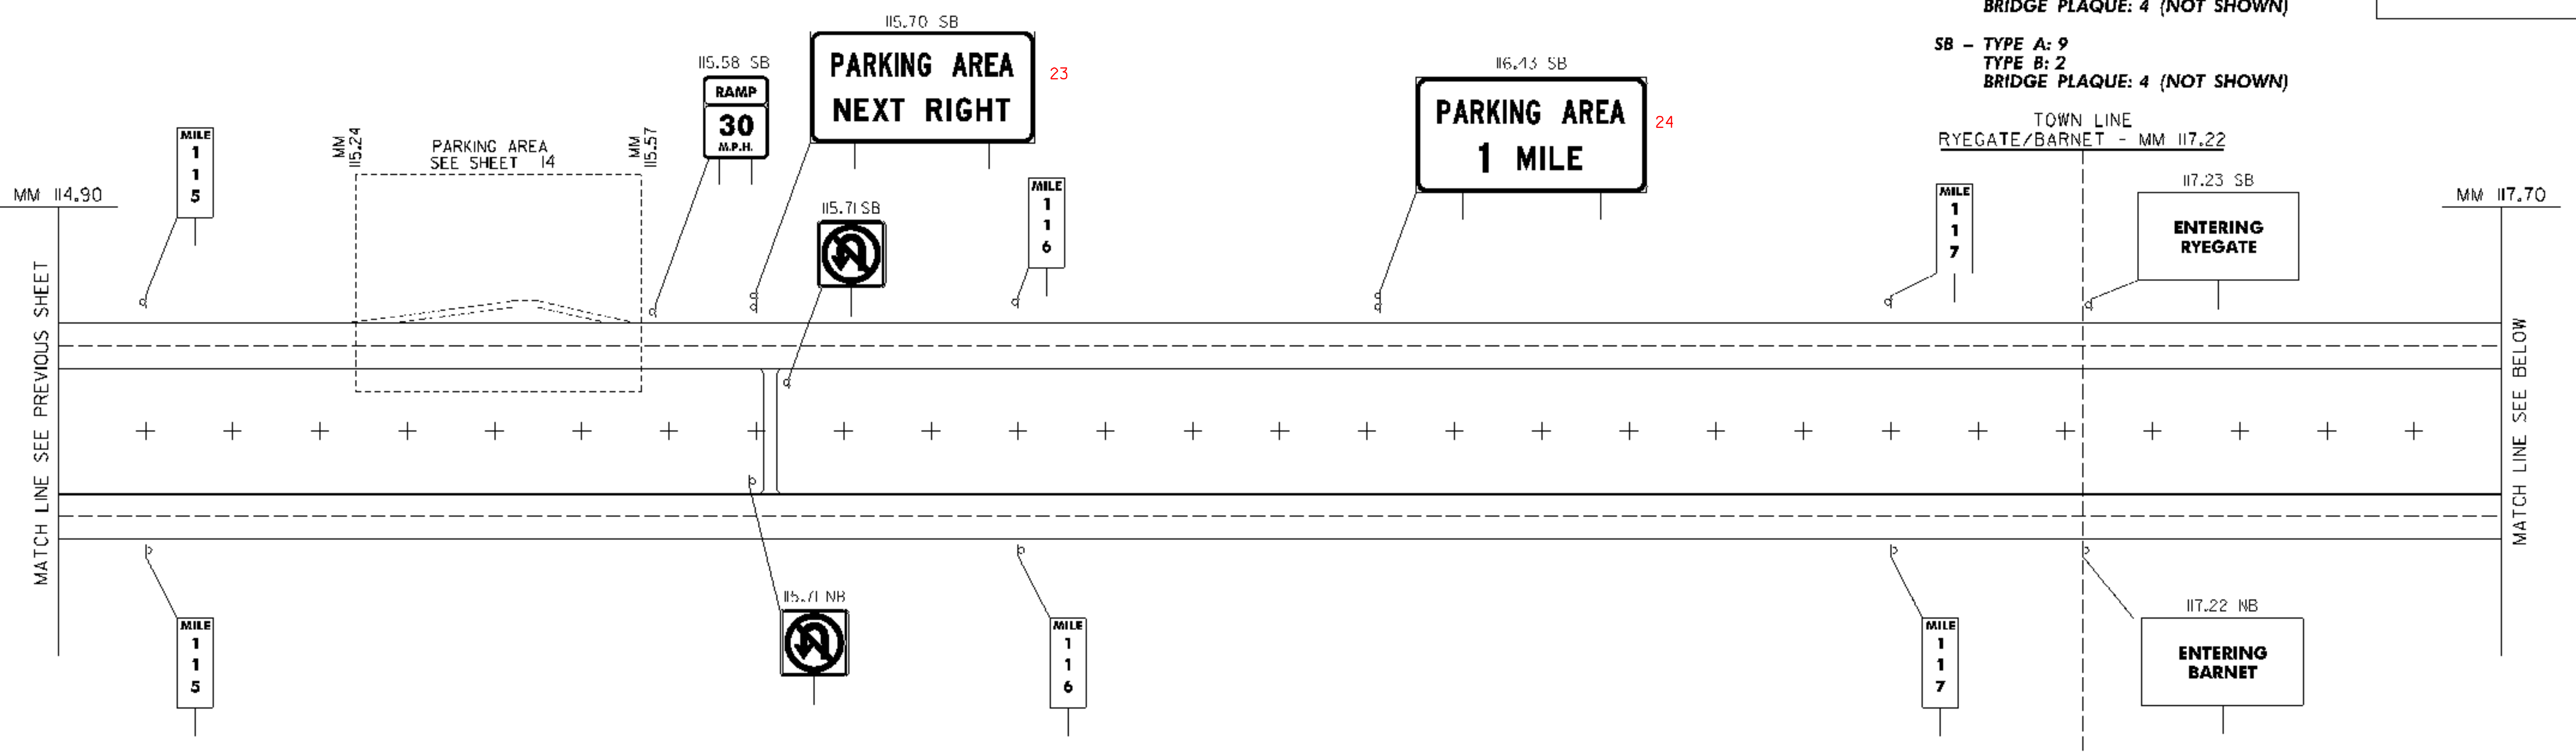

ALL SIGNS AND POSTS WILL BE REMOVED UNLESS OTHERWISE NOTED

EXISTING SIGNS	PROJECT NAME: RYEGATE-ST. JOHNSBURY	PLOT DATE: 12/13/2006
	PROJECT NUMBER: IM 091-2(73)	DRAWN BY: JCS
	FILE NAME: 97194s-ml.dgn	CHECKED BY: DAM
	DESIGNED BY: DAM	SHEET 9 OF 88
	CLD REF. NO.: 97-0194	