
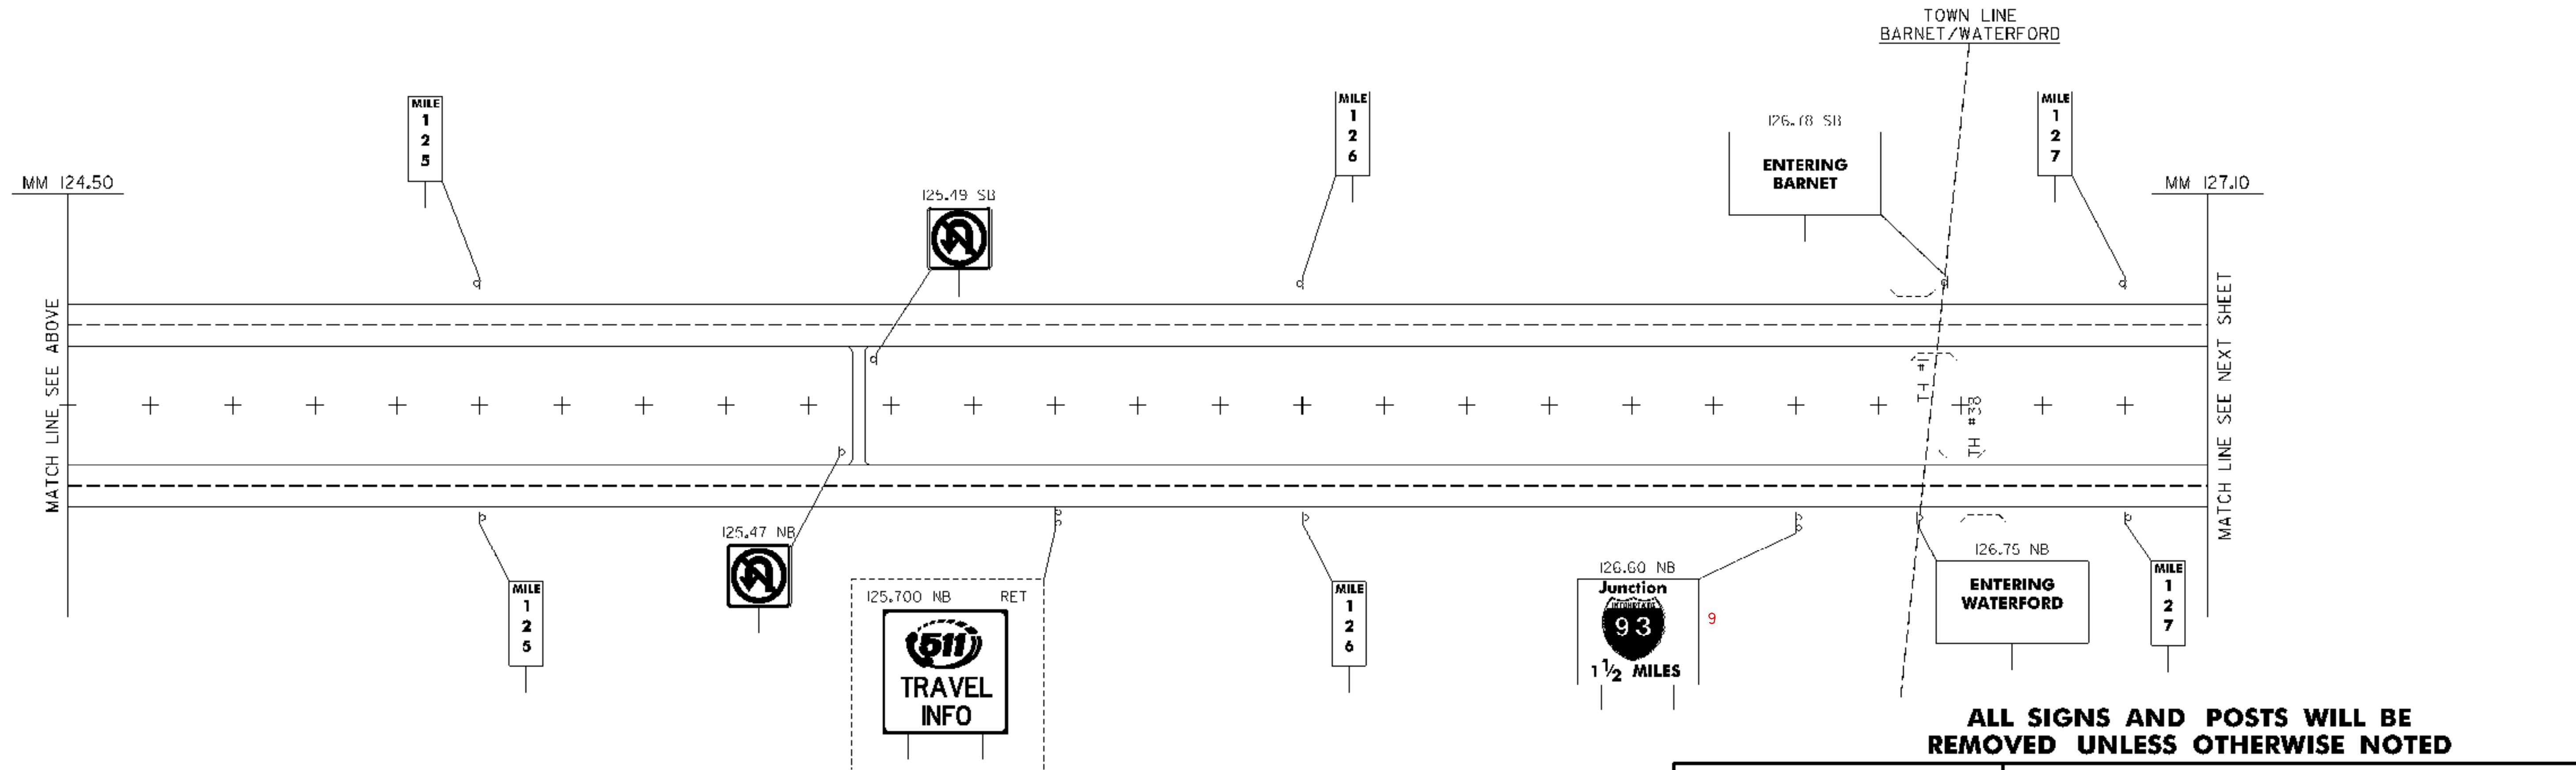


REMOVING SIGNS

NB - TYPE A: 9
 TYPE B: 1
 BRIDGE PLAQUE: 7 (NOT SHOWN)

SB - TYPE A: 9
 TYPE B: 0
 BRIDGE PLAQUE: 8 (NOT SHOWN)

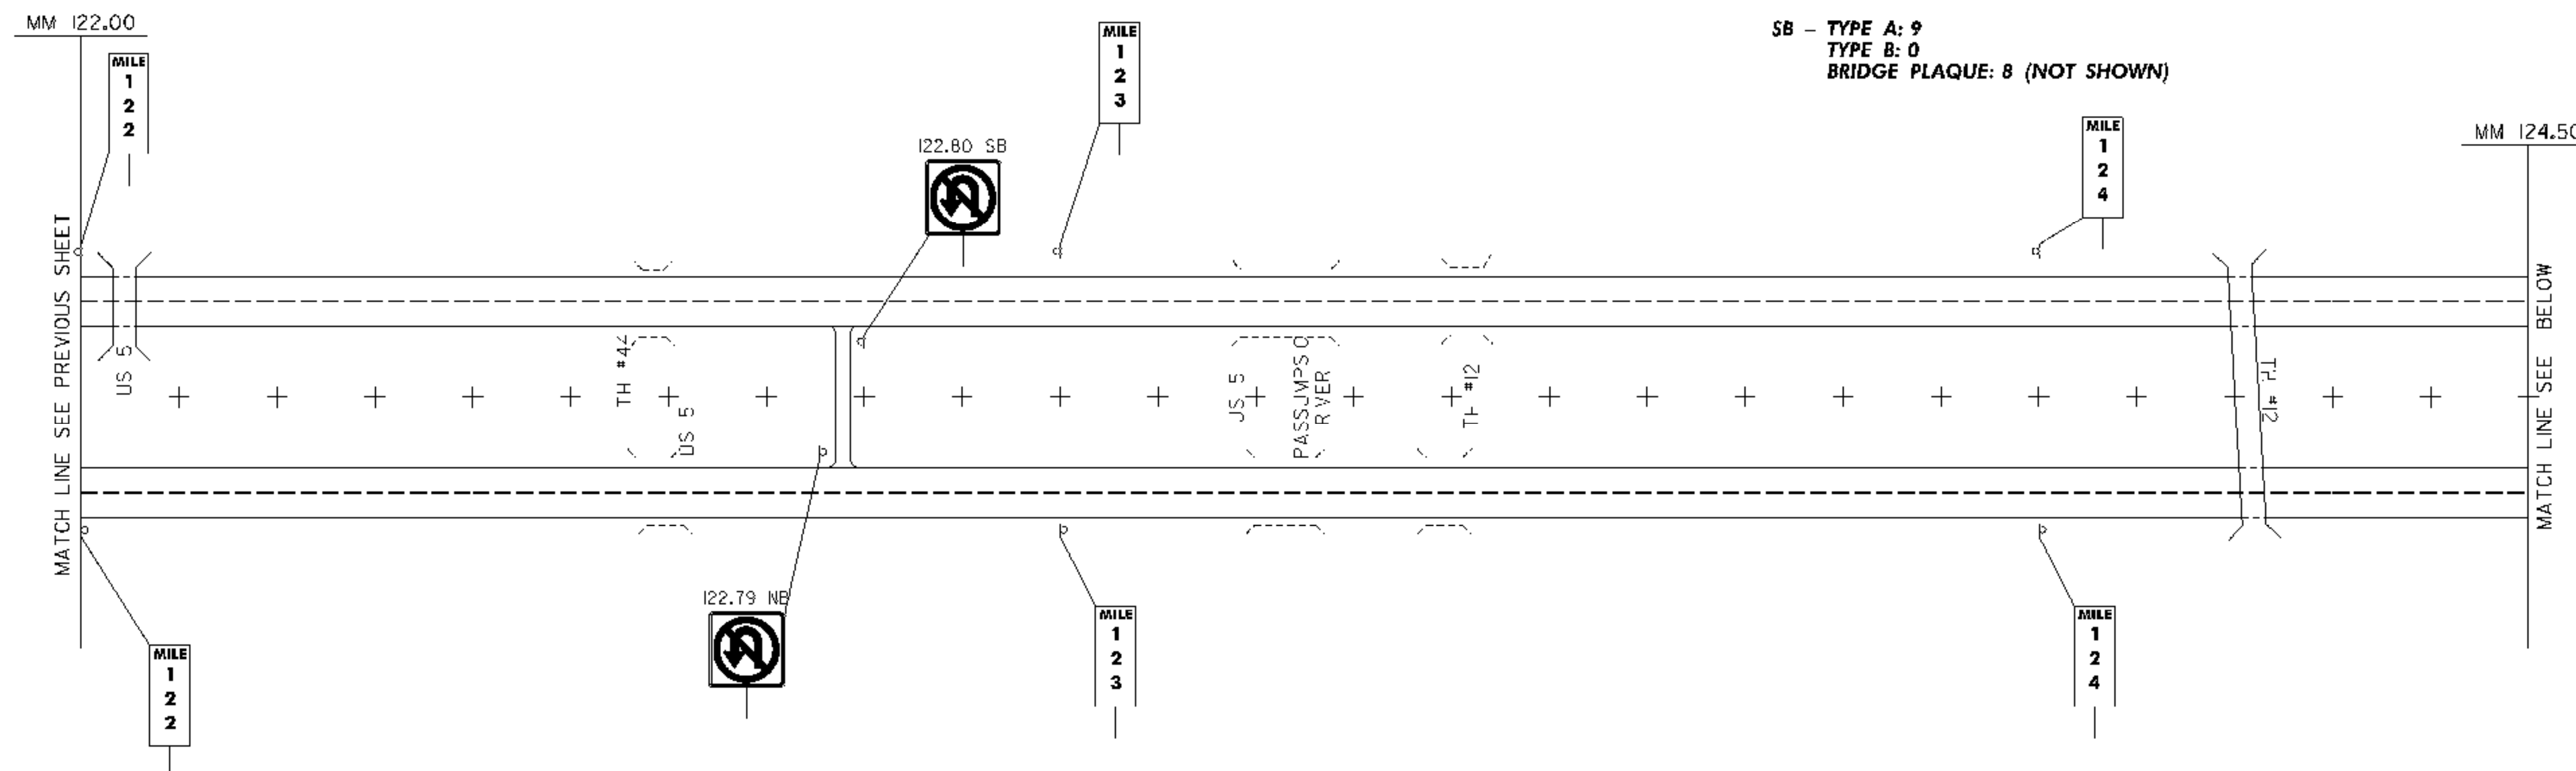

ALL SIGNS AND POSTS WILL BE REMOVED UNLESS OTHERWISE NOTED

EXISTING SIGNS

PROJECT NAME:	RYEGATE-ST. JOHNSBURY
PROJECT NUMBER:	IM 091-2(73)
FILE NAME:	97194s-m1.dgn
PROJECT LEADER:	CRB
DESIGNED BY:	DAM
CLD REF. NO.:	97-0194
PLOT DATE:	12/13/2006
DRAWN BY:	JCS
CHECKED BY:	DAM
SHEET	11 OF 88