


**REMOVING SIGNS**

NB - TYPE A: 3  
TYPE B: 5

SB - TYPE A: 8  
TYPE B: 1

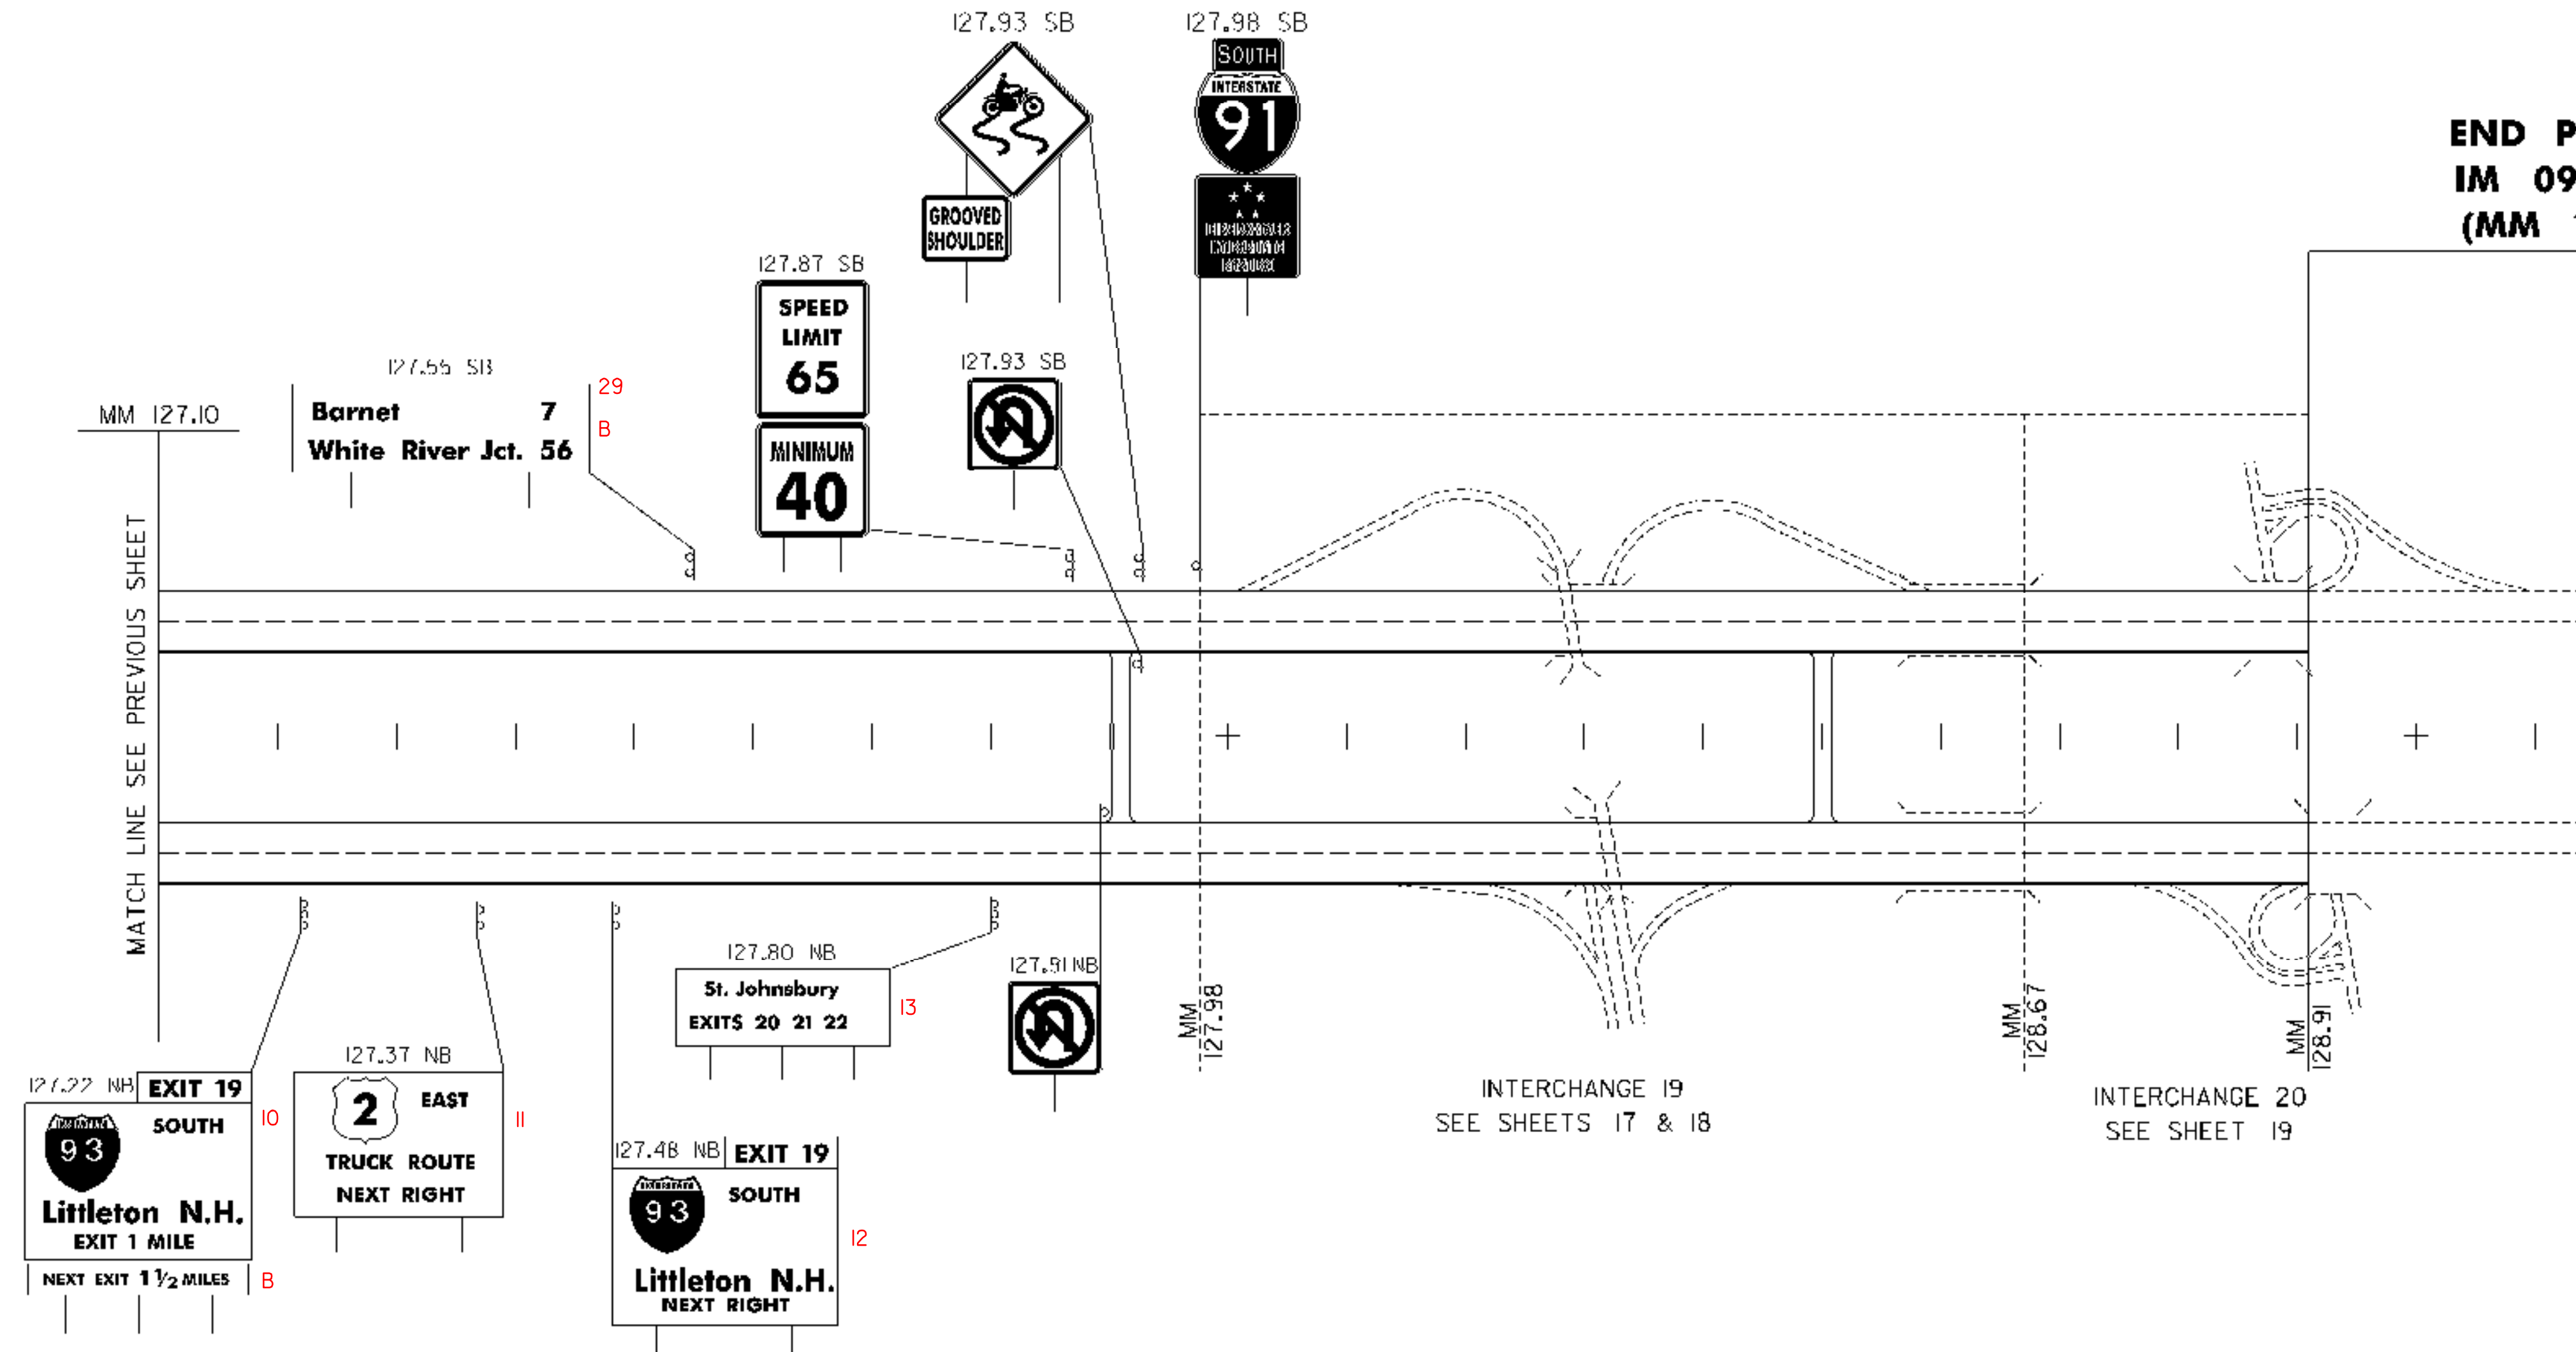

**END PROJECT**  
**IM 091-2(73)**  
**(MM 128.91)**

**ALL SIGNS AND POSTS WILL BE REMOVED UNLESS OTHERWISE NOTED**

**EXISTING SIGNS**

PROJECT NAME: RYEGATE-ST. JOHNSBURY

PROJECT NUMBER: IM 091-2(73)

FILE NAME: 97194s-m1.dgn

PROJECT LEADER: CRB

DESIGNED BY: DAM

CLD REF. NO.: 97-0194

PLOT DATE: 12/13/2006

DRAWN BY: JCS

CHECKED BY: DAM

SHEET 12 OF 88