


REMOVING SIGNS

TYPE A: 8
TYPE B: 1

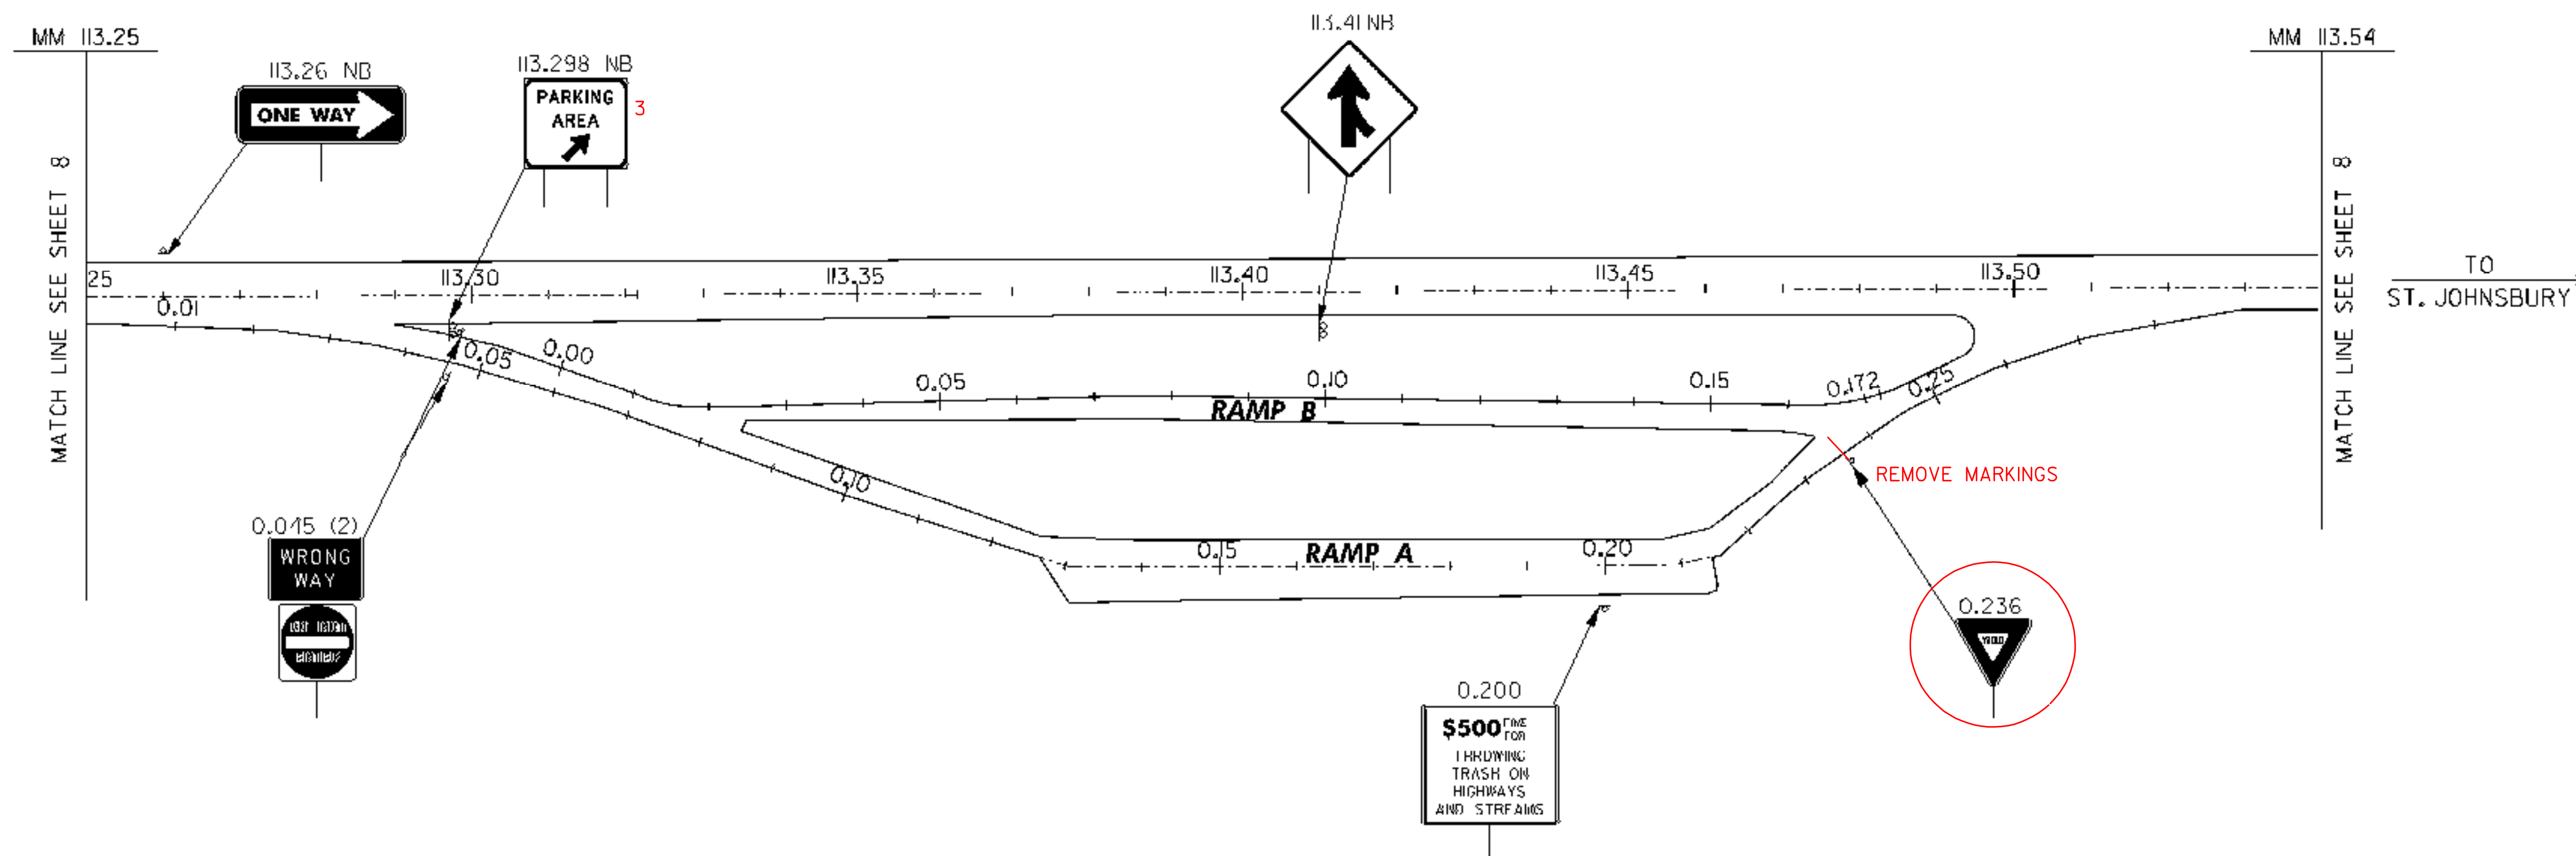

LEGEND

----- RET - RETAINED

ALL SIGNS AND POSTS WILL BE REMOVED UNLESS OTHERWISE NOTED

**PARKING AREA
113.39 I-91 NB
EXISTING SIGNS**

PROJECT NAME: RYEGATE-ST. JOHNSBURY

PROJECT NUMBER: IM 091-2(73)

FILE NAME: 97194s-ra.dgn

PROJECT LEADER: CRB

DESIGNED BY: DAM

CLD REF. NO.: 97-0194

PLOT DATE: 12/13/2006

DRAWN BY: JCS

CHECKED BY: DAM

SHEET 13 OF 88