


REMOVING SIGNS
 TYPE A: 15
 TYPE B: 1

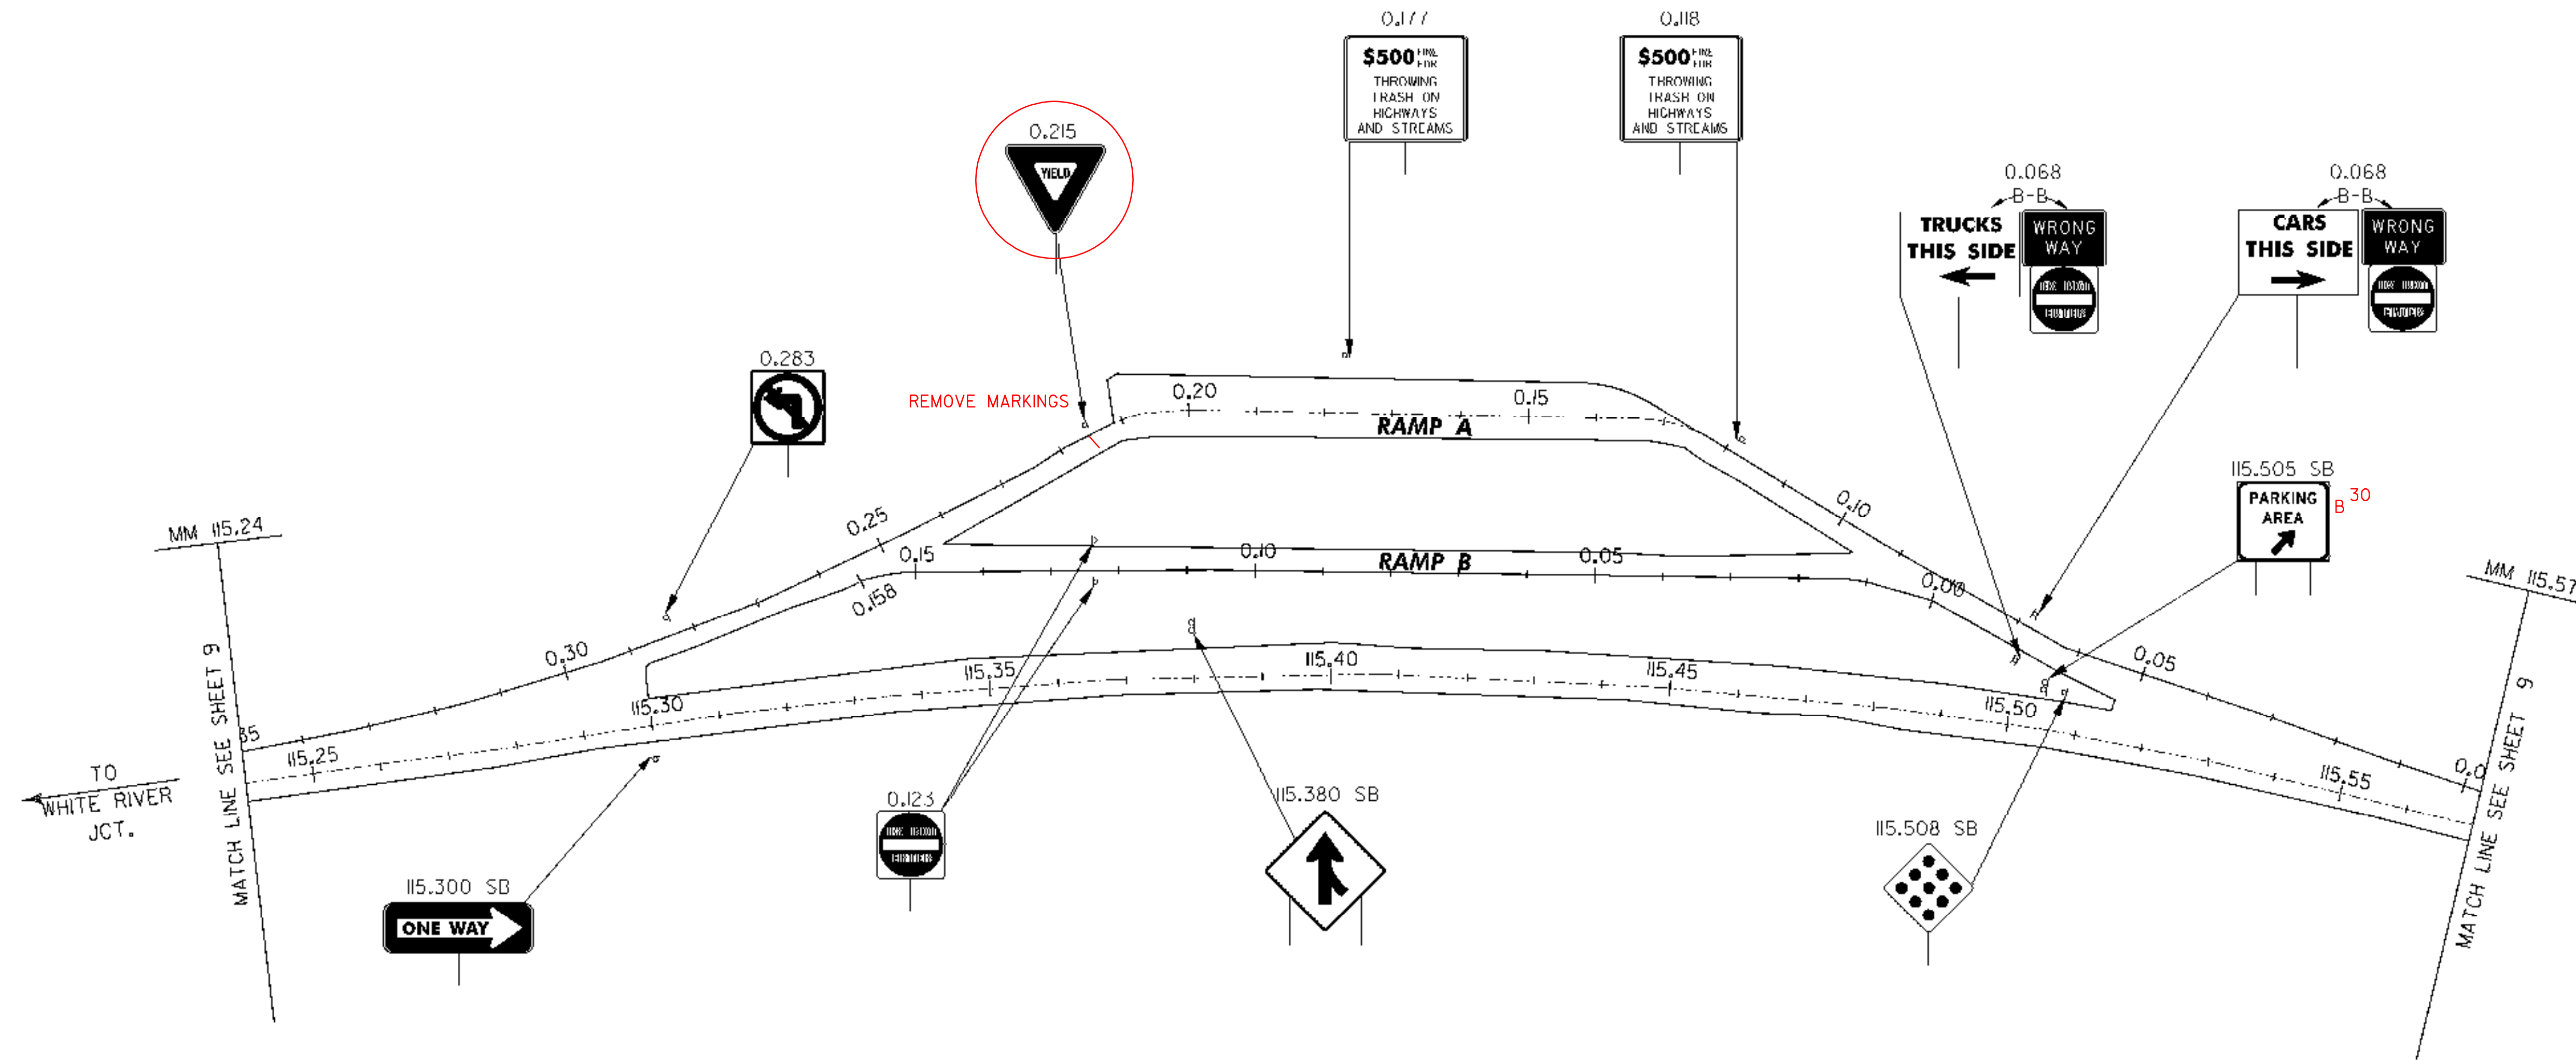

LEGEND

RET - RETAINED

ALL SIGNS AND POSTS WILL BE REMOVED UNLESS OTHERWISE NOTED

**PARKING AREA
 115.40 I-91 SB
 EXISTING SIGNS**

PROJECT NAME: RYEGATE-ST. JOHNSBURY
 PROJECT NUMBER: IM 091-2(73)

FILE NAME: 97194s-rd.dgn
 PROJECT LEADER: CRB
 DESIGNED BY: DAM
 CLD REF. NO.: 97-0194

PLOT DATE: 12/13/2006
 DRAWN BY: JCS
 CHECKED BY: DAM
 SHEET 14 OF 88