


REMOVING SIGNS
 TYPE A: 98
 TYPE B: 4
 BRIDGE PLAQUE: 4 (NOT SHOWN)

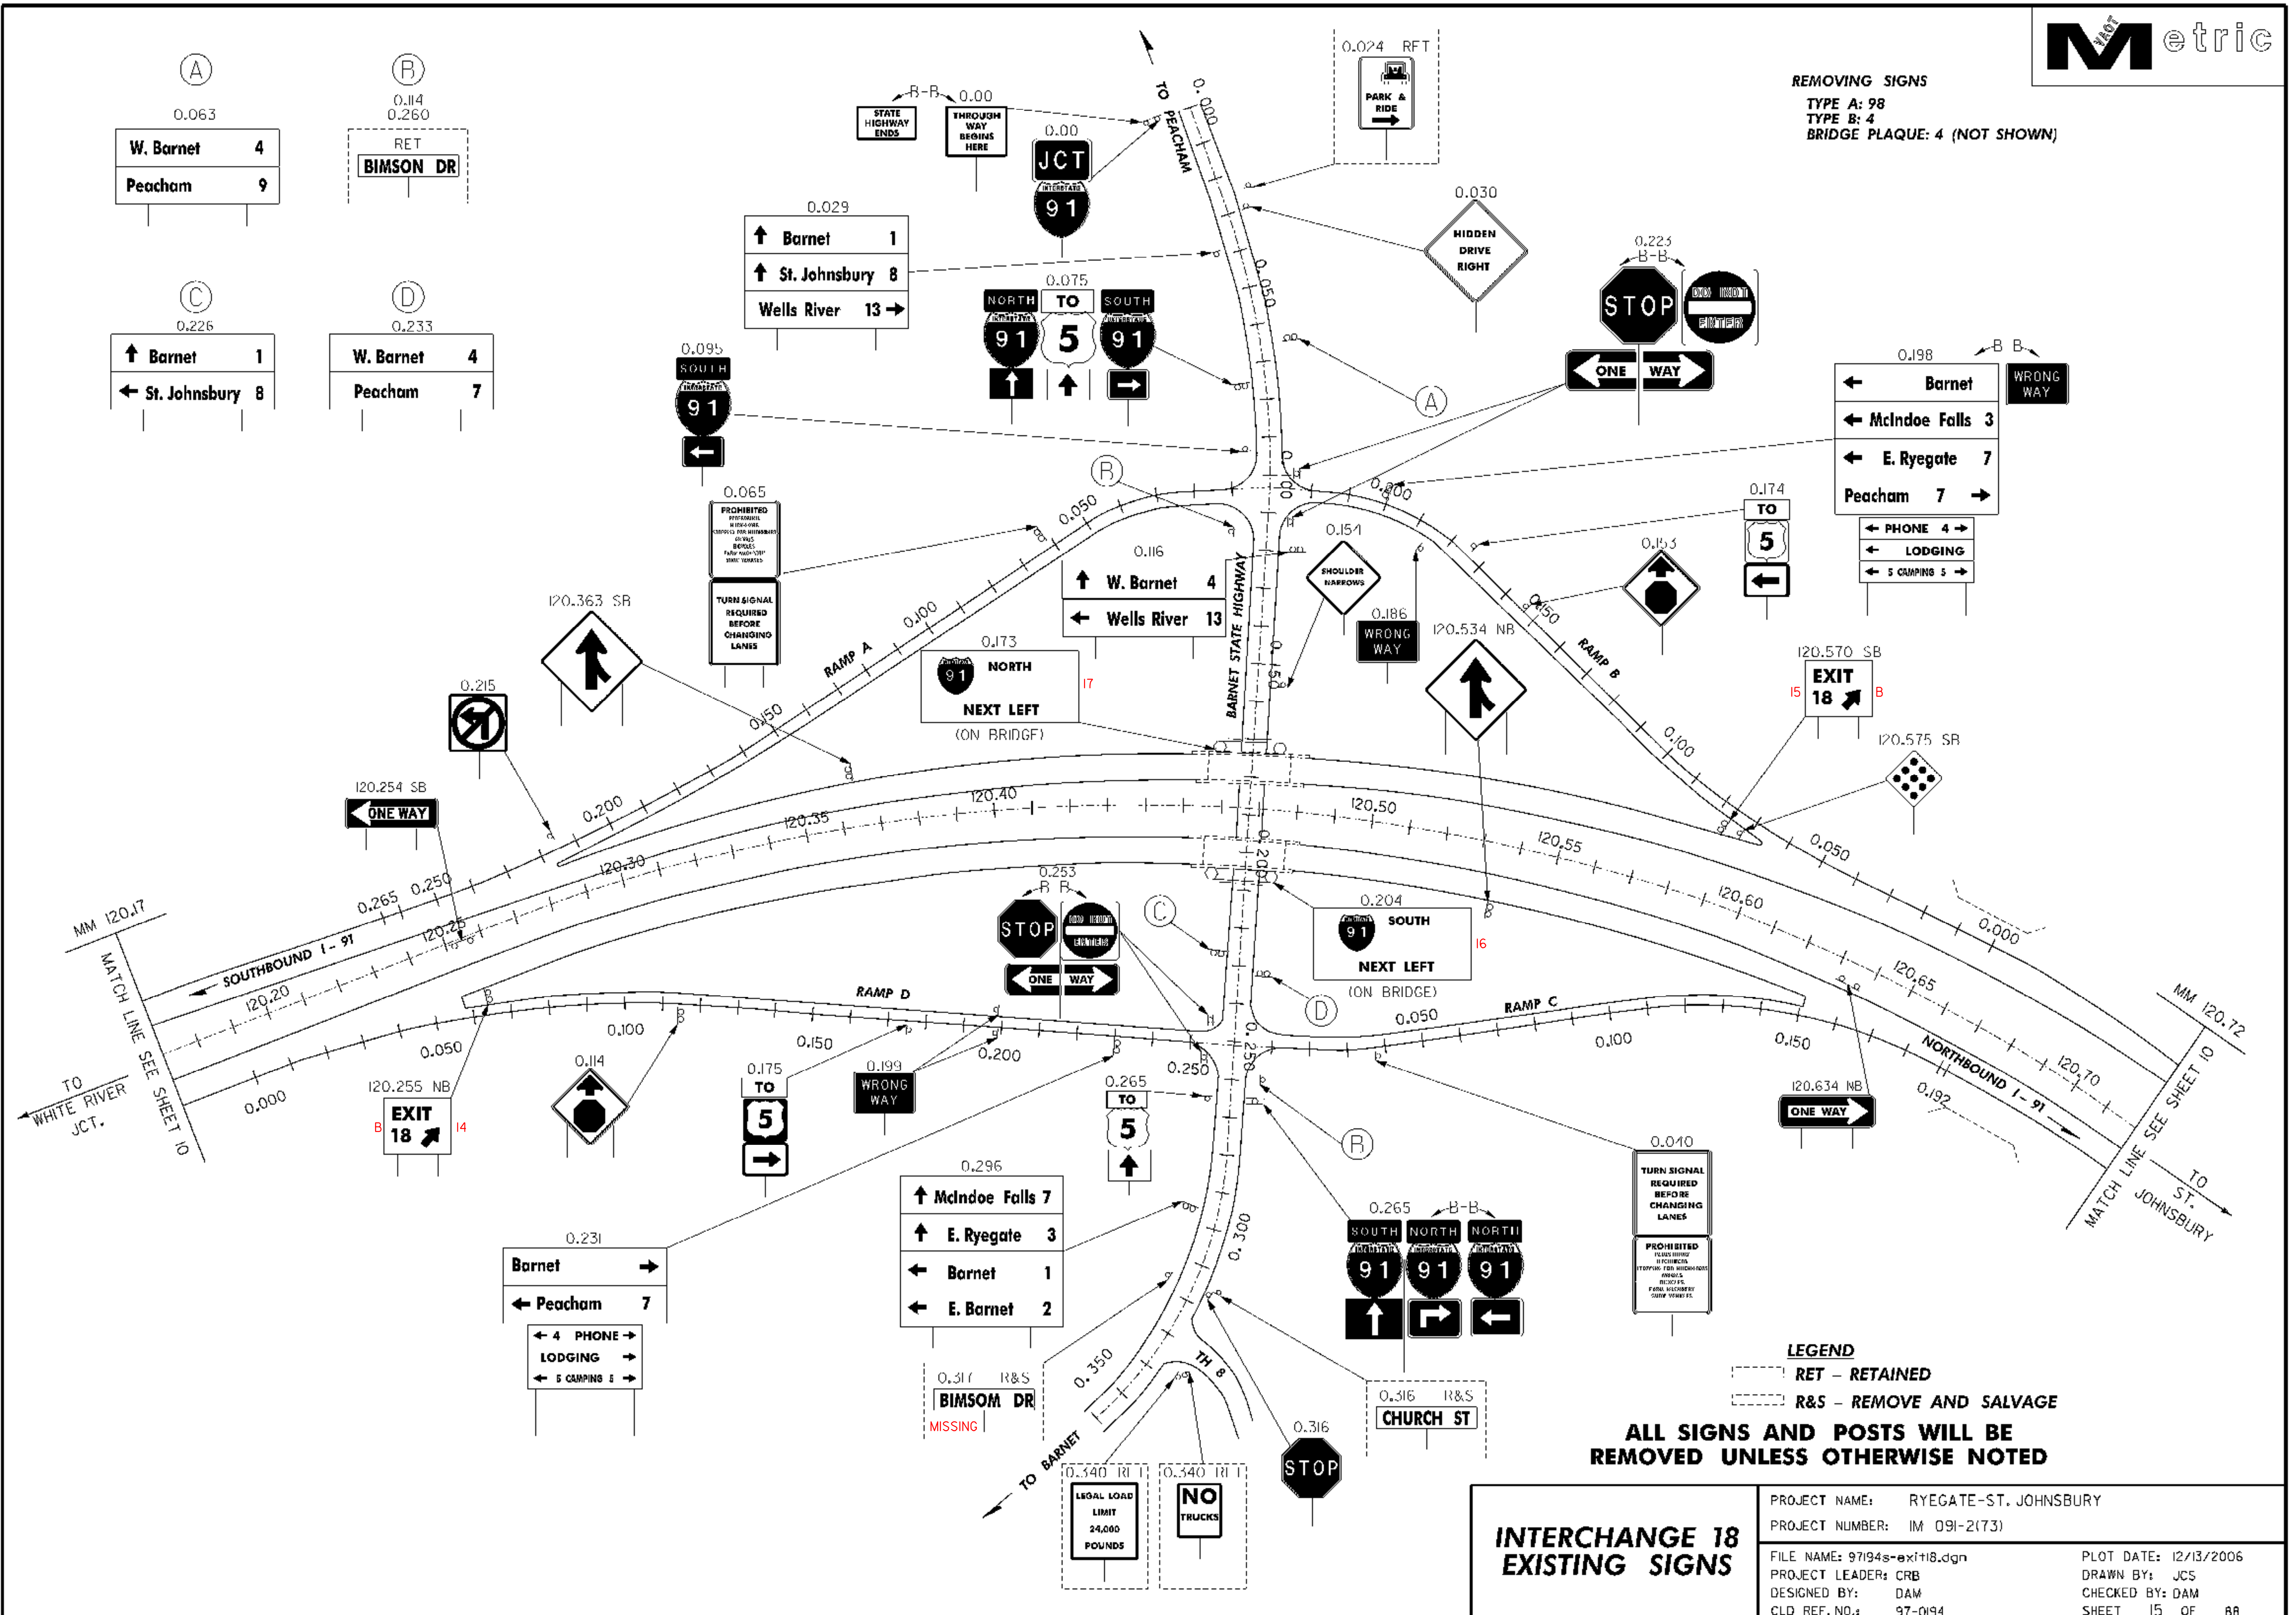

(A)
 0.063
 W. Barnet 4
 Peacham 9

(B)
 0.114
 0.260
 RET
 BIMSOM DR

(C)
 0.226
 ↑ Barnet 1
 ← St. Johnsbury 8

(D)
 0.233
 W. Barnet 4
 Peacham 7

0.029
 ↑ Barnet 1
 ↑ St. Johnsbury 8
 Wells River 13 →

0.075
 NORTH TO SOUTH
 91 5 91

0.065
 PROHIBITED
 TURN SIGNAL
 REQUIRED BEFORE
 CHANGING LANES

0.173
 NORTH
 NEXT LEFT
 (ON BRIDGE)

0.116
 ↑ W. Barnet 4
 ← Wells River 13

0.204
 SOUTH
 NEXT LEFT
 (ON BRIDGE)

0.296
 ↑ McIndoe Falls 7
 ↑ E. Ryegate 3
 ← Barnet 1
 ← E. Barnet 2

0.340 RI
 LEGAL LOAD
 LIMIT
 24,000
 POUNDS

0.340 RI
 NO TRUCKS

LEGEND
 RET - RETAINED
 R&S - REMOVE AND SALVAGE

ALL SIGNS AND POSTS WILL BE REMOVED UNLESS OTHERWISE NOTED

INTERCHANGE 18 EXISTING SIGNS

PROJECT NAME: RYEGATE-ST. JOHNSBURY	PROJECT NUMBER: IM 091-2(173)
FILE NAME: 97194s-exit18.dgn	CLD REF. NO.: 97-0194
PROJECT LEADER: CRB	DESIGNED BY: DAM
DRAWN BY: JCS	CHECKED BY: DAM
DATE: 12/13/2006	SHEET 15 OF 88