


REMOVING SIGNS  
 TYPE A: 9  
 TYPE B: 1

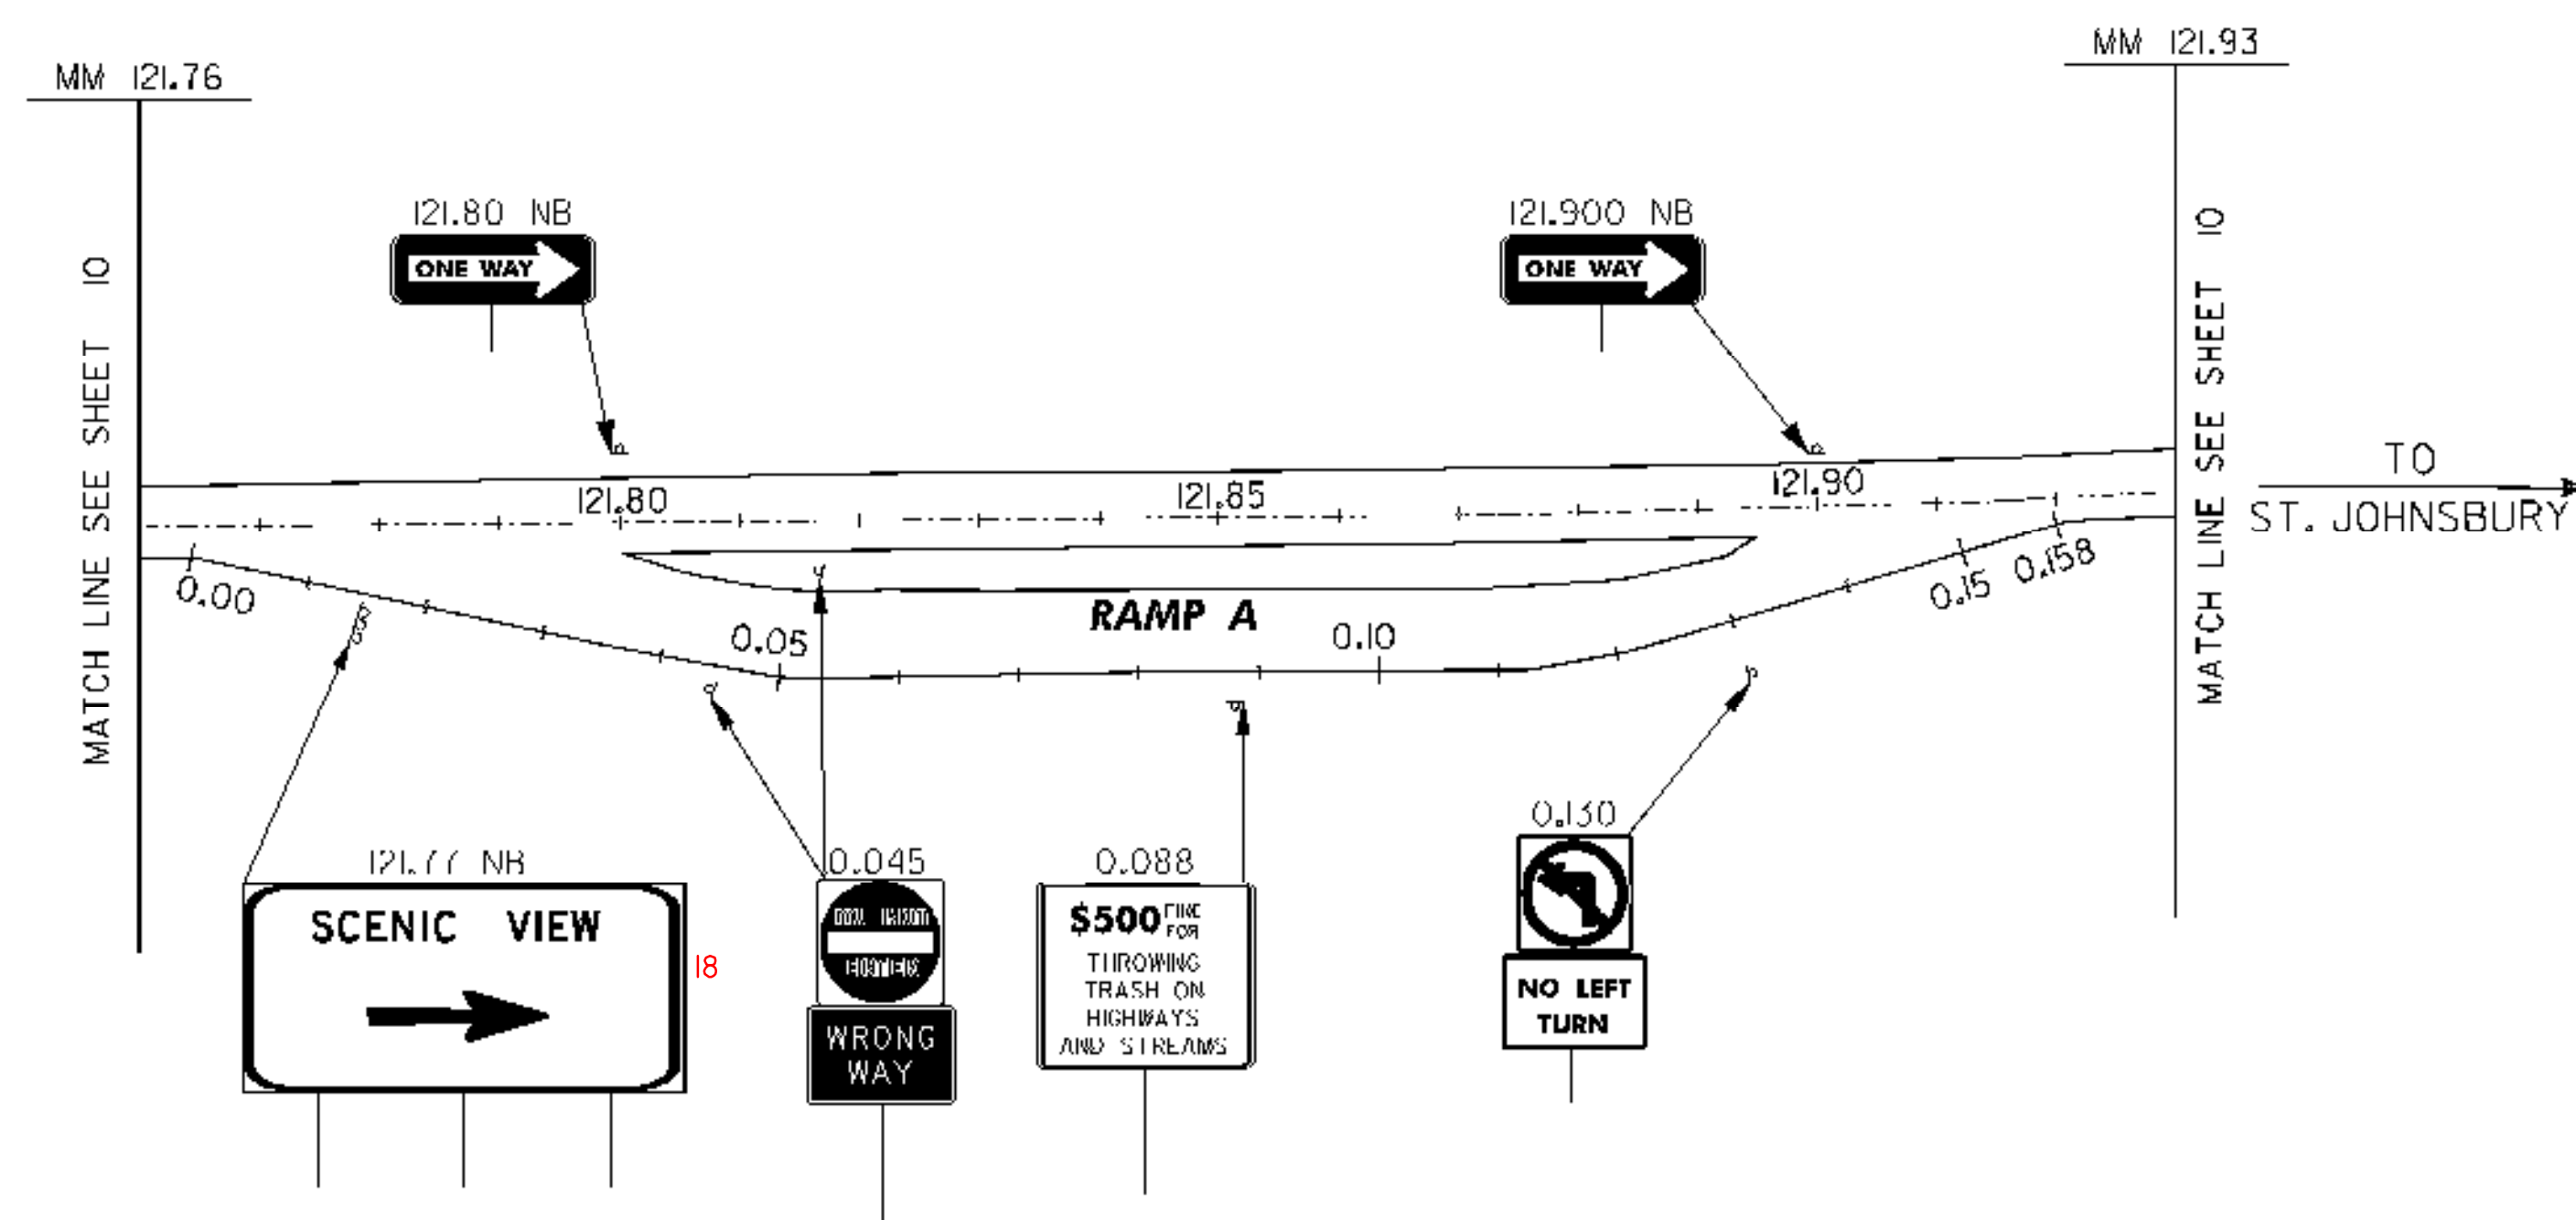

**LEGEND**

RET - RETAINED

**ALL SIGNS AND POSTS WILL BE REMOVED UNLESS OTHERWISE NOTED**

**SCENIC VIEW  
 121.83 I-91 NB  
 EXISTING SIGNS**

PROJECT NAME:	RYEGATE-ST. JOHNSBURY
PROJECT NUMBER:	IM 091-2(73)
FILE NAME:	97194s-ra.dgn
PROJECT LEADER:	CRB
DESIGNED BY:	DAM
CLD REF. NO.:	97-0194
PLOT DATE:	12/13/2006
DRAWN BY:	JCS
CHECKED BY:	DAM
SHEET	16 OF 88