


Accel. lane taper ends at 115.136 ±
865' from Gore
Use 9 Type II Delineators

Decel. lane taper begins at 115.59 ±
375' from Gore
Use 4 Type II Delineators

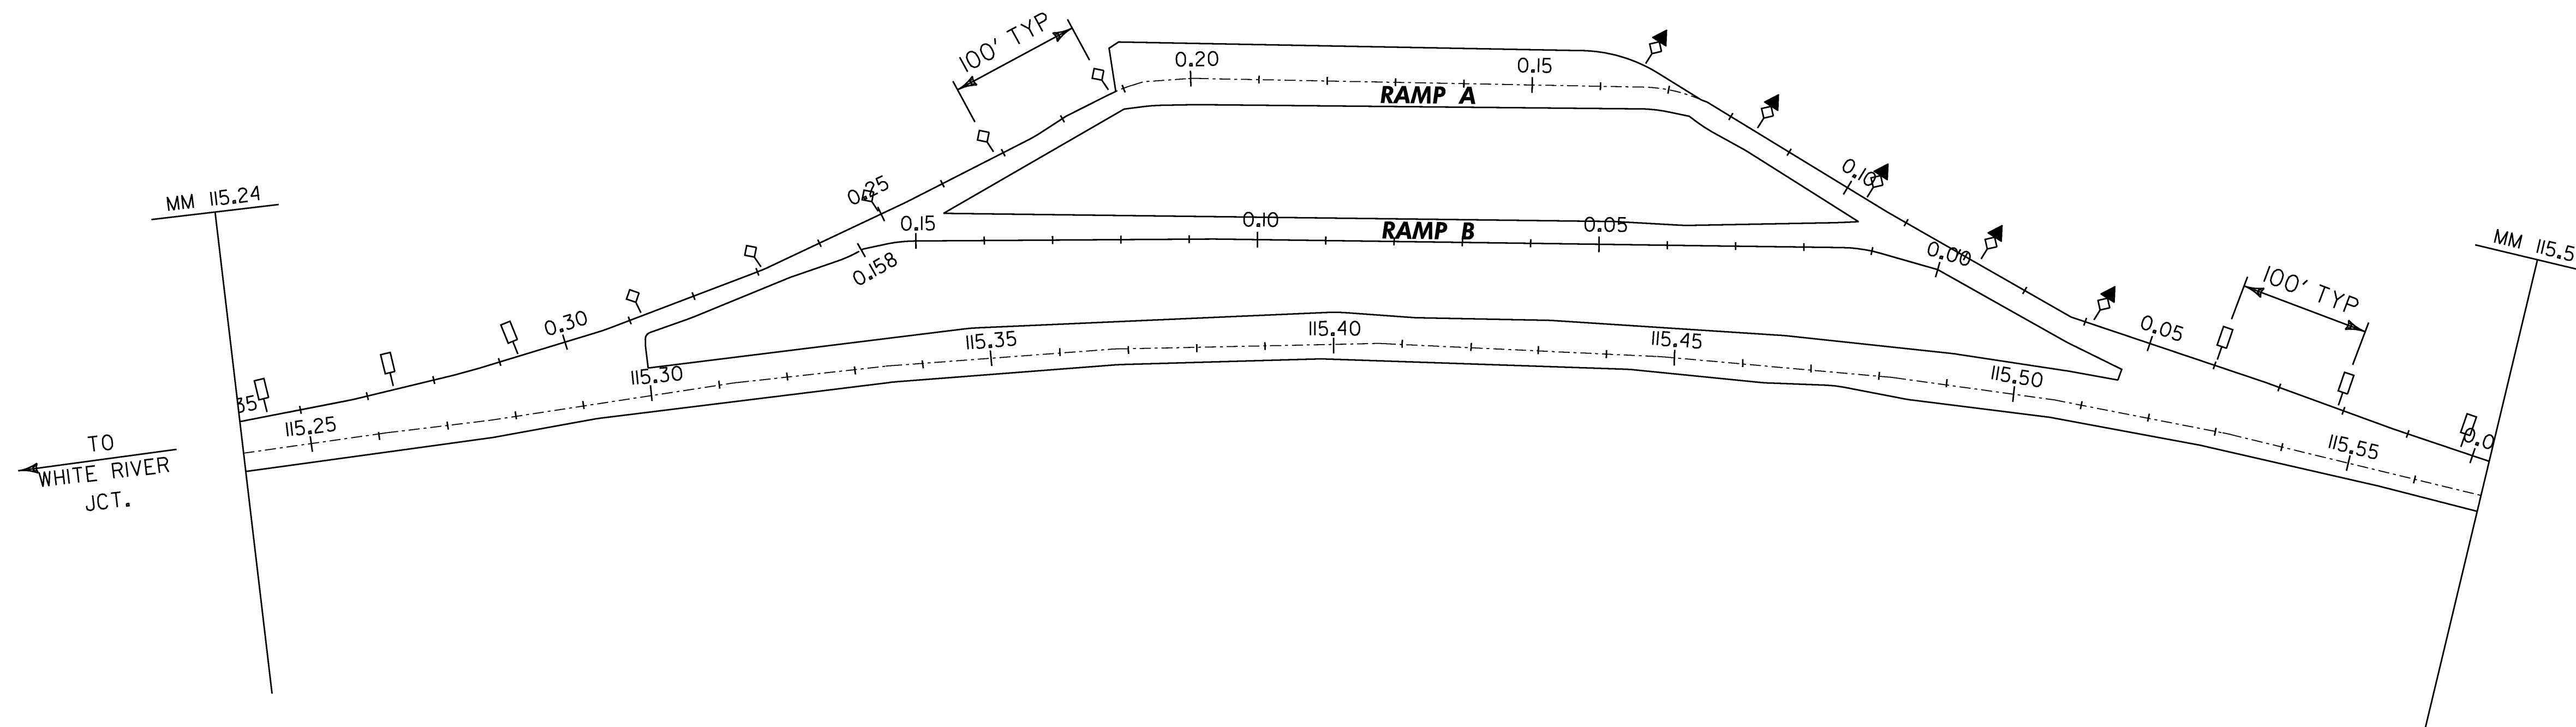

LEGEND

- ◇ TYPE I (WHITE)
- ◆ TYPE I (YELLOW)
- TYPE II (WHITE)
- ◆ TYPE III (RED ON BACK, WHITE)
- ◆ TYPE III (RED ON BACK, YELLOW)

**PARKING AREA
115.40 I-91 SB
DELINEATOR LAYOUT**

PROJECT NAME: RYEGATE-ST. JOHNSBURY	PLOT DATE: 12/13/2006
PROJECT NUMBER: IM 091-2(73)	DRAWN BY: JCS
FILE NAME: 97194s-ra.dgn	CHECKED BY: DAM
PROJECT LEADER: CRB	SHEET 33 OF 88
DESIGNED BY: DAM	
CLD REF. NO.: 97-0194	