


Decel. lane taper begins at 121.682 ±
660' from Gore
Use 7 Type II Delineators

Accel. lane taper ends at 122.00 ±
550' from Gore
Use 6 Type II Delineators

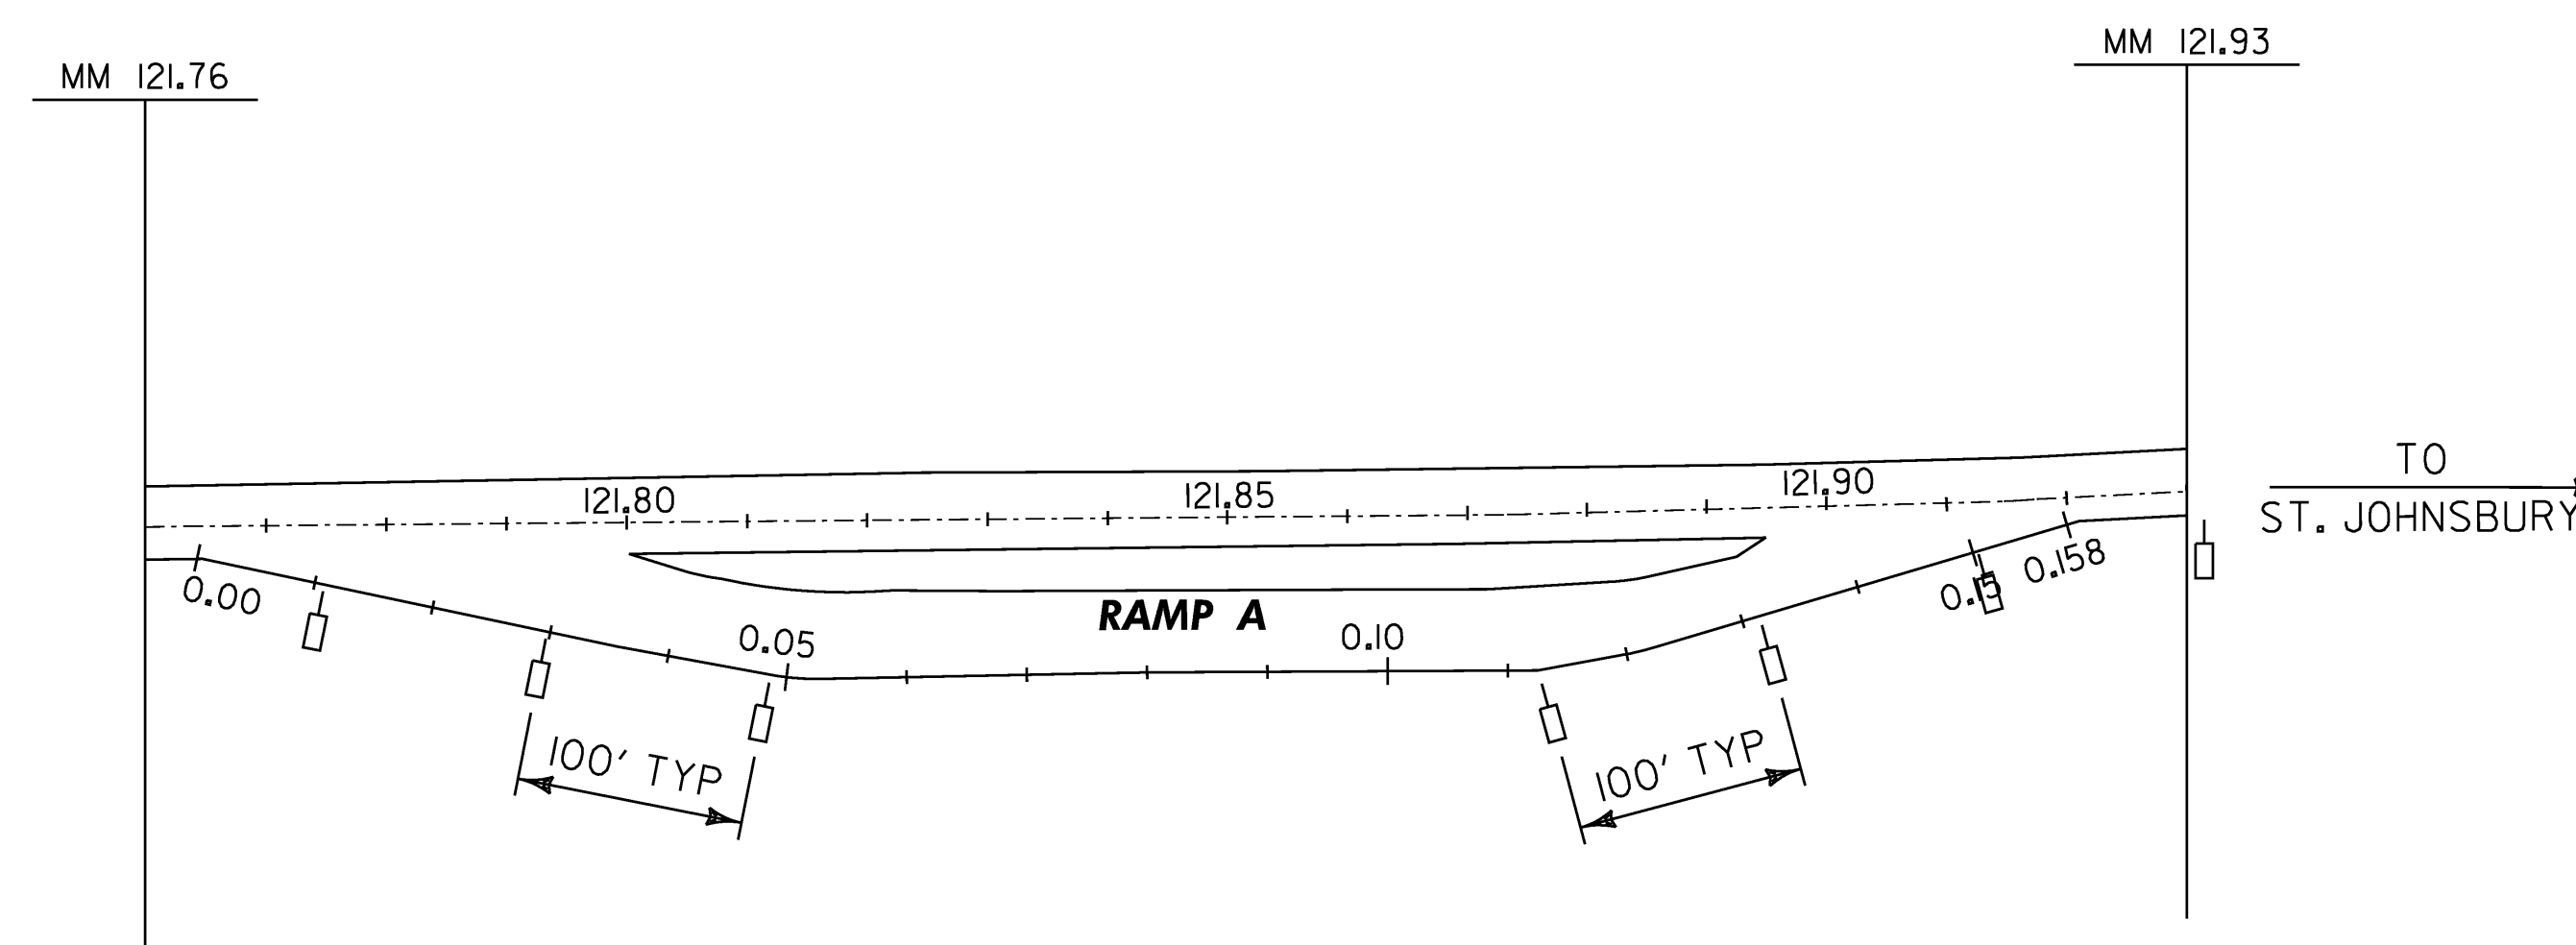

LEGEND

- ◇ TYPE I (WHITE)
- ◆ TYPE I (YELLOW)
- TYPE II (WHITE)
- ◆ TYPE III (RED ON BACK, WHITE)
- ◆ TYPE III (RED ON BACK, YELLOW)

**SCENIC VIEW
121.83 I-91 NB
DELINEATOR LAYOUT**

PROJECT NAME: RYEGATE-ST. JOHNSBURY	PLOT DATE: 12/13/2006
PROJECT NUMBER: IM 091-2(73)	DRAWN BY: JCS
FILE NAME: 97194s-ra.dgn	CHECKED BY: DAM
PROJECT LEADER: CRB	SHEET 35 OF 88
DESIGNED BY: DAM	
CLD REF. NO.: 97-0194	