

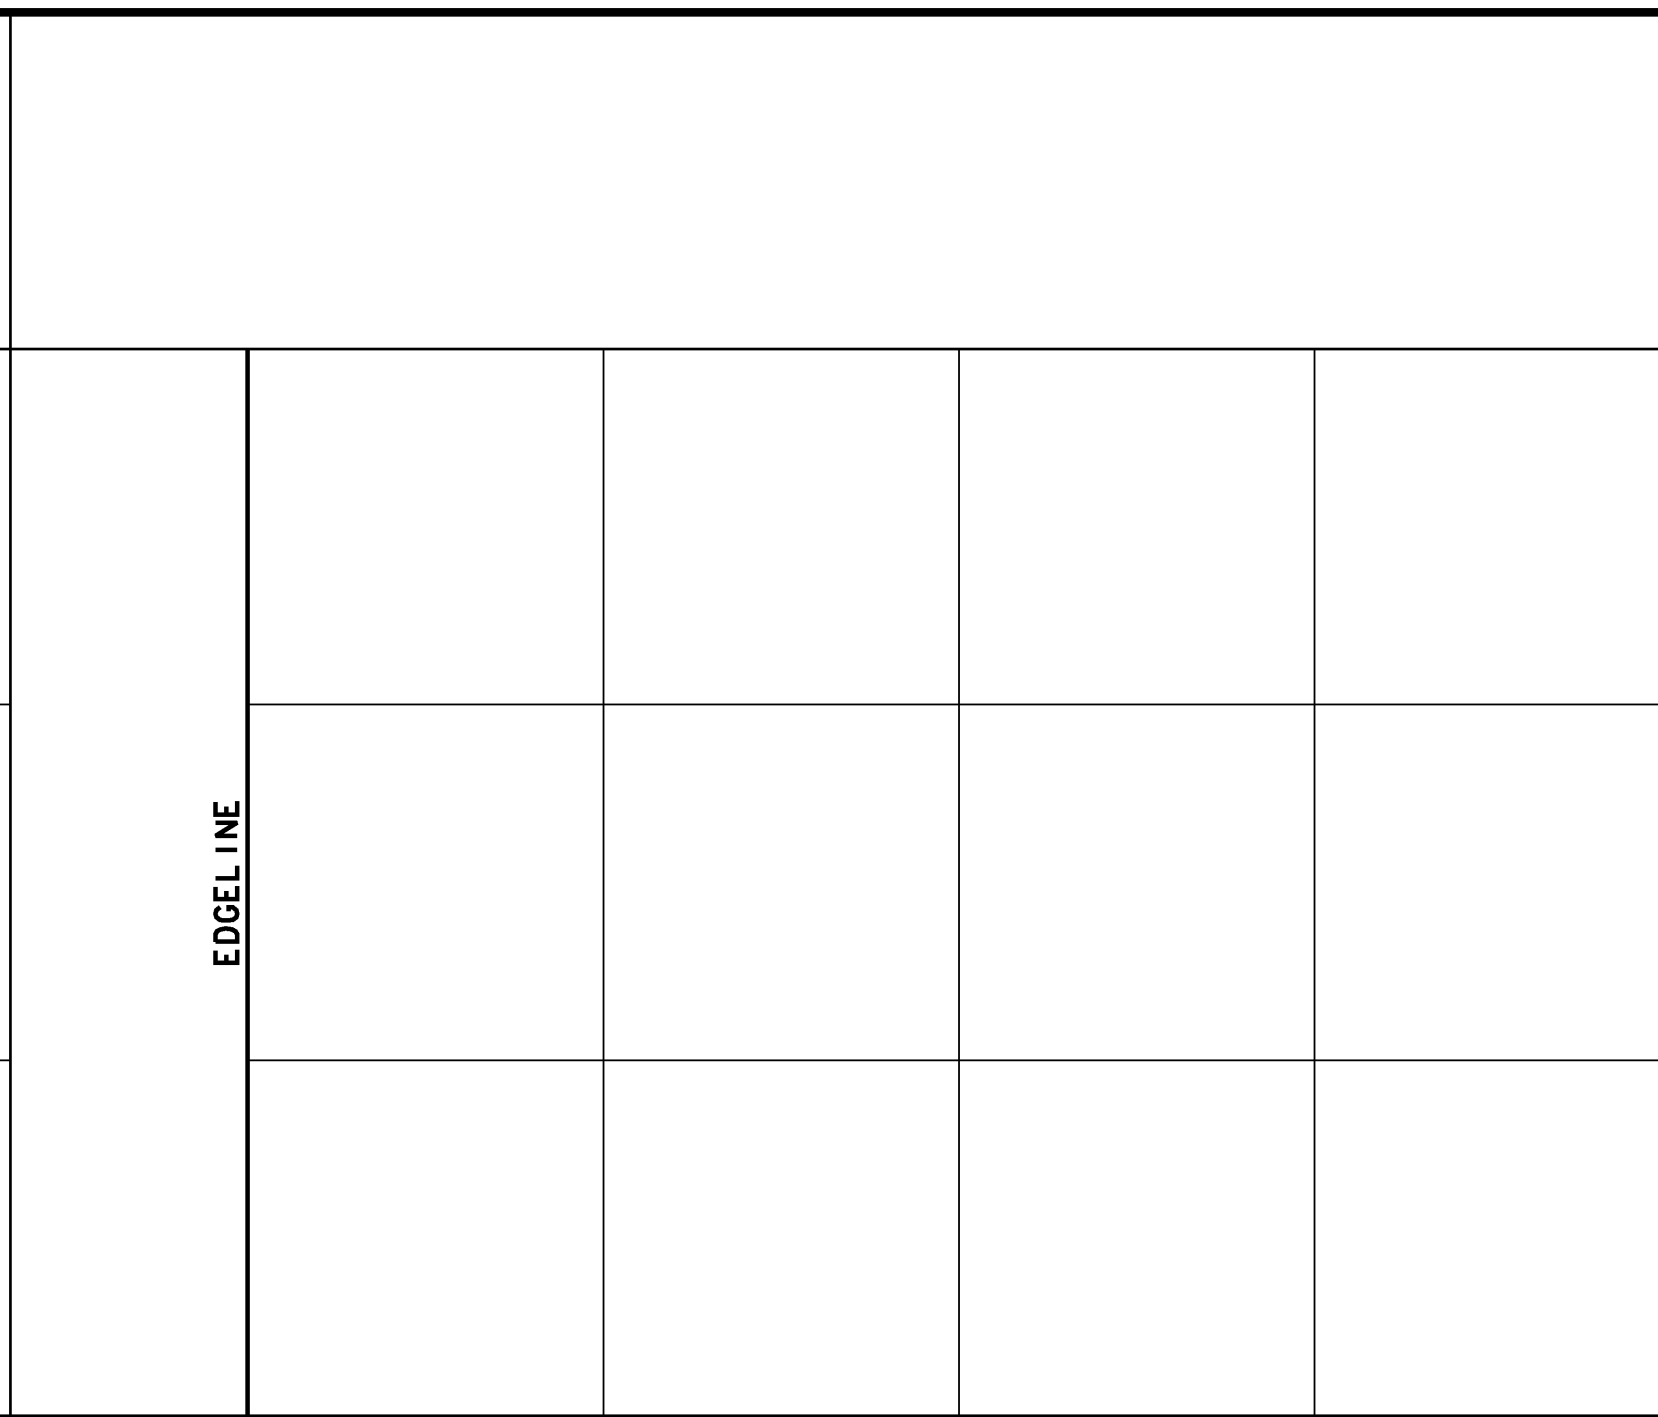





M.M. 128.810 SB

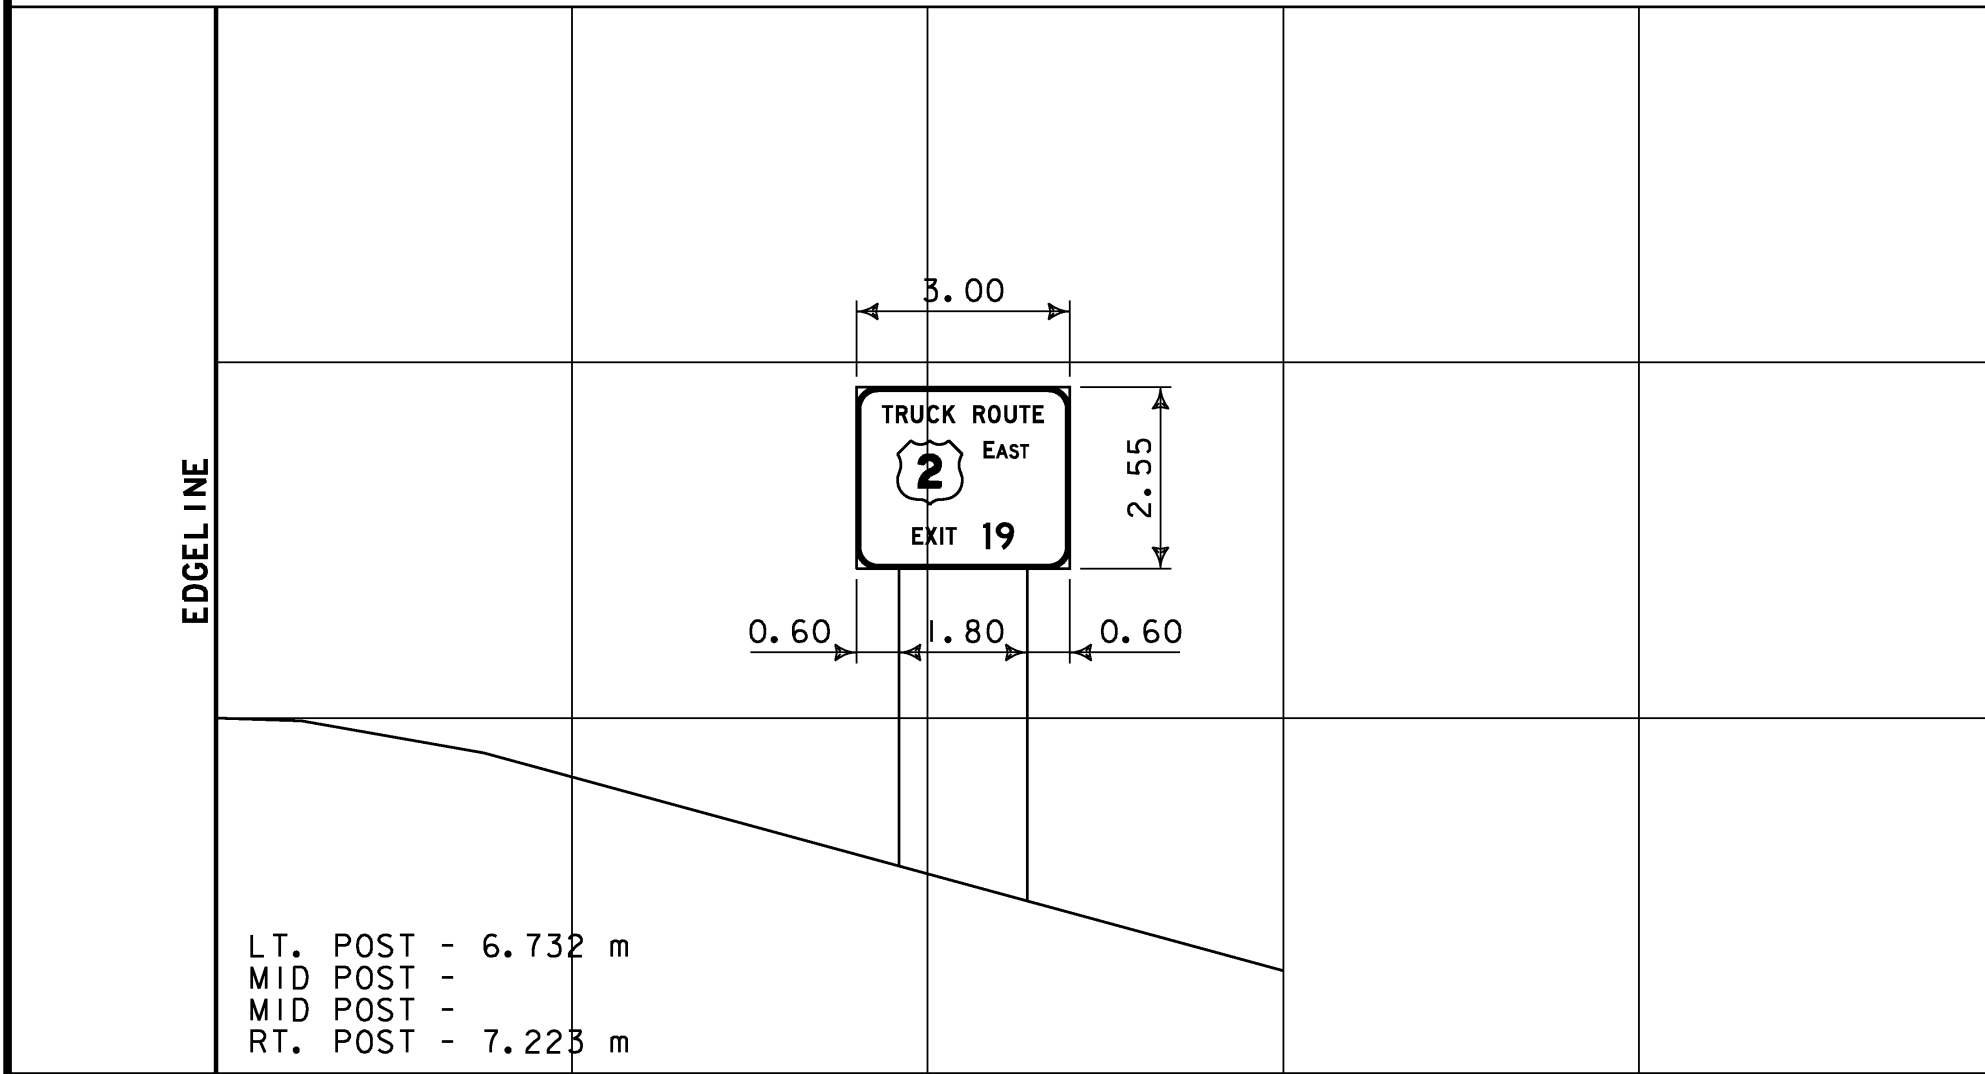


M.M. 127.195 SB

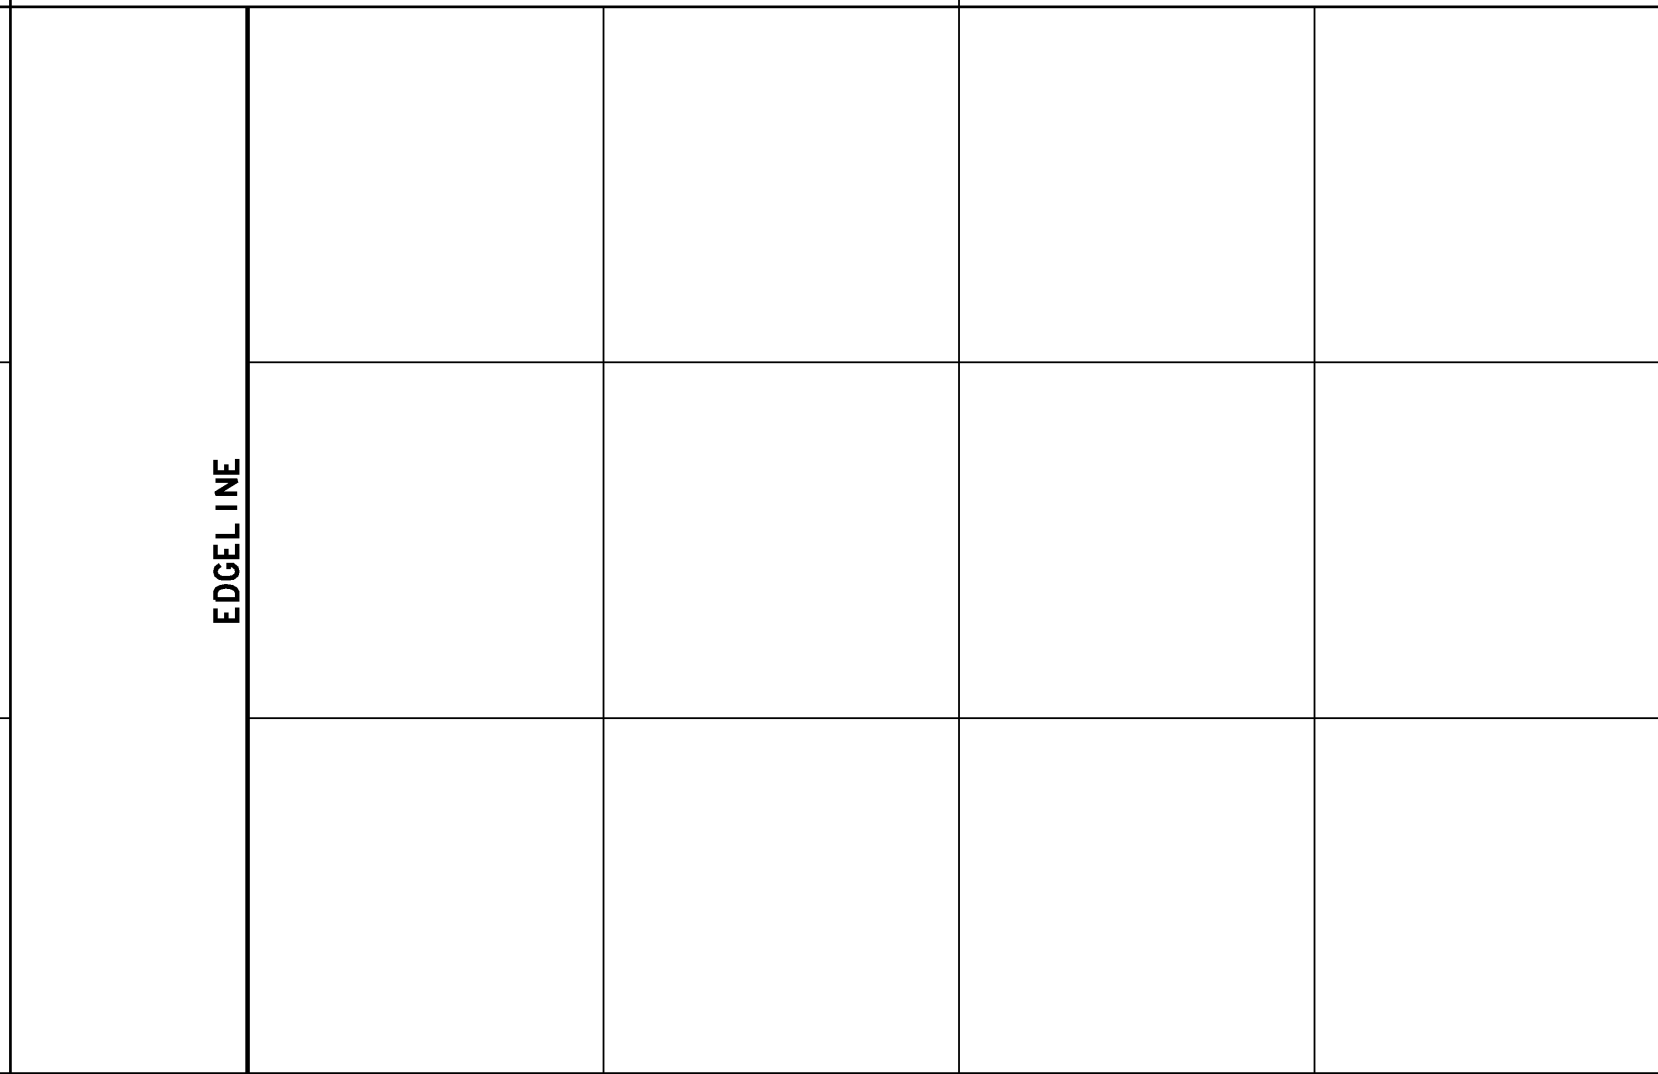

M.M. 127.195 SB

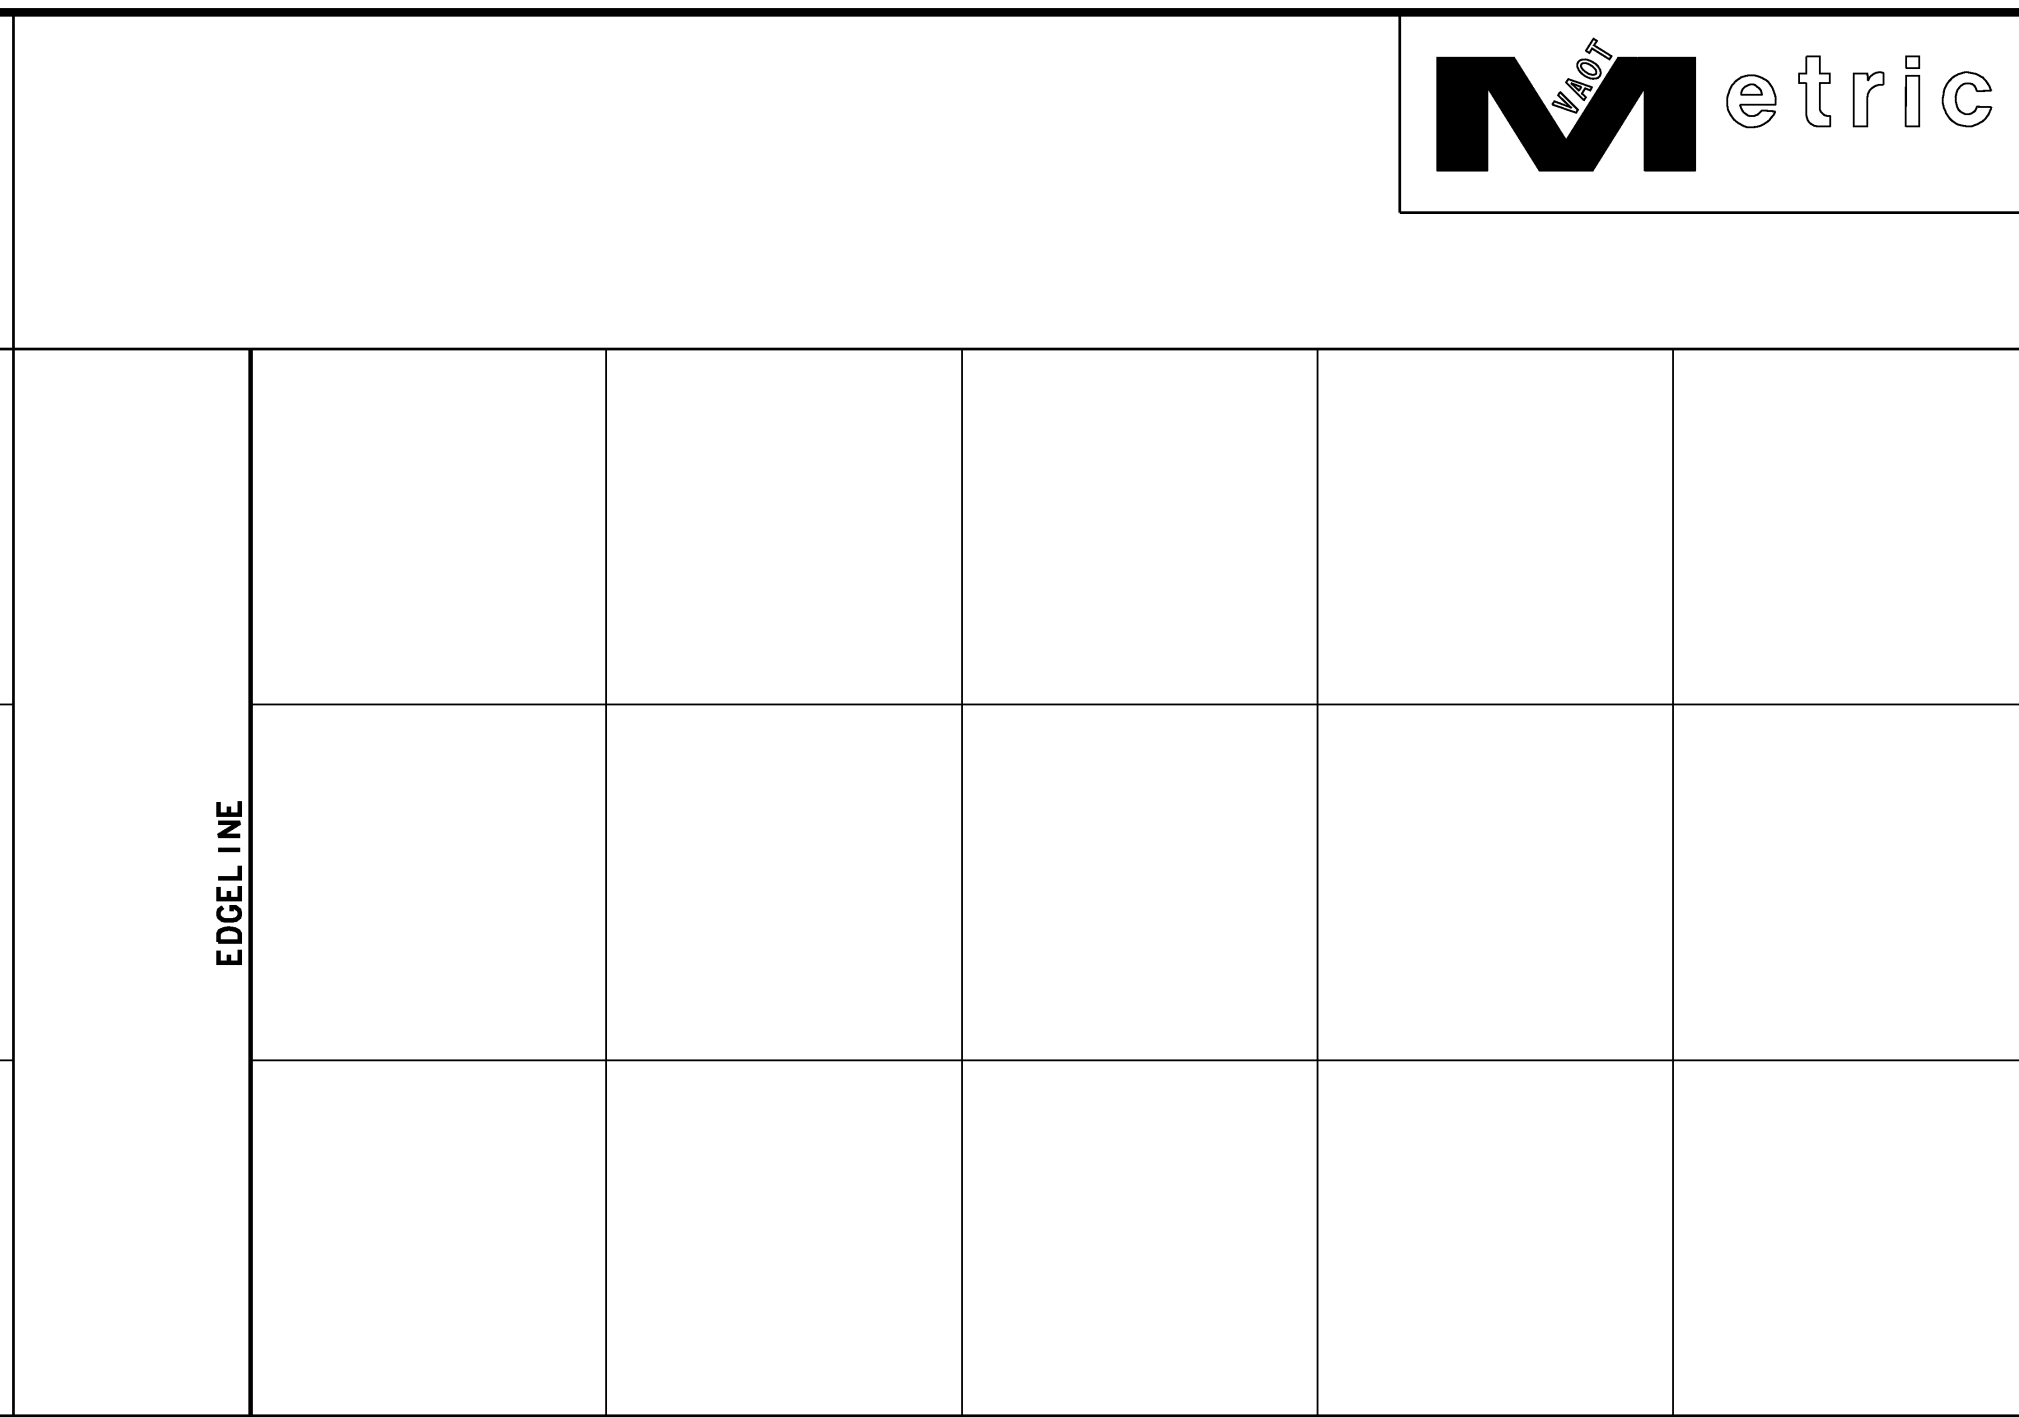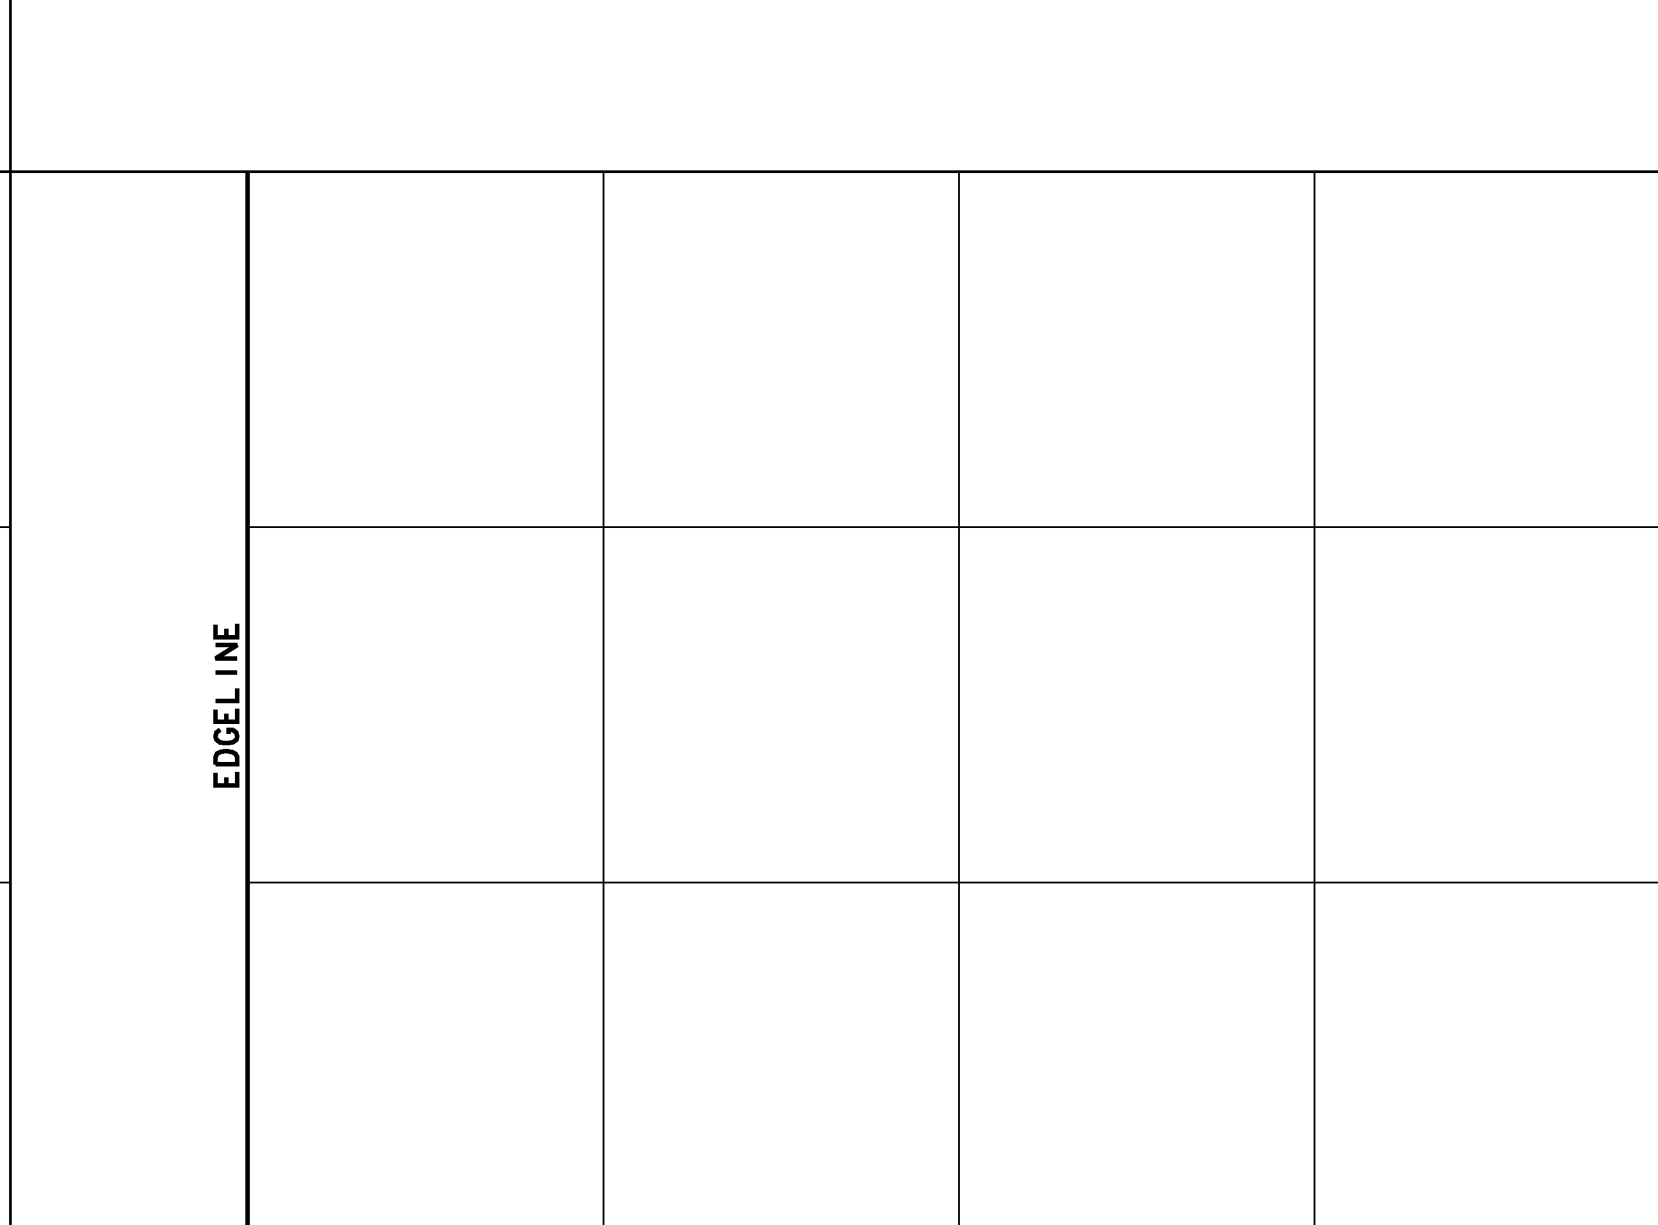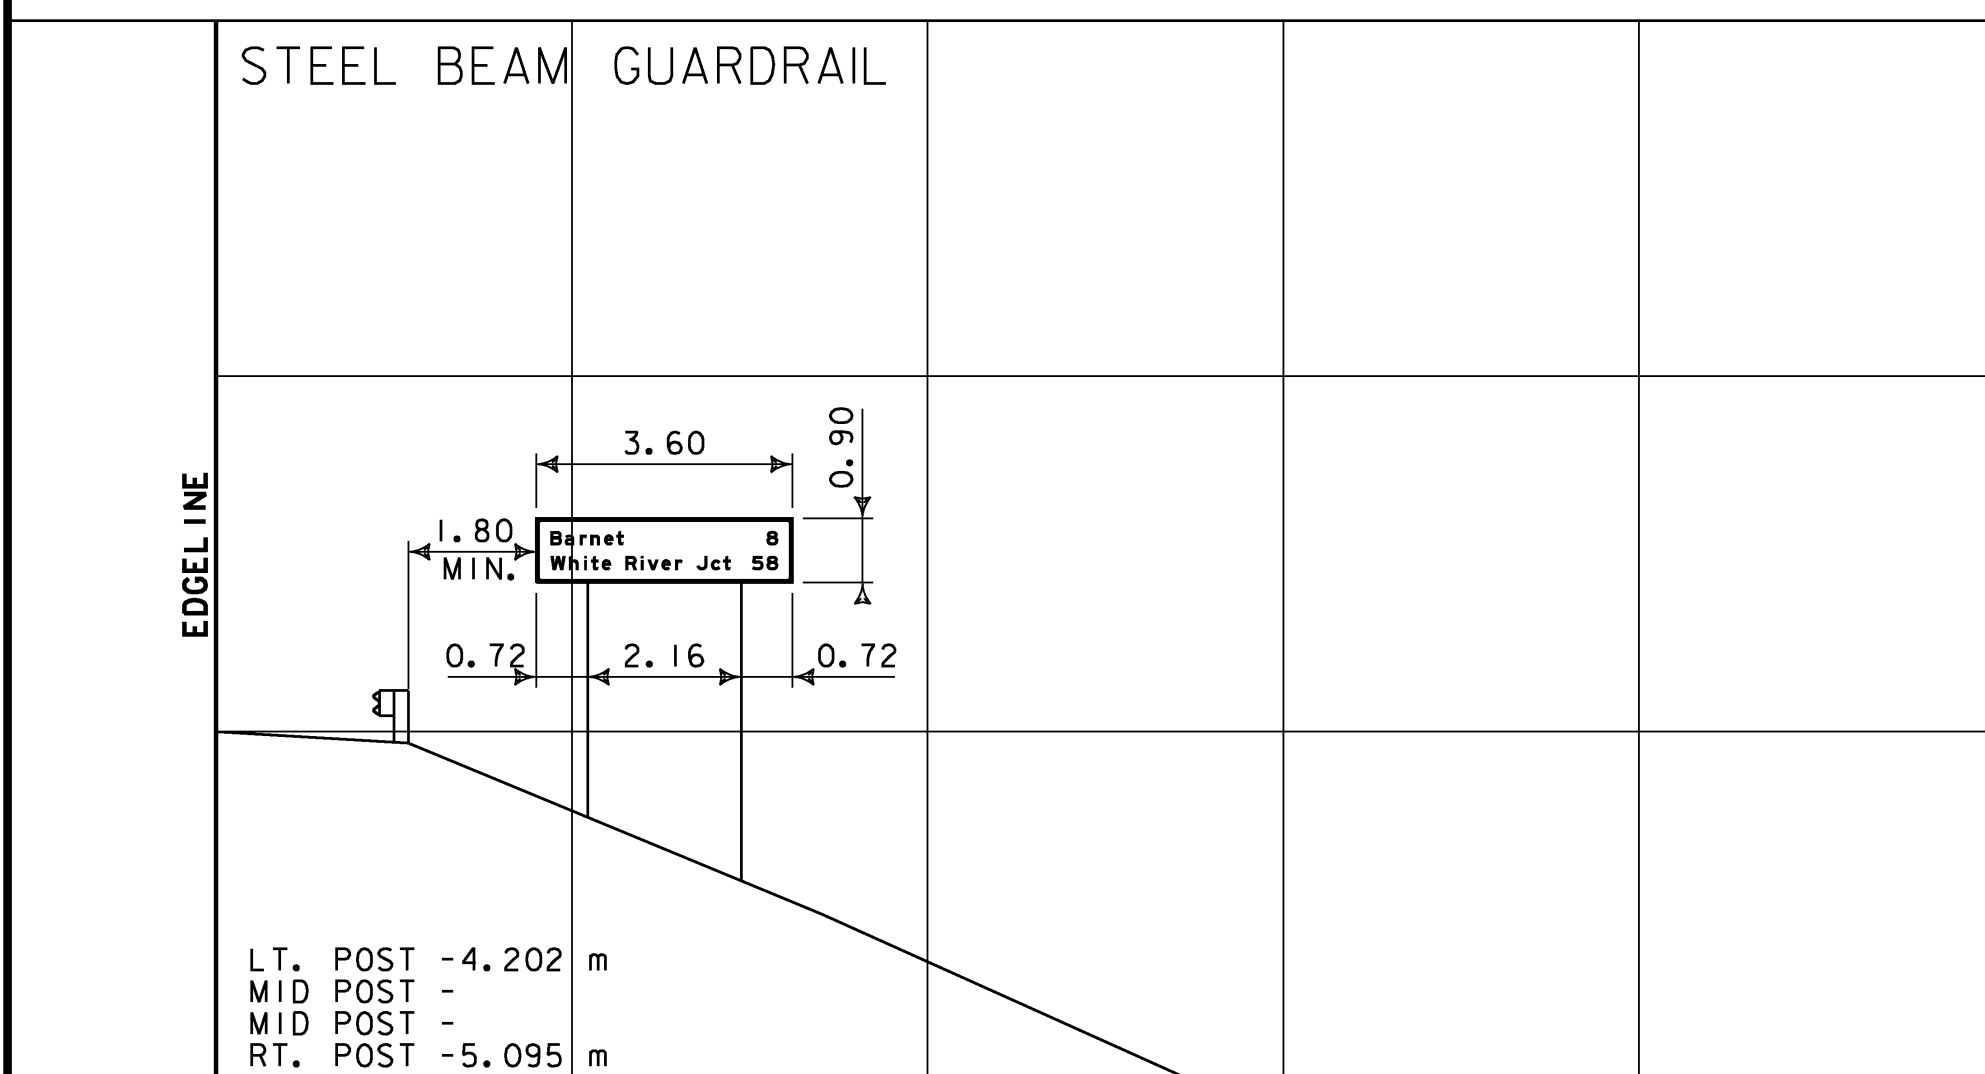

M.M. 127.195 SB

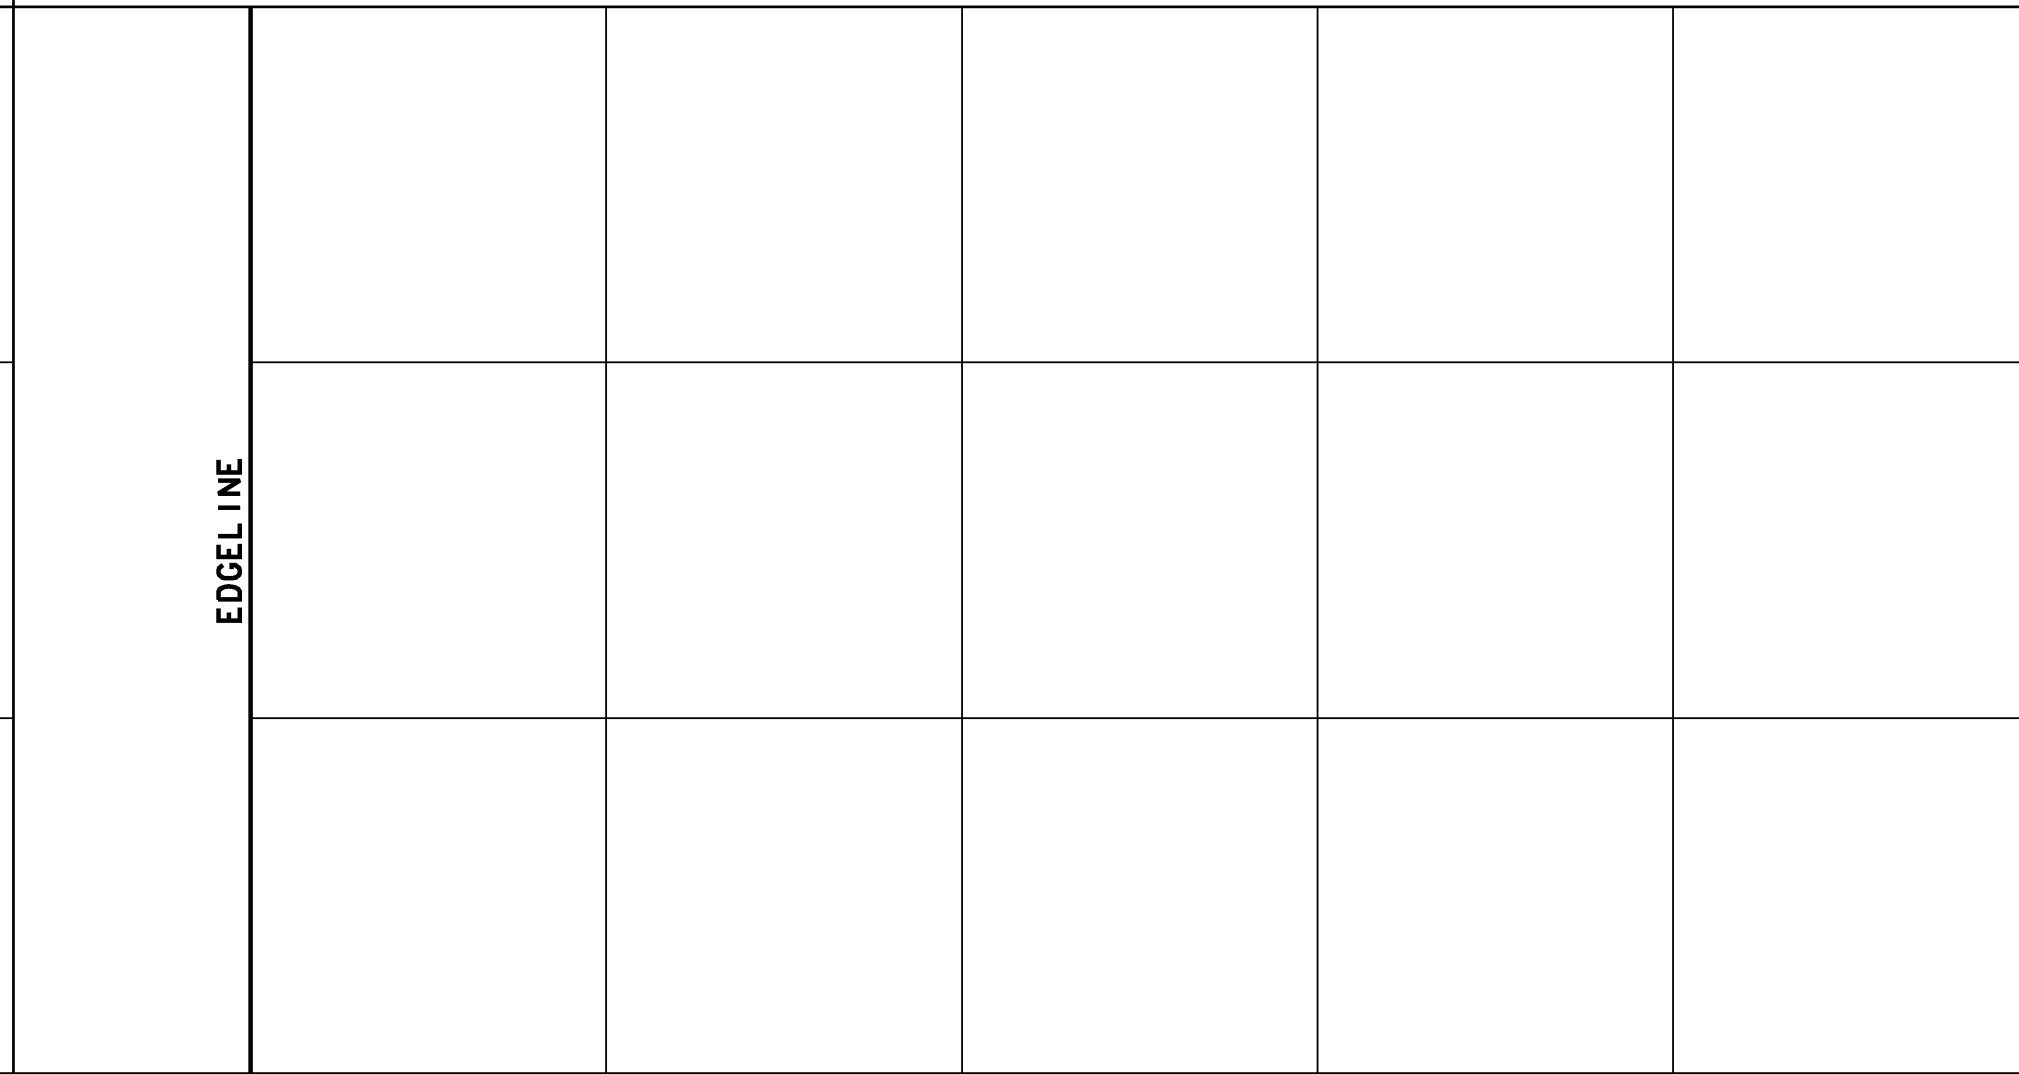

DIMENSIONS FOR CRITICAL OFFSETS OR CLEARANCES SHOWN FOR CONVENIENCE. REFER TO STANDARD SHEETS FOR PLACEMENT GUIDELINES.

SIGN CROSS SECTION SHEET 4	PROJECT NAME: RYEGATE-ST. JOHNSBURY	PLOT DATE: 12/13/2006
	PROJECT NUMBER: IM 091-2(73)	DRAWN BY: JCS
	FILE NAME: 97194s-xs.dgn	CHECKED BY: DAM
	DESIGNED BY: DAM	SHEET 82 OF 88
	CLD REF. NO.: 97-0194	