


APPROVED  
 GWC  
 06/13/07  
 A/W  
 RLT

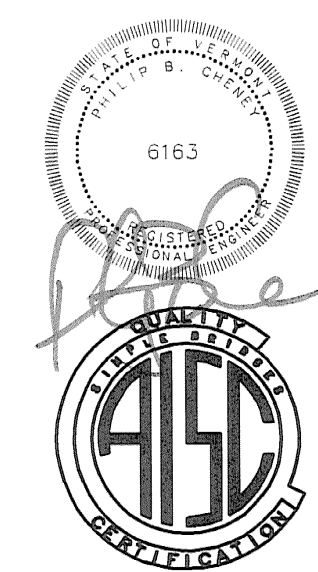

REVISIONS		
No.	Remarks	Date
0	Initial submittal	

**HIGHWAY SAFETY CORP.**  
 GLASTONBURY, CT  
 CANTILEVER SIGN STRUCTURE  
 STATE OF VERMONT  
 COUNTY OF CALEDONIA  
 INTERSTATE RTE. 91 STA. 127.628 NB  
 PROJECT No. AC IM 091-2(73)  
 F.R. LAFAYETTE

DRAWN: MHM  
 CHECKED: P. Radice  
 DATE: 3/23/07  
 SCALE: N.T.S.  
 PROJECT No. 1587c  
 SHEET No. 4 of 6