


TRUSS 1

ALL DIMENSIONS SHOWN ARE IN MILLIMETERS (mm) UNLESS OTHERWISE NOTED. ENGLISH CONVERSION SHOWN IN [] FOR REFERENCE ONLY.

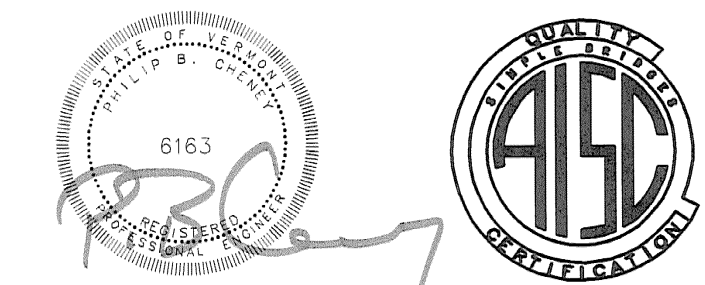

HIGHWAY SAFETY CORP.
GLASTONBURY, CT

TRI-CHORD SIGN STRUCTURE
STATE OF VERMONT
COUNTY OF CALEDONIA
INTERSTATE RTE. 91 STA.128.70 SB
PROJECT No. AC IM 091-2(73)

DATE: 3/23/07
SCALE: NTS
JOB REFERENCE NO.: 1587a
SHEET NO.: 2 of 8

DESIGNED BY: P. Radice
CHECKED BY: F.R. LAFAYETTE
DATE: 06/14/07

REVISIONS		
No.	Remarks	Date
0	Initial submittal	