



INDEX OF SHEETS
SEE SHEET 2

STATE OF VERMONT
AGENCY OF TRANSPORTATION

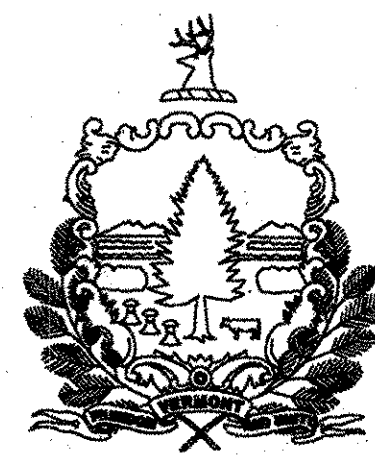

PROPOSED IMPROVEMENT
TOWNS OF ST. JOHNSBURY-LYNDON
TOWN OF WATERFORD
COUNTY OF CALEDONIA

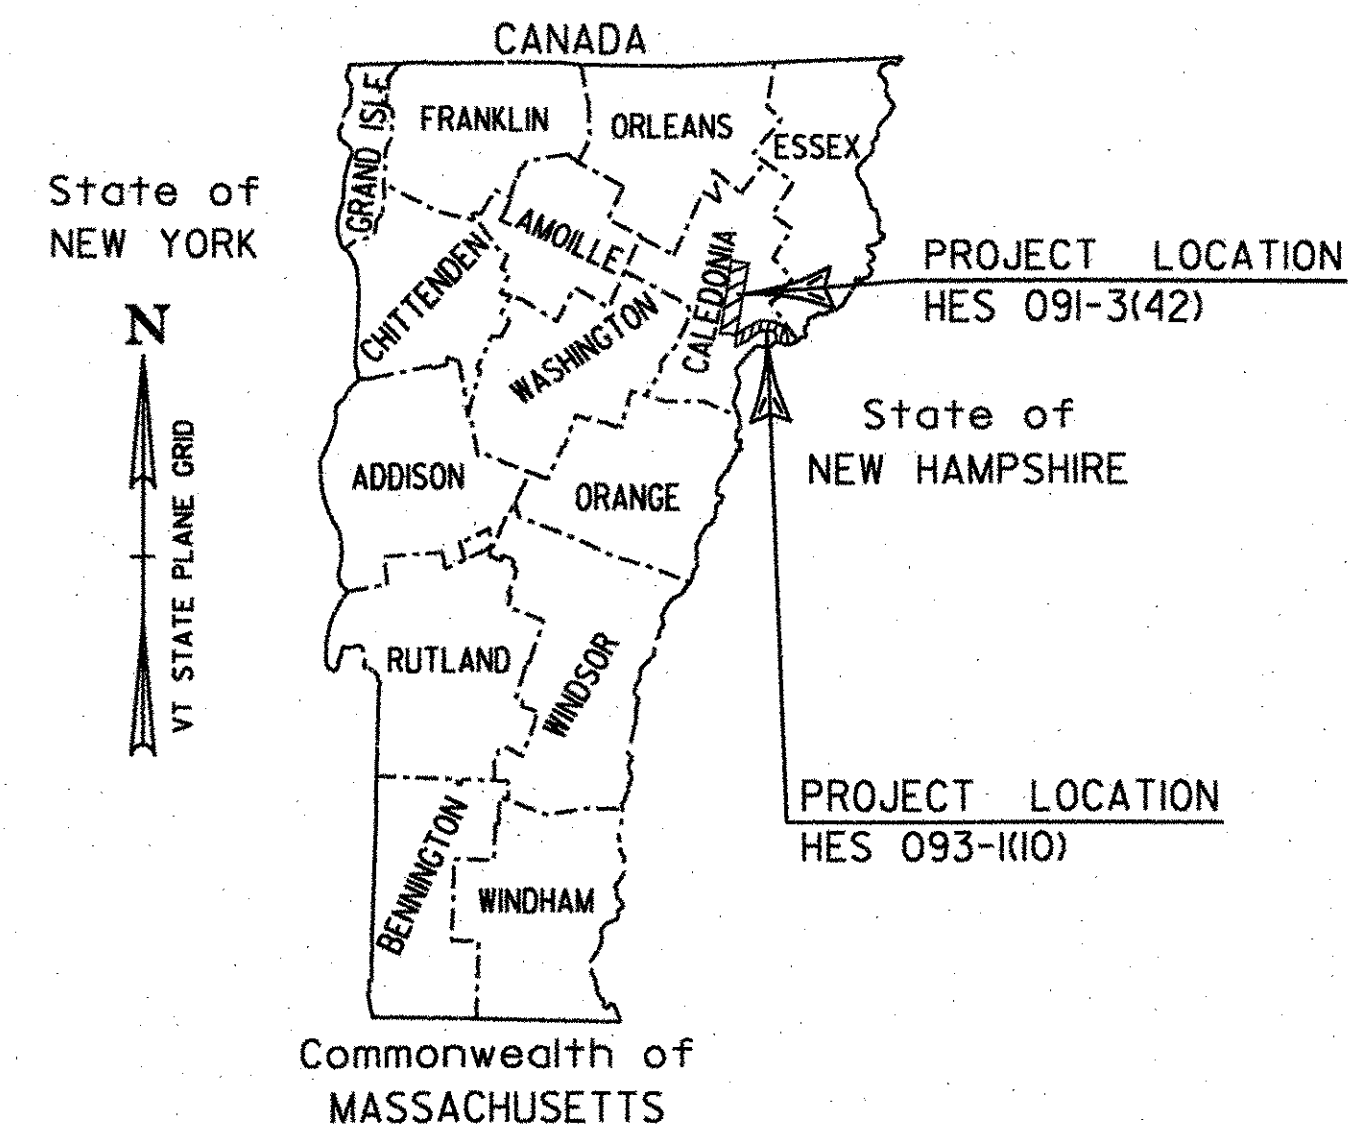

RECORD PLANS

CONTRACTOR: F. R. LAFAYETTE, INC. - ESSEX JUNCTION, VT

RESIDENT ENGINEER: JIM FOREST

CONSTRUCTION BEGAN: MAY 9, 2007

CONSTRUCTION COMPLETE: DECEMBER 5, 2008

RECORD PLANS BY: J. FOREST & C. PIERCE

I HEREBY CERTIFY THAT ALL THE CONSTRUCTION REQUIRED BY THIS SET OF DRAWINGS HAS BEEN ACCOMPLISHED AS INDICATED HEREIN.

BY James A. Forest RESIDENT ENGINEER

DATE 04-27-09

NOTE: Any further information concerning final quantities, amounts or other details relative to this project may be found at Central Files in the electronic archives.

INTERSTATE ROUTE 91 (HES 091-3(42)) - SIGNS

BEGINNING AT MM 128.91 IN THE TOWN OF ST. JOHNSBURY AND EXTENDING NORTHERLY APPROXIMATELY 17.85 KM (11.09 MI) TO MM 140.00 IN THE TOWN OF LYNDON

LENGTH OF ROADWAY 17 848 METERS = 11.09 MILES = 17.85 KILOMETERS
LENGTH OF PROJECT 17 848 METERS = 11.09 MILES = 17.85 KILOMETERS

WORK TO BE PERFORMED UNDER THIS PROJECT INCLUDES REMOVAL OF EXISTING SIGNS AND PLACEMENT OF NEW SIGNS AND ASSOCIATED ELEMENTS ALONG THE PROJECT LENGTH, RAMPS, AND INTERCHANGES.

INTERSTATE ROUTE 93 (HES 093-1(10)) - SIGNS

BEGINNING AT A POINT AT THE NEW HAMPSHIRE / VERMONT STATE LINE IN THE TOWN OF WATERFORD AND EXTENDING NORTHERLY APPROXIMATELY 17.86 KM (11.10 MI) TO MM 11.10

LENGTH OF ROADWAY 17 864 METERS = 11.10 MILES = 17.86 KILOMETERS
LENGTH OF PROJECT 17 864 METERS = 11.10 MILES = 17.86 KILOMETERS

WORK TO BE PERFORMED UNDER THIS PROJECT INCLUDES REMOVAL OF EXISTING SIGNS AND PLACEMENT OF NEW SIGNS AND ASSOCIATED ELEMENTS ALONG THE PROJECT LENGTH, RAMPS, AND INTERCHANGES.


TRAFFIC DATA	
NORTHBOUND	SOUTHBOUND
INTERSTATE 91	
2000 ADT 9800	2000 ADT 9800
INTERSTATE 93	
2000 ADT = 4900	2000 ADT = 4900

**MM 128.91
BEGIN PROJECT HES 091-3(42)**

**MM 140.00
END PROJECT HES 091-3(42)**

**VT-NH STATE LINE (MM 0.000)
BEGIN PROJECT HES 093-1(10)**

**MM 11.100
END PROJECT HES 093-1(10)**

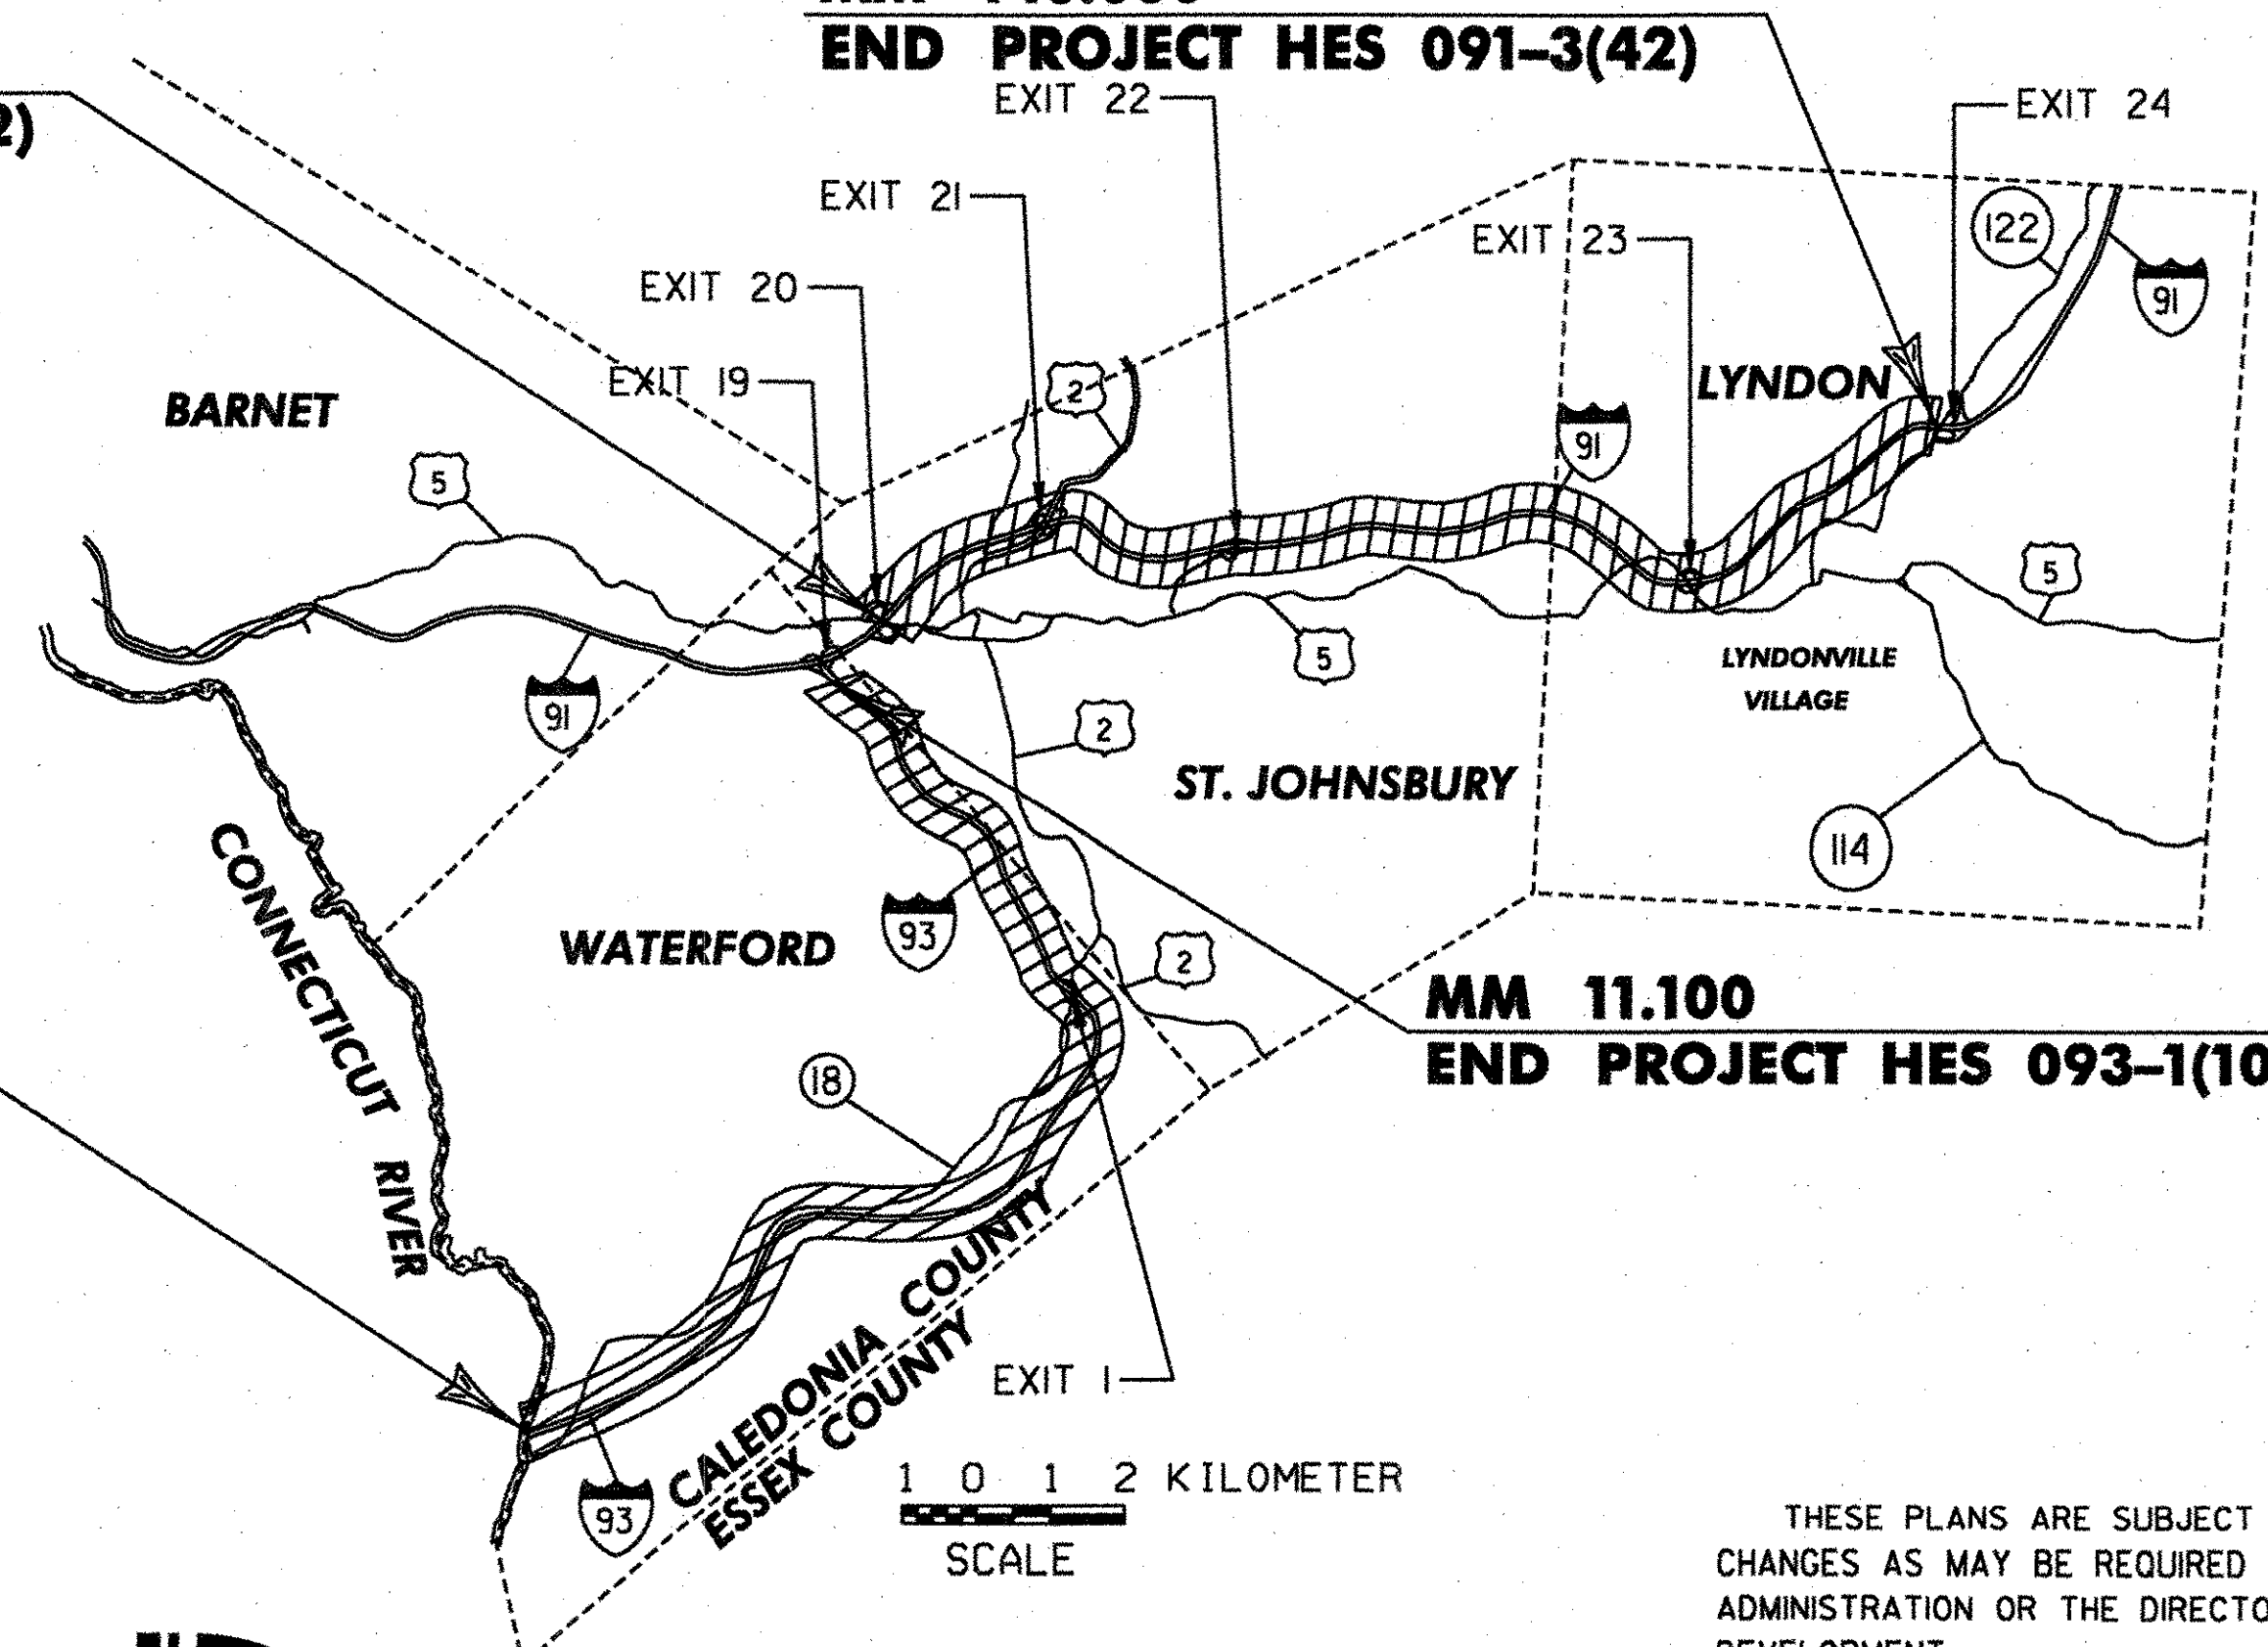

CONVENTIONAL SYMBOLS

COUNTY LINE	
TOWN LINE	
LIMITS OF ACCESS	
POINT OF ACCESS	
FENCE LINE	
STONE WALL	
TRAVELED WAY	
GUARD RAIL	
RAILROAD	
SURVEY LINE	
CULVERT	
POWER POLE	
TELEPHONE POLE	
TREES	
CONTROL OF ACCESS	
PROPERTY LINE	
R.O.W. TAKING LINE	
SLOPE RIGHTS	
TOP OF CUT	
TOE OF SLOPE	

SURVEYED BY : N/A
SURVEYED DATE : N/A

DATUM
VERTICAL N/A
HORIZONTAL N/A

CLD CONSULTING ENGINEERS Inc.

540 Commercial Street • Manchester, NH 03101
(603) 668-8223 • Fax: (603) 668-8902
email: cld@cldegnr.com • www.cldengr.com
Maine • New Hampshire • Vermont



THESE PLANS ARE SUBJECT TO SUCH ENGINEERING CHANGES AS MAY BE REQUIRED BY THE FEDERAL HIGHWAY ADMINISTRATION OR THE DIRECTOR OF PROGRAM DEVELOPMENT.

CONSTRUCTION IS TO BE CARRIED ON IN ACCORDANCE WITH THESE PLANS AND THE STANDARD SPECIFICATIONS FOR CONSTRUCTION DATED 2001, AS APPROVED BY THE FEDERAL HIGHWAY ADMINISTRATION ON JANUARY 4, 2001 FOR USE ON THIS PROJECT, INCLUDING ALL SUBSEQUENT REVISIONS AND SUCH REVISED SPECIFICATIONS AND SPECIAL PROVISIONS AS ARE INCORPORATED IN THESE PLANS.

DEPARTMENT OF TRANSPORTATION FEDERAL HIGHWAY ADMINISTRATOR	APPROVED <u>Mark D. Kuttler</u> DATE <u>2-21-07</u>
DIRECTOR OF PROGRAM DEVELOPMENT	APPROVED <u>Robert J. Schmitt</u> DATE <u>1-9-07</u>
PROJECT MANAGER :	ROGER THOMPSON
PROJECT NAME :	ST. JOHNSBURY-LYNDON/WATERFORD
PROJECT NUMBER :	HES 091-3 (42) HES 093-1 (10)
SHEET 1 OF 130 SHEETS	

Metric
UNLESS NOTED OTHERWISE
STATIONS ARE IN MILES
ELEVATIONS ARE IN METERS
DIMENSIONS ARE IN MILLIMETERS