


REMOVING SIGNS
 NB - TYPE A: 12
 TYPE B: 1
 BRIDGE PLAQUE: 2 (NOT SHOWN)
 SB - TYPE A: 9
 TYPE B: 2
 BRIDGE PLAQUE: 2 (NOT SHOWN)

END PROJECT
 HES 091-3(42)
 (MM 140.00)

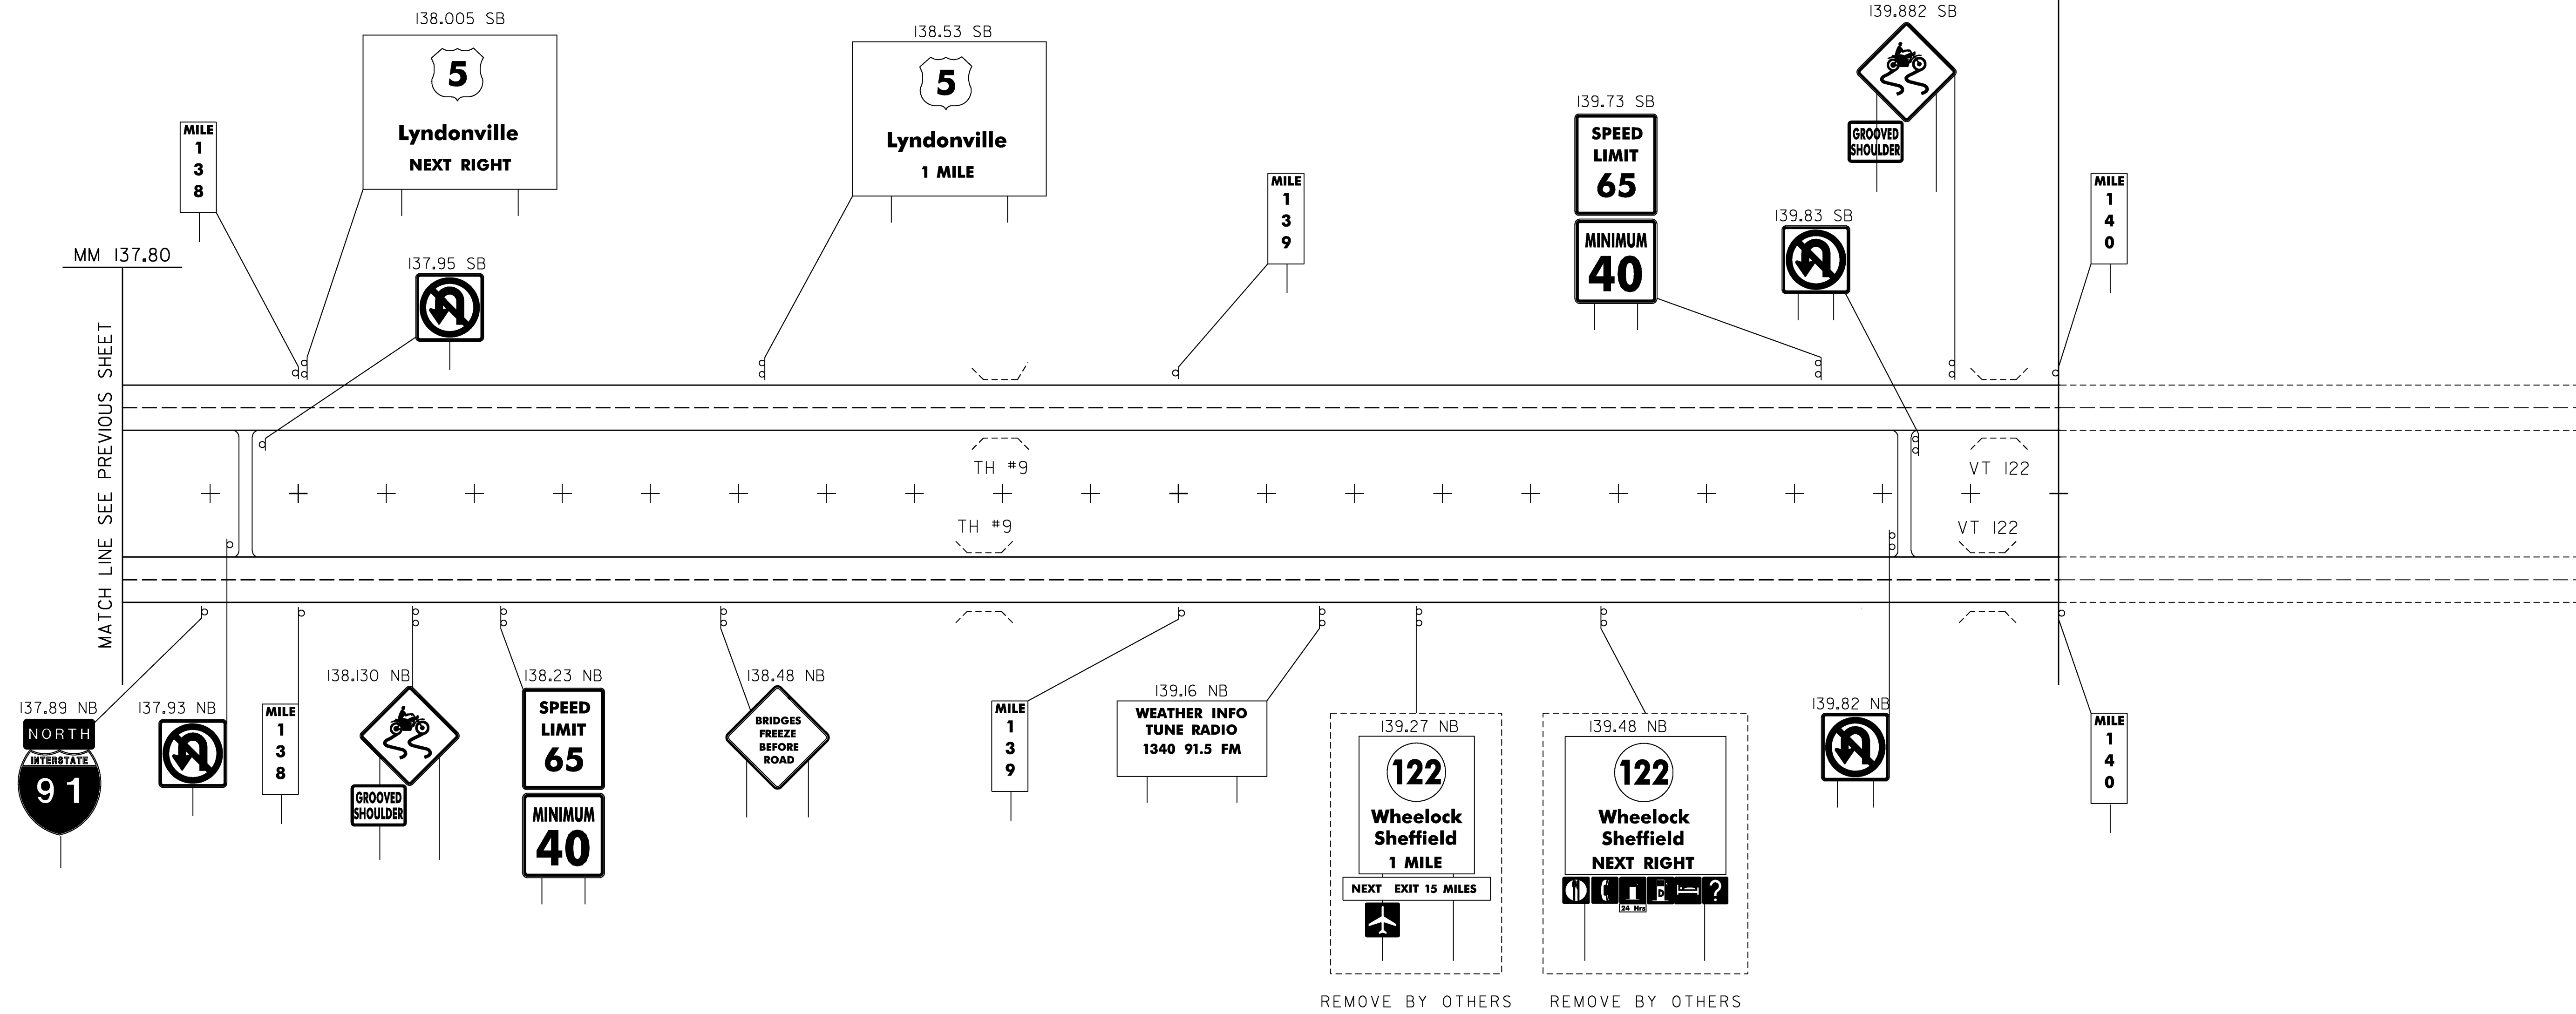

LEGEND
 [Dashed Box] RET - RETAINED

ALL SIGNS AND POSTS WILL BE
 REMOVED UNLESS OTHERWISE NOTED

EXISTING SIGNS	PROJECT NAME: ST. JOHNSBURY-LYNDON
	PROJECT NUMBER: HES 091-3(42)
	FILE NAME: 97210a-ml.dgn
	CLD REF. NO.: 97-0211
	PLOT DATE: 1/4/2007
	DRAWN BY: HJC
	CHECKED BY: DAM
	SHEET 13 OF 130